



Note: Depress Curb through Sidewalk section of Alley Return.

B.M. 112.655 'x' on side walk at SE. corner
of Bldg. NW corner of Douglas and Dodge

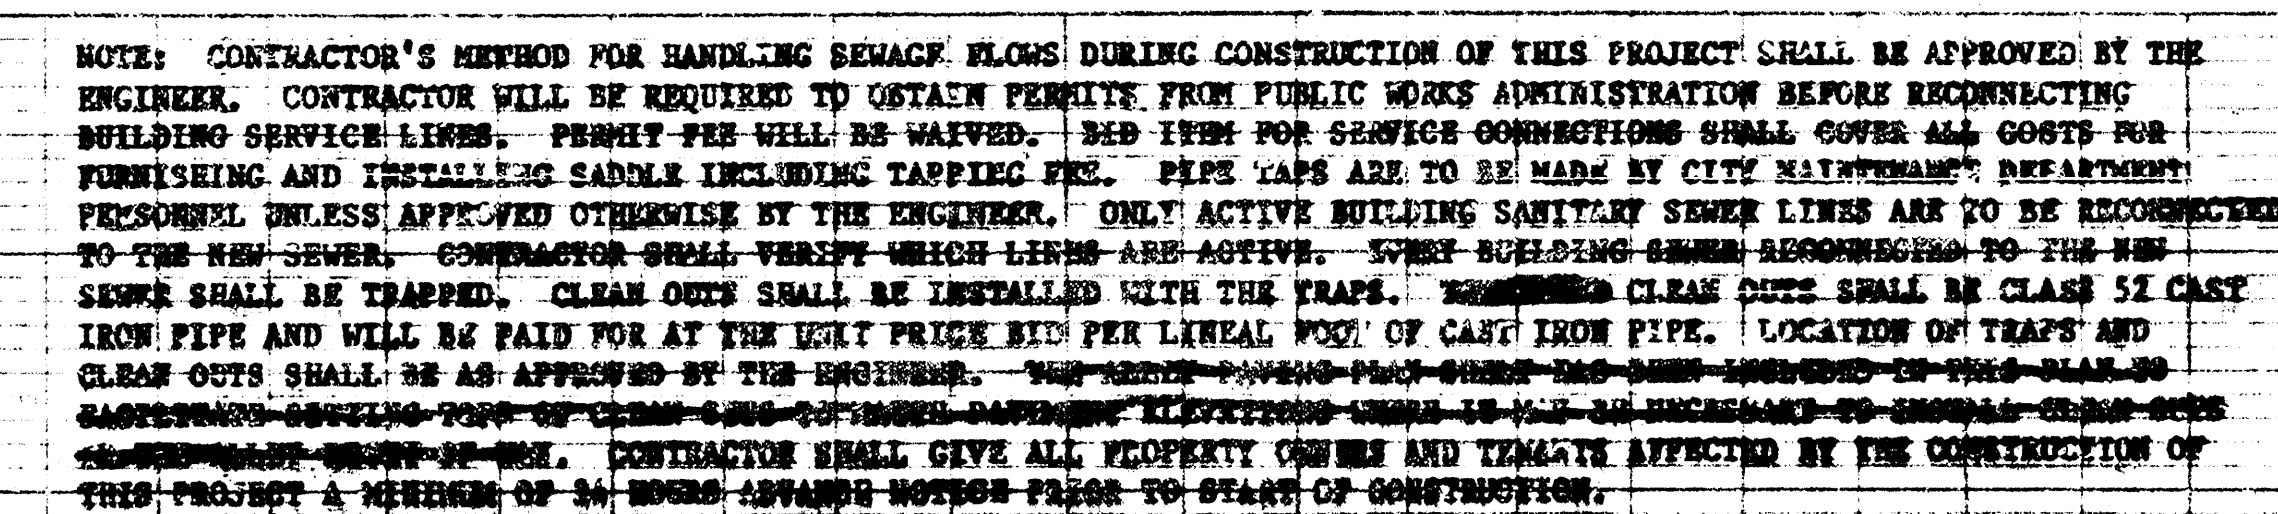

ALL 4" AND 6" SEWER CONSTRUCTION SHALL CONFORM TO THE APPLICABLE SECTIONS OF THE CITY OF WICHITA CODE.

As Built
Jk

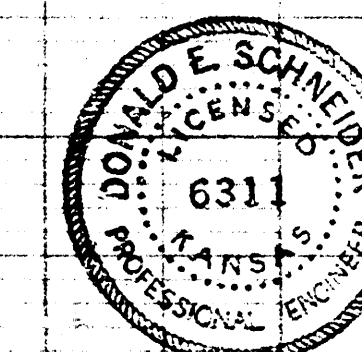

CITY OF WICHITA, KANSAS
DEAN SELLERS — CITY ENGINEER
PROJ. NO. 542-80245-80005-000000-001

K-E PLATE 1, PLAN-PROFILE
KILGUS & ESSER CO.
46 7024 MADE IN U.S.A.

**FILMED FROM THE BEST
AVAILABLE COPY**