


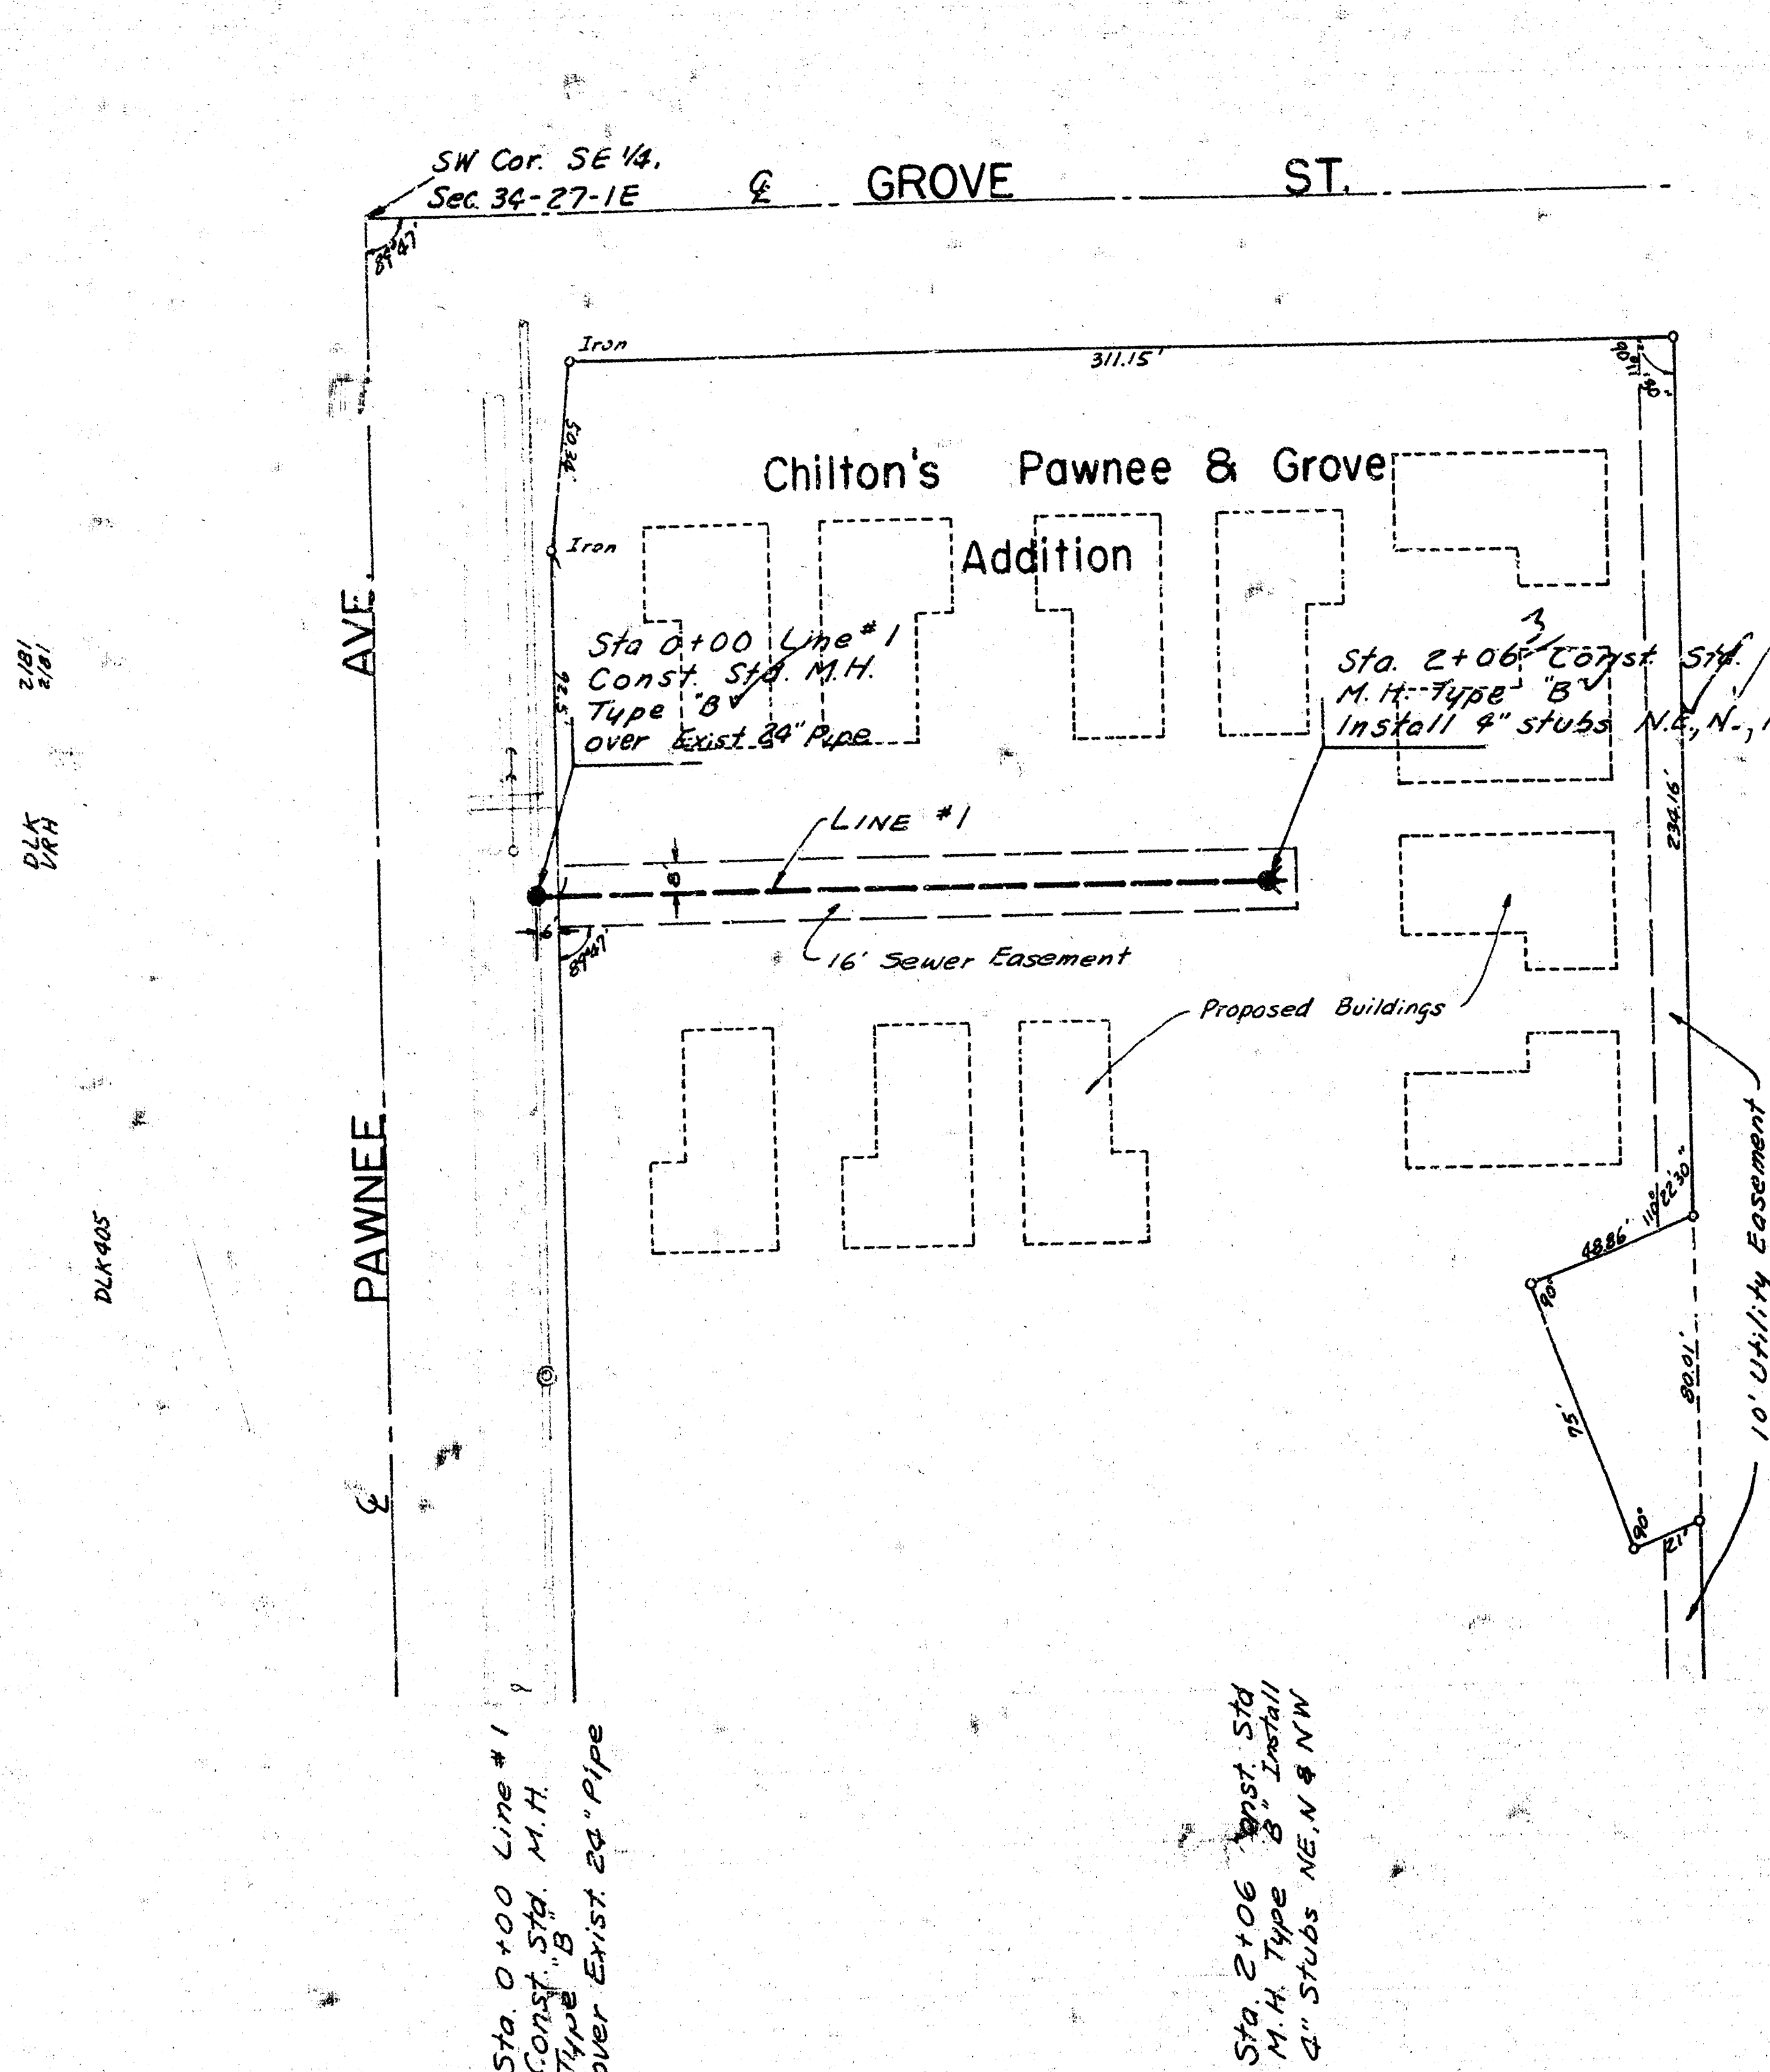


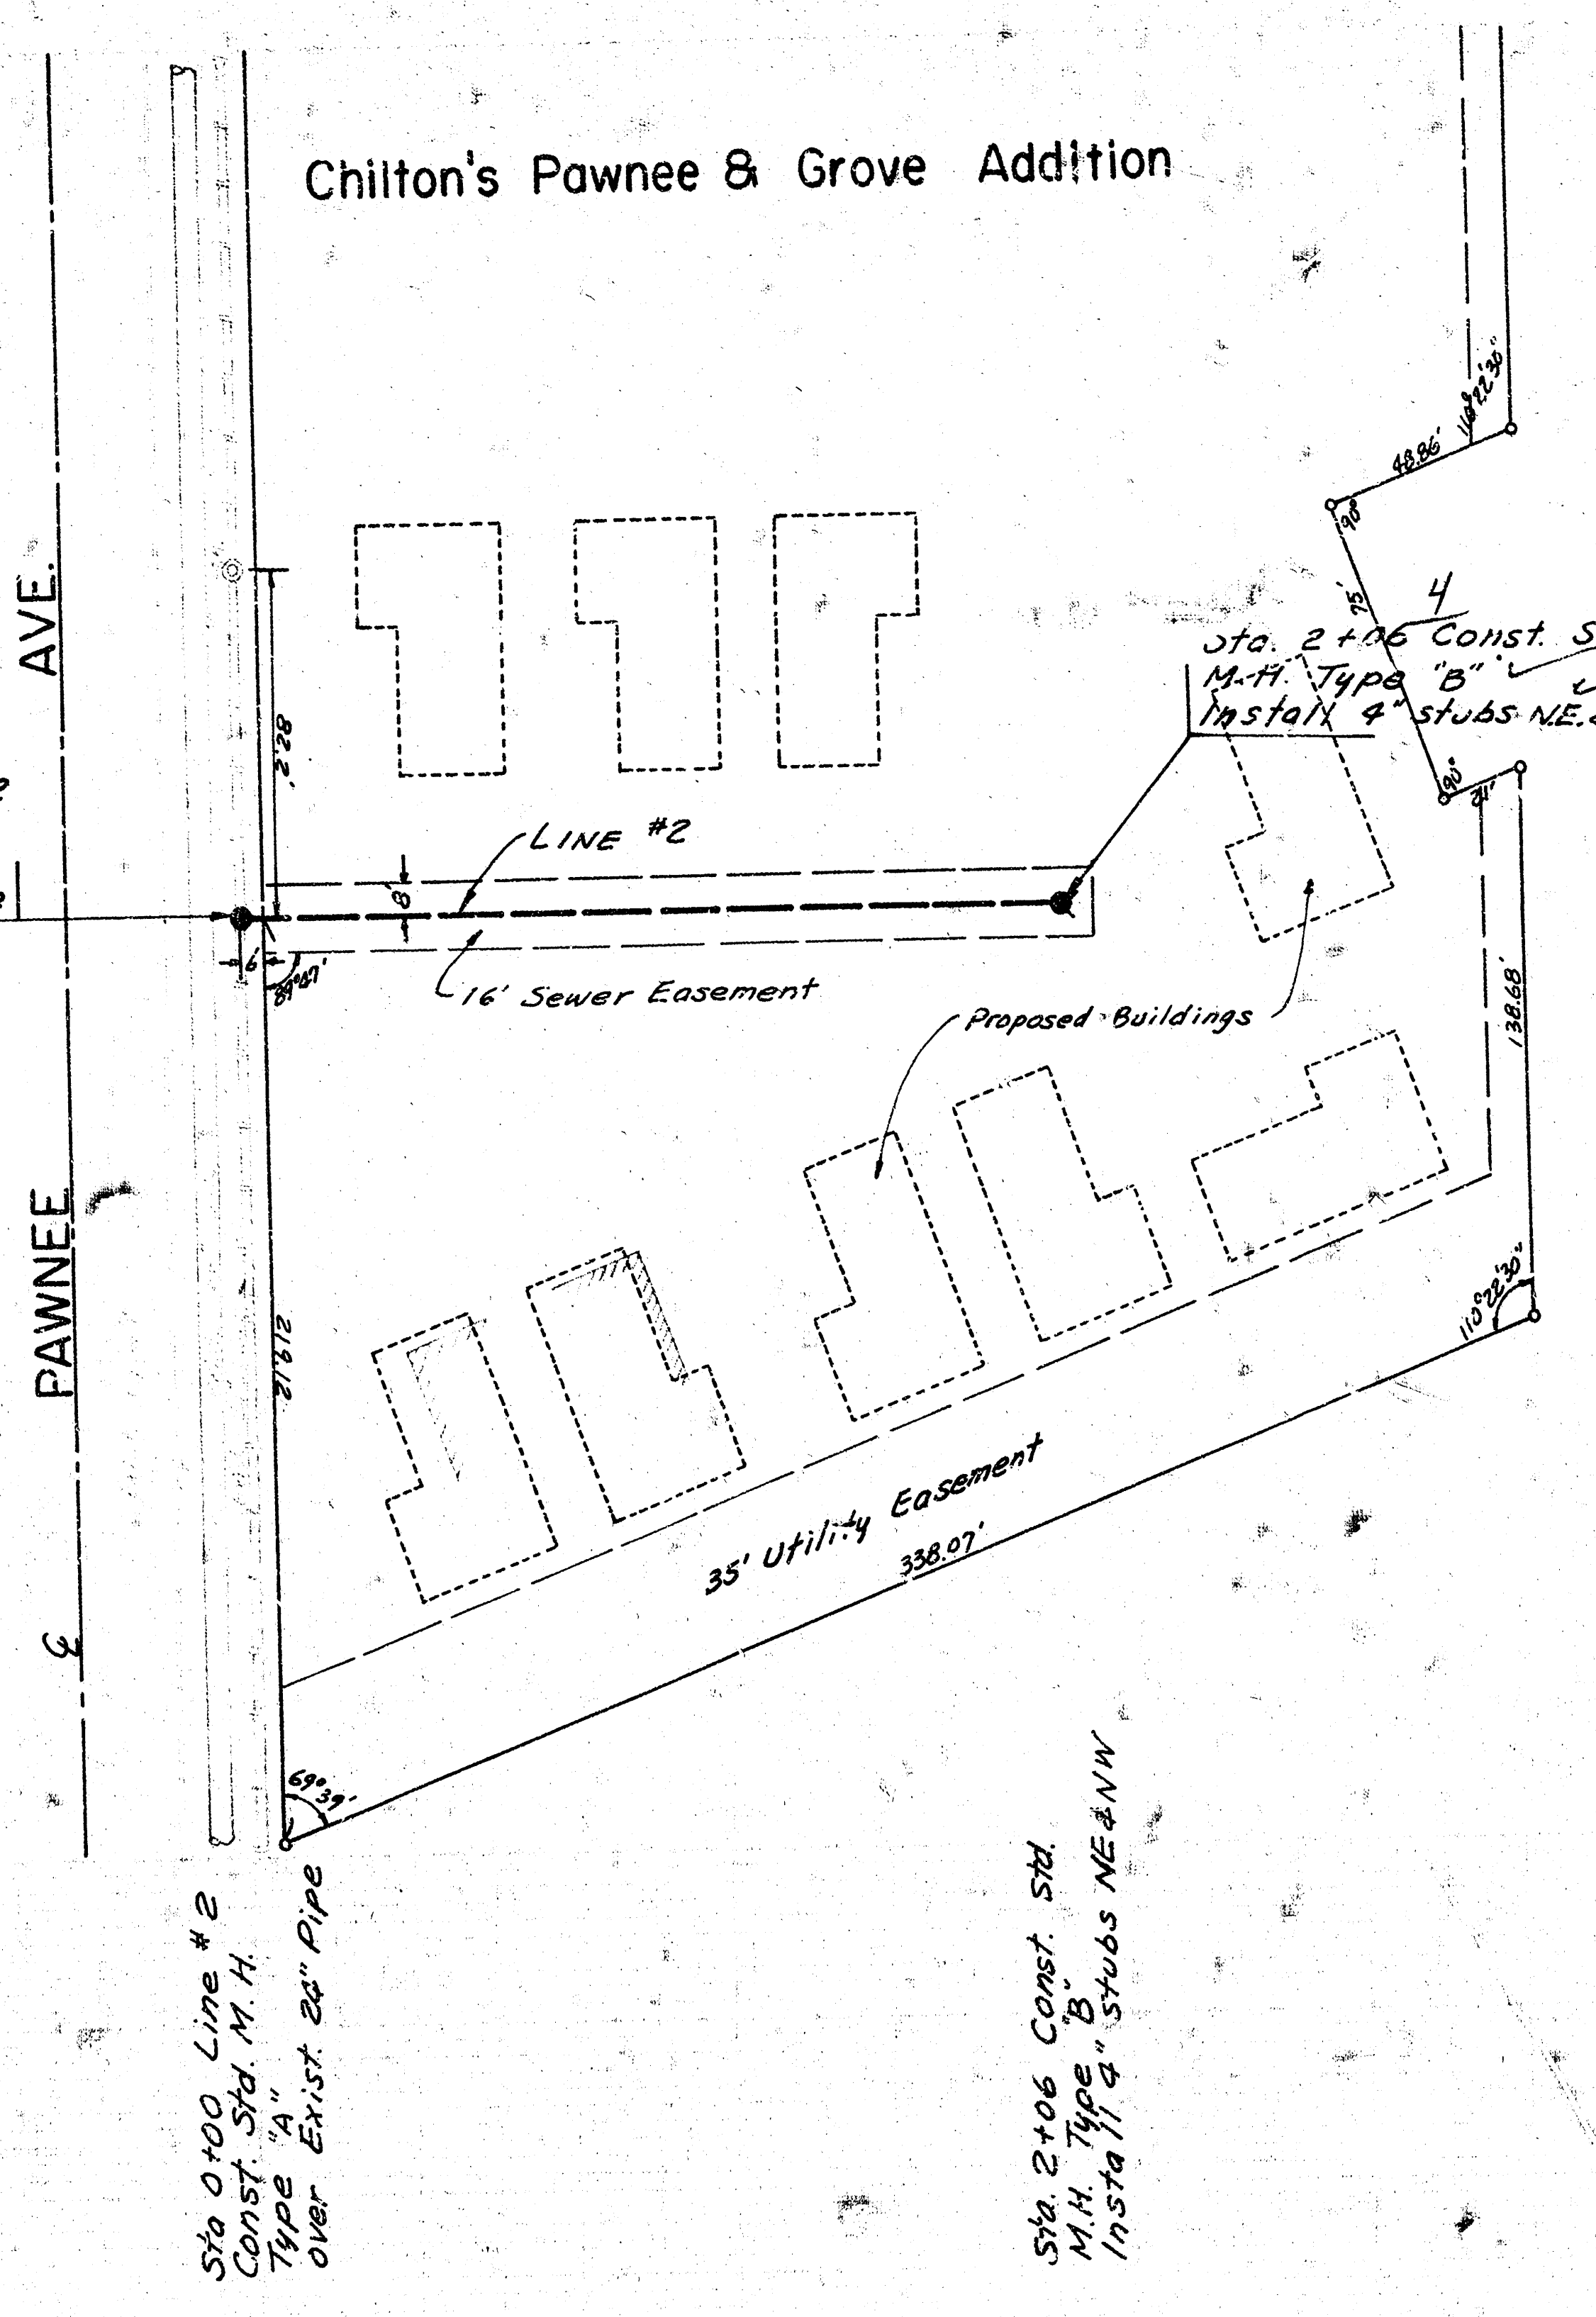


Scale Plan 1" = 40'
Profile 1" = 40' Horiz.
1" = 5' Vert.

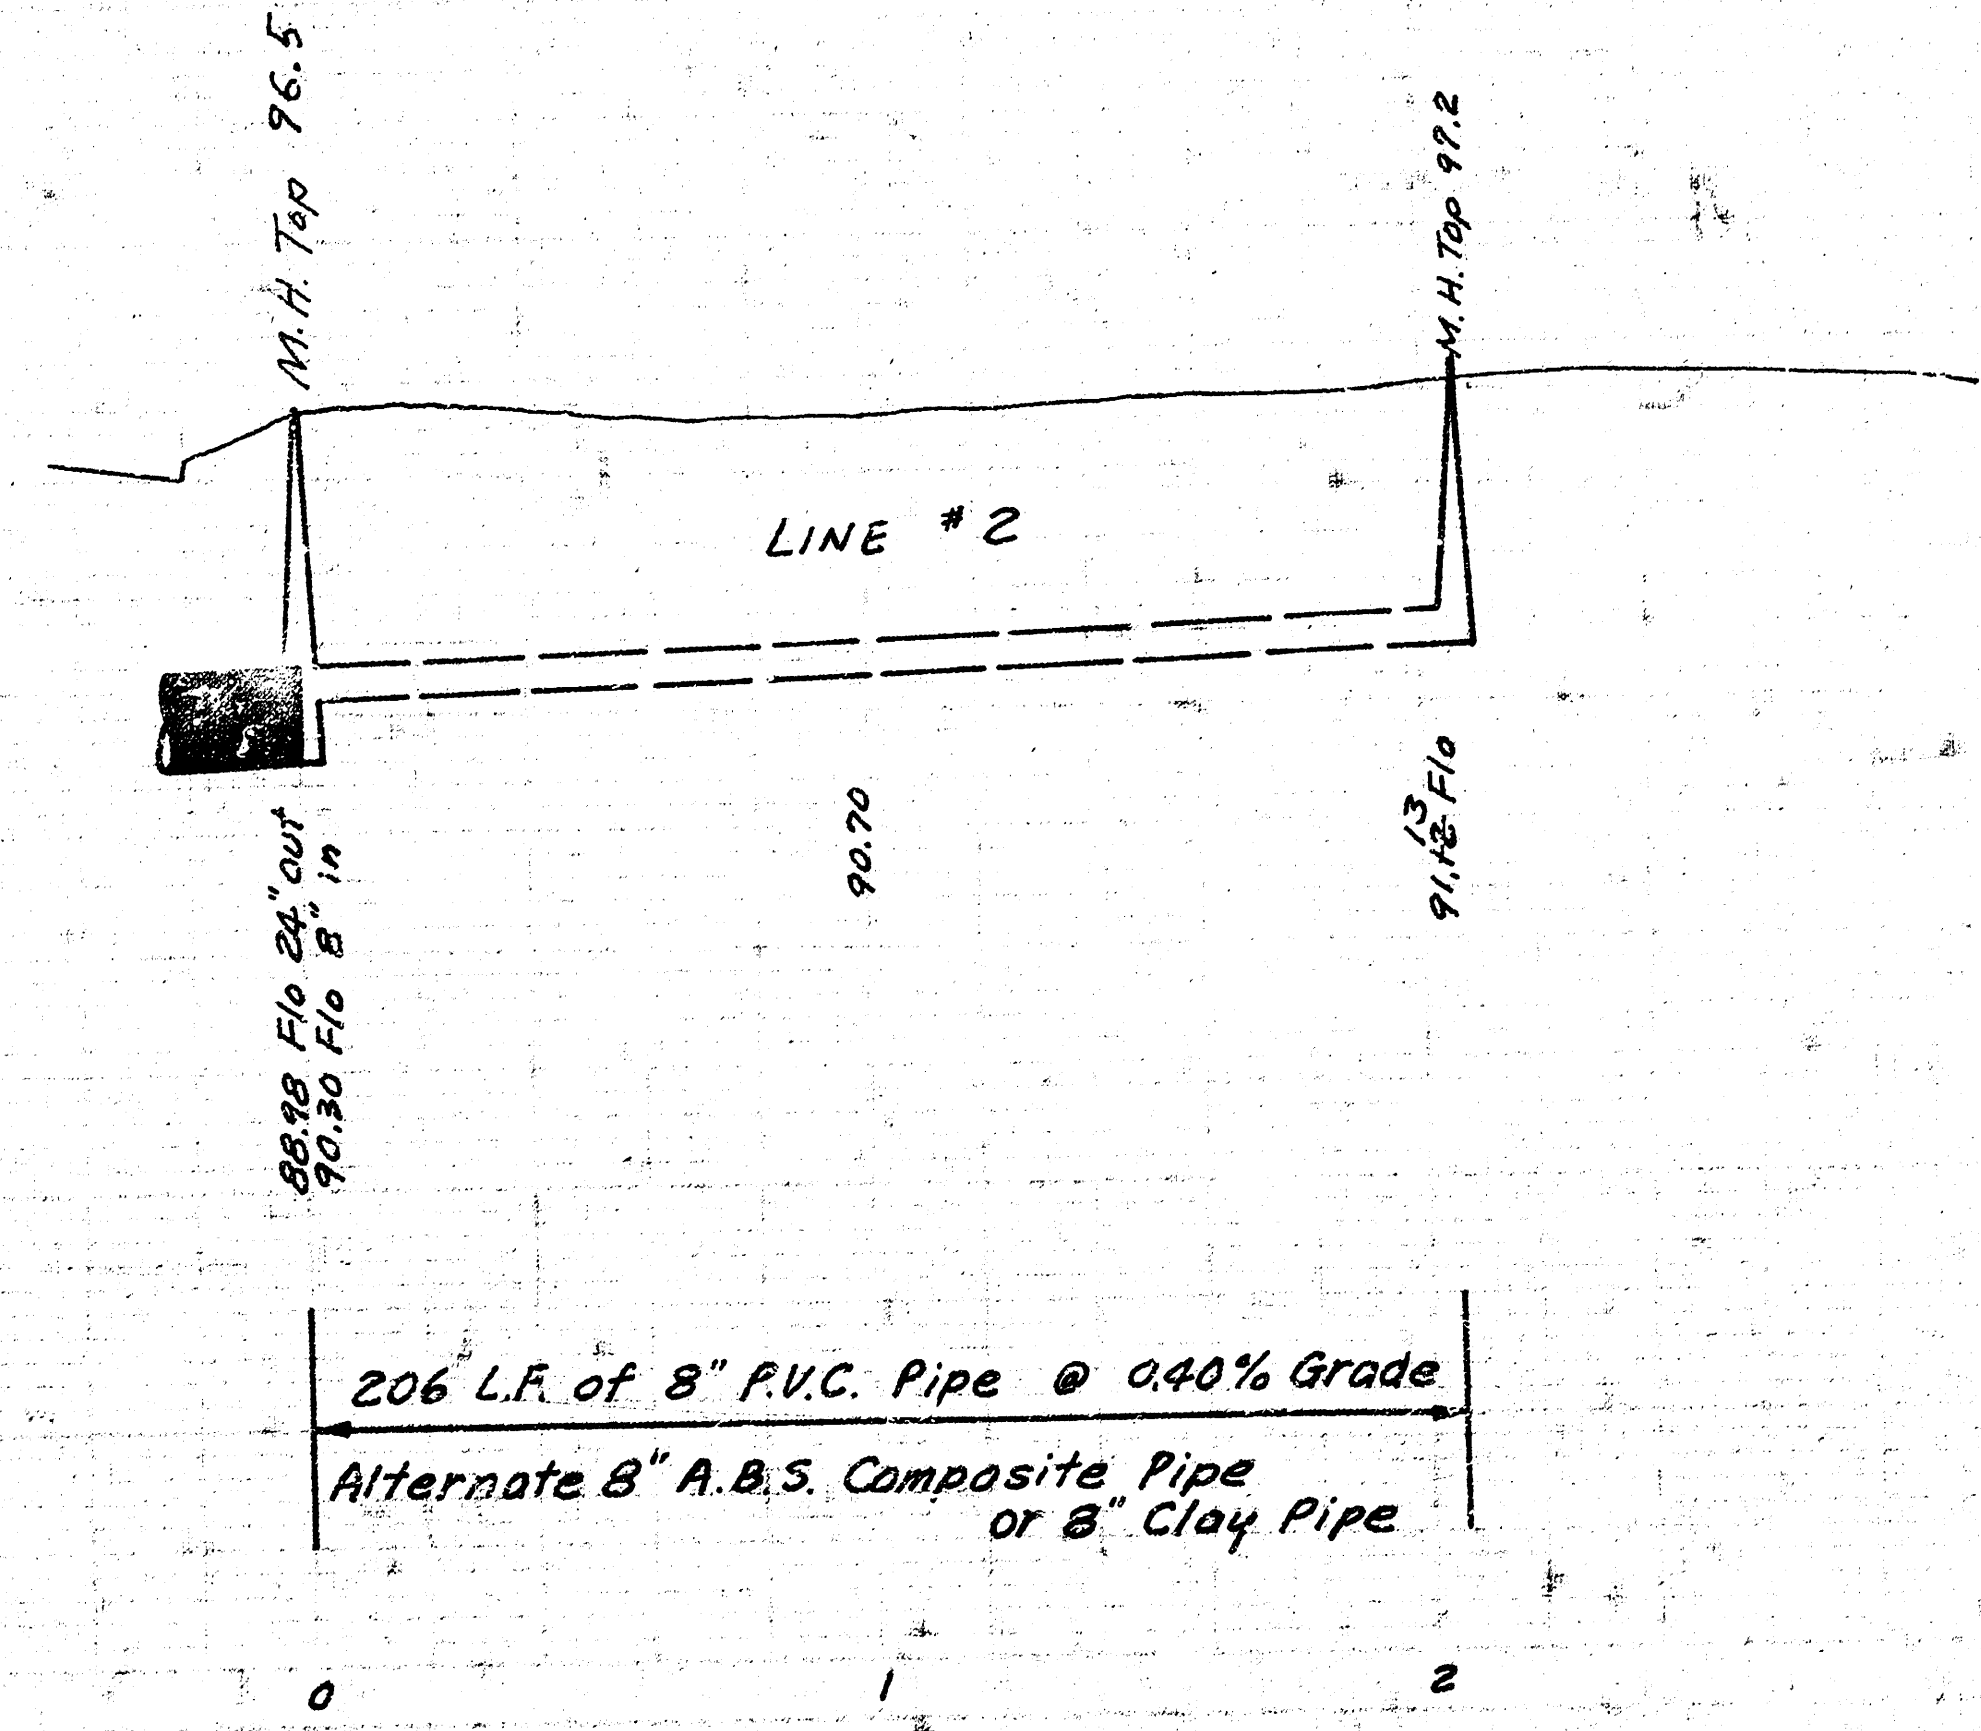

- B.M. 103.48 City Std. B.M. Disc. Hillside & Pawnee 29' N & 40.7' E of E both.
- B.M. 94.69 'a' Top of W. Curb Grove 80' N of E Pawnee.
- B.M. 98.13 SW Cor. Conc. Porch House #2602 East Pawnee.

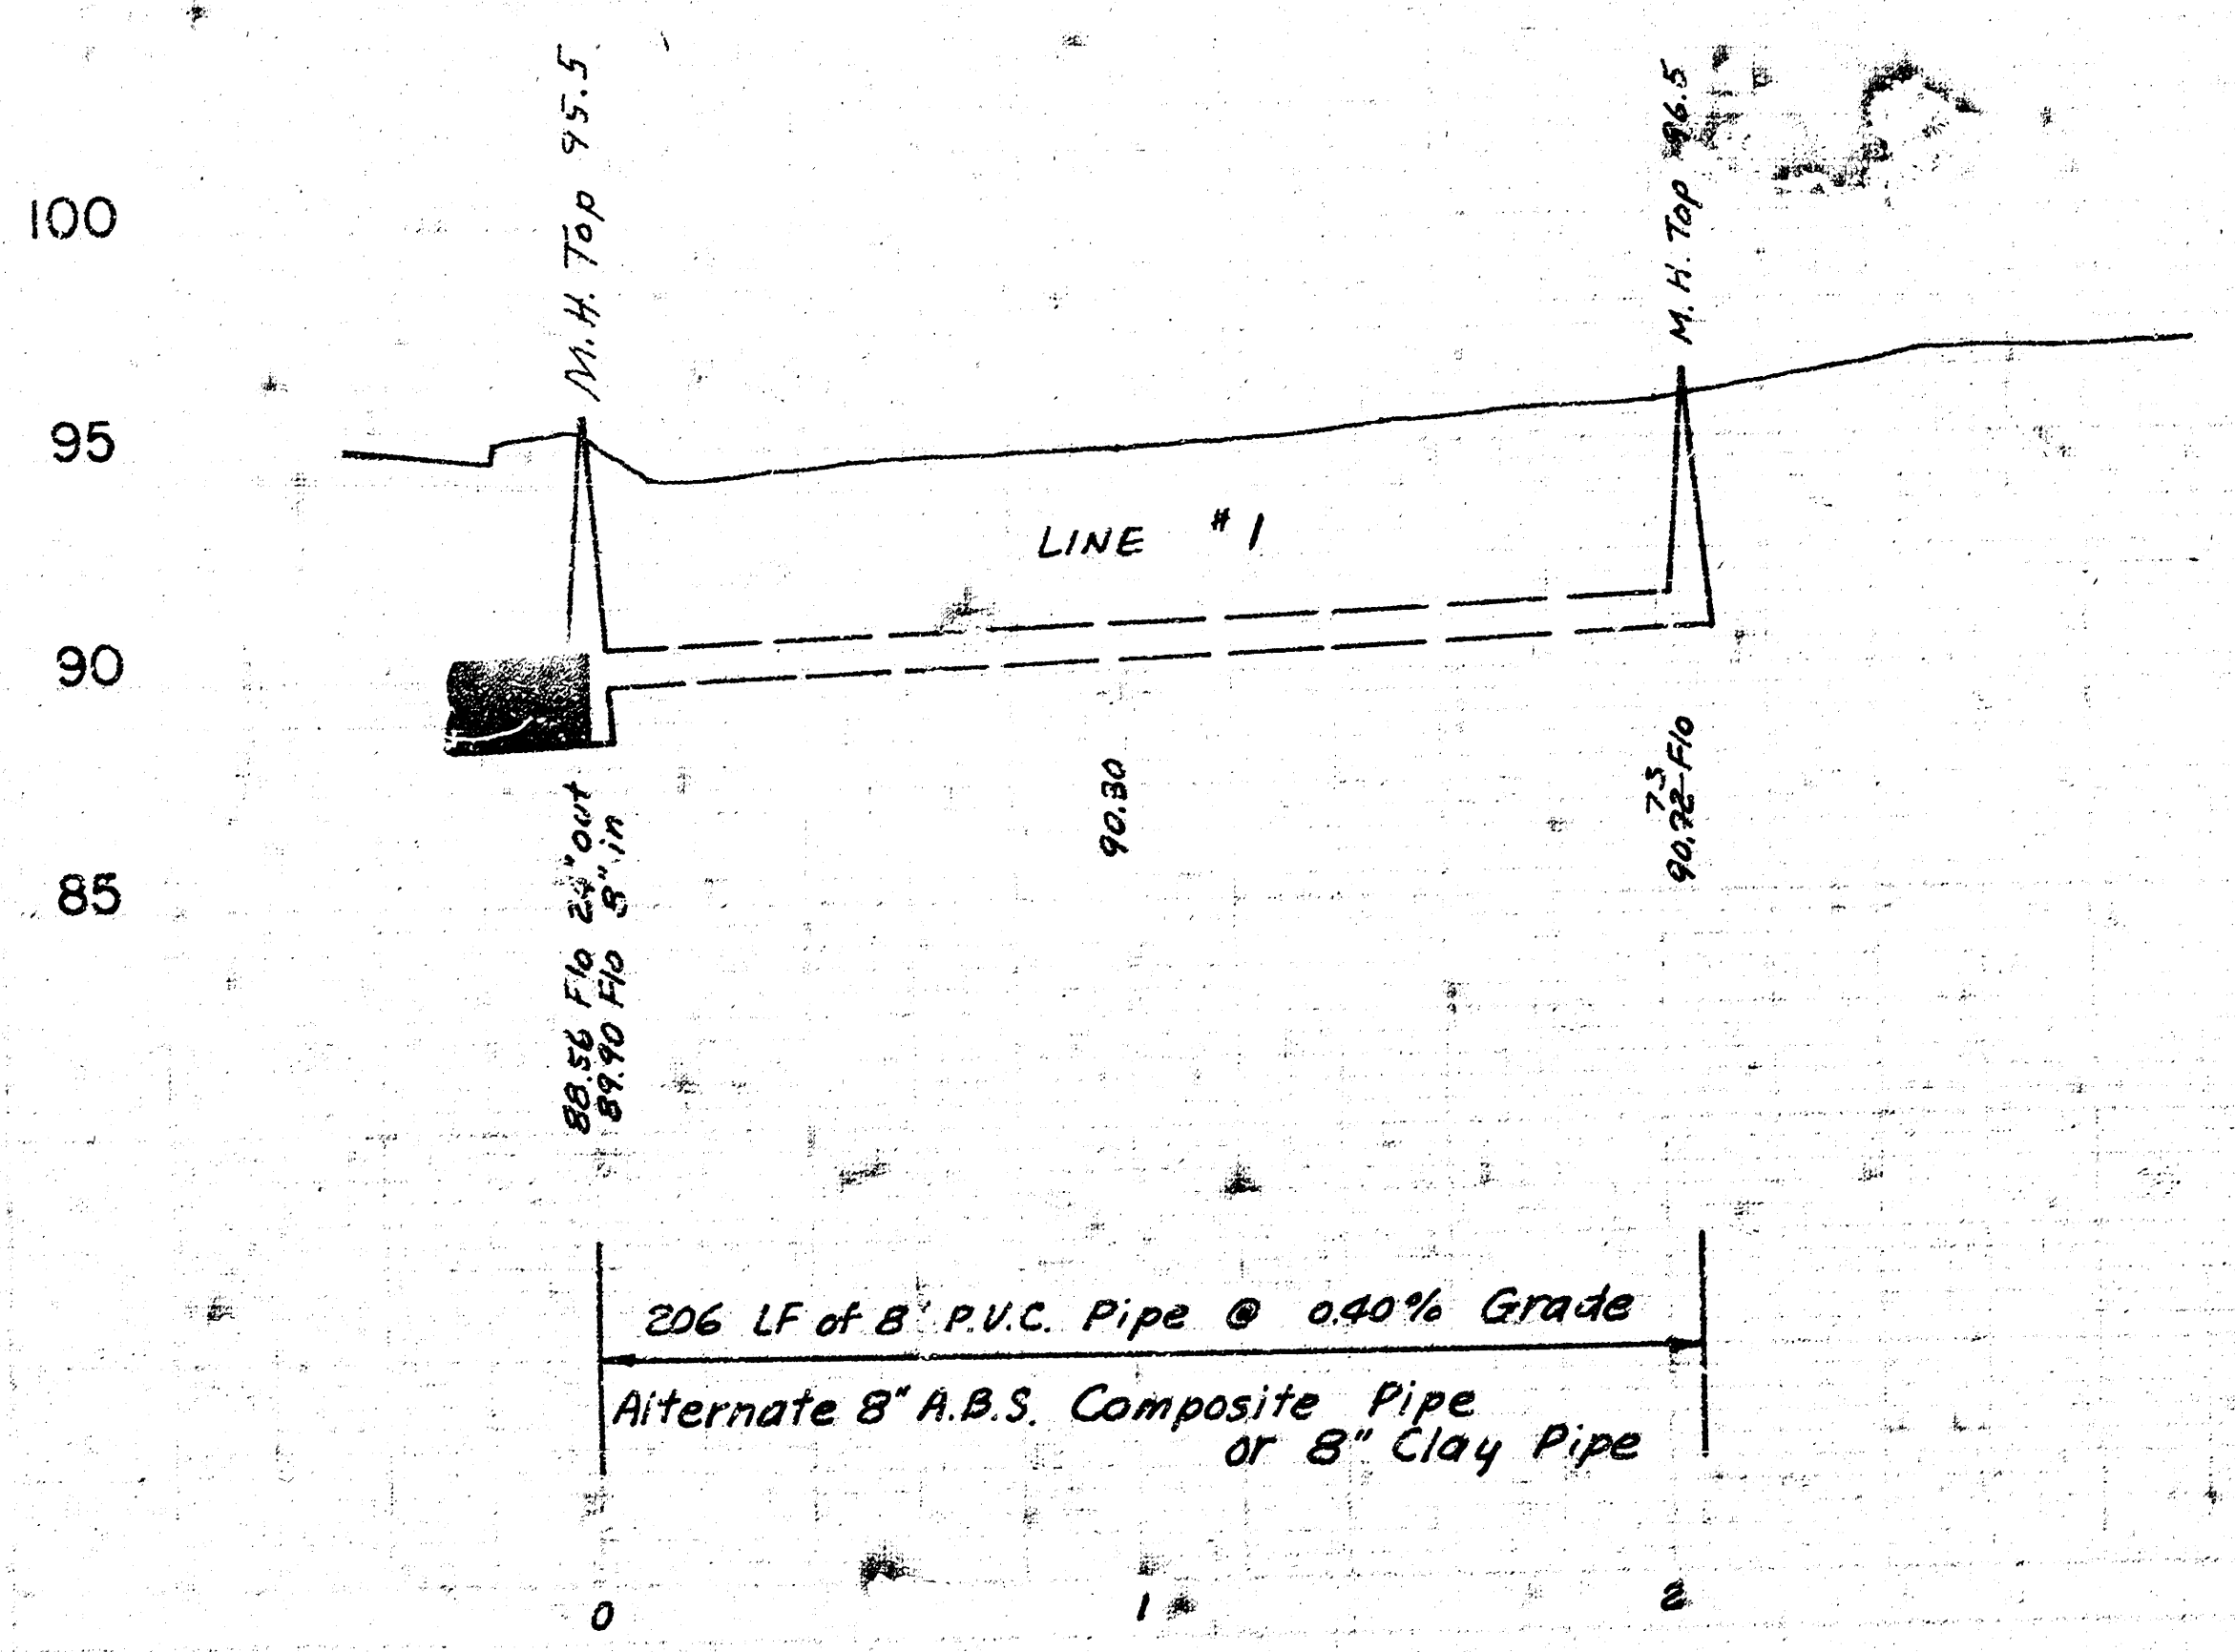

As Built
7/27/81
Jff

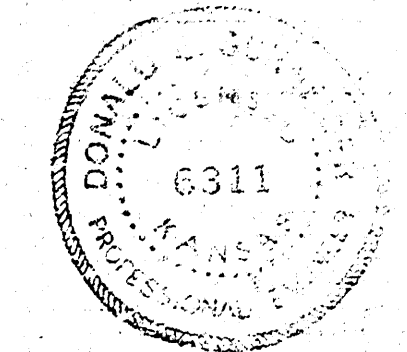

LATERAL 14, SANITARY SEWER NO. 12
CITY OF WICHITA
R.W. BRUGGEMAN
DIRECTOR OF ENGINEERING - CITY ENGINEER
PROJ. NO. 468-76-245-81054-000-000-001