


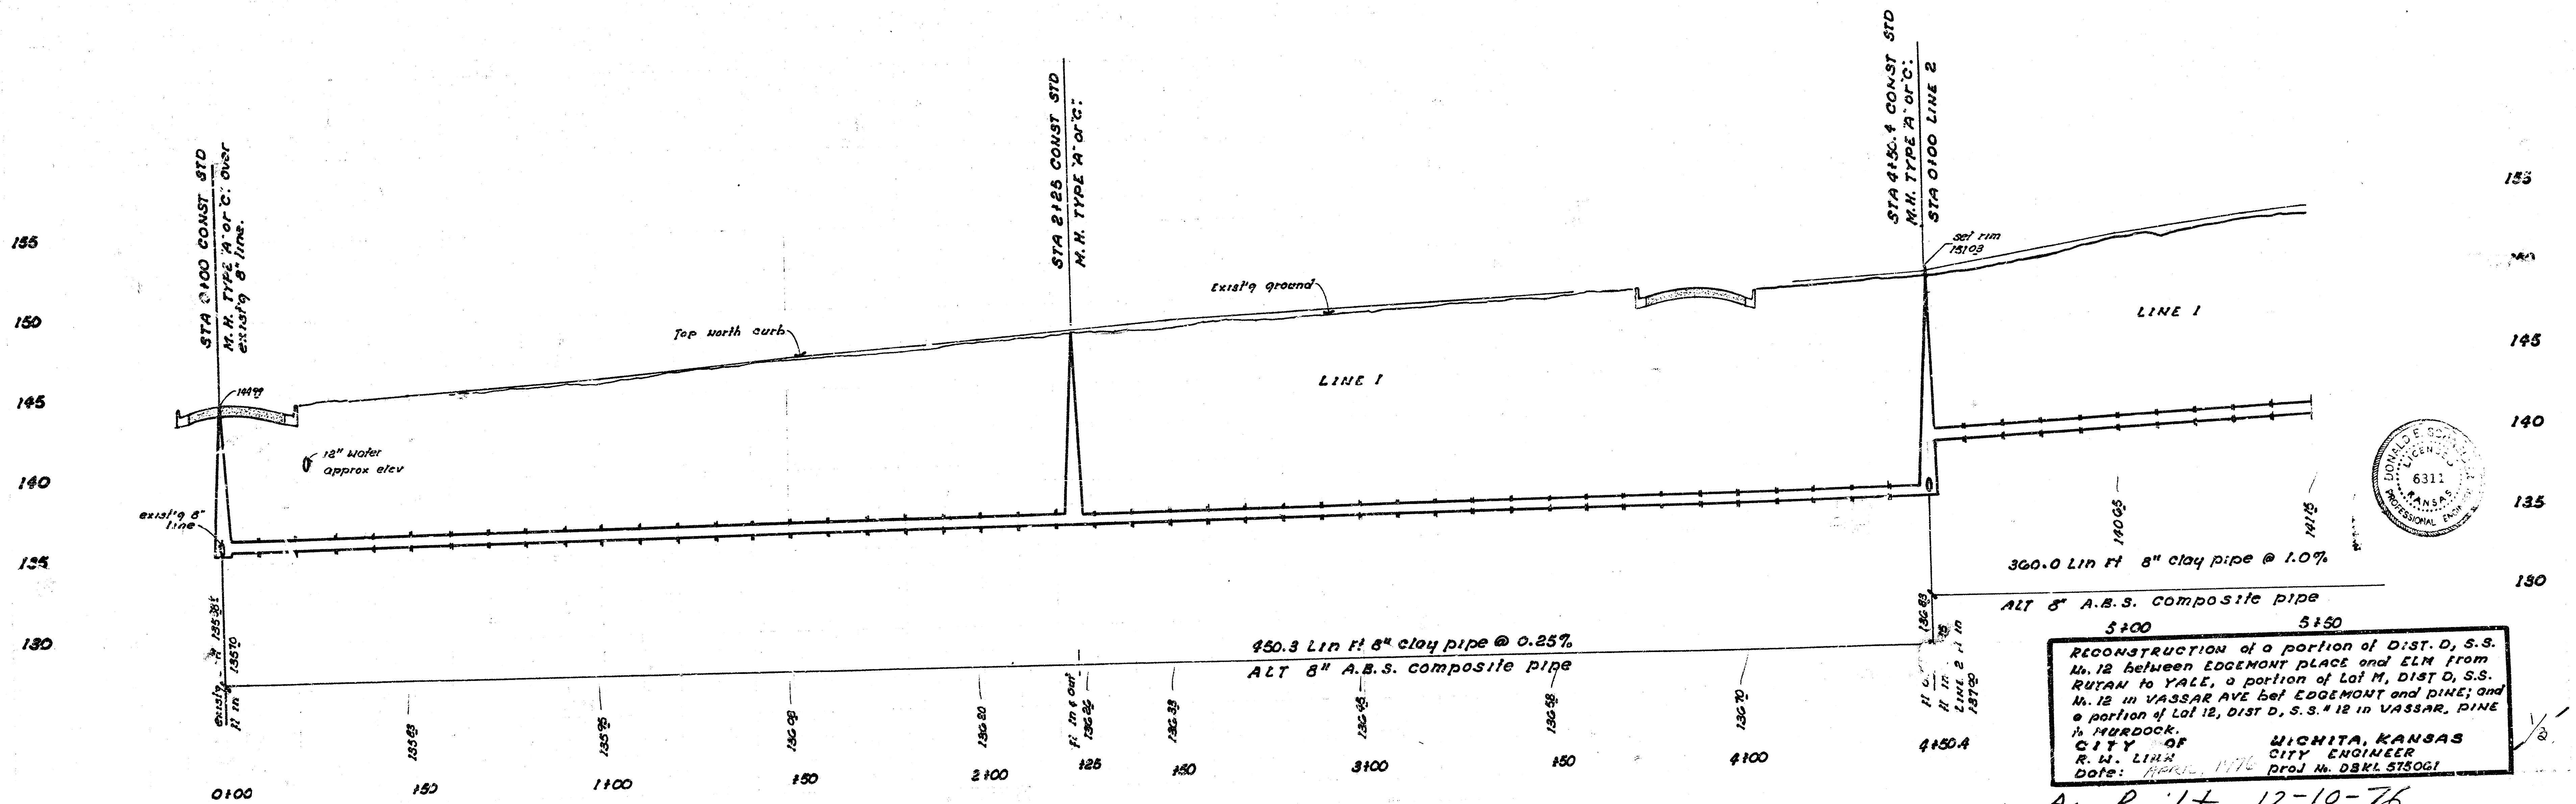


B.M. 1517 "D" TOP 50. CURB EDGEMONT 9' E. of E.L. RUTAN

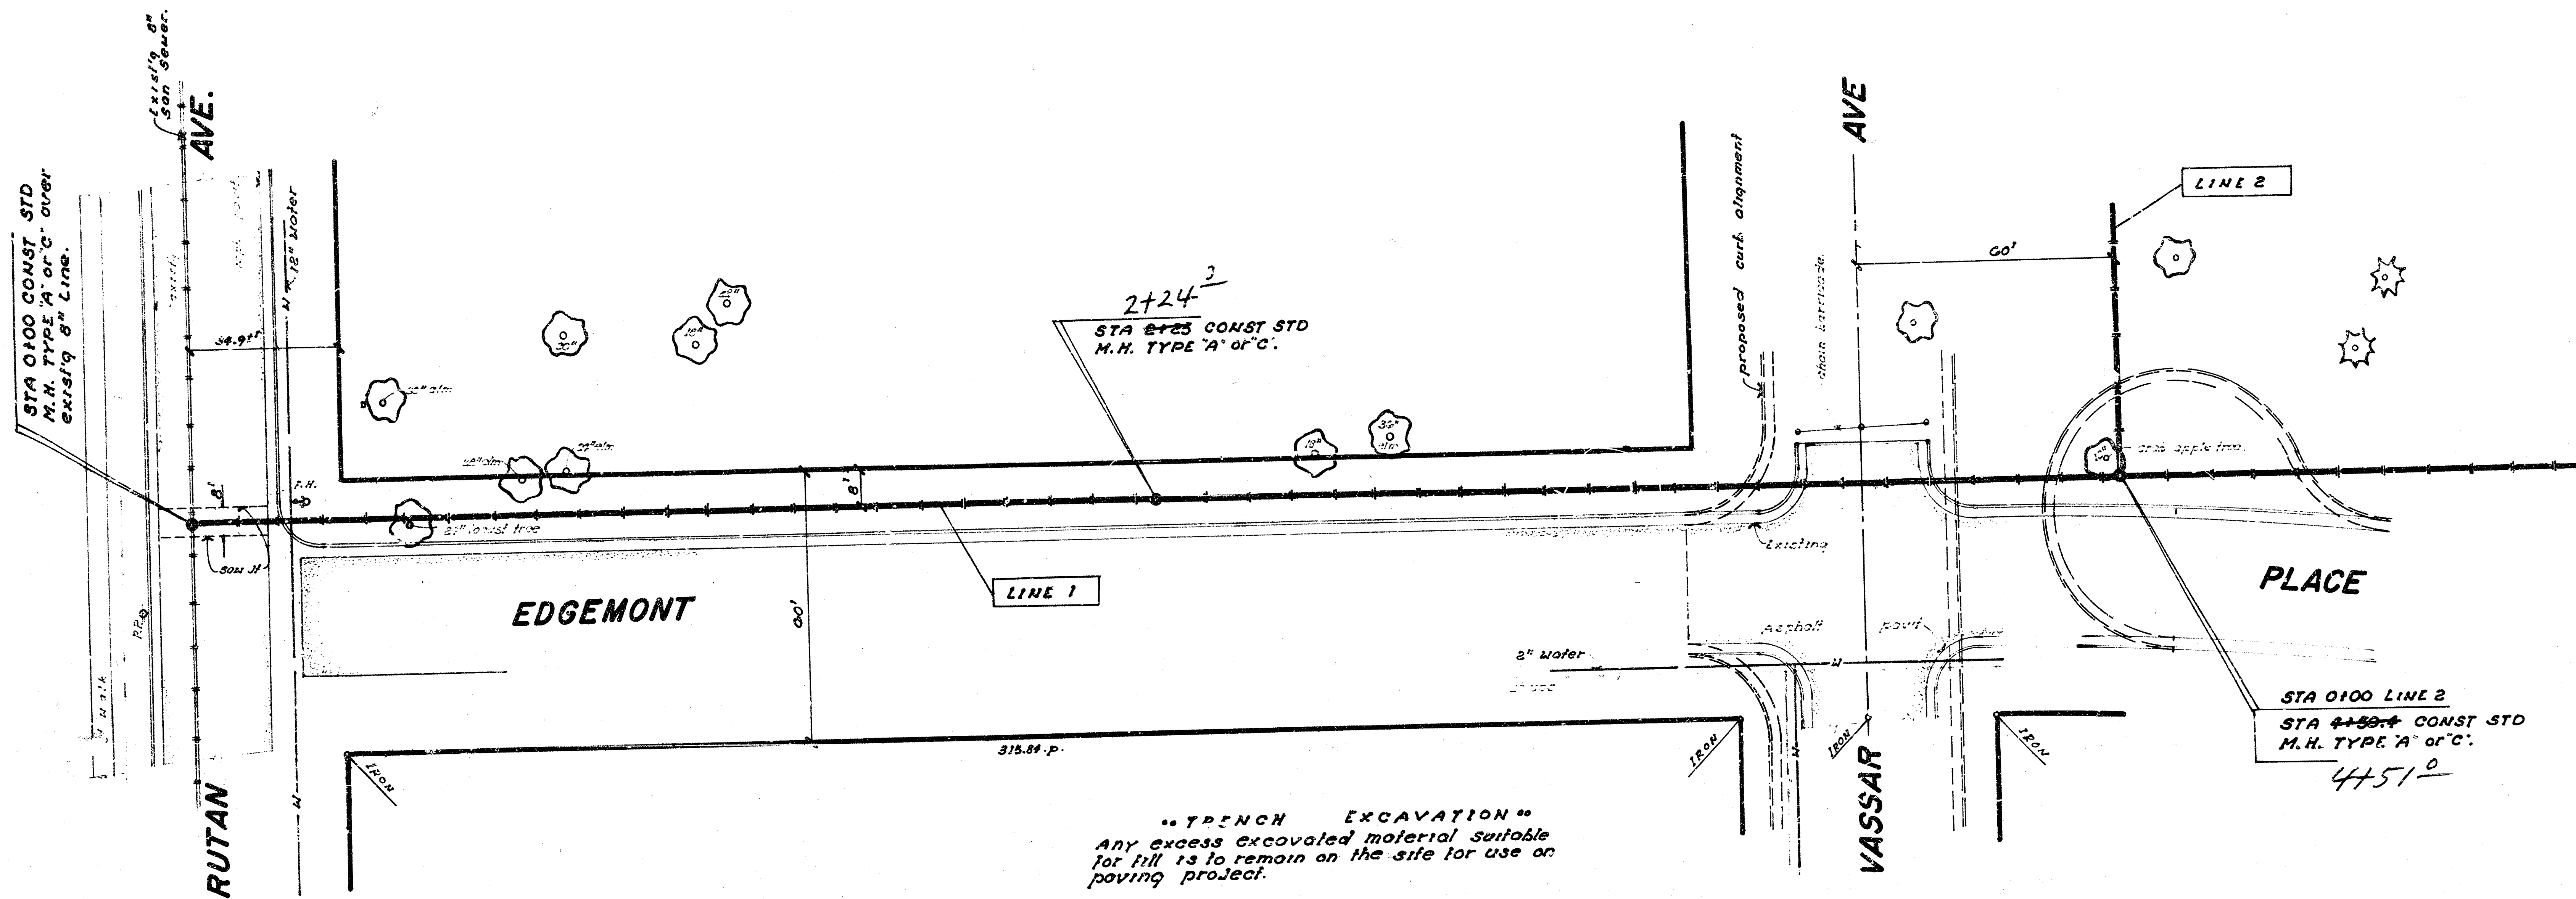


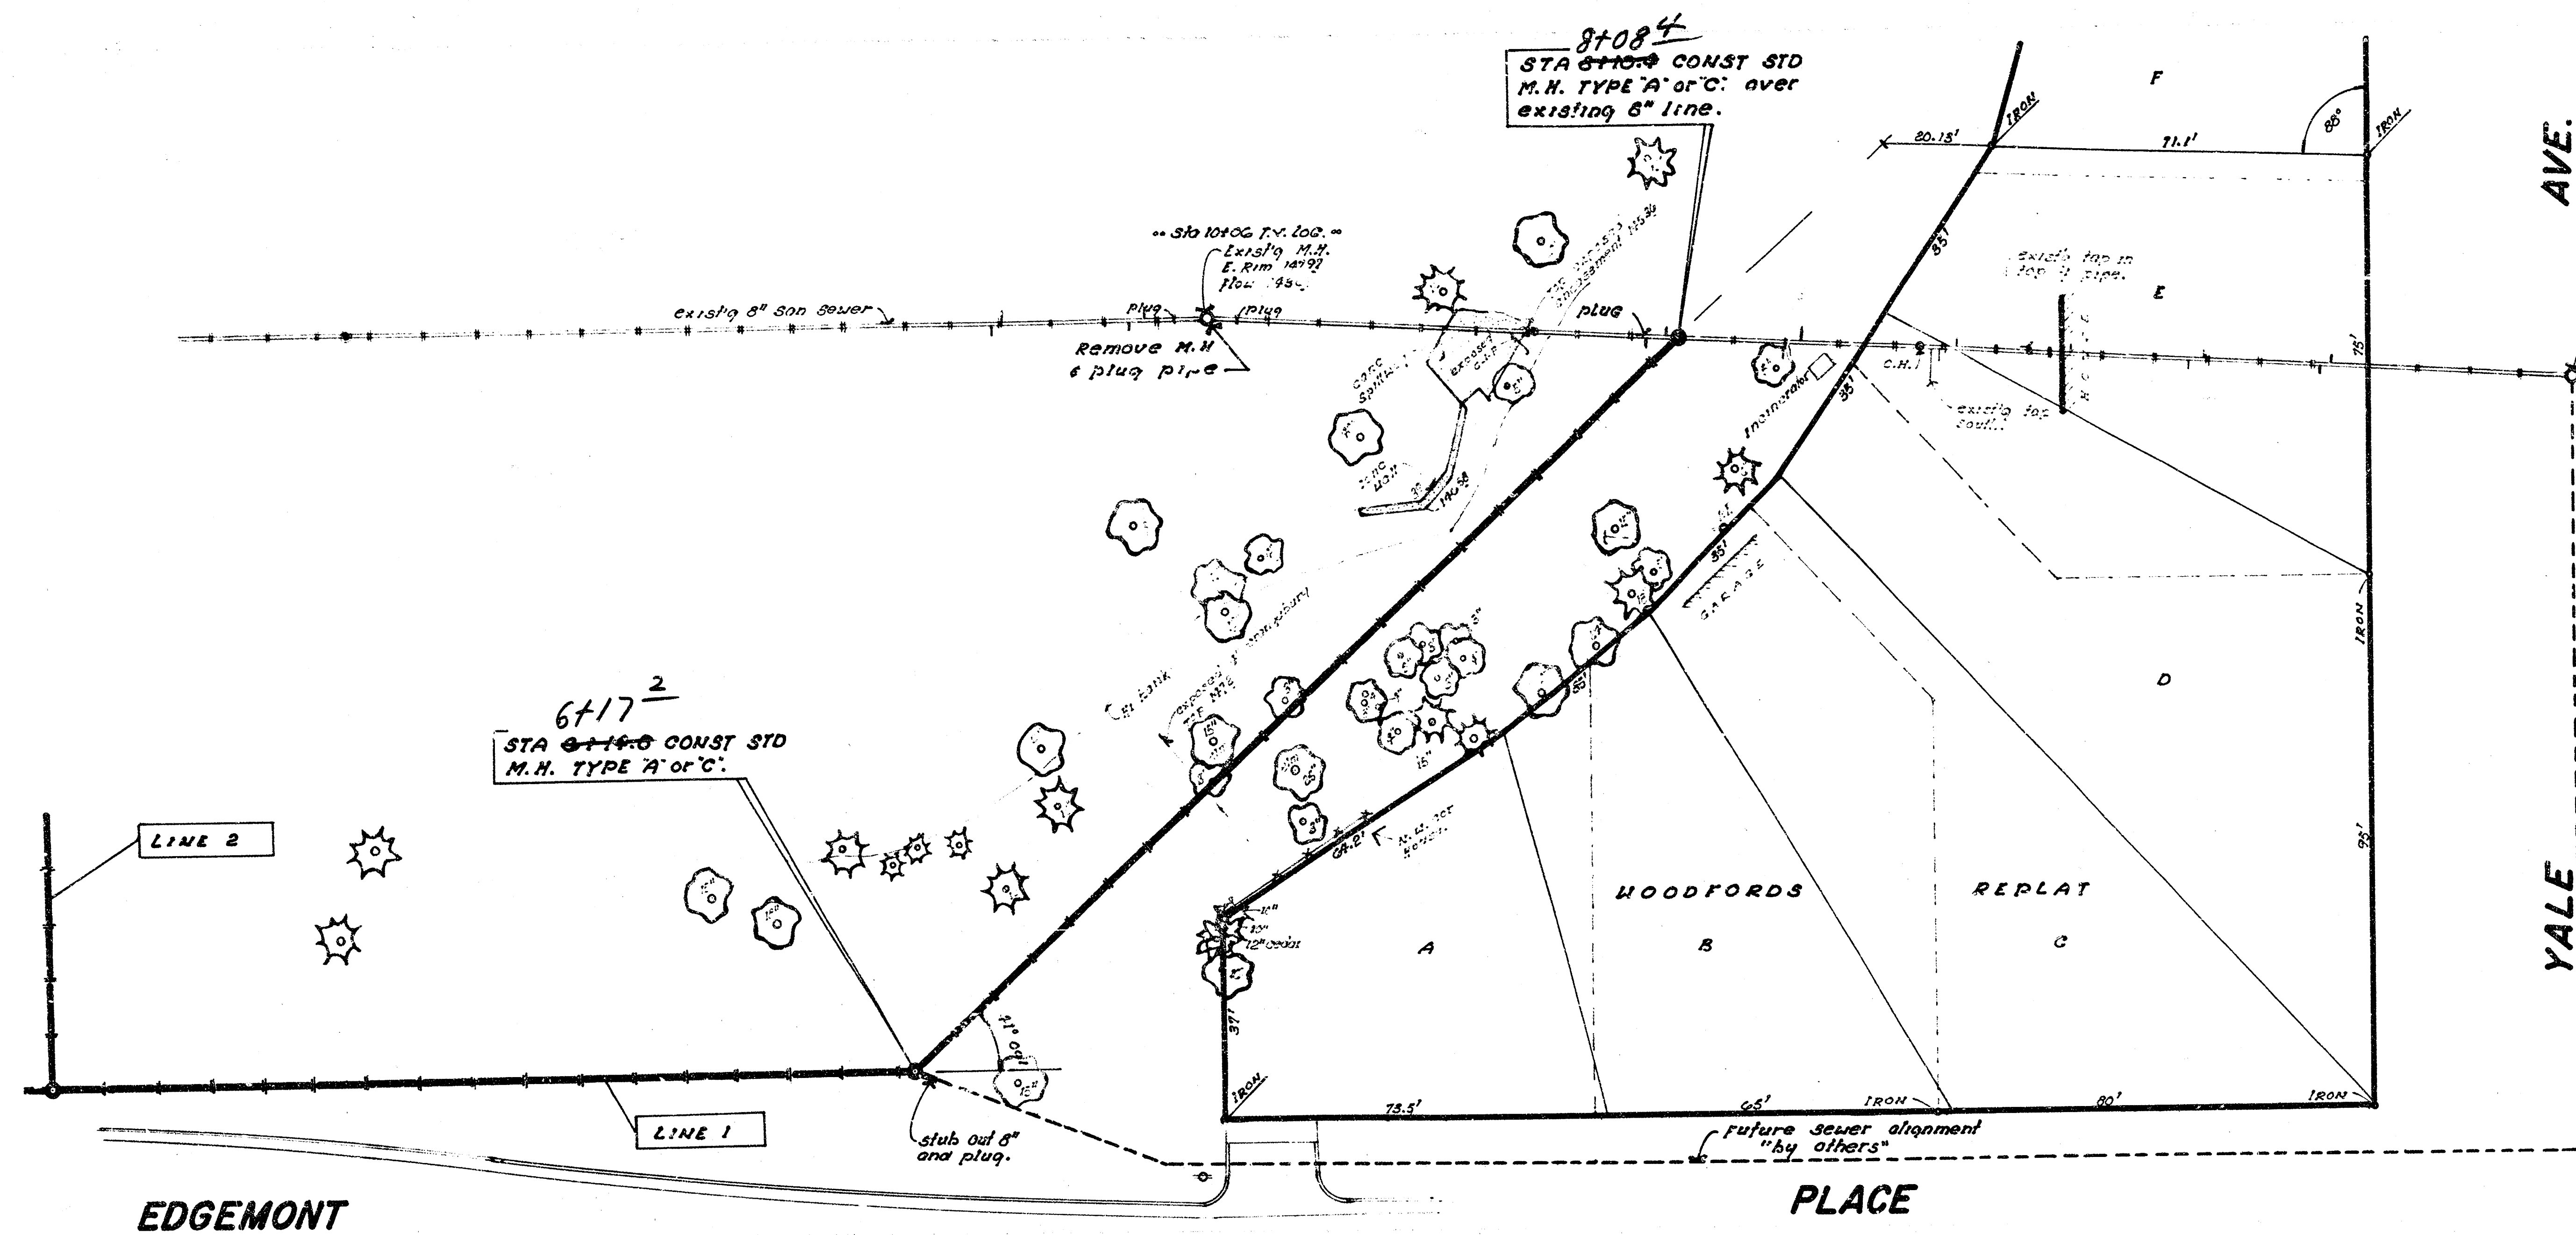


“SERVICE CONNECTIONS”
 NOTE: Contractor to determine the location of existing service connections for houses on lots A thru F WOODFORDS REPLAT. Service lines re connected to be paid as price bid for service connections.

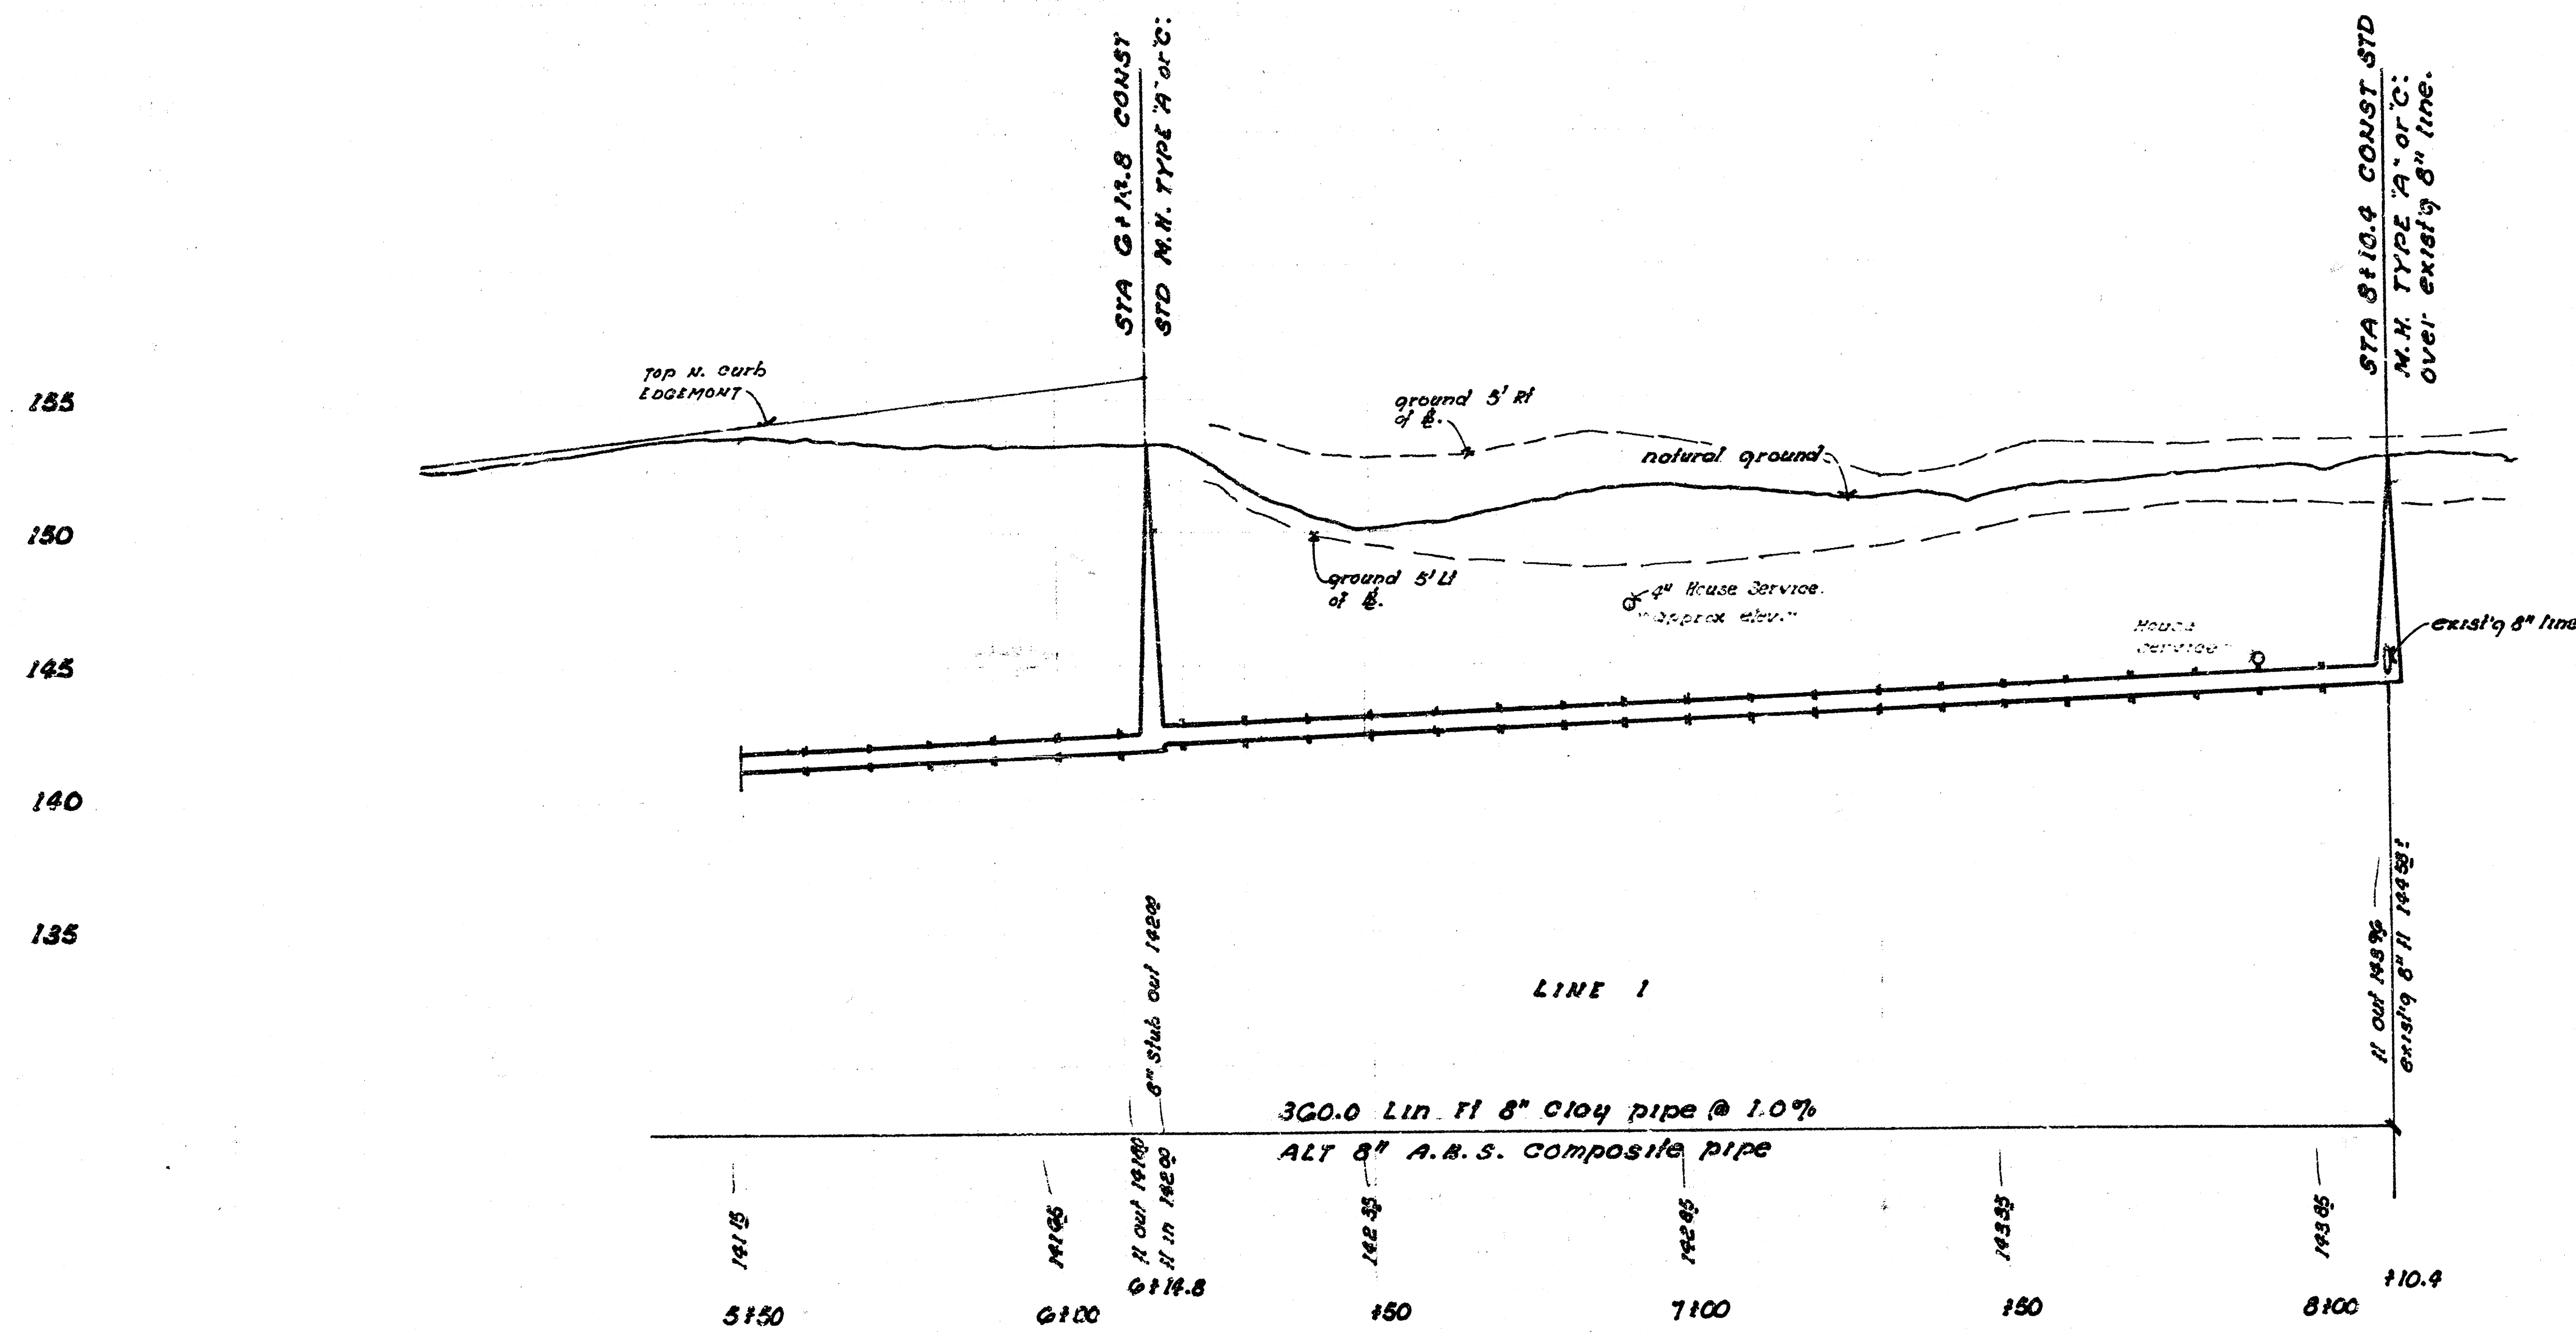

155
150
145
140
135

2/2

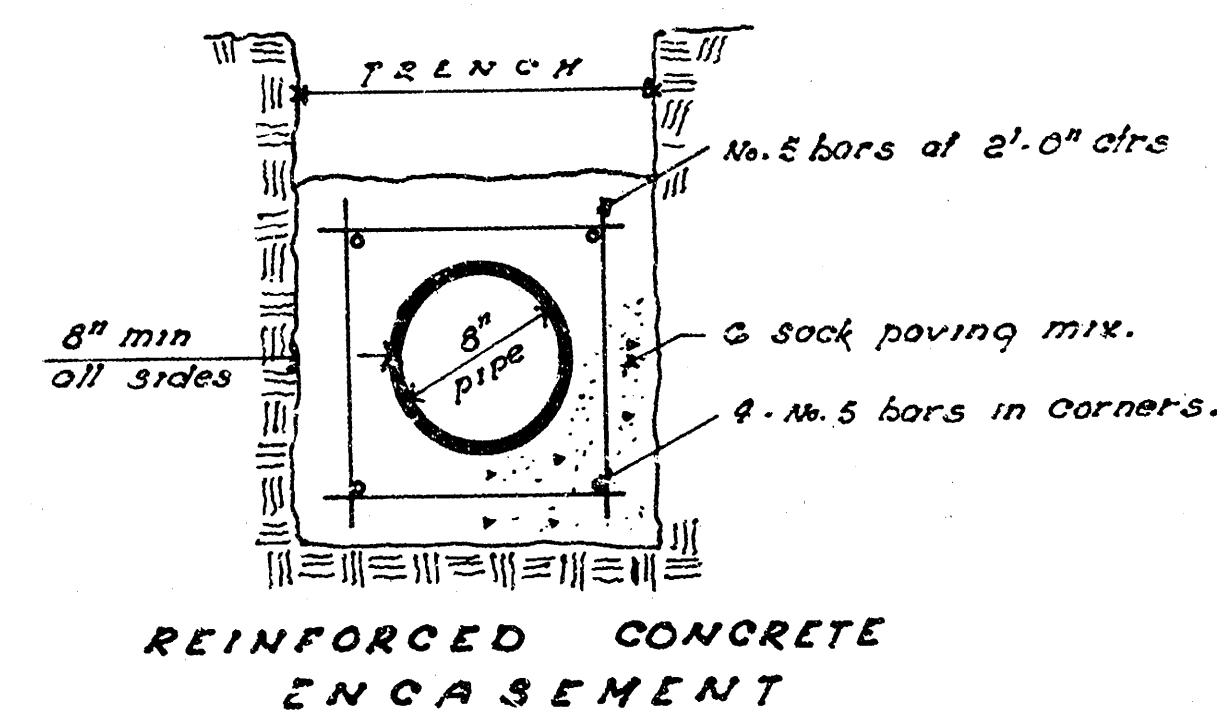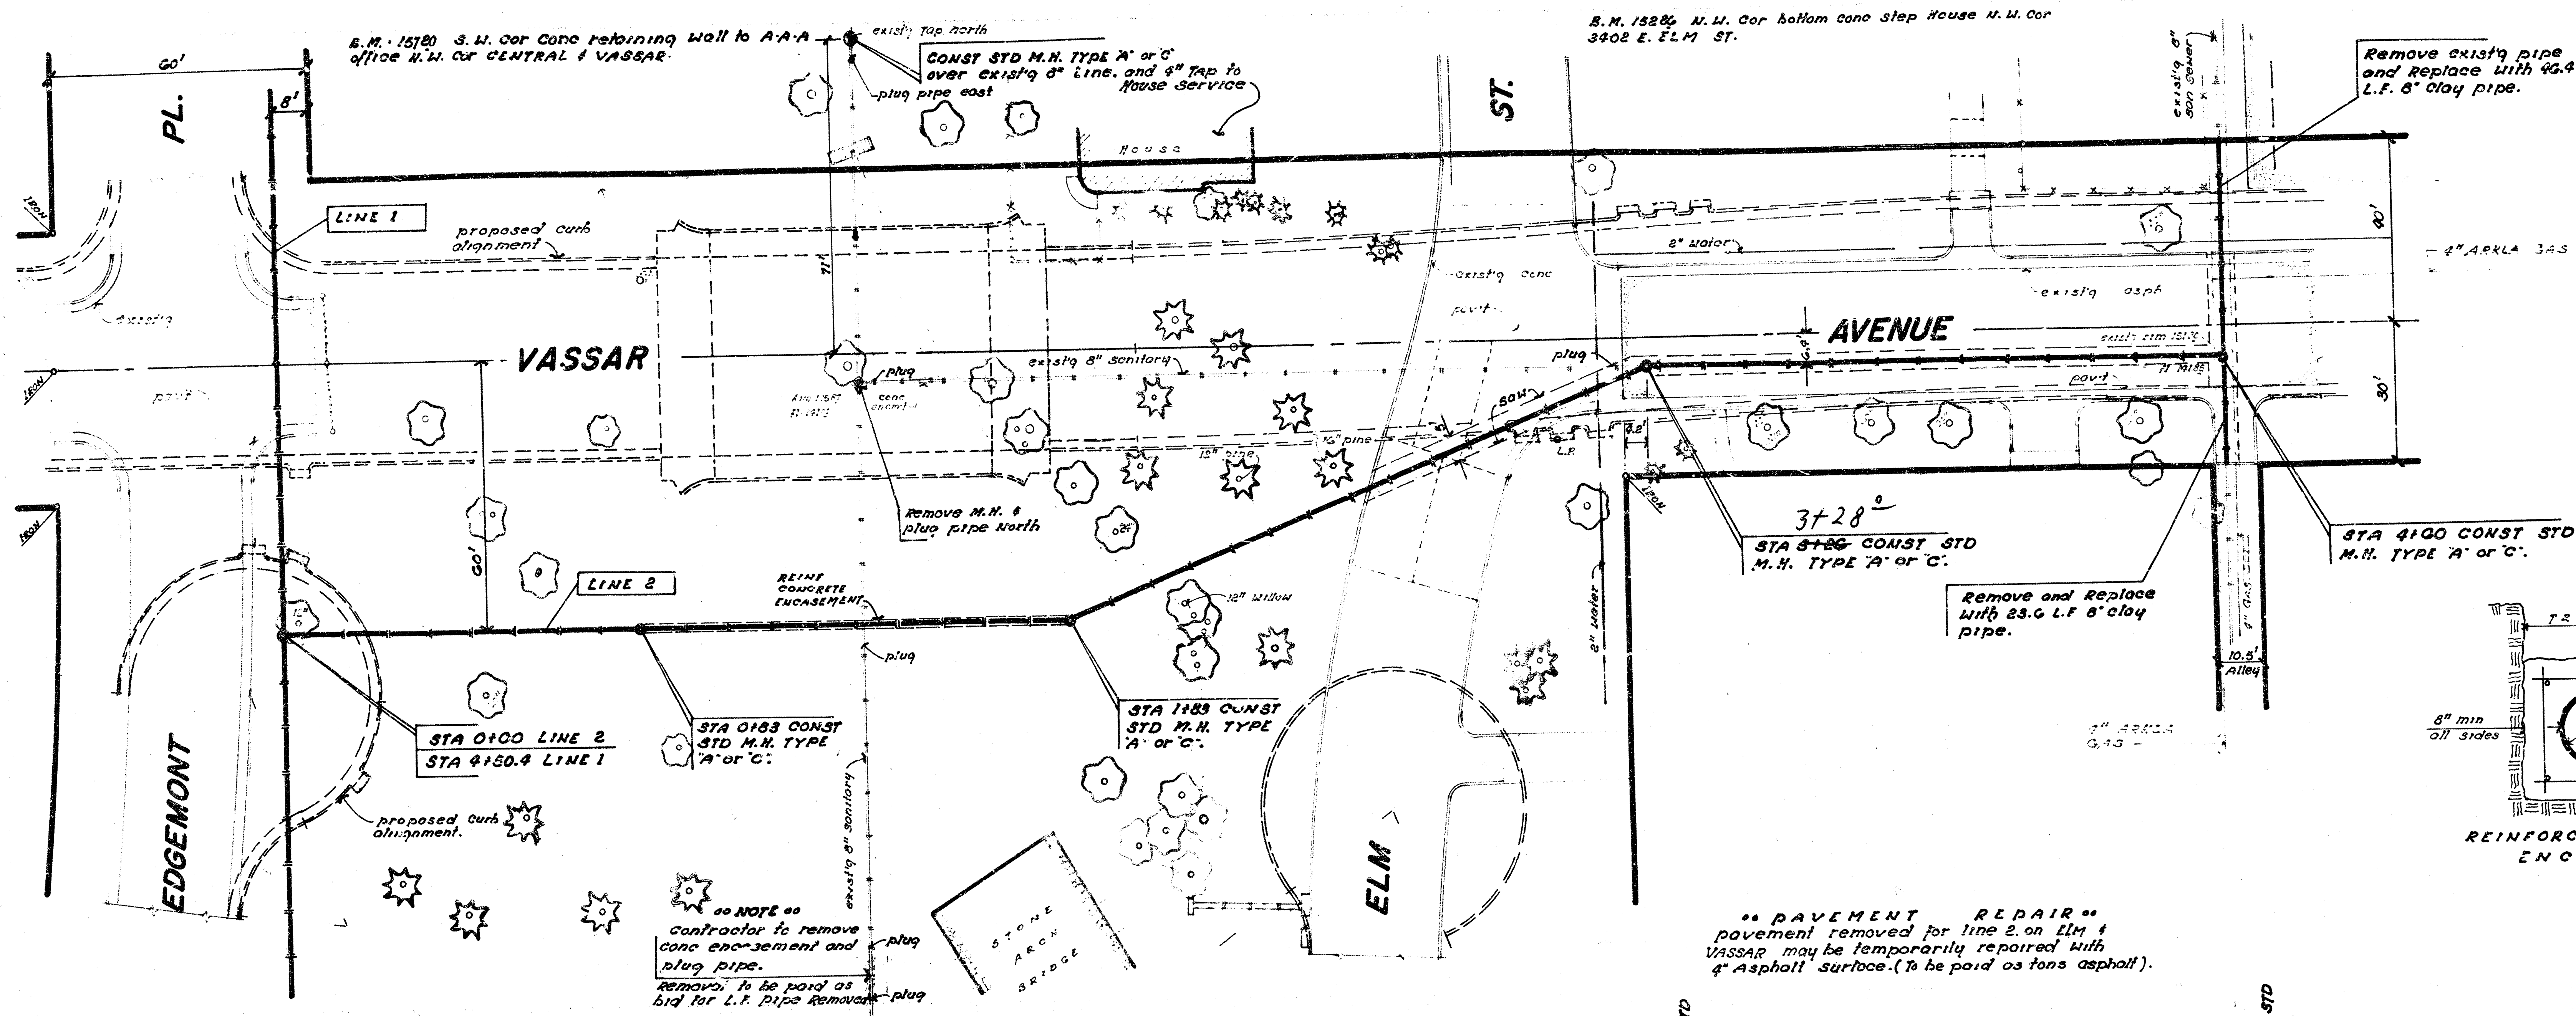

PLAN SCALE 1" = 20'
 profile 1" = 20' Horiz
 1" = 5' Vert

