



174' Approx. 425' N. N.E. Central
200'

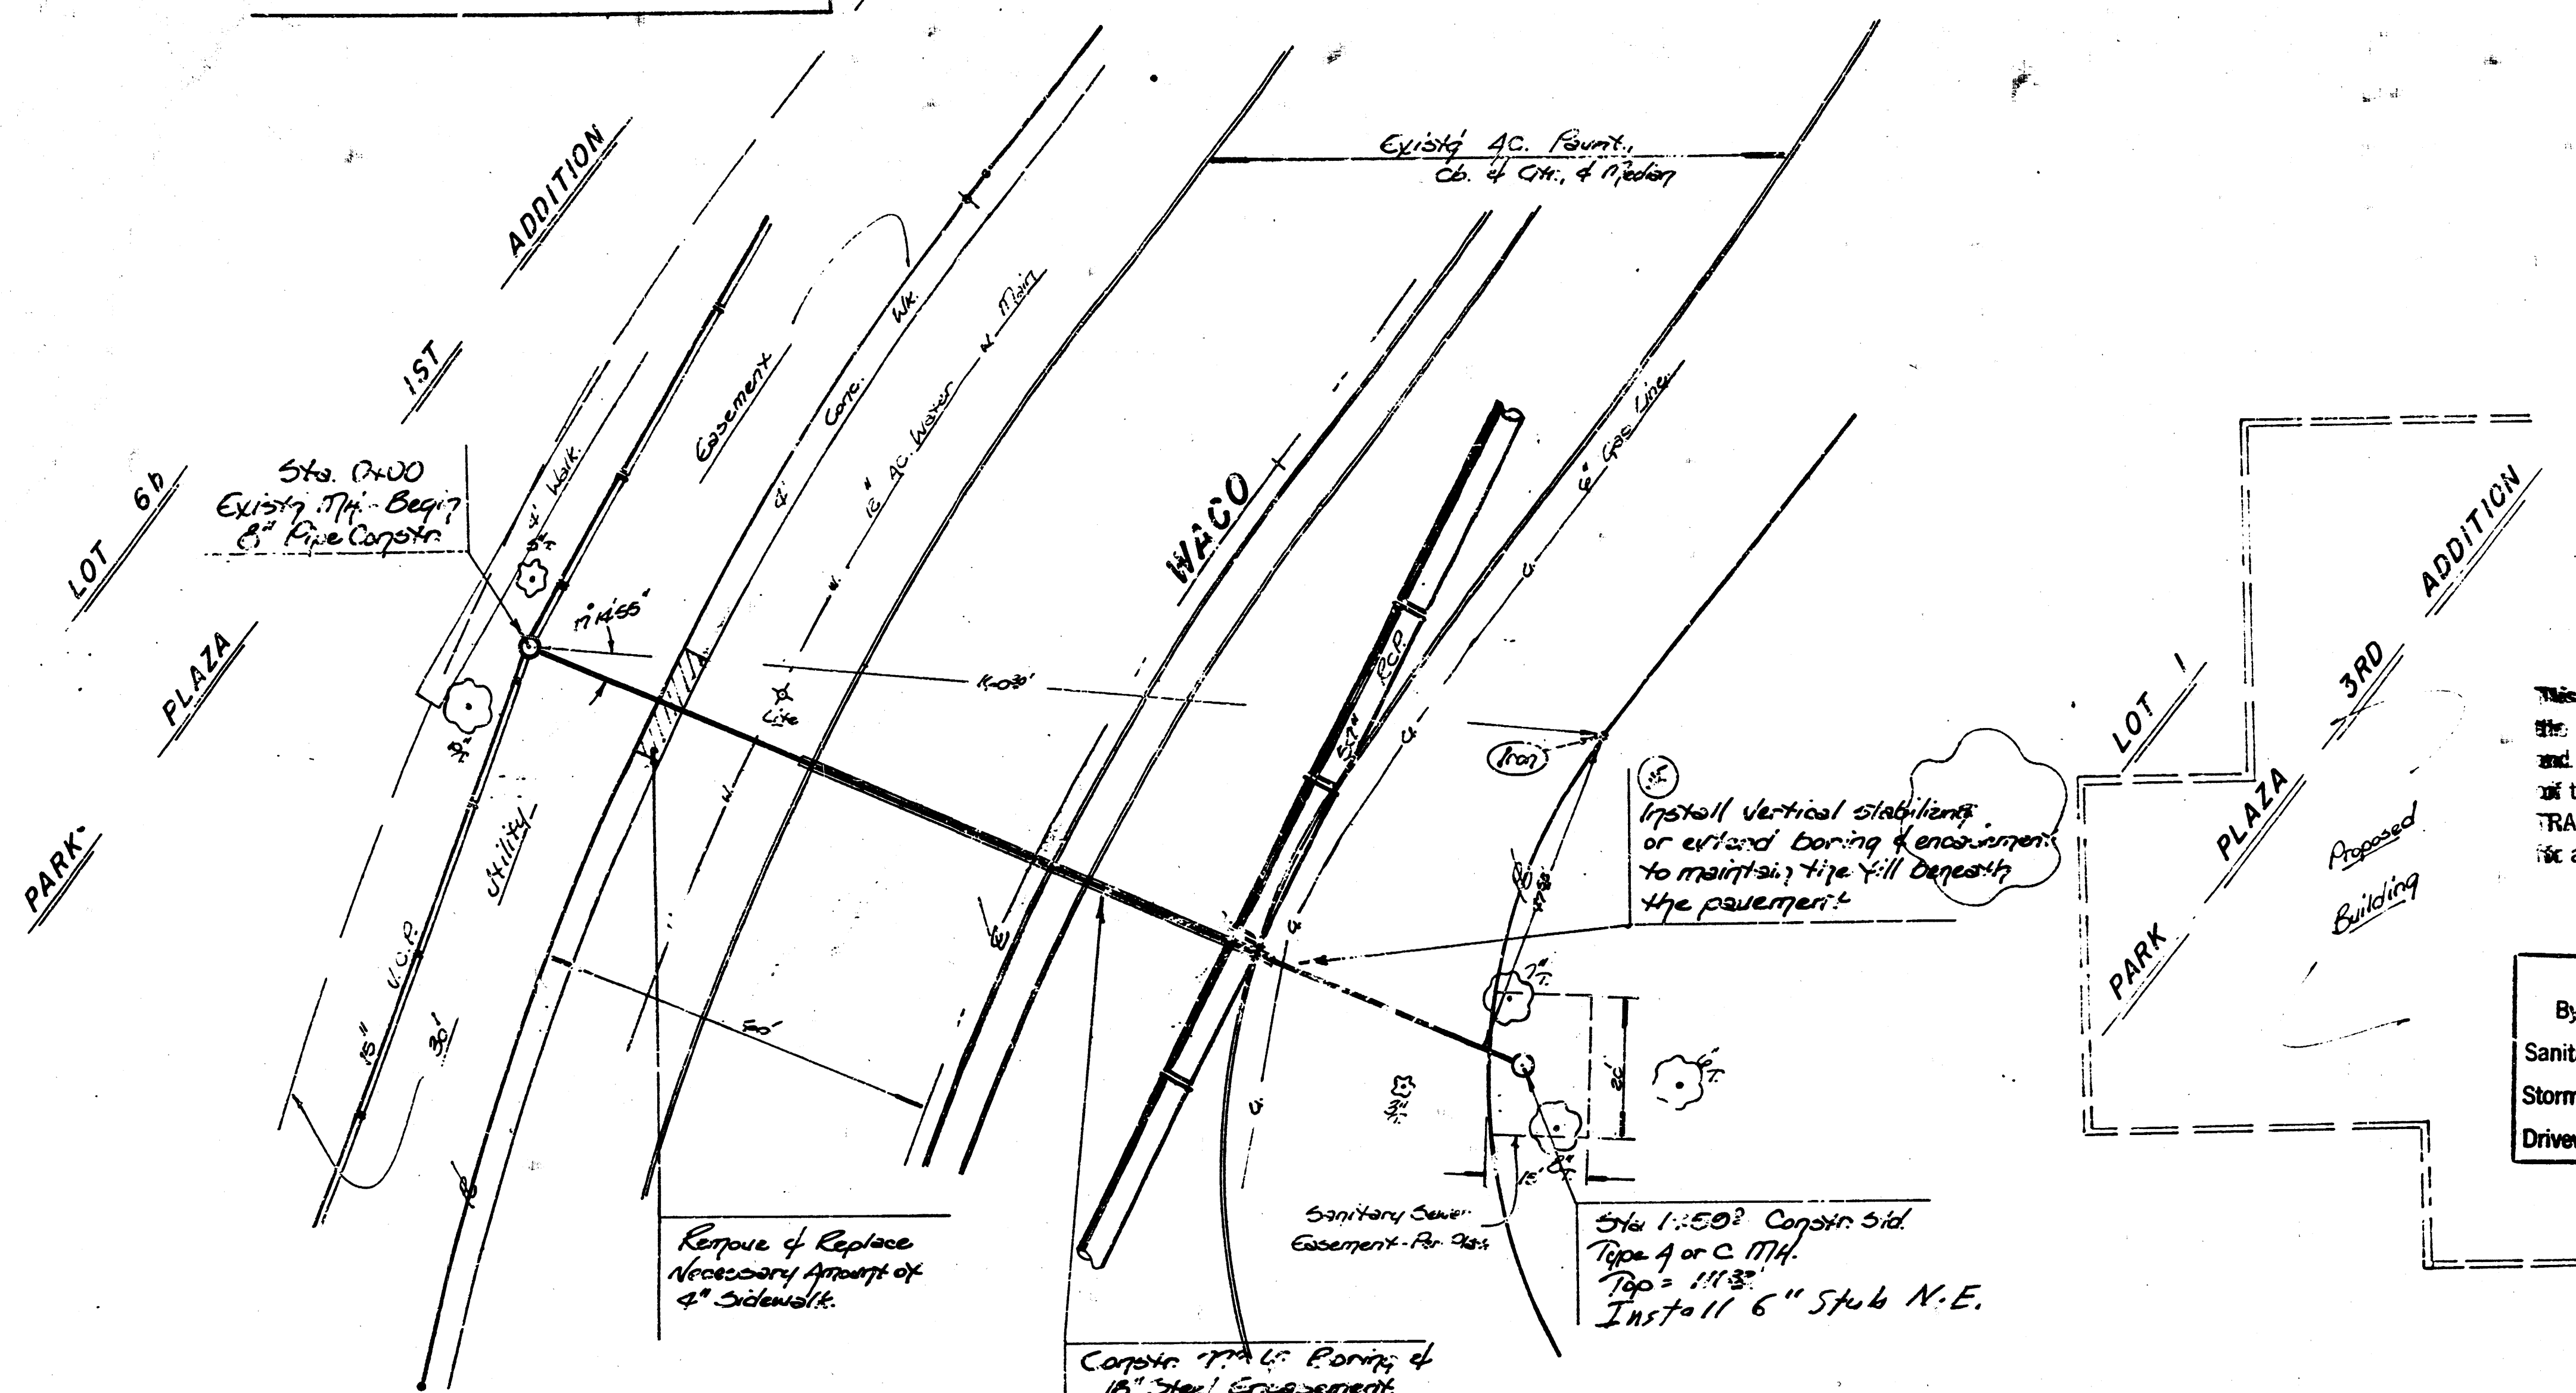



Scale: 1" = 20' Plan
1" = 5' Profile View
1" = 20'

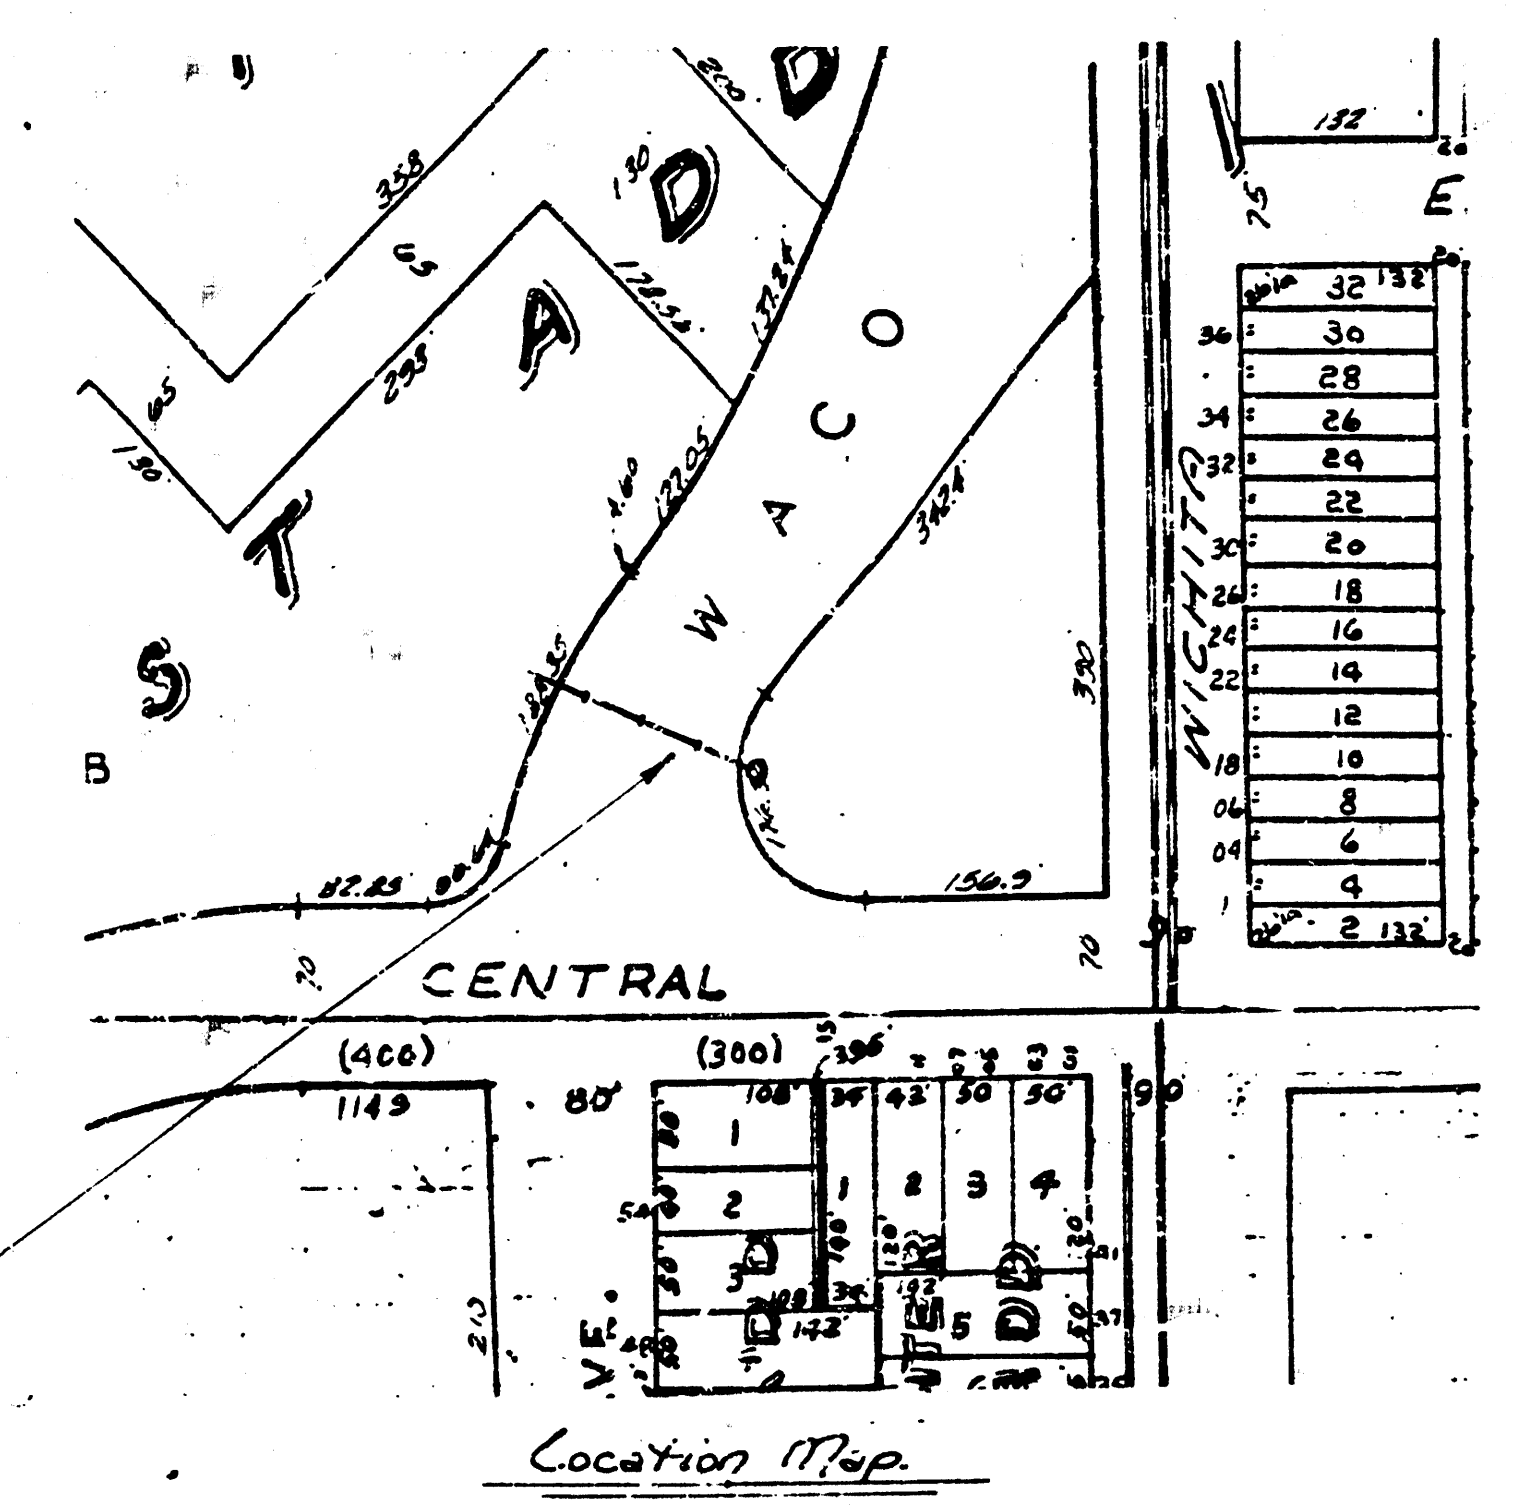

NOTE TO CONTRACTOR
This project will be constructed under the supervision of the CITY ENGINEER and conforming to the SPECIFICATIONS of the CITY OF WICHITA. The CONTRACTOR will prepay the City of Wichita for all costs of inspection.



7-23-82

APPROVED AS NOTED
By CITY ENGINEER OF WICHITA
Sanitary Sewers
Storm Sewers
Driveway Approaches

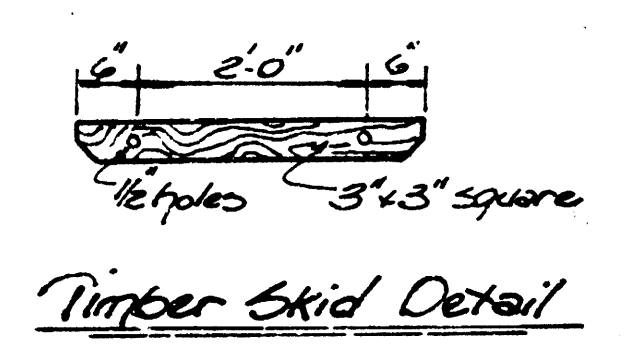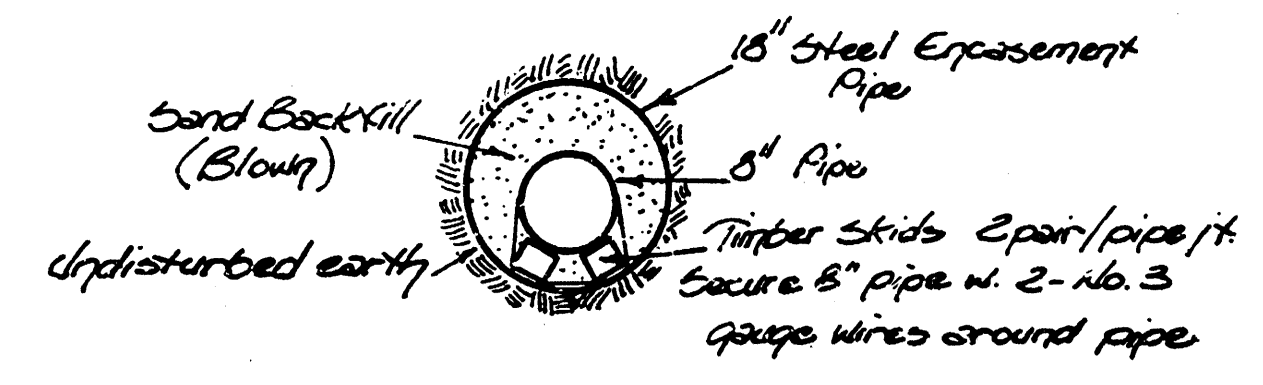

Note:
Contractor to verify all existing underground lines in the vicinity of the construction.
Boring construction shall conform to City of Wichita specifications.
Contractor to utilize vertical stabilizing or extend the boring & encasement to maintain the fill depth of the pavement.

PROFILE
DATE
BY
CHECKED
NOTED
STRUCTURE NOTATION
NO. 1000-1

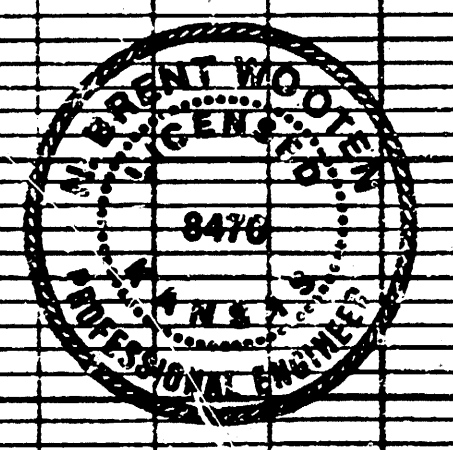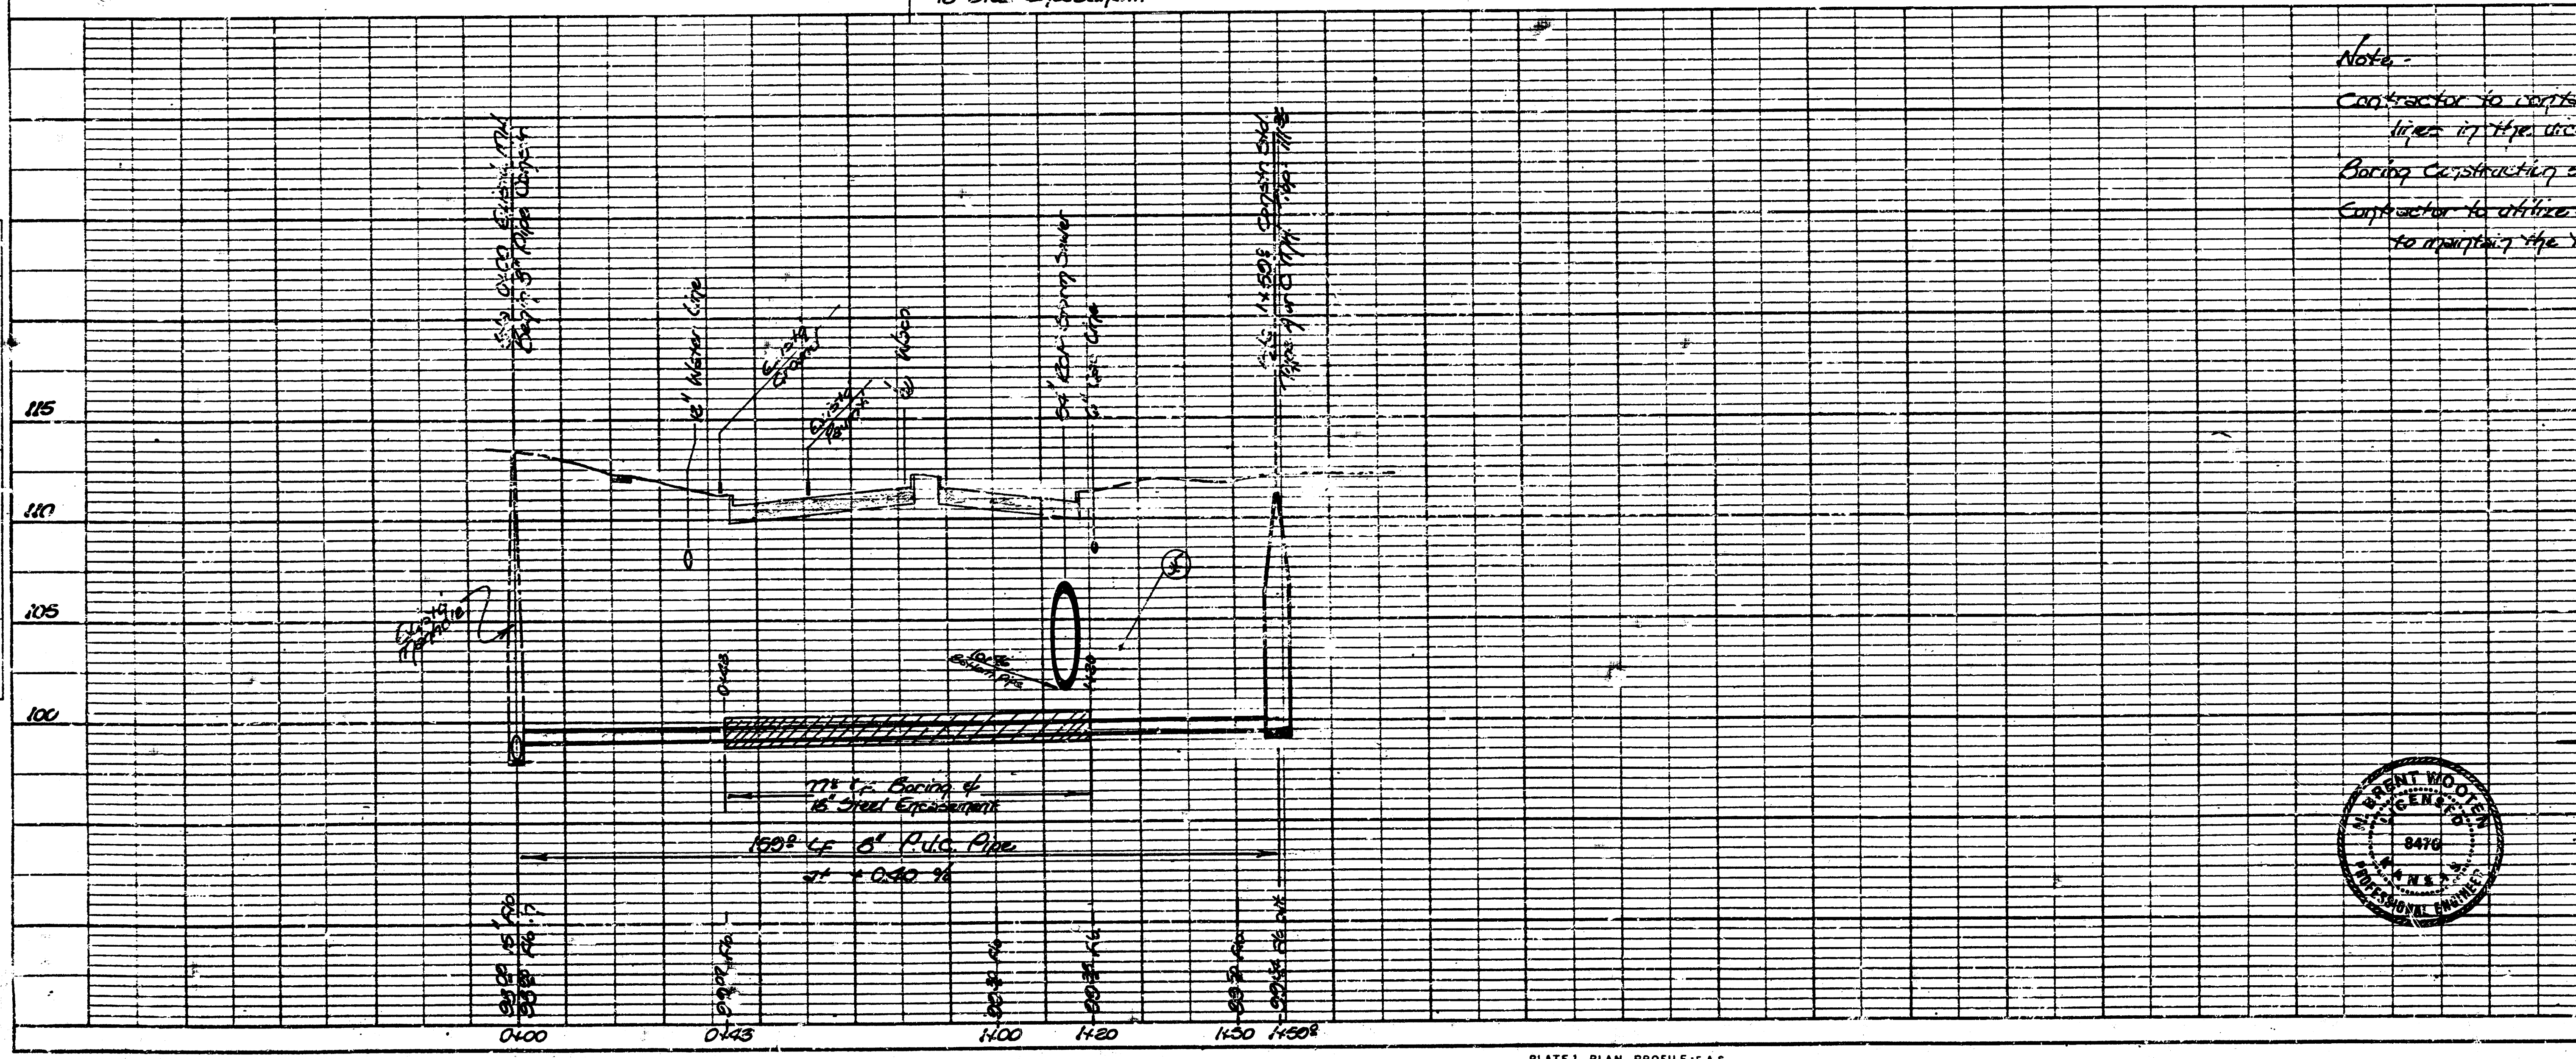

PRIVATE SANITARY SEWER EXTENSION TO
SERVE LOT 1, PARK PLAZA
THIRD ADDITION.
CITY OF WICHITA, KS.
PROJECT NO.
468-76-245-80000-000-008
BAUGHMAN COMPANY, P.A.
SURVEYING & ENGINEERING
314/262-7271 • 330 LAURA • WICHITA, KANSAS 67211

PLATE 1 - PLAN - PROFILE - F.A.S.
CLEARPRINT PAPER CO., S.F. CAL.
NO. 1000-1

FILMED FROM THE BEST
AVAILABLE COPY.....