


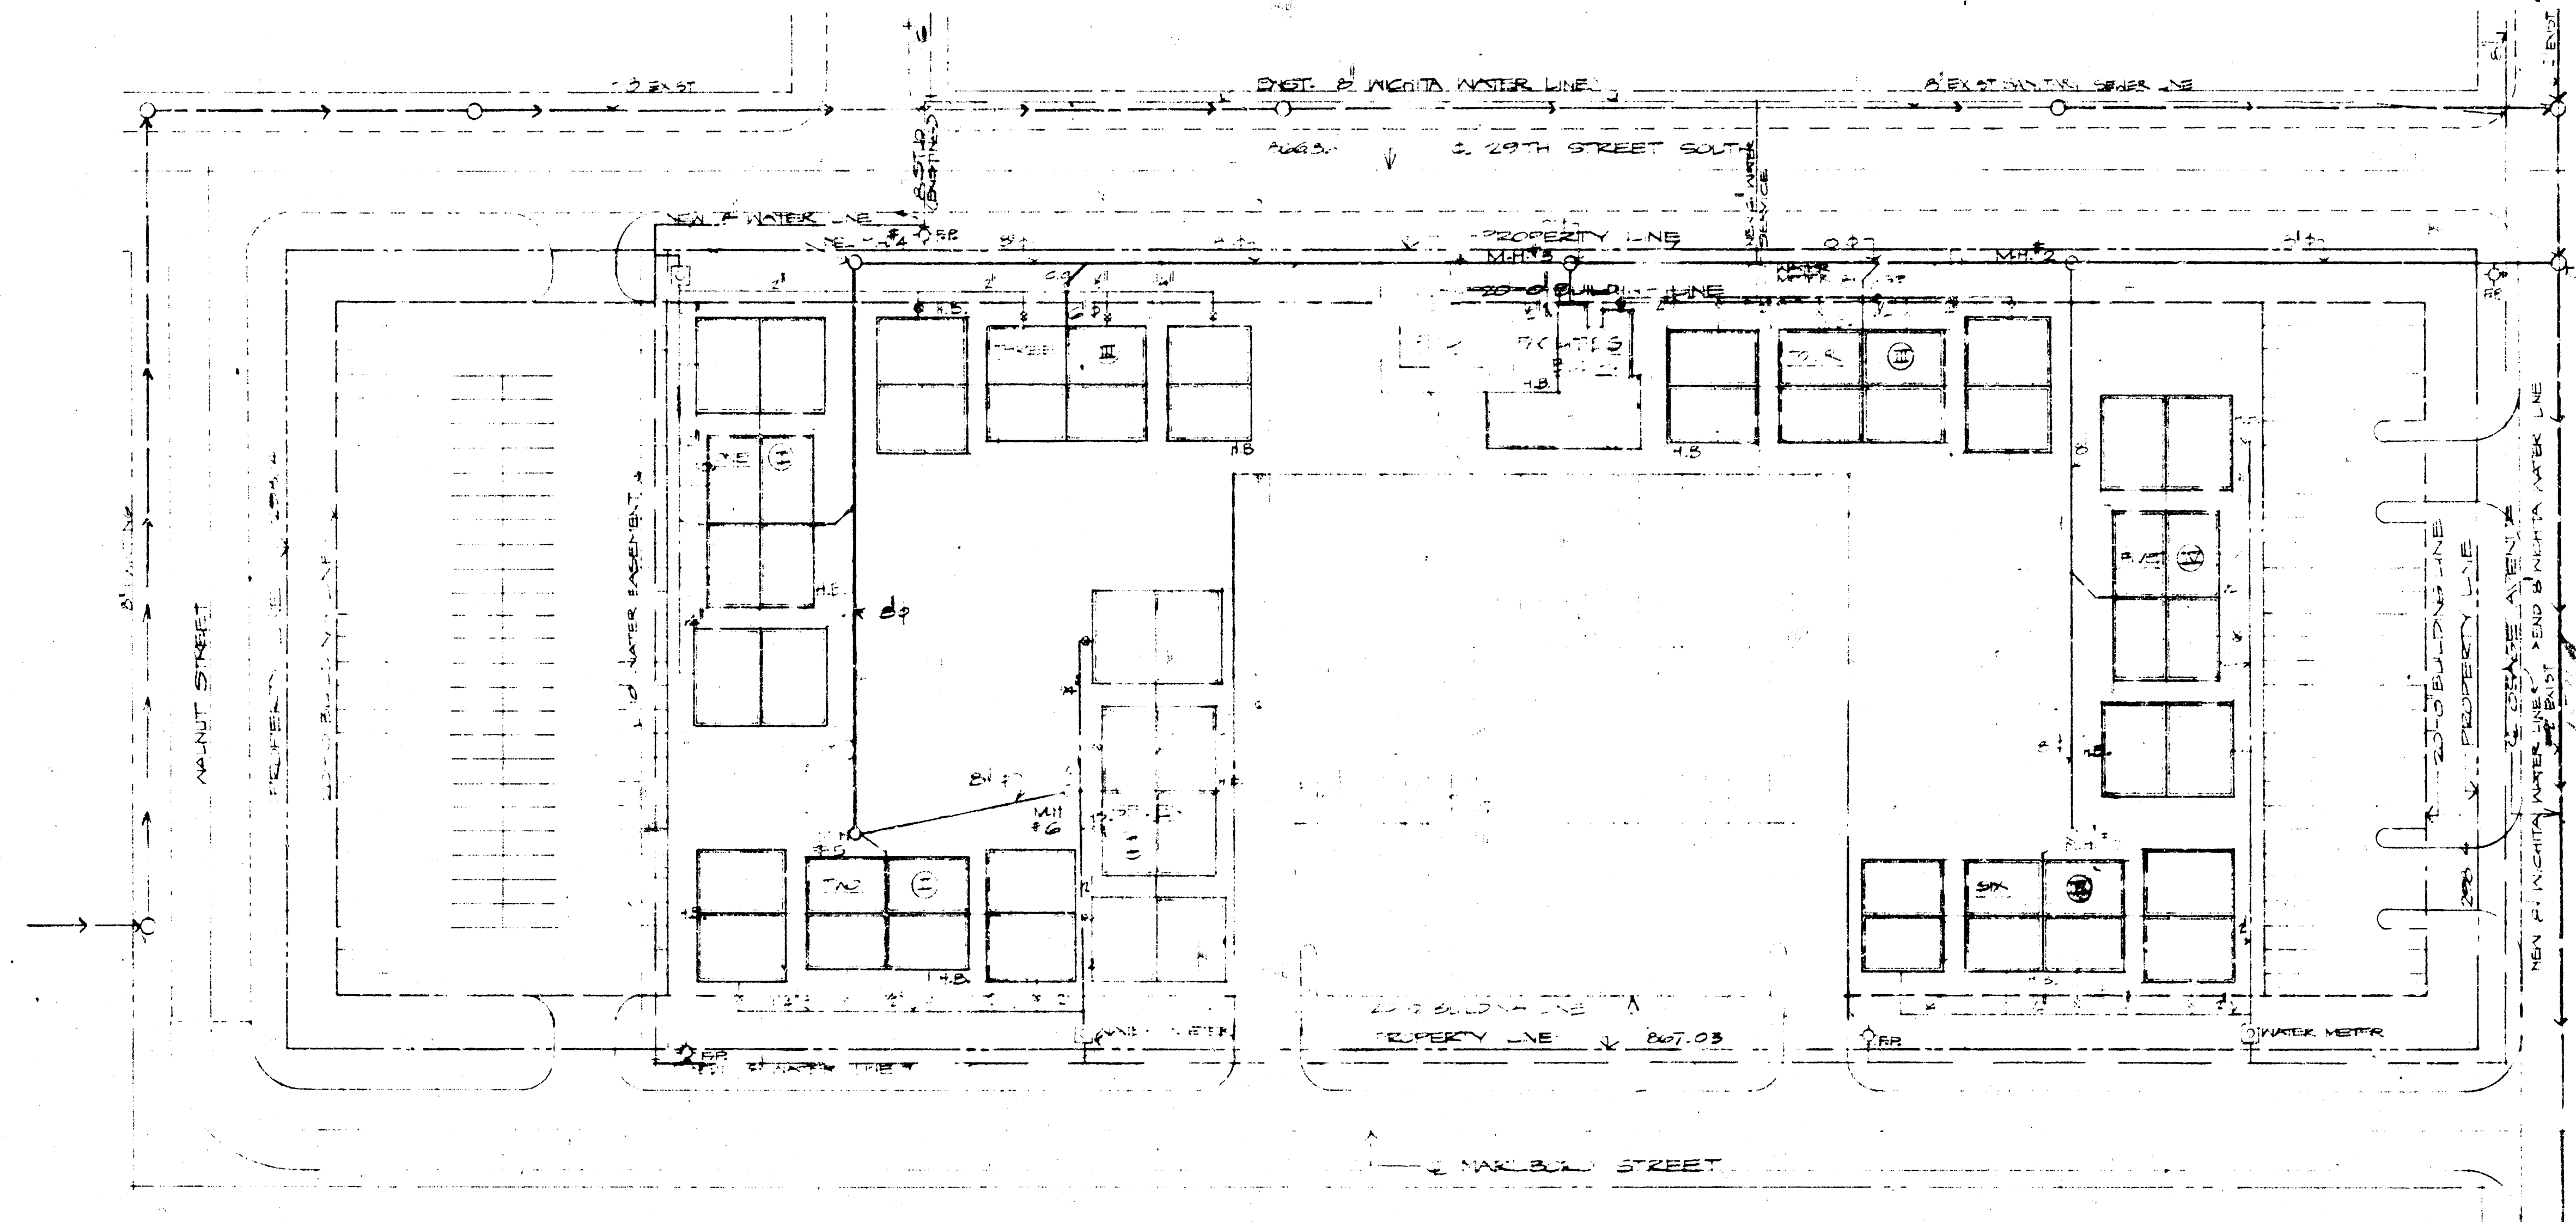

ALL MH TO T₁ A

MECHANICAL SITE PLAN

APPROVED AS NOTED
By CITY ENGINEER OF WICHITA
Sanitary Sewers: *[Signature]*
Storm Sewers: _____
Driveway Approaches: _____

NOTE TO CONTRACTOR
This project will be constructed under the supervision of the CITY ENGINEER and conforming to the SPECIFICATIONS of the CITY OF WICHITA. The CONTRACTOR will reimburse the City of Wichita for all cost of Engineering, and Inspection.

Heartland, Inc.
Wichita, Kansas 67202
PH 316 261-1111

DESIGNED BY: **Heartland, Inc.**
CONSTRUCTION MANAGEMENT

PHONE 316 463-5137

MECHANICAL SITE PLAN

REVISED 12 AUG 73

PLANTATION 3 APARTMENTS
WICHITA, KANSAS


sheet
M
of 3

bishop & quinn - a.i.a. - architects
midwest city, oklahoma




2416570-01

2416570-23

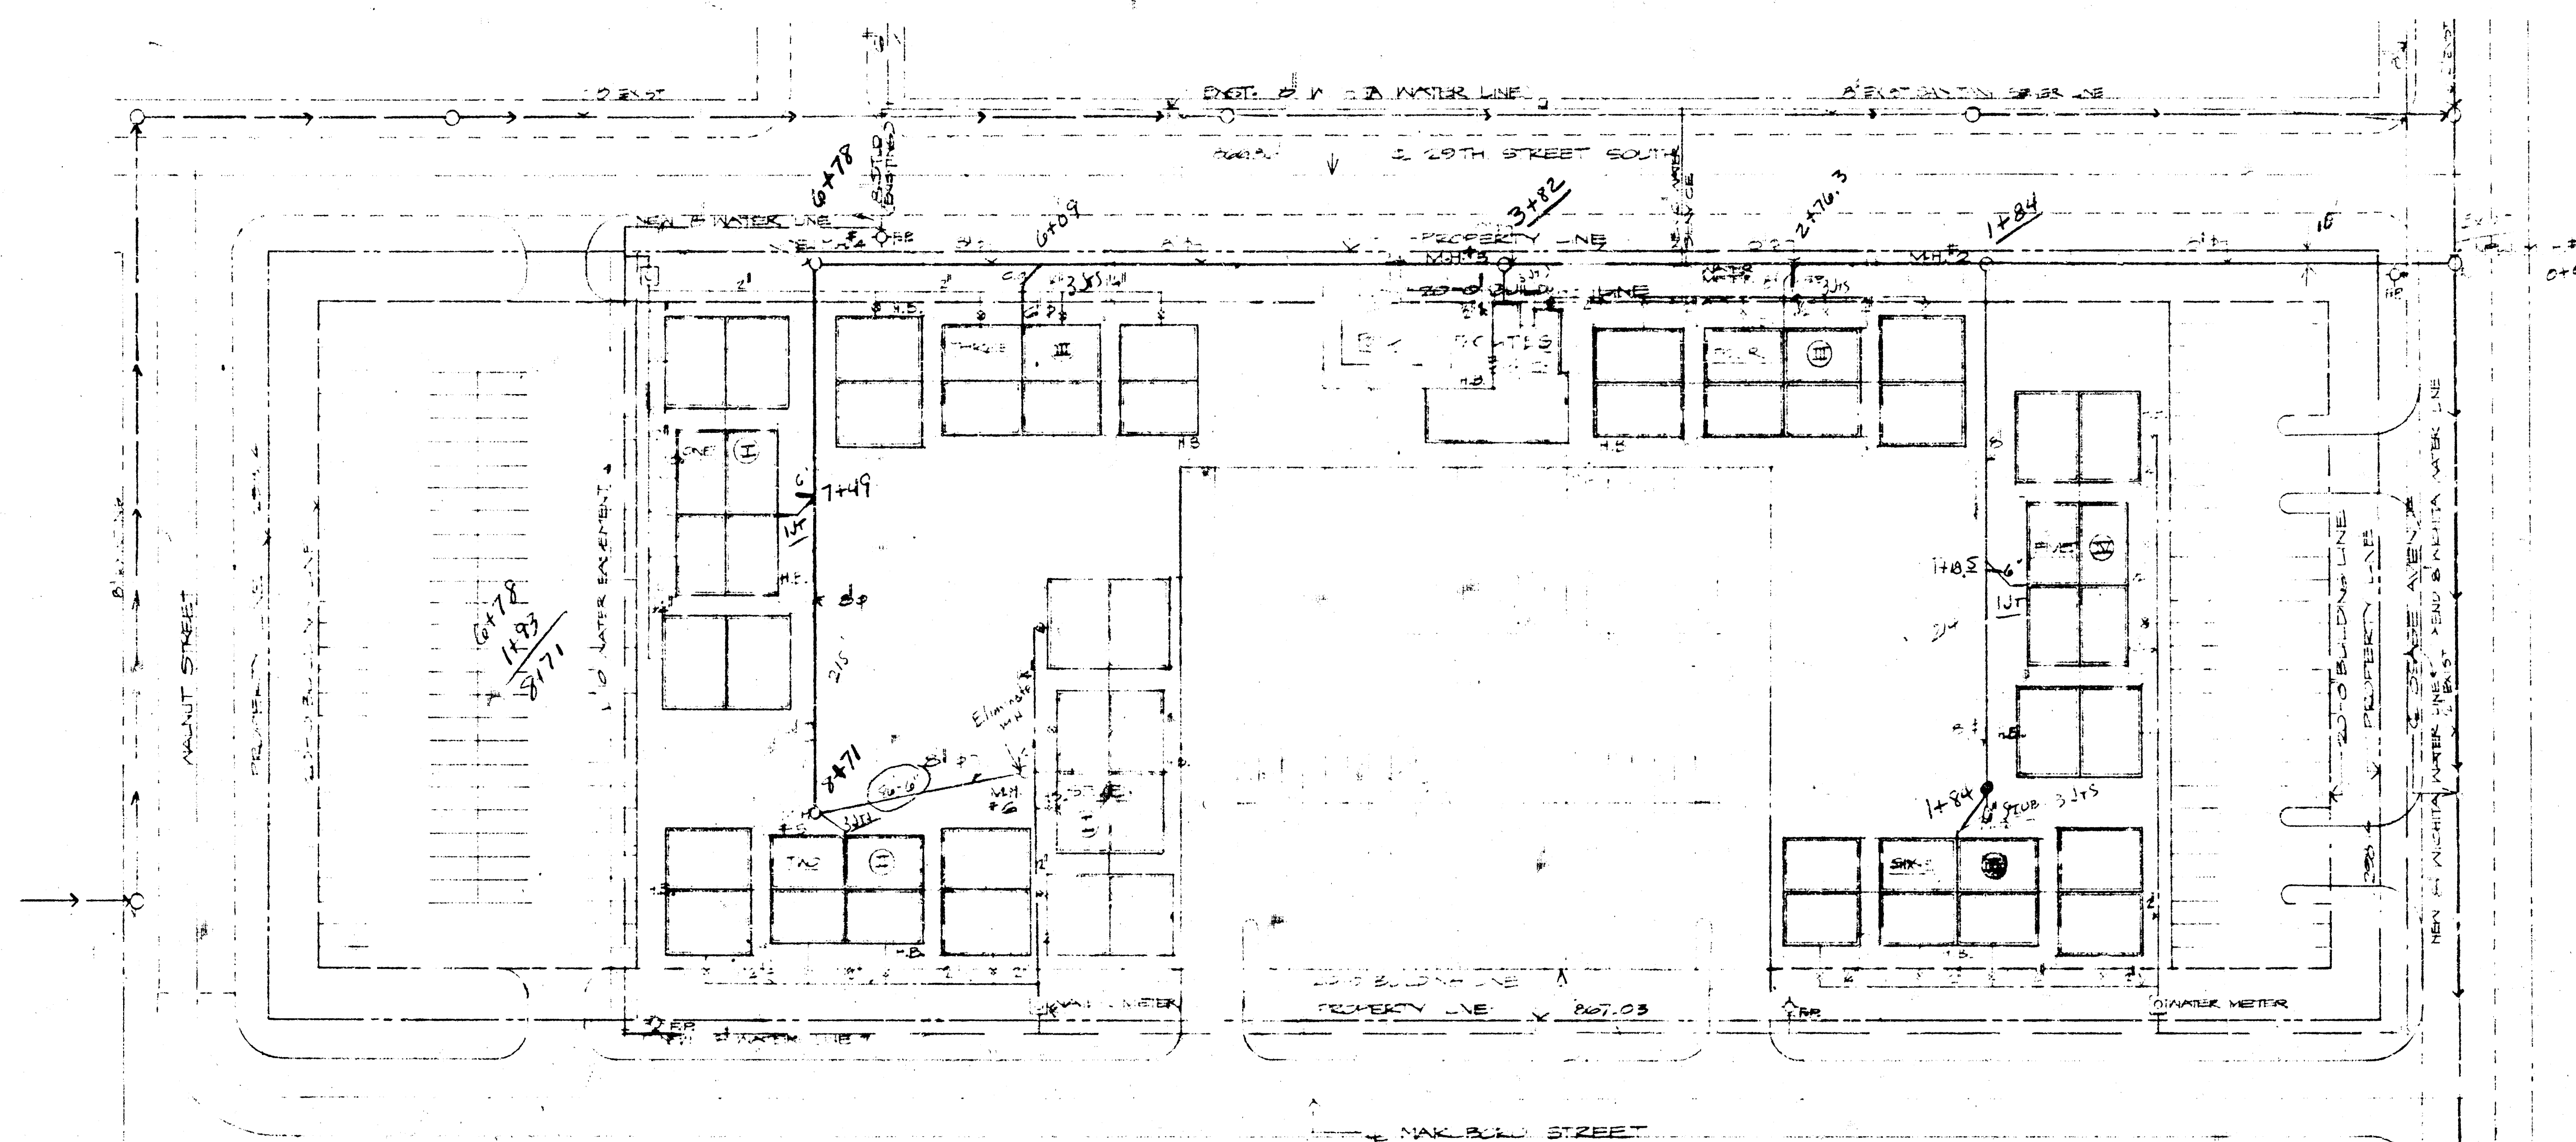

MECHANICAL SITE PLAN

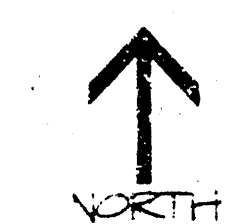

MID STATES CONST. CO. INC.
AS BUILT & EXISTING CONDITIONS

271
124
138

214
215
675
1104LF

JOB #656

MECHANICAL SITE PLAN

REVISED 10 AUG 73


PLANTATION 3 APARTMENTS
WICHITA, KANSAS


sheet
M-1
of 3

bishop & quinn . a . i . a . architects

midwest city, oklahoma

23

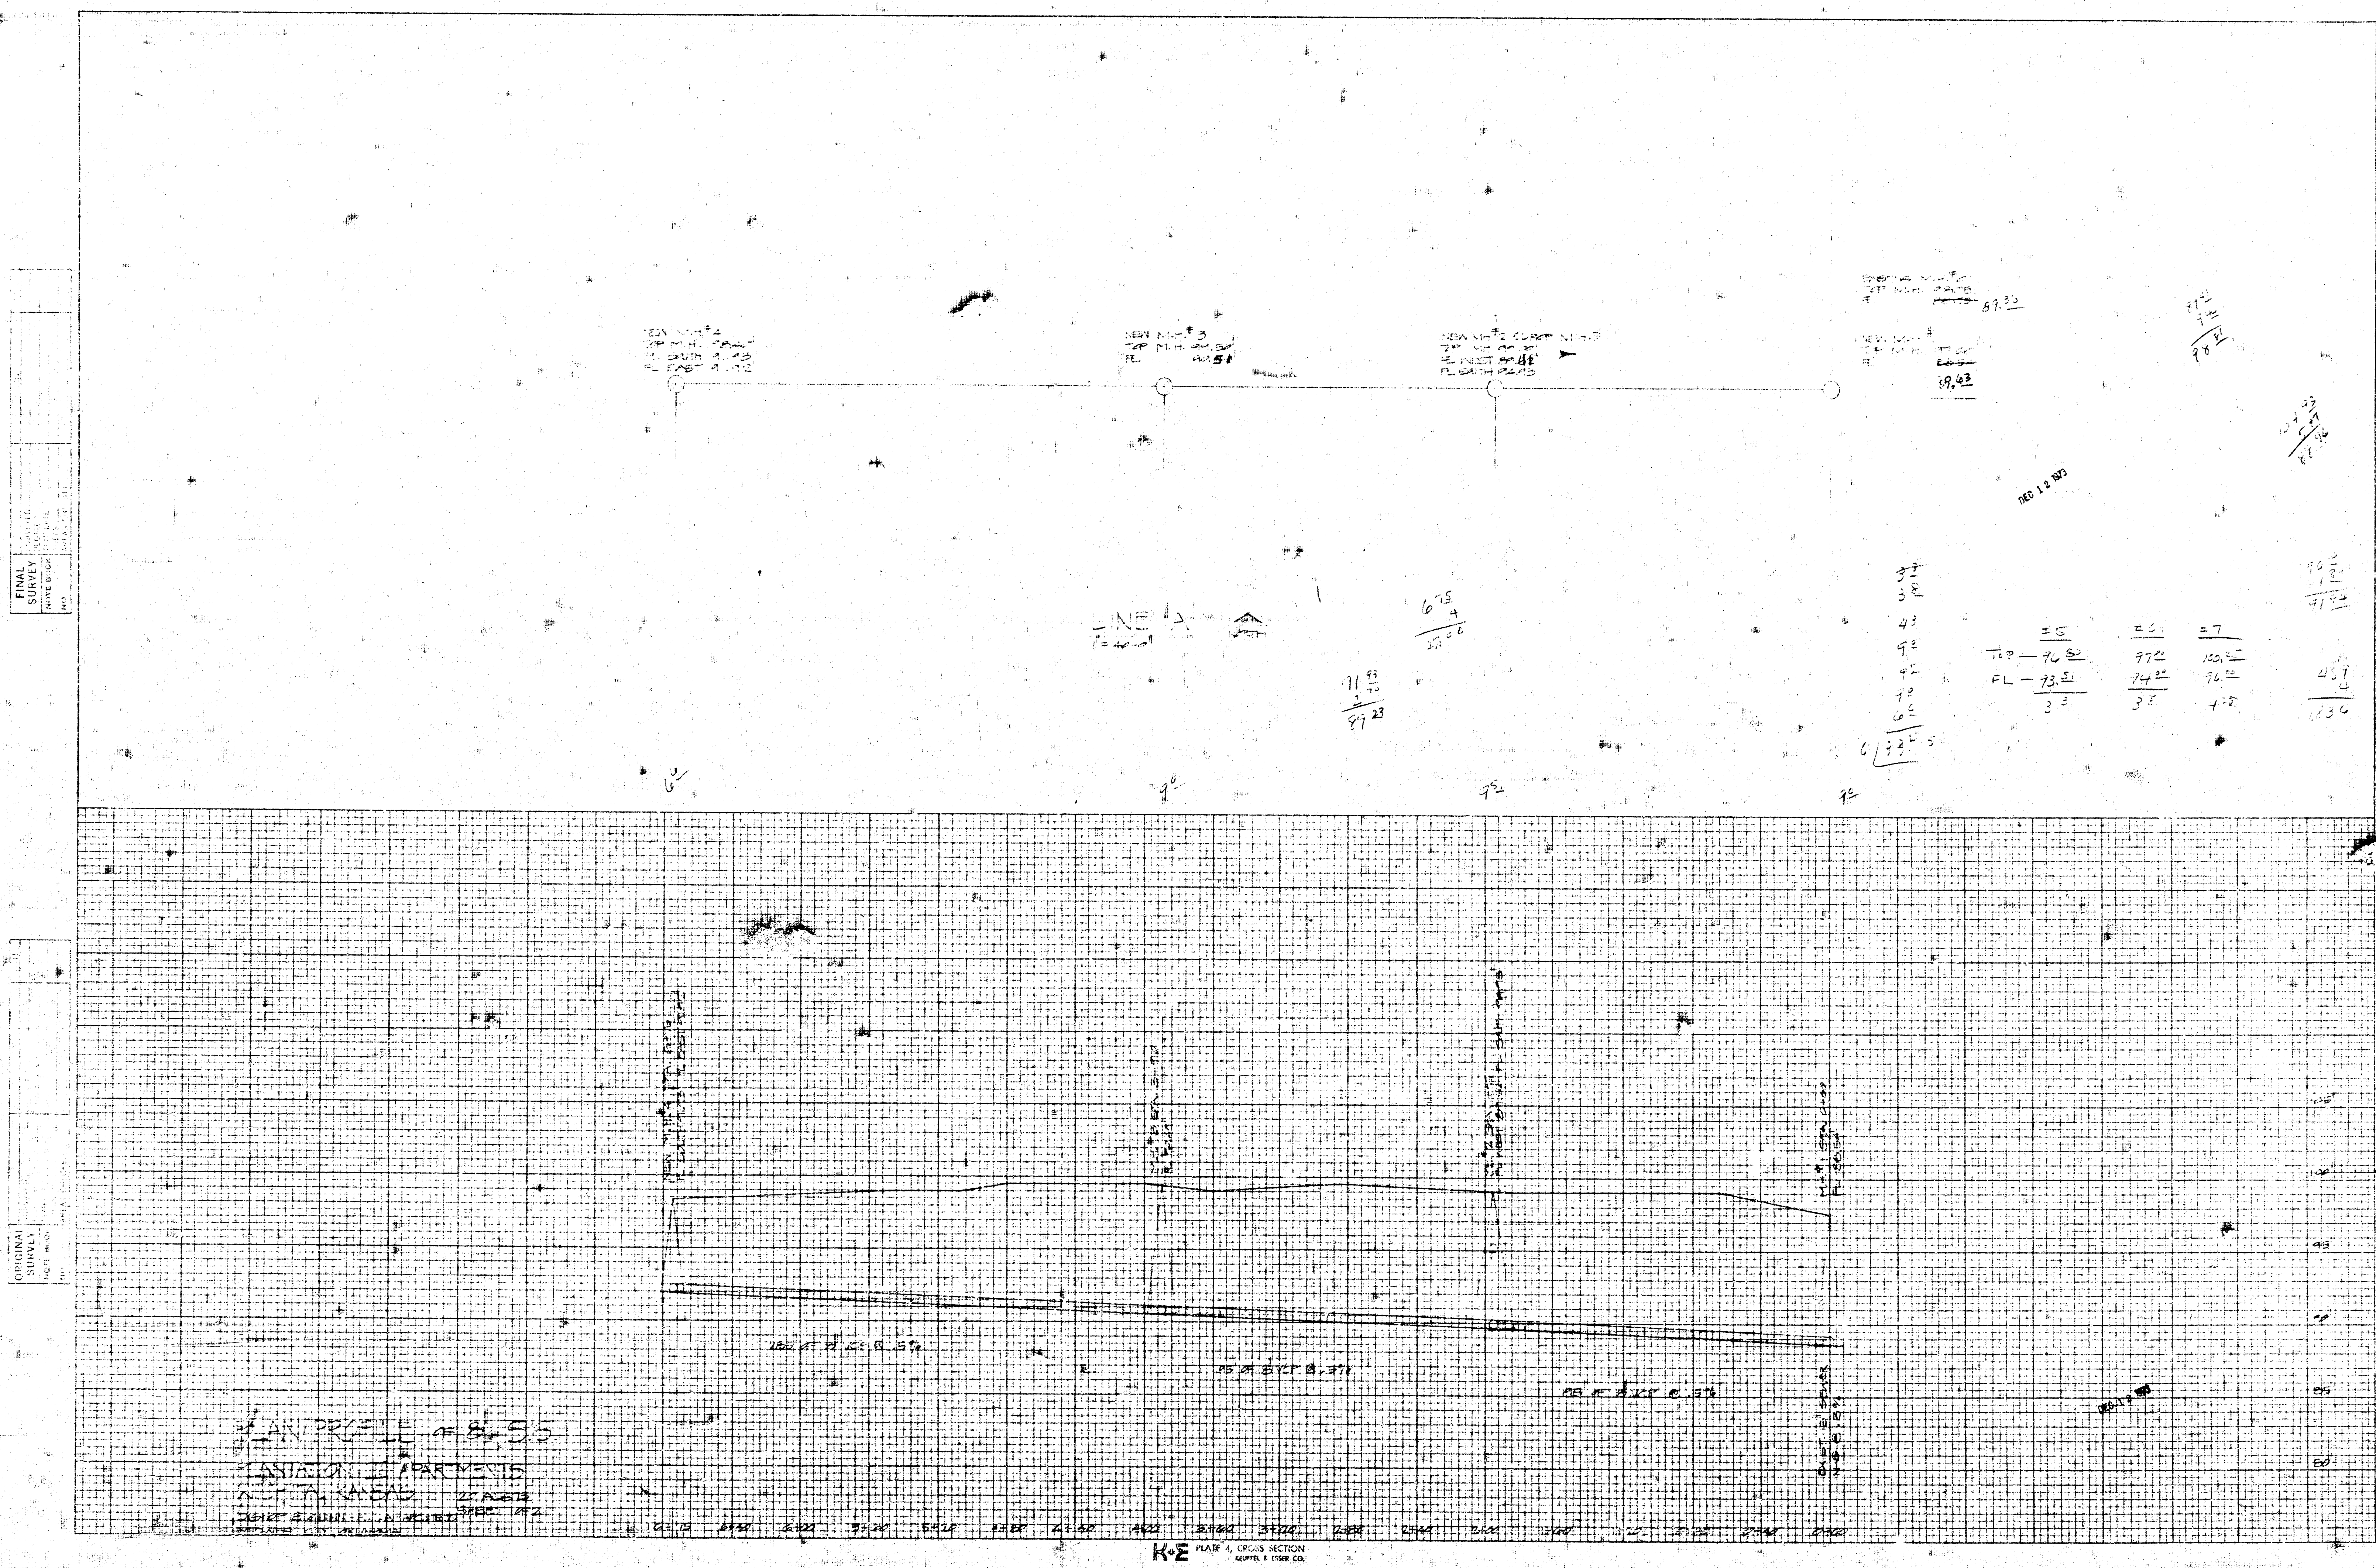

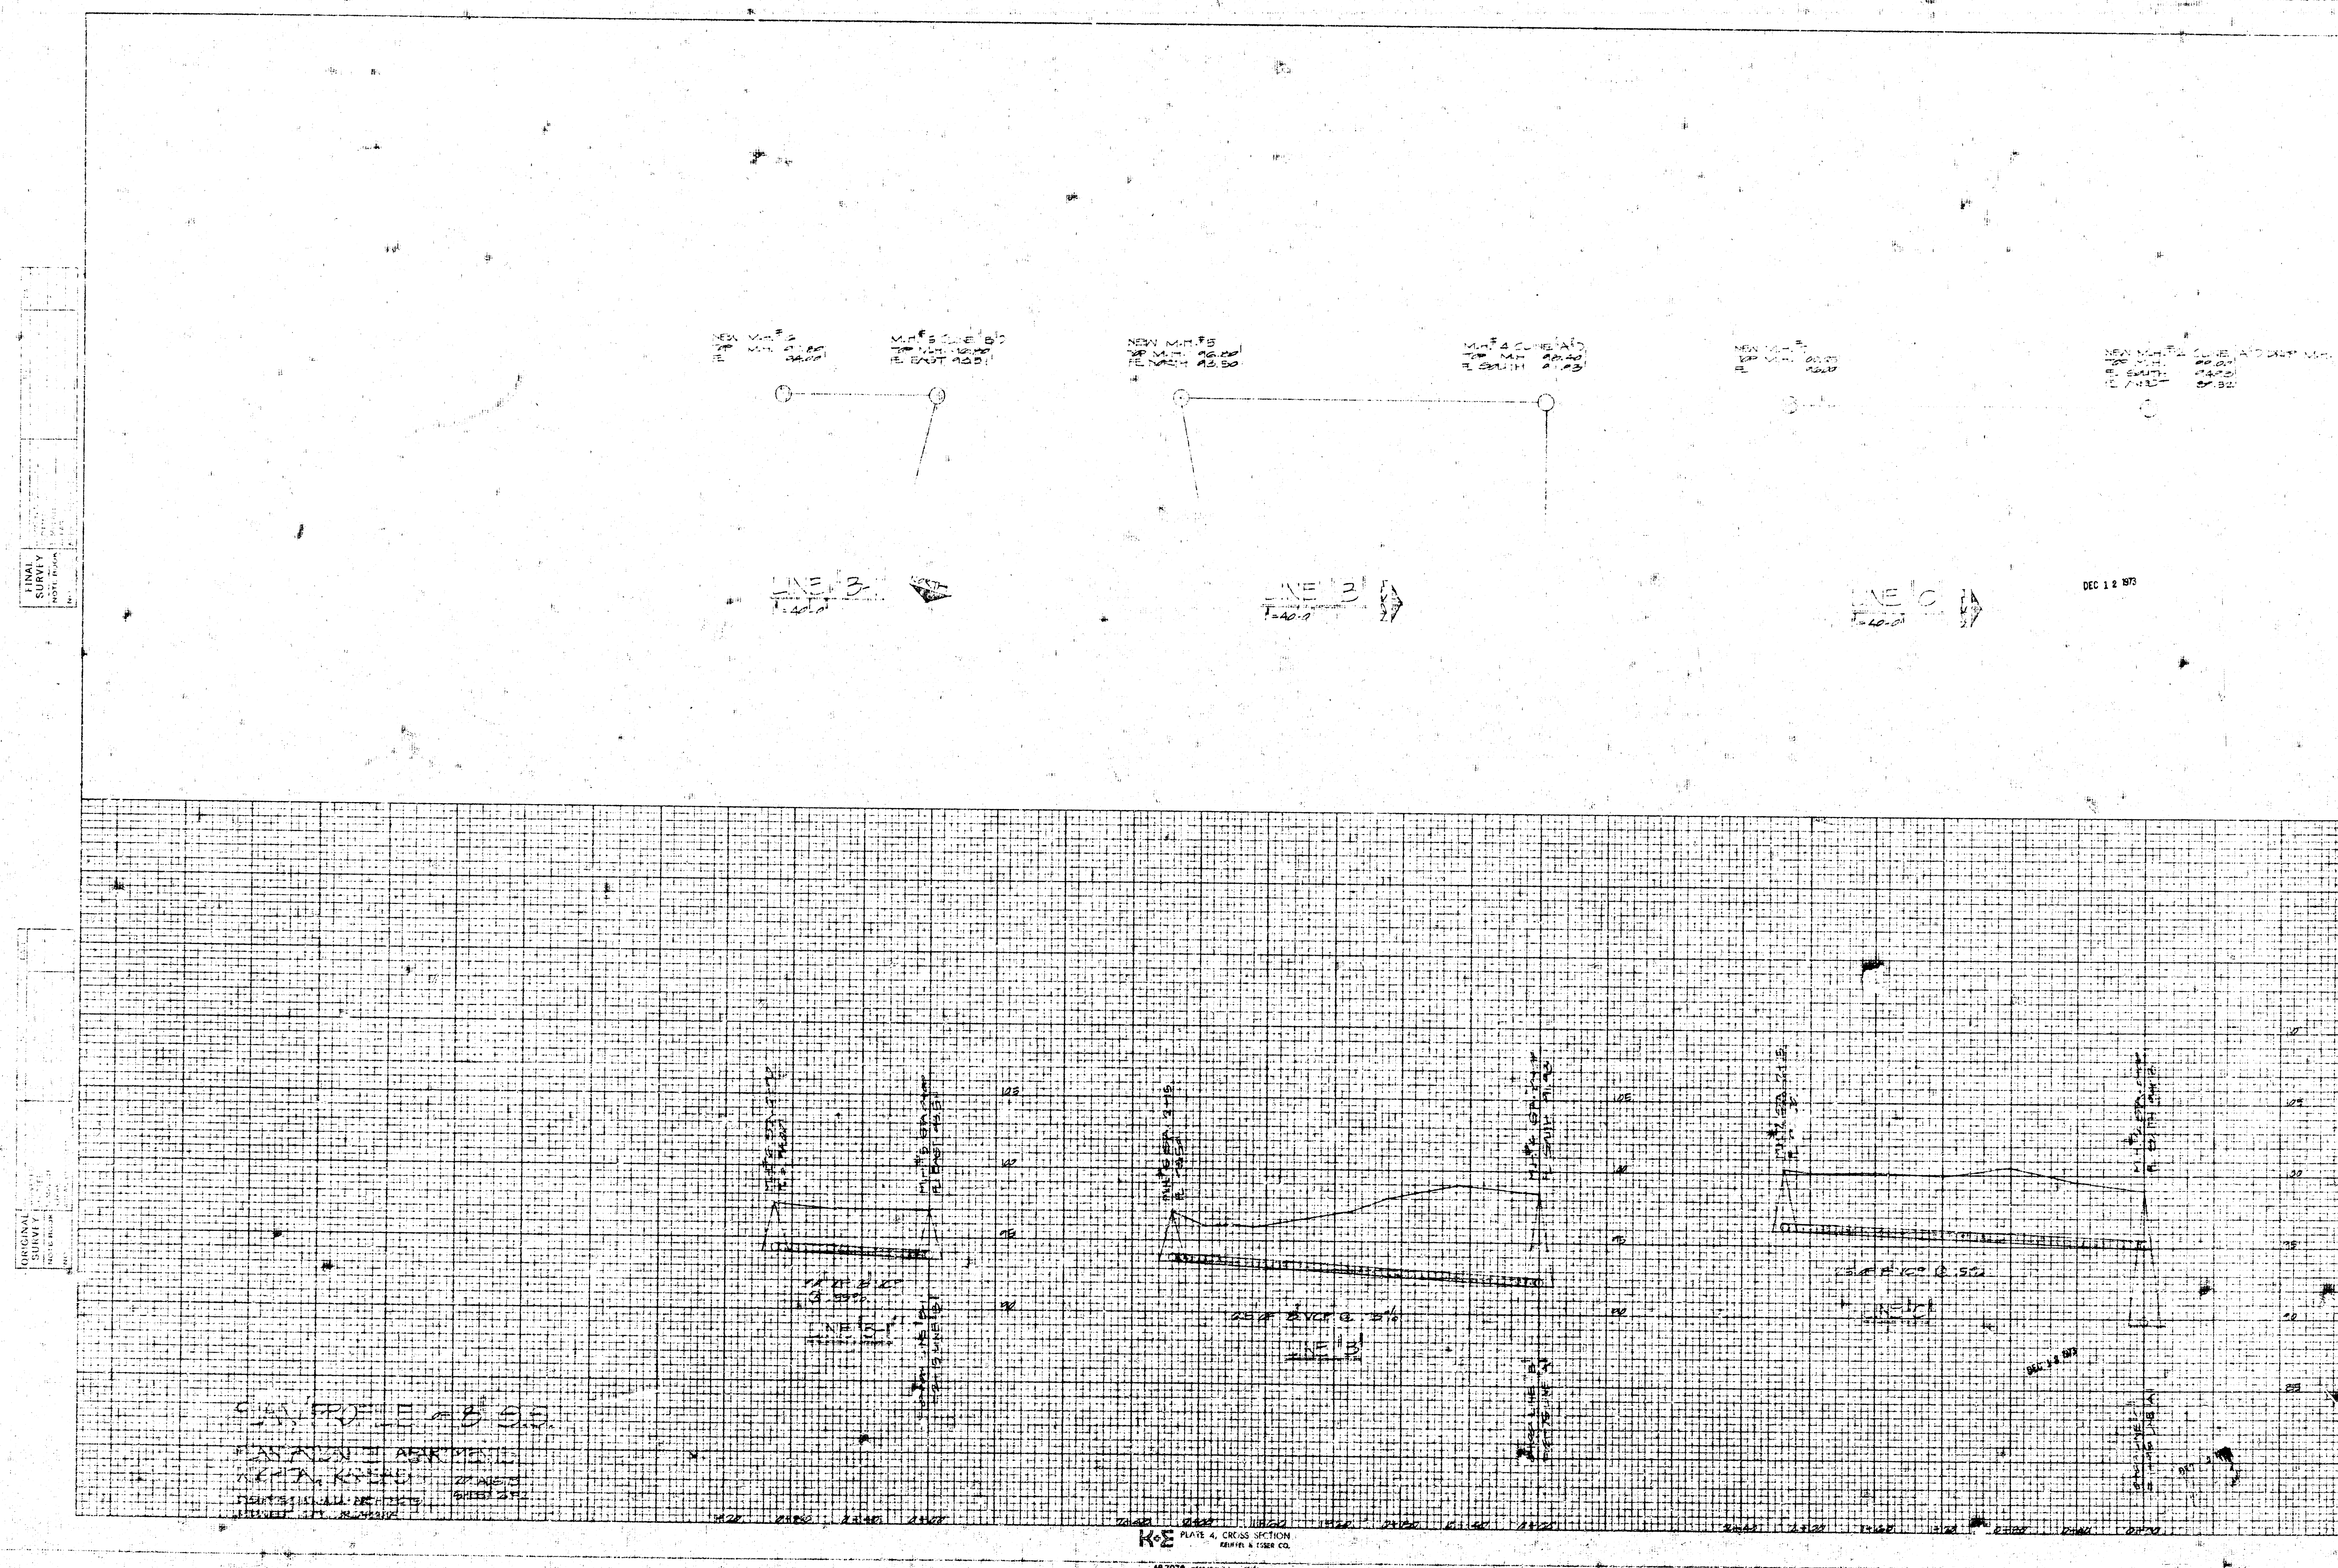

FINAL
DESIGN
DATE: 10/1/55
BY: [Signature]

ORIGINAL
DATE: 10/1/55
BY: [Signature]

