



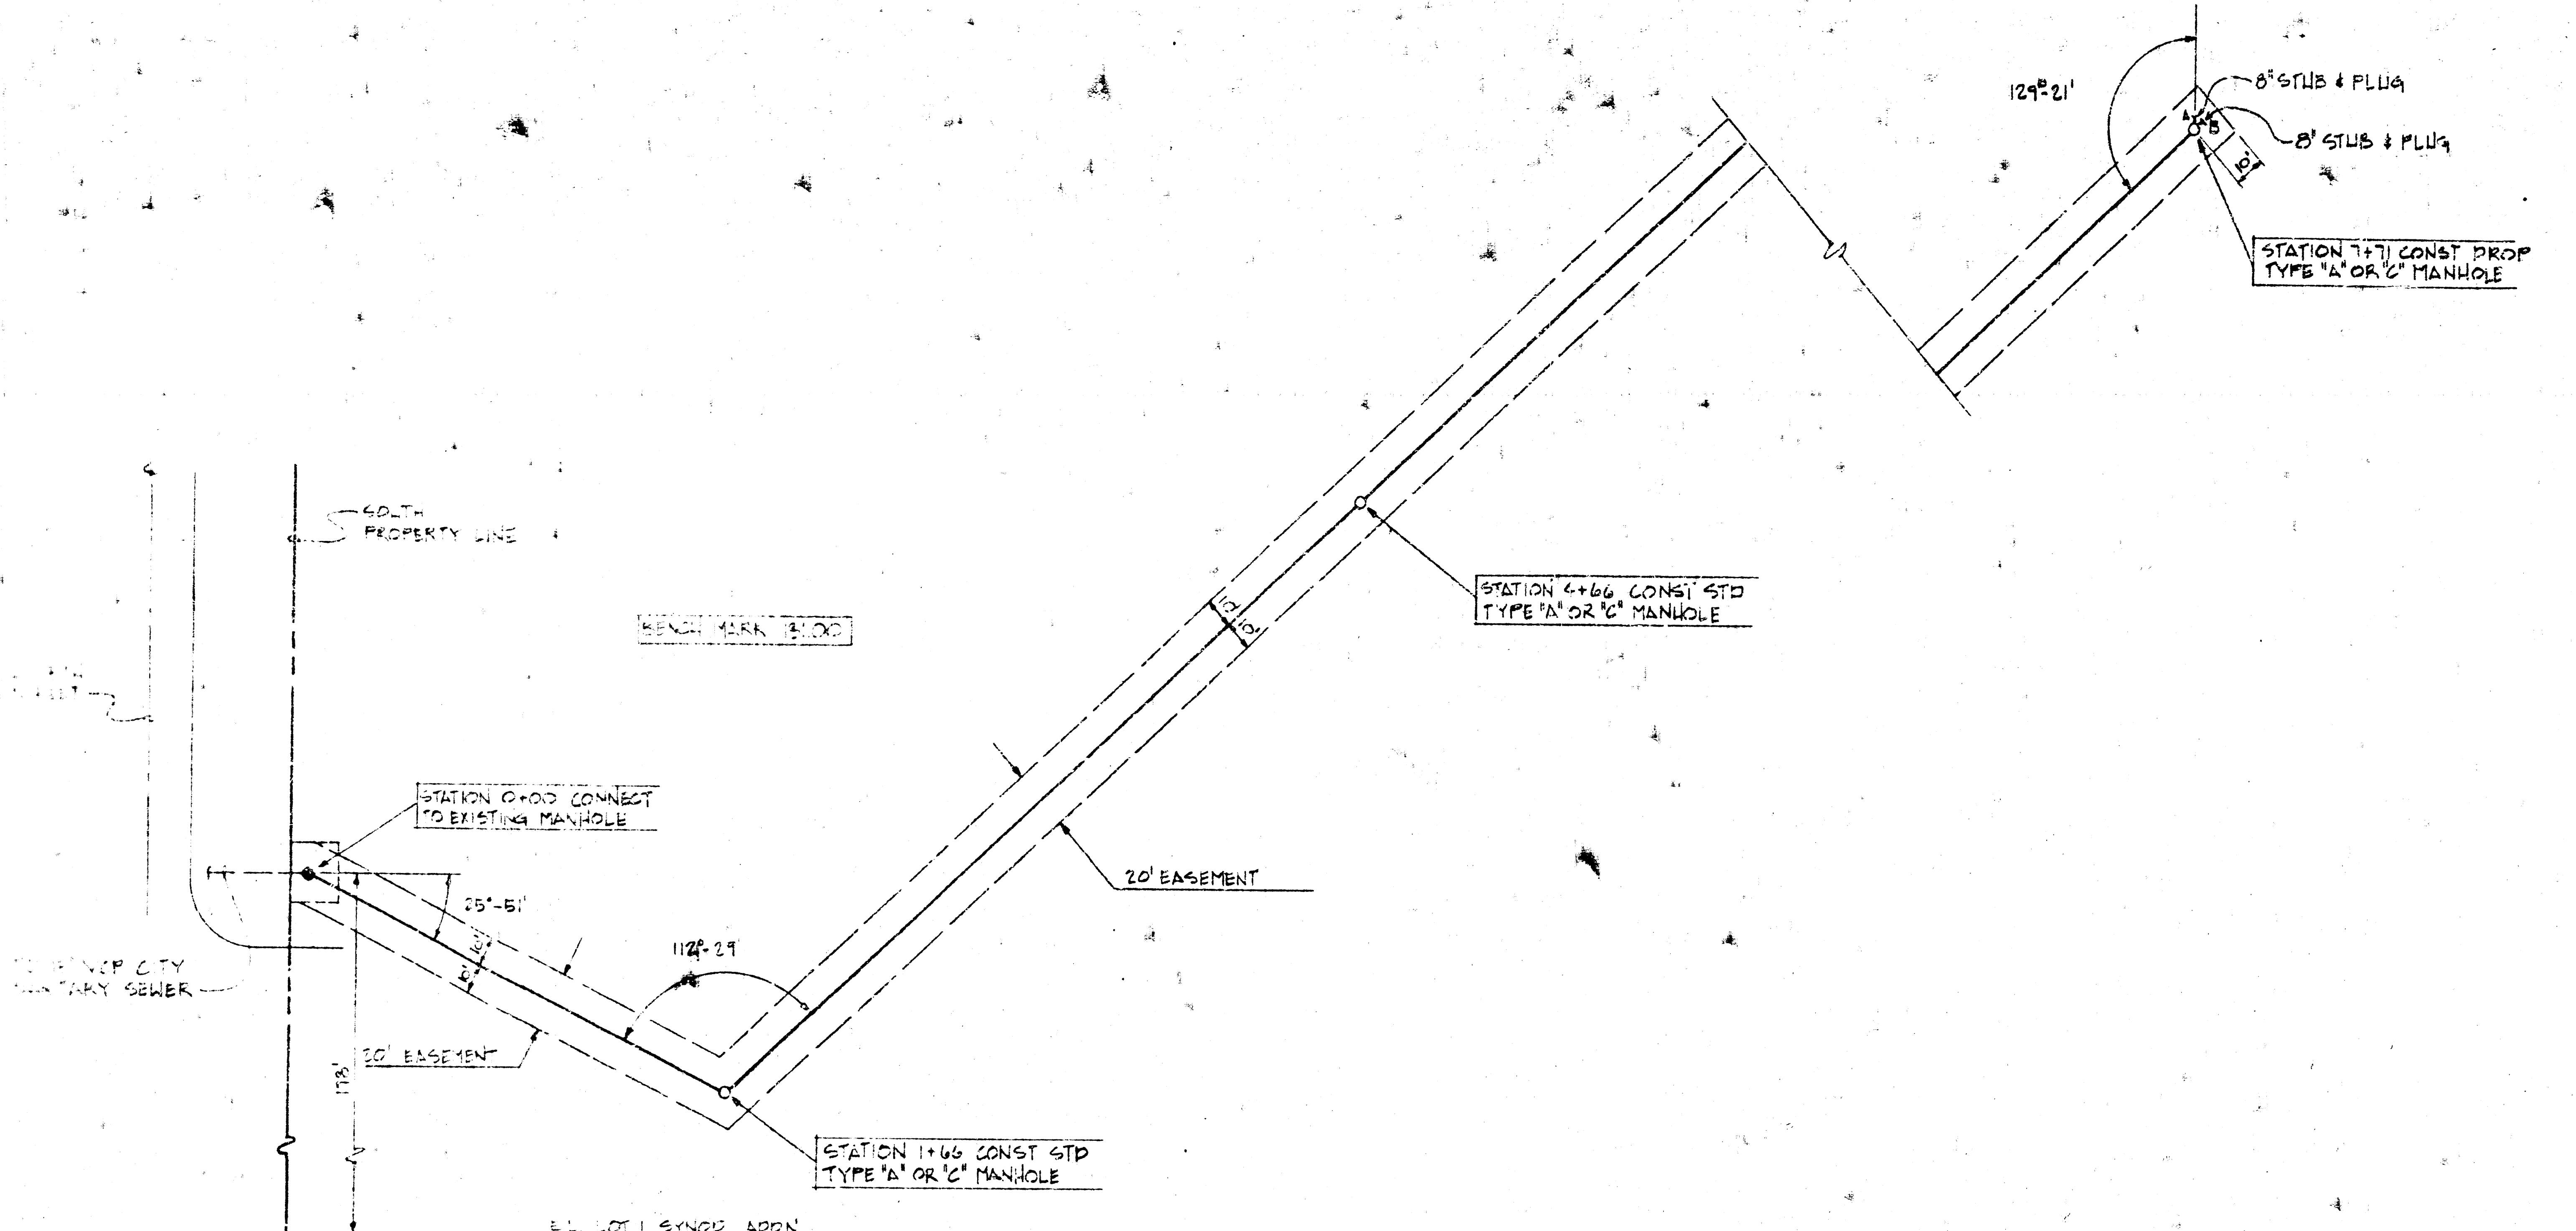

9-10-76
 APPROVED AS NOTED
 By CITY ENGINEER OF WICHITA
 Sanitary Sewers O.E.S.
 Storm Sewers _____
 Driveway Approaches _____

NOTE TO CONTRACTOR
 This project will be constructed under the supervision of the CITY ENGINEER and conforming to the specifications of the CITY OF WICHITA. The CONTRACTOR will reimburse the City of Wichita for all cost of inspection.

PRESBYTERIAN MANOR APARTMENTS
 SANITARY SEWER PARTIAL PLAN & PROFILE
 SOUTHEAST CORNER LOT 1 SYNOPSIS ADDITION
 TO WICHITA, SEDGWICK COUNTY, KANSAS.
 4700 WEST 18TH STREET
 SCALE - 1"=40'-0" HORIZONTAL
 1"=2'-0" VERTICAL
 CITY PROJECT NO DBKW706035

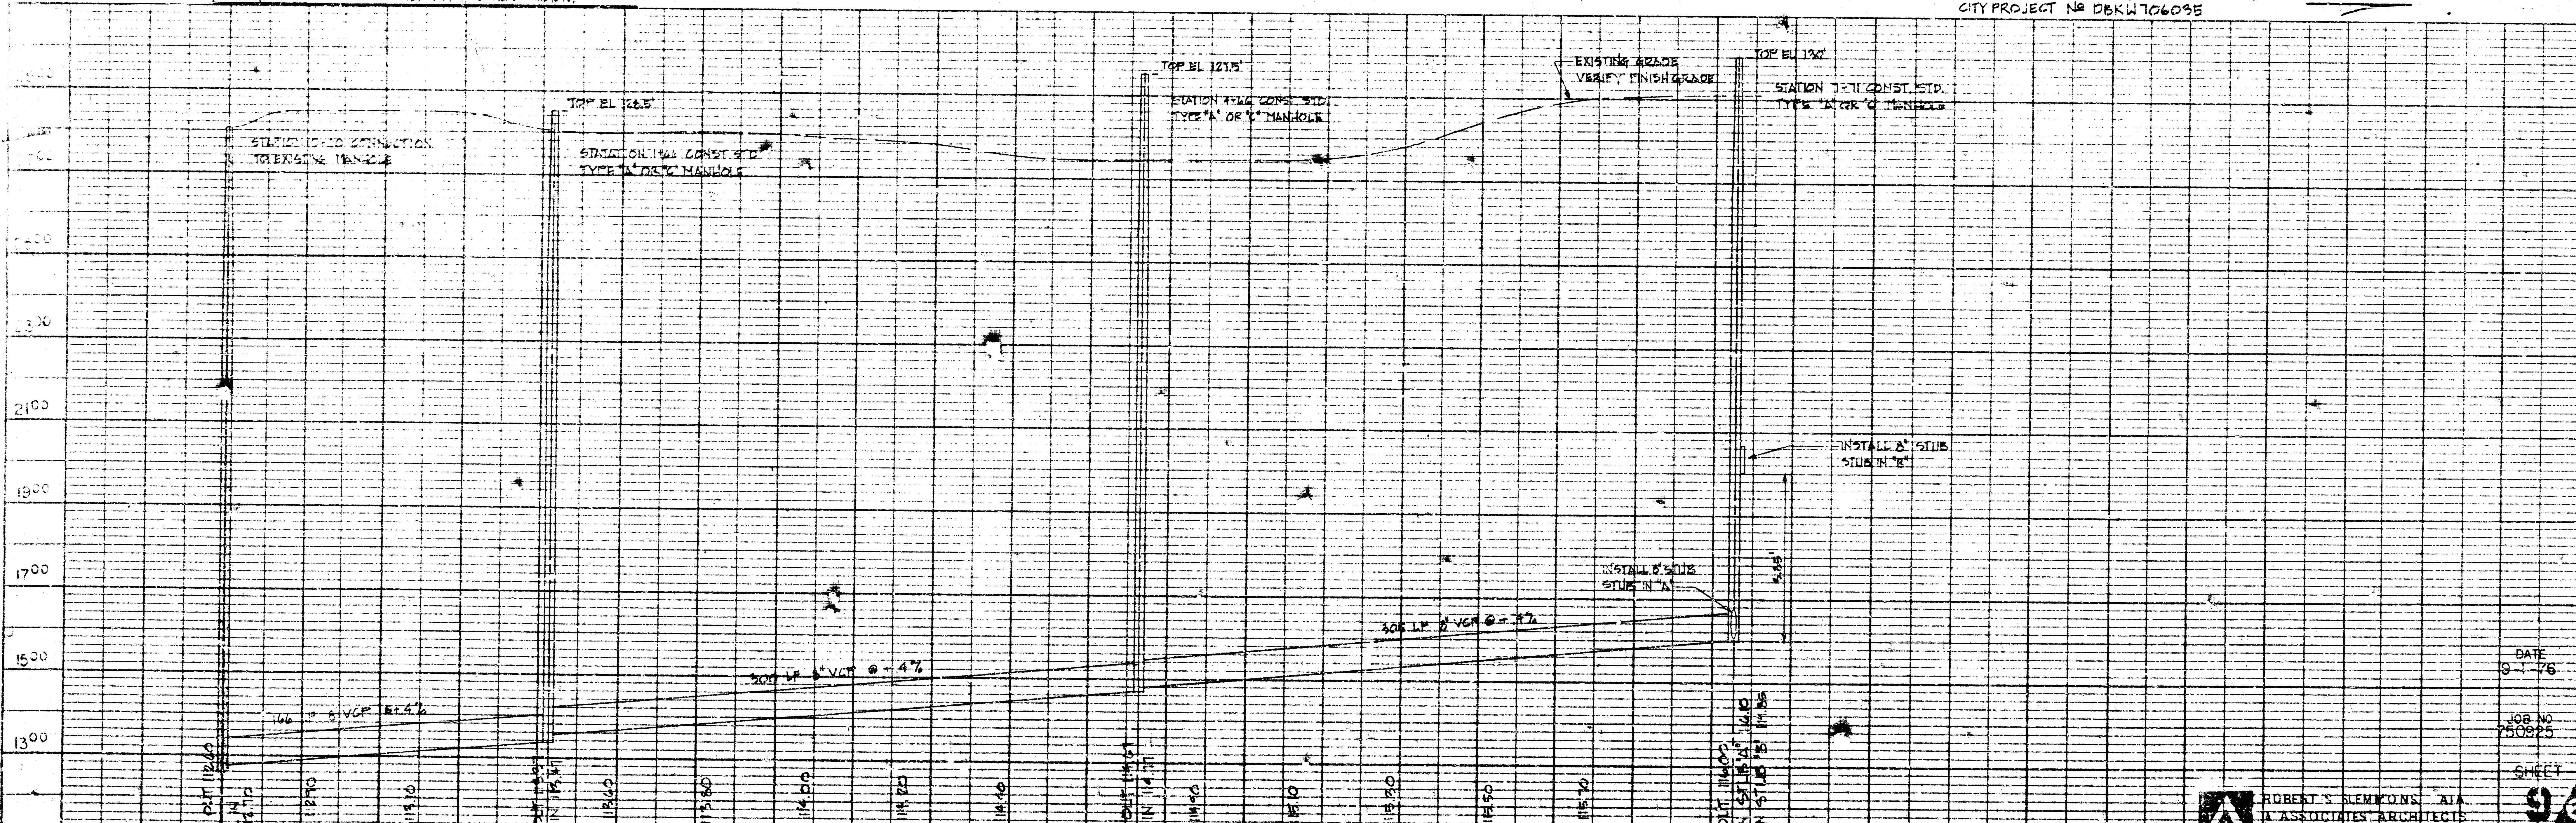

DATE
 9-1-76
 JOB NO
 750825
 SHEET