


BEUCH MARK: CITY DISC, 34 WEST
AND 10' SOUTH OF THE CENTERLINES
OF WEST ST. AND 2ND ST.
ELEVATION = 118.87

SCALE: 1" = 20' HORIZ
1" = 1'-0" VERT.

NOTE: SANITARY SEWER TO BE
CONSTRUCTED AS PER
CITY OF WICHITA STANDARDS

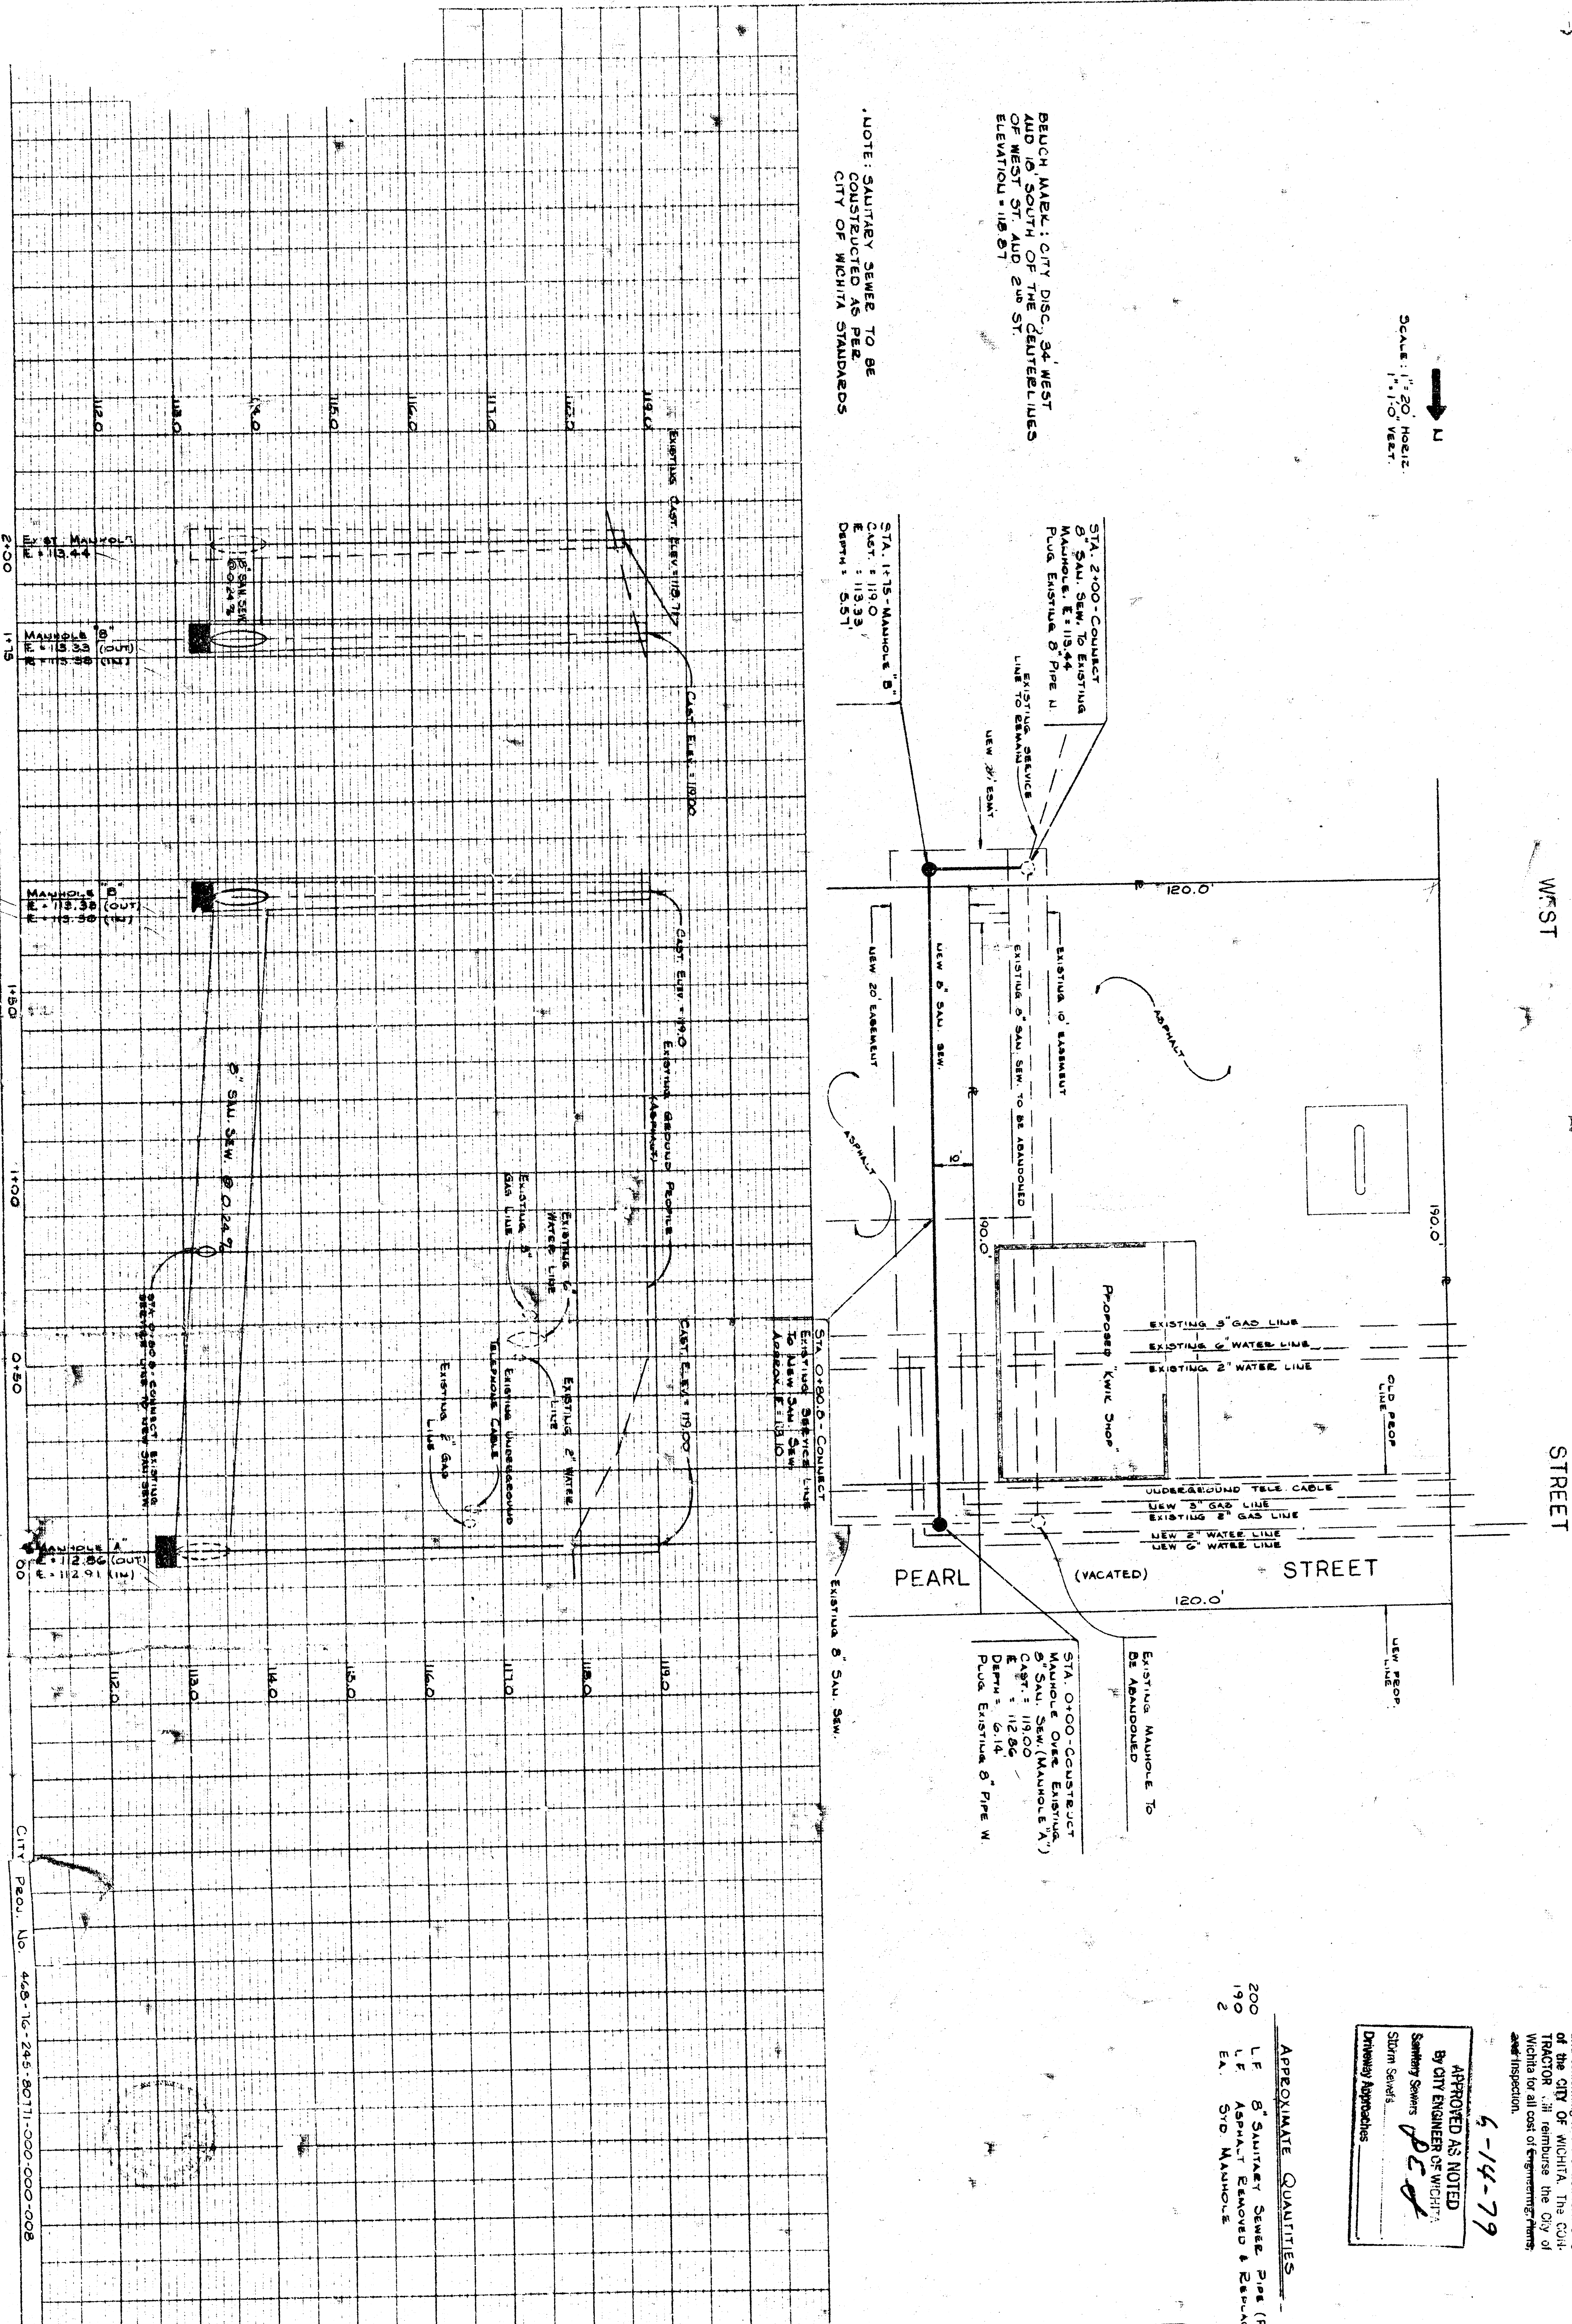

WIS ST

STREET

PEARL

(VACATED)

STREET

NOTE TO CONTRACTOR

This project will be constructed under the supervision of the CITY ENGINEER and conforming to the SPECIFICATIO. S. and the CITY OF WICHITA. The CONTRACTOR will reimburse the City of Wichita for all cost of Engineering Plans and inspection.

6-14-79

APPROVED AS NOTED
By CITY ENGINEER OF WICHITA
Sanitary Sewers *PCD*
Storm Sewers _____
Driveway Approaches _____

APPROXIMATE QUANTITIES	
200	L.F. 8" SANITARY SEWER PIPE (P.V.C.)
190	L.F. ASPHALT REMOVED & REPLACED
2	EA. SYD. MANHOLE

SAN SEW. RELOCATION FOR

KWIK SHOP BUILDING NO. 736

DOUGLAS & WEST - WICHITA, KANSAS

Kwik Shop **CONVENIENCE FOOD STORES**
ARCHITECTURAL & ENGINEERING DEPARTMENT
2700 EAST FOURTH STREET
HUTCHINSON, KANSAS 67501 1-316-685-5311