


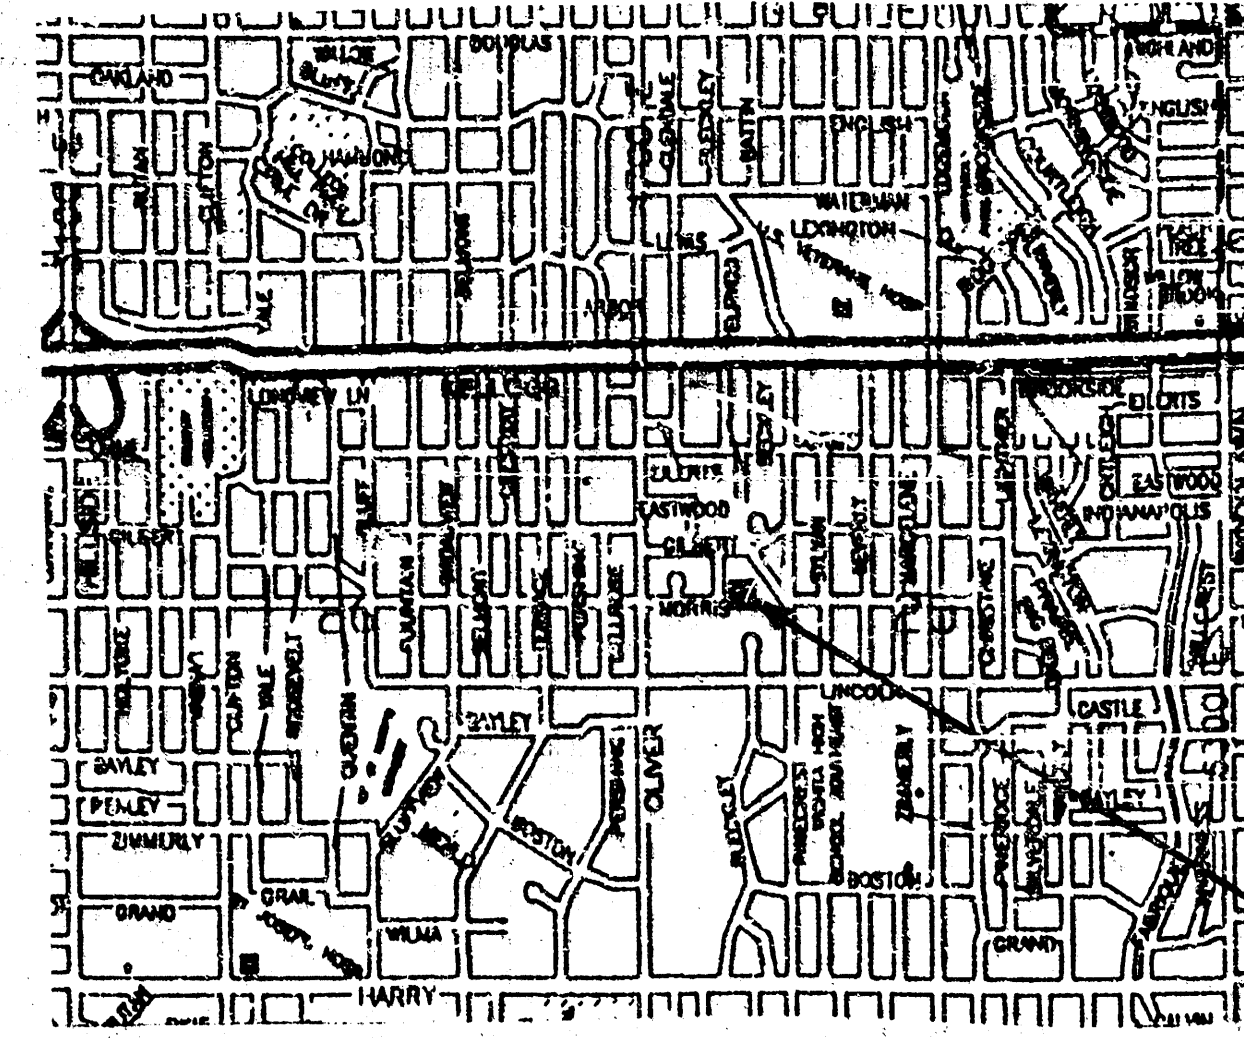


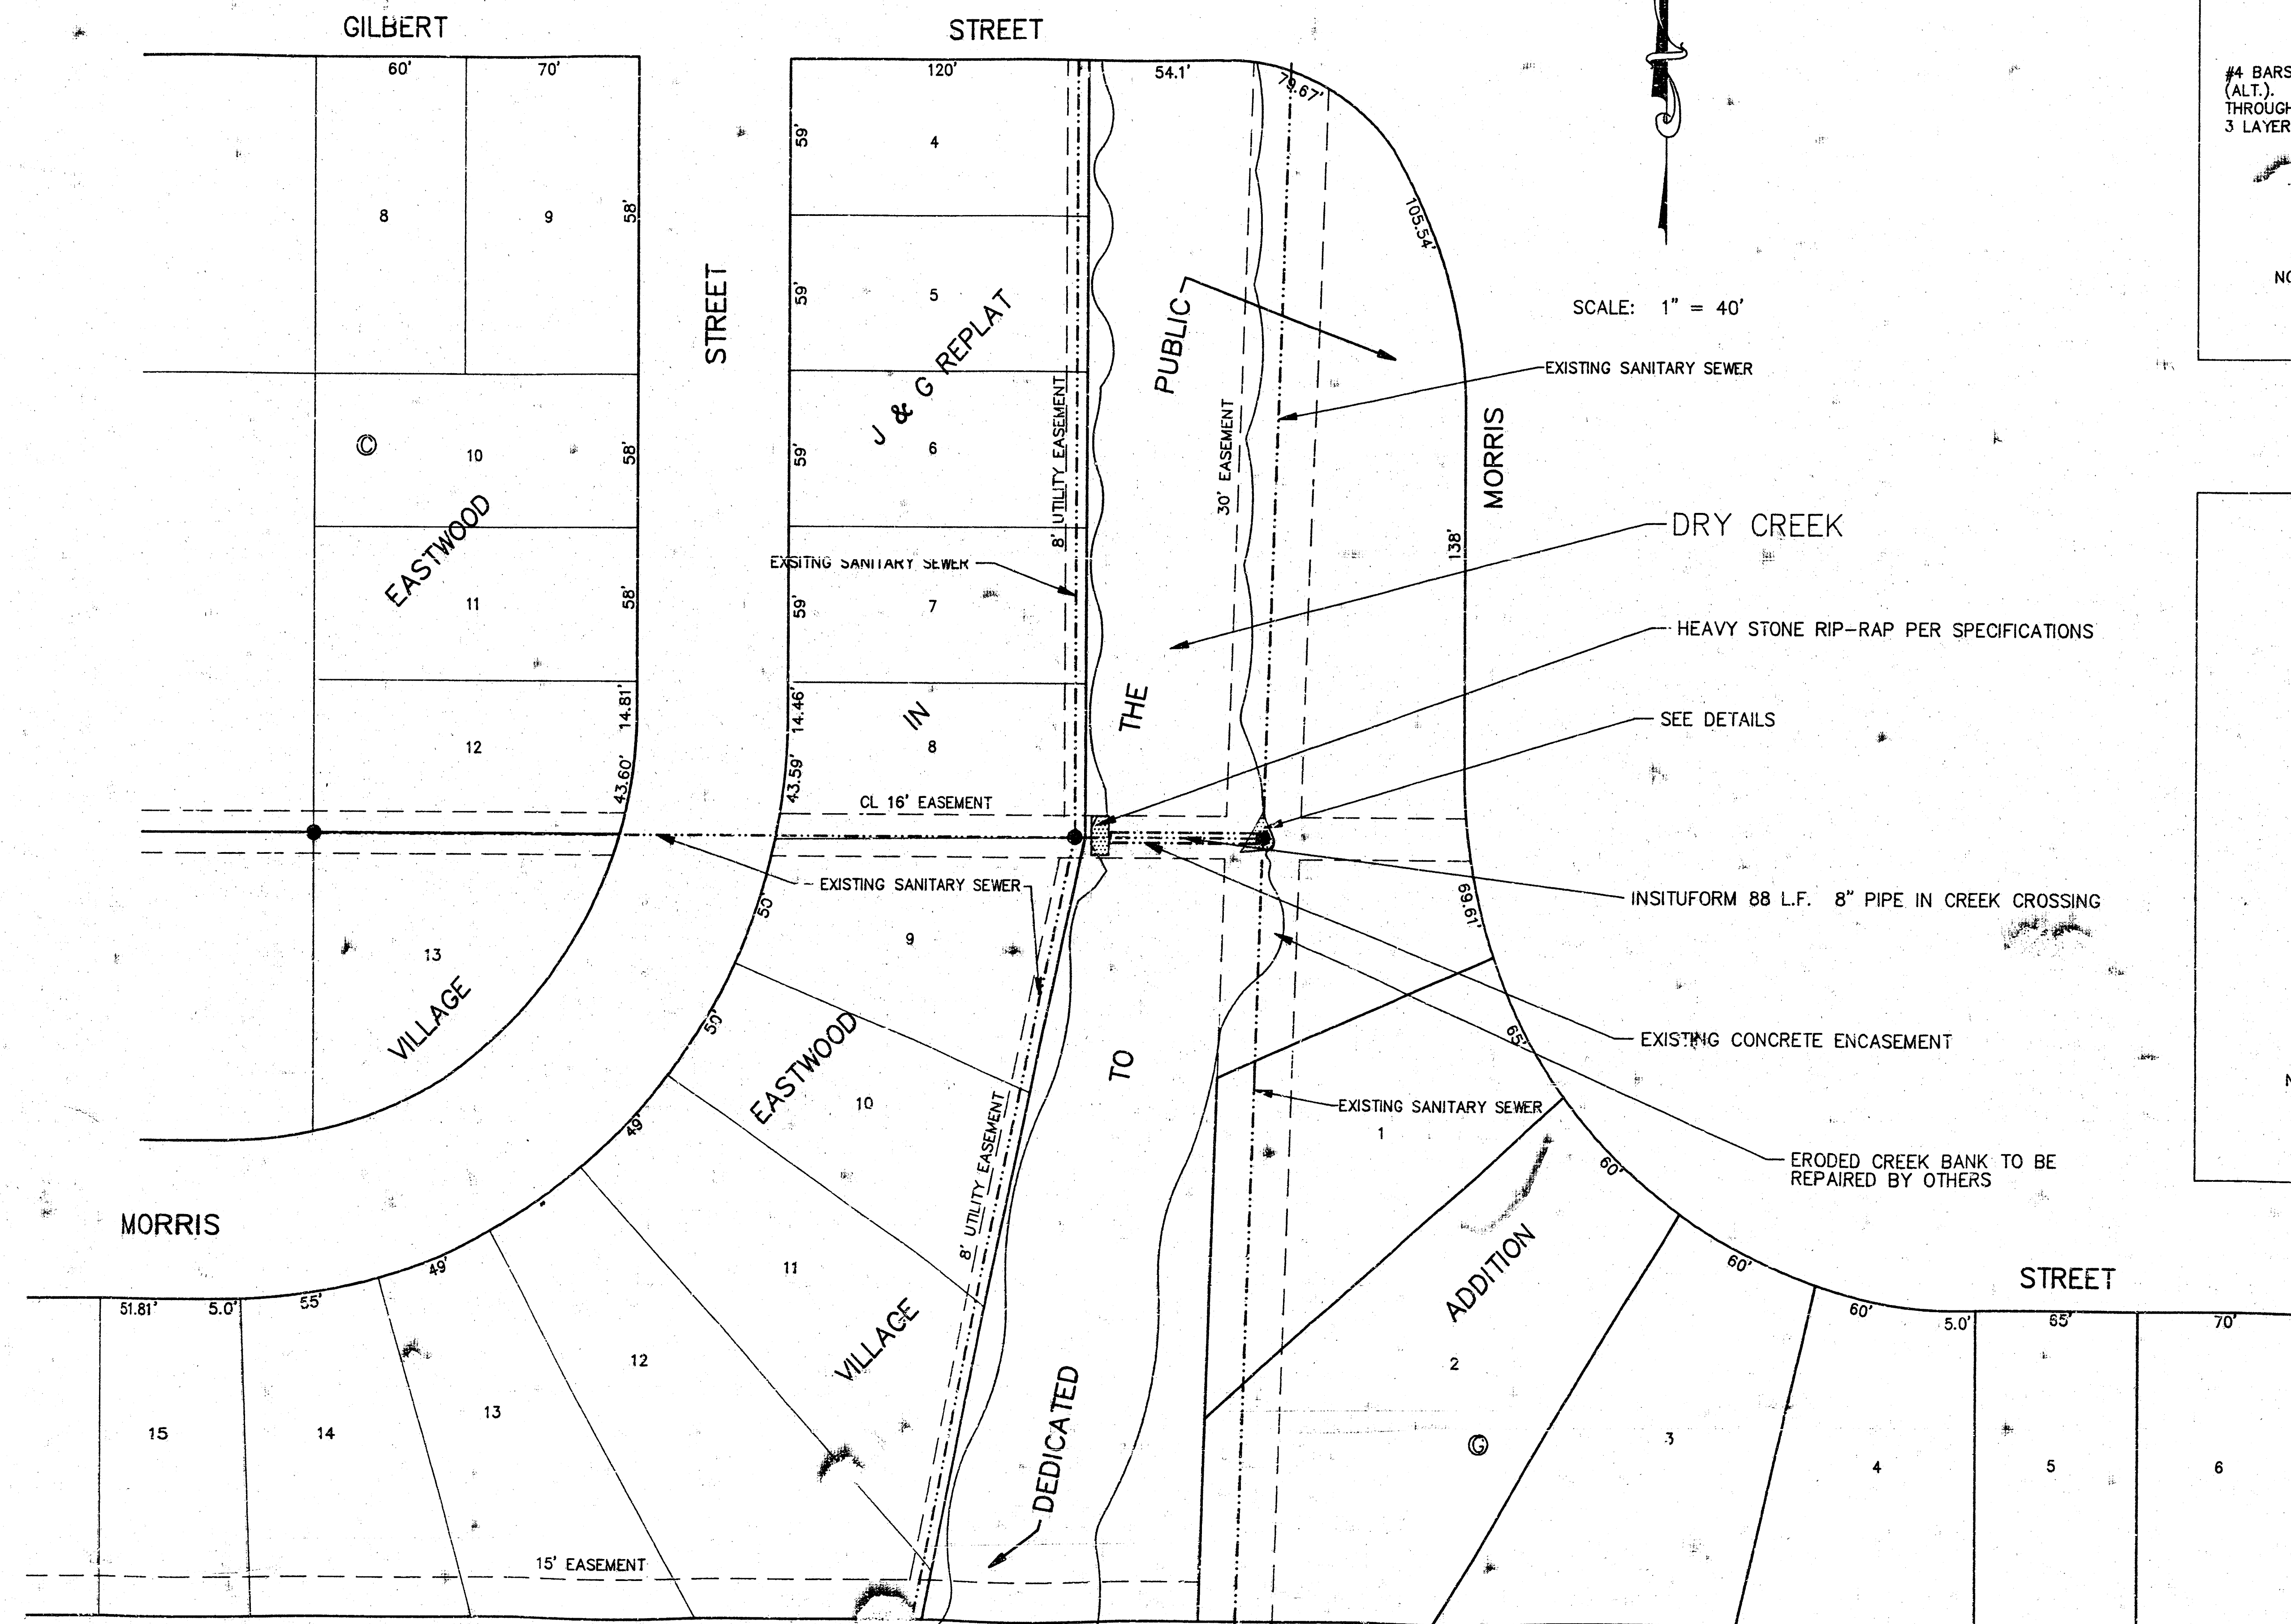

PROJECT LOCATION

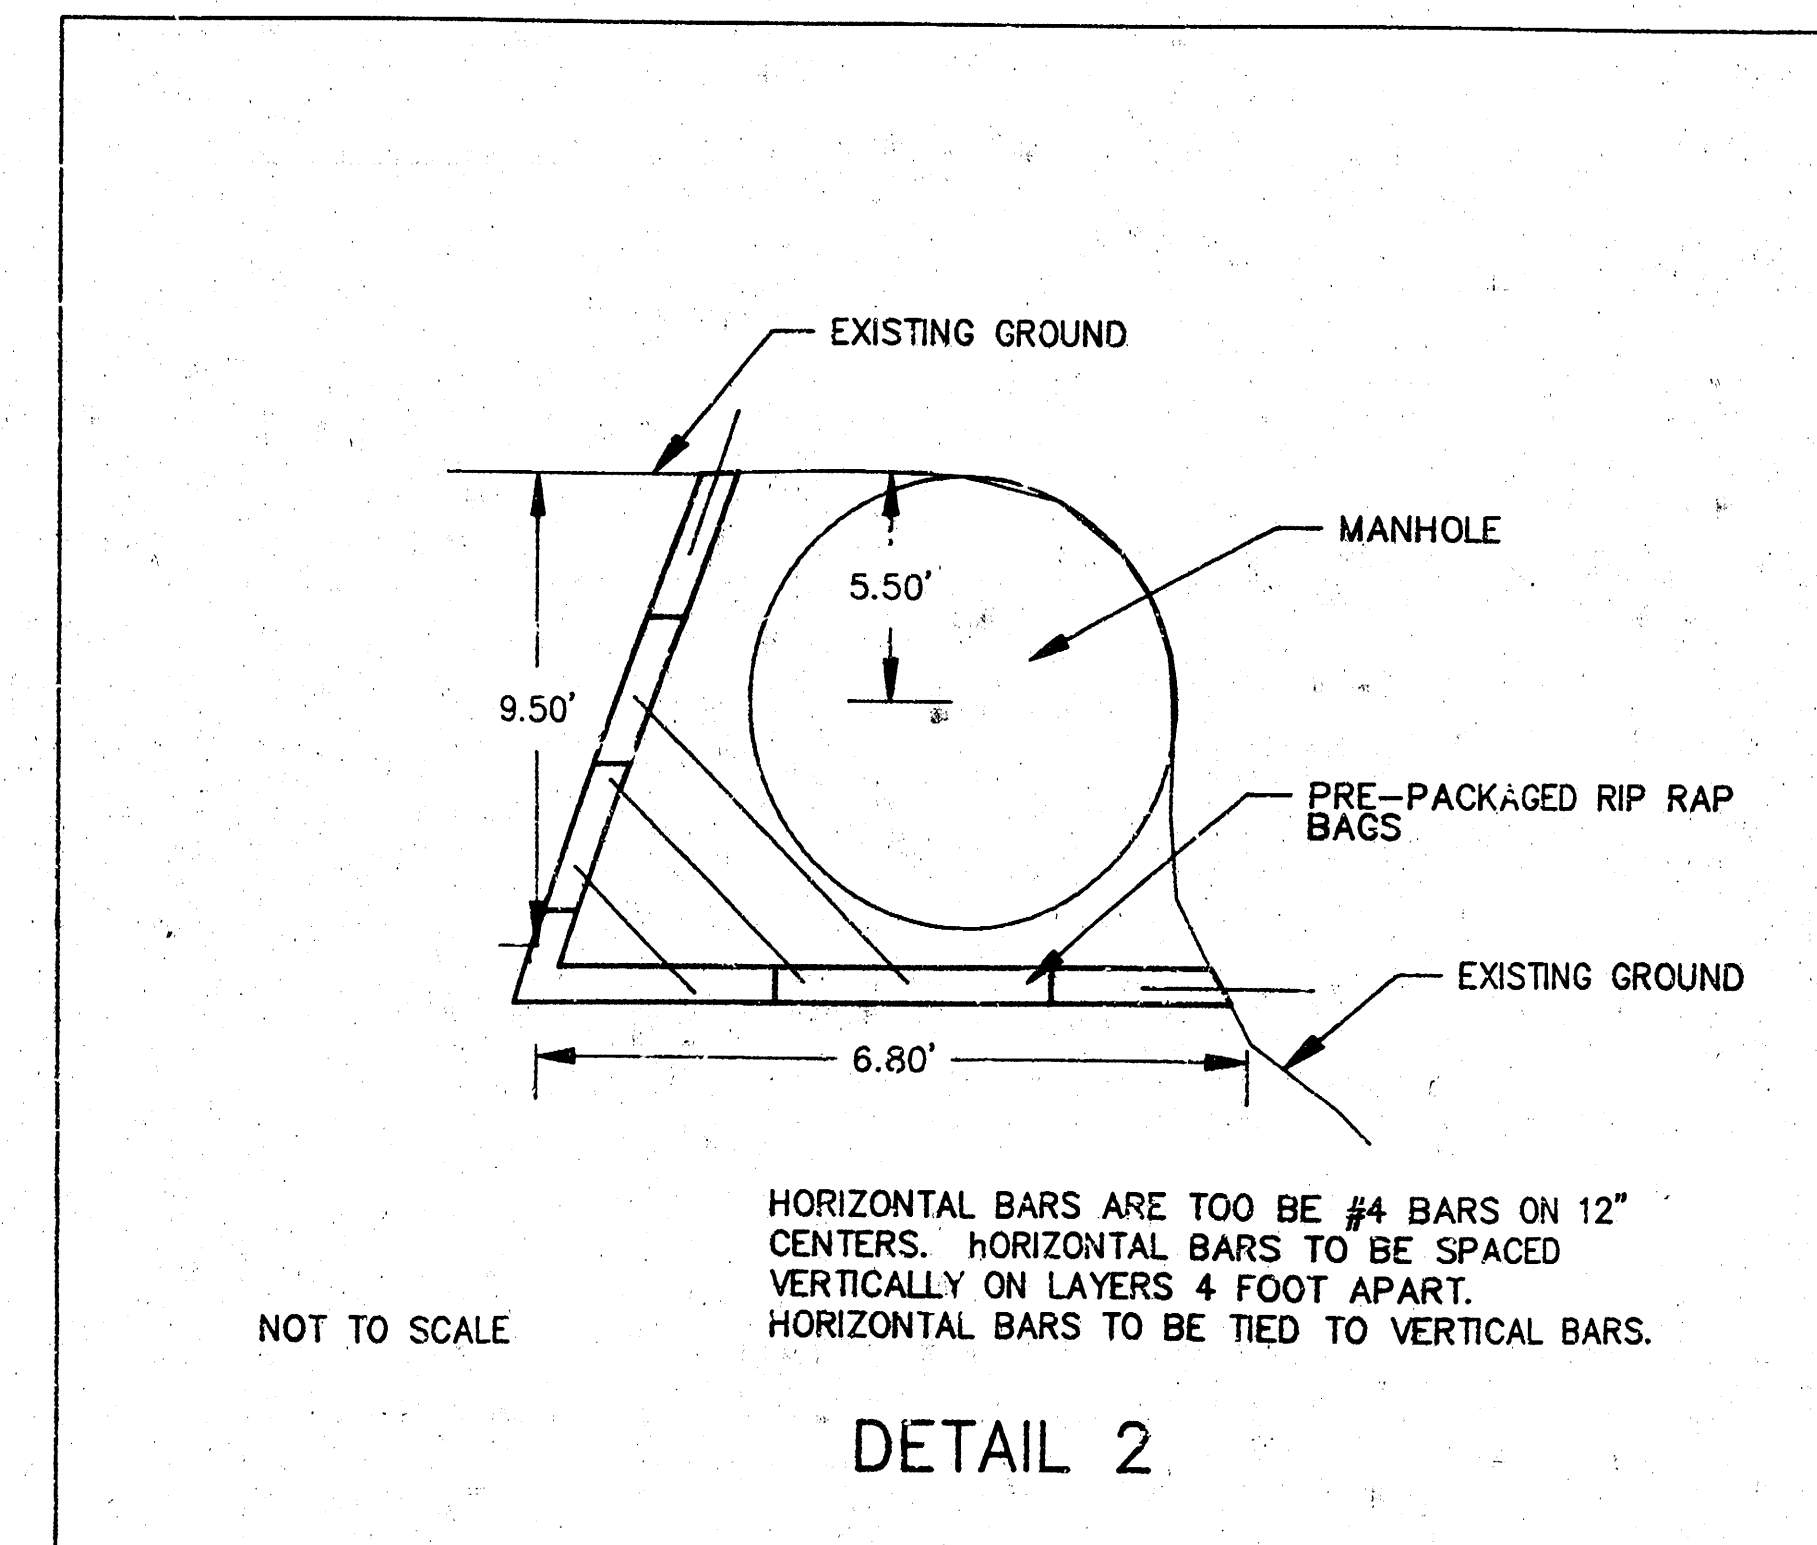

SCALE: 1" = 40'

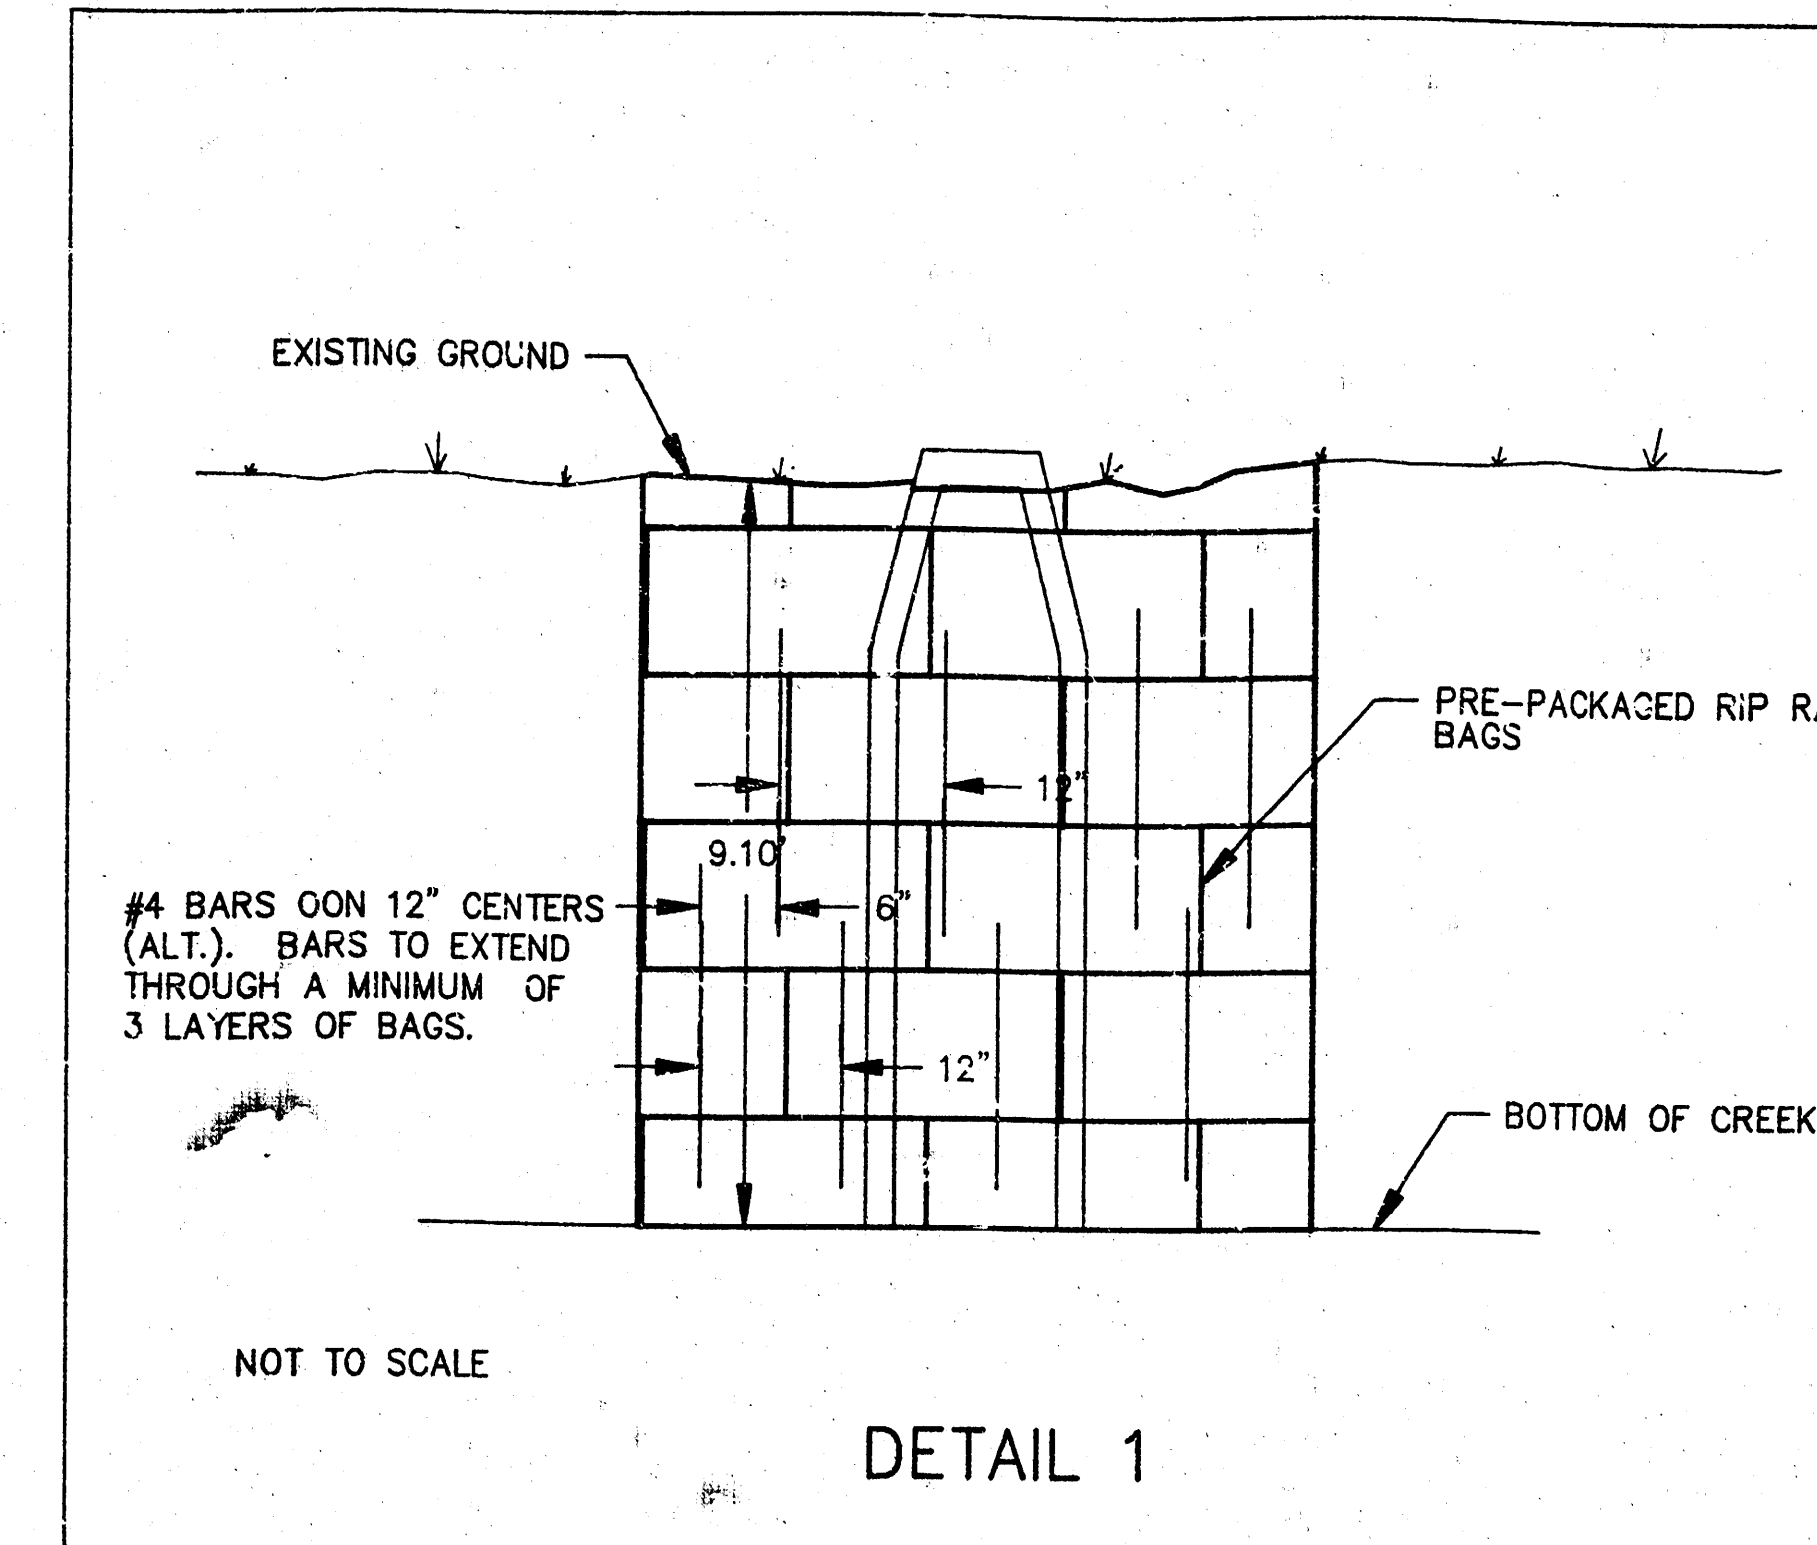

1994 Sanitary Sewer
Rehabilitation Program
Phase I



PROJ. NO. 468-82399
INDEX NO. 623124
DRAWN BY J. BRIGGS

SHEET 1 OF 1

Booked 2-15-95
JJB
As Per Plan