

931 PPS

PRIVATE SANITARY SEWER TO SERVE Ridgeport North Addition

LOT 1

Private Project Number 931 PPS (607861)

CITY OF WICHITA, KANSAS

Michael E. Lindebak, P.E. City Engineer

September, 1999


931 PPS
928 PPS
MICROFILM

Index

- Cover Sheet
- Plan/Profile Sheet Line 1
- Manhole Details
- Lid & Rim Details
- Copy Of Plot



Benchmarks:

1. "X" S.E. Cor. Bridge Deck 1/2 Mile N. Of 29th St. N.
On Ridge Rd.
ELEV. = 139.14 City Datum (1326.54 M.S.L.)
2. 60d Step Bench E. Side HLP 1936' S Of @
37th St. N. E. Side Ridge
ELEV. = 140.81 City Datum (1328.21 M.S.L.)
3. 60d Step Bench E. Side HLP 1405' S Of @
37th St. N. E. Side Ridge
ELEV. = 141.18 City Datum (1328.58 M.S.L.)
4. 60d Step Bench E. Side HLP 592' S Of @
37th St. N. E. Side Ridge
ELEV. = 142.14 City Datum (1329.54 M.S.L.)
5. Co. B.M. " " On S. Hubguard RCBC 73' W. Of
@ Ridge Road On 37th St. N.
ELEV. = 144.12 City Datum (1331.52 M.S.L.)

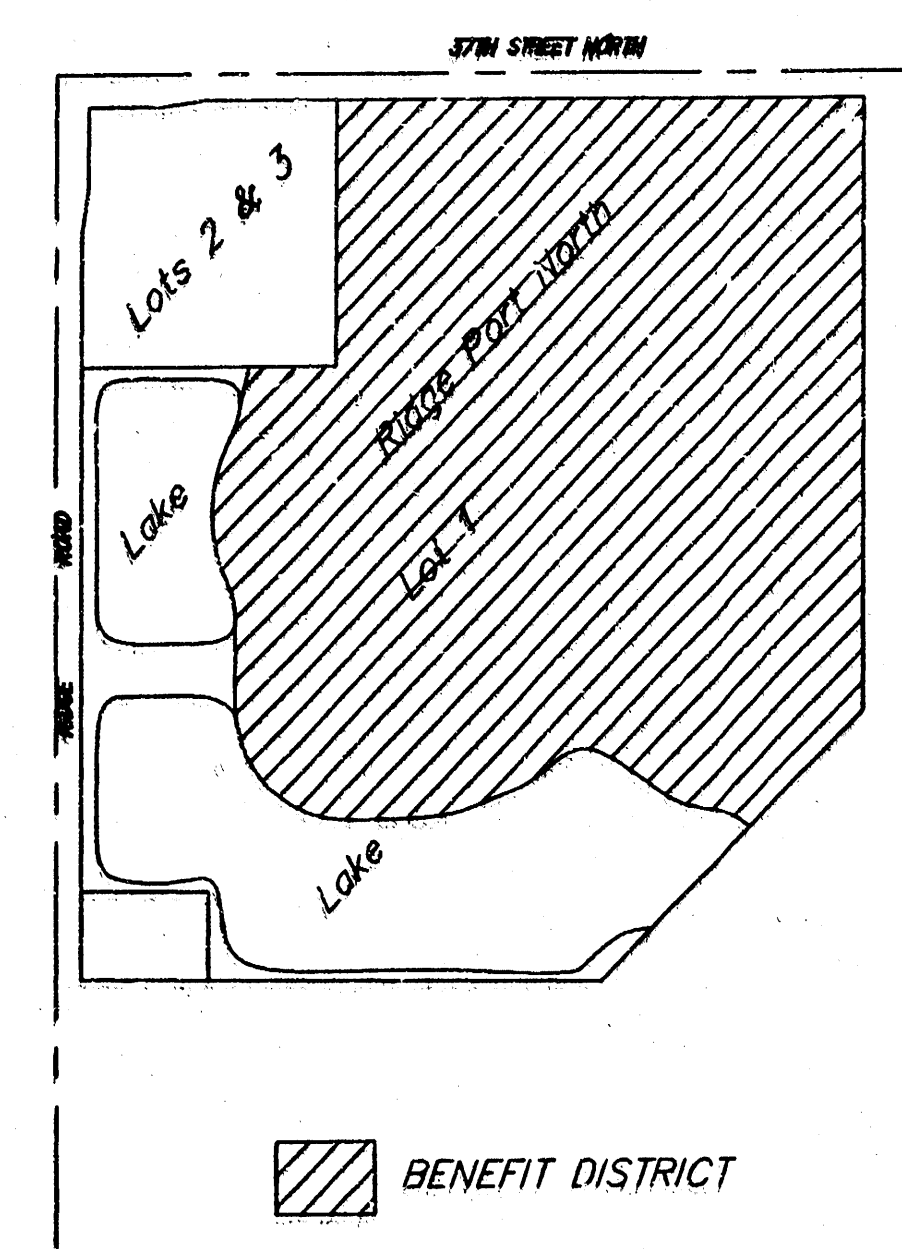

General Notes

1. Contractor will be required to provide notice to utility companies a minimum of forty-eight (48) hours prior to any excavation, as follows:
Kansas One-Call 687-2470
The Contractor must notify the following in case of an emergency:
MultiMedia Cablevision 262-4270
Kansas Gas Service Company 383-8650
Kansas Gas & Electric Company 383-8600
Peoples Gas Company 942-7600
Southwestern Bell Telephone Company 1-571-2611
City of Wichita Water Department 268-4908
City of Wichita Sewer Department 268-4071
2. The Contractor shall be responsible for preserving property irons. The Contractor will be required to re-establish any property irons which are damaged or destroyed by his construction operations. Such irons shall be re-established by a licensed land surveyor in accordance with state laws.
3. The Contractor shall notify pipeline companies at least 48 hours in advance of work being performed across and/or adjacent to pipelines.
4. All areas disturbed by construction operations shall be seeded with rye grass at a rate of 6 lbs. per 1000 sq. feet or as per city specs. Contractor to prepare ground to city specifications.
5. Utility service lines, poles, valve boxes, meters, et cetera are to be adjusted as necessary by others prior to construction unless the plans specifically call for their adjustment by the Contractor or unless the plans specifically identify a utility to be adjusted by its owner during construction. Existing utilities and their location, as shown on the plans, represent the best information obtainable for design and shall be field verified. The contractor will be required to work around existing utilities within the right-of-way which do not conflict with proposed construction.
6. Contractor shall not start work on the project until the project inspector is assigned to the project and is present on the site. Any work done without inspection will be required to be uncovered for inspection.
7. Rubble from the removal of miscellaneous structures and excess excavation which is to be wasted shall be disposed of on sites to be provided by the Contractor. These sites shall be approved by the Engineer as to suitability, appearance and site location. Locations that, in the opinion of the Engineer, will leave an unsightly appearance will not be approved. All disposal sites must be approved by the Kansas Department of Health and Environment. Material either stockpiled or disposed of in a flood plain would require a Kansas State Board of Agriculture permit. Any material dumped in waters of the United States or wetlands is subject to U.S. Corps. of Engineers permitting regulations. Any material buried or stockpiled beyond approved construction limits would require additional archaeological investigations unless buried in a previously approved borrow location.
8. Contractor will coordinate project construction with other public and private contracts to serve area.

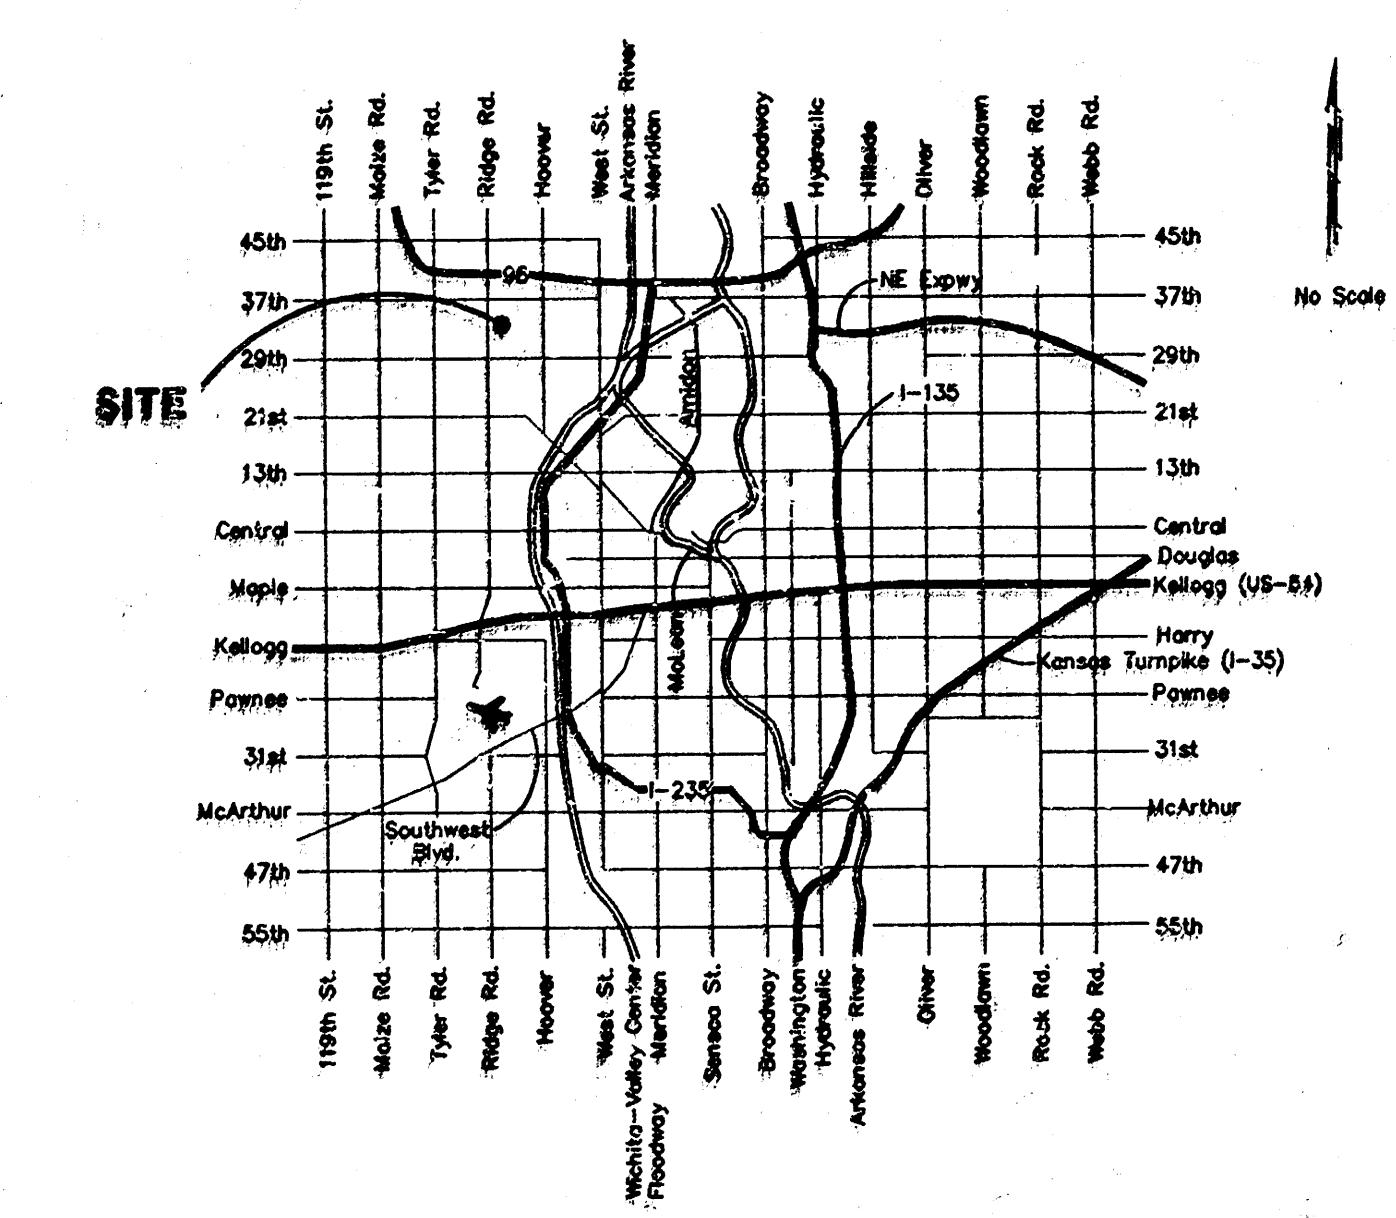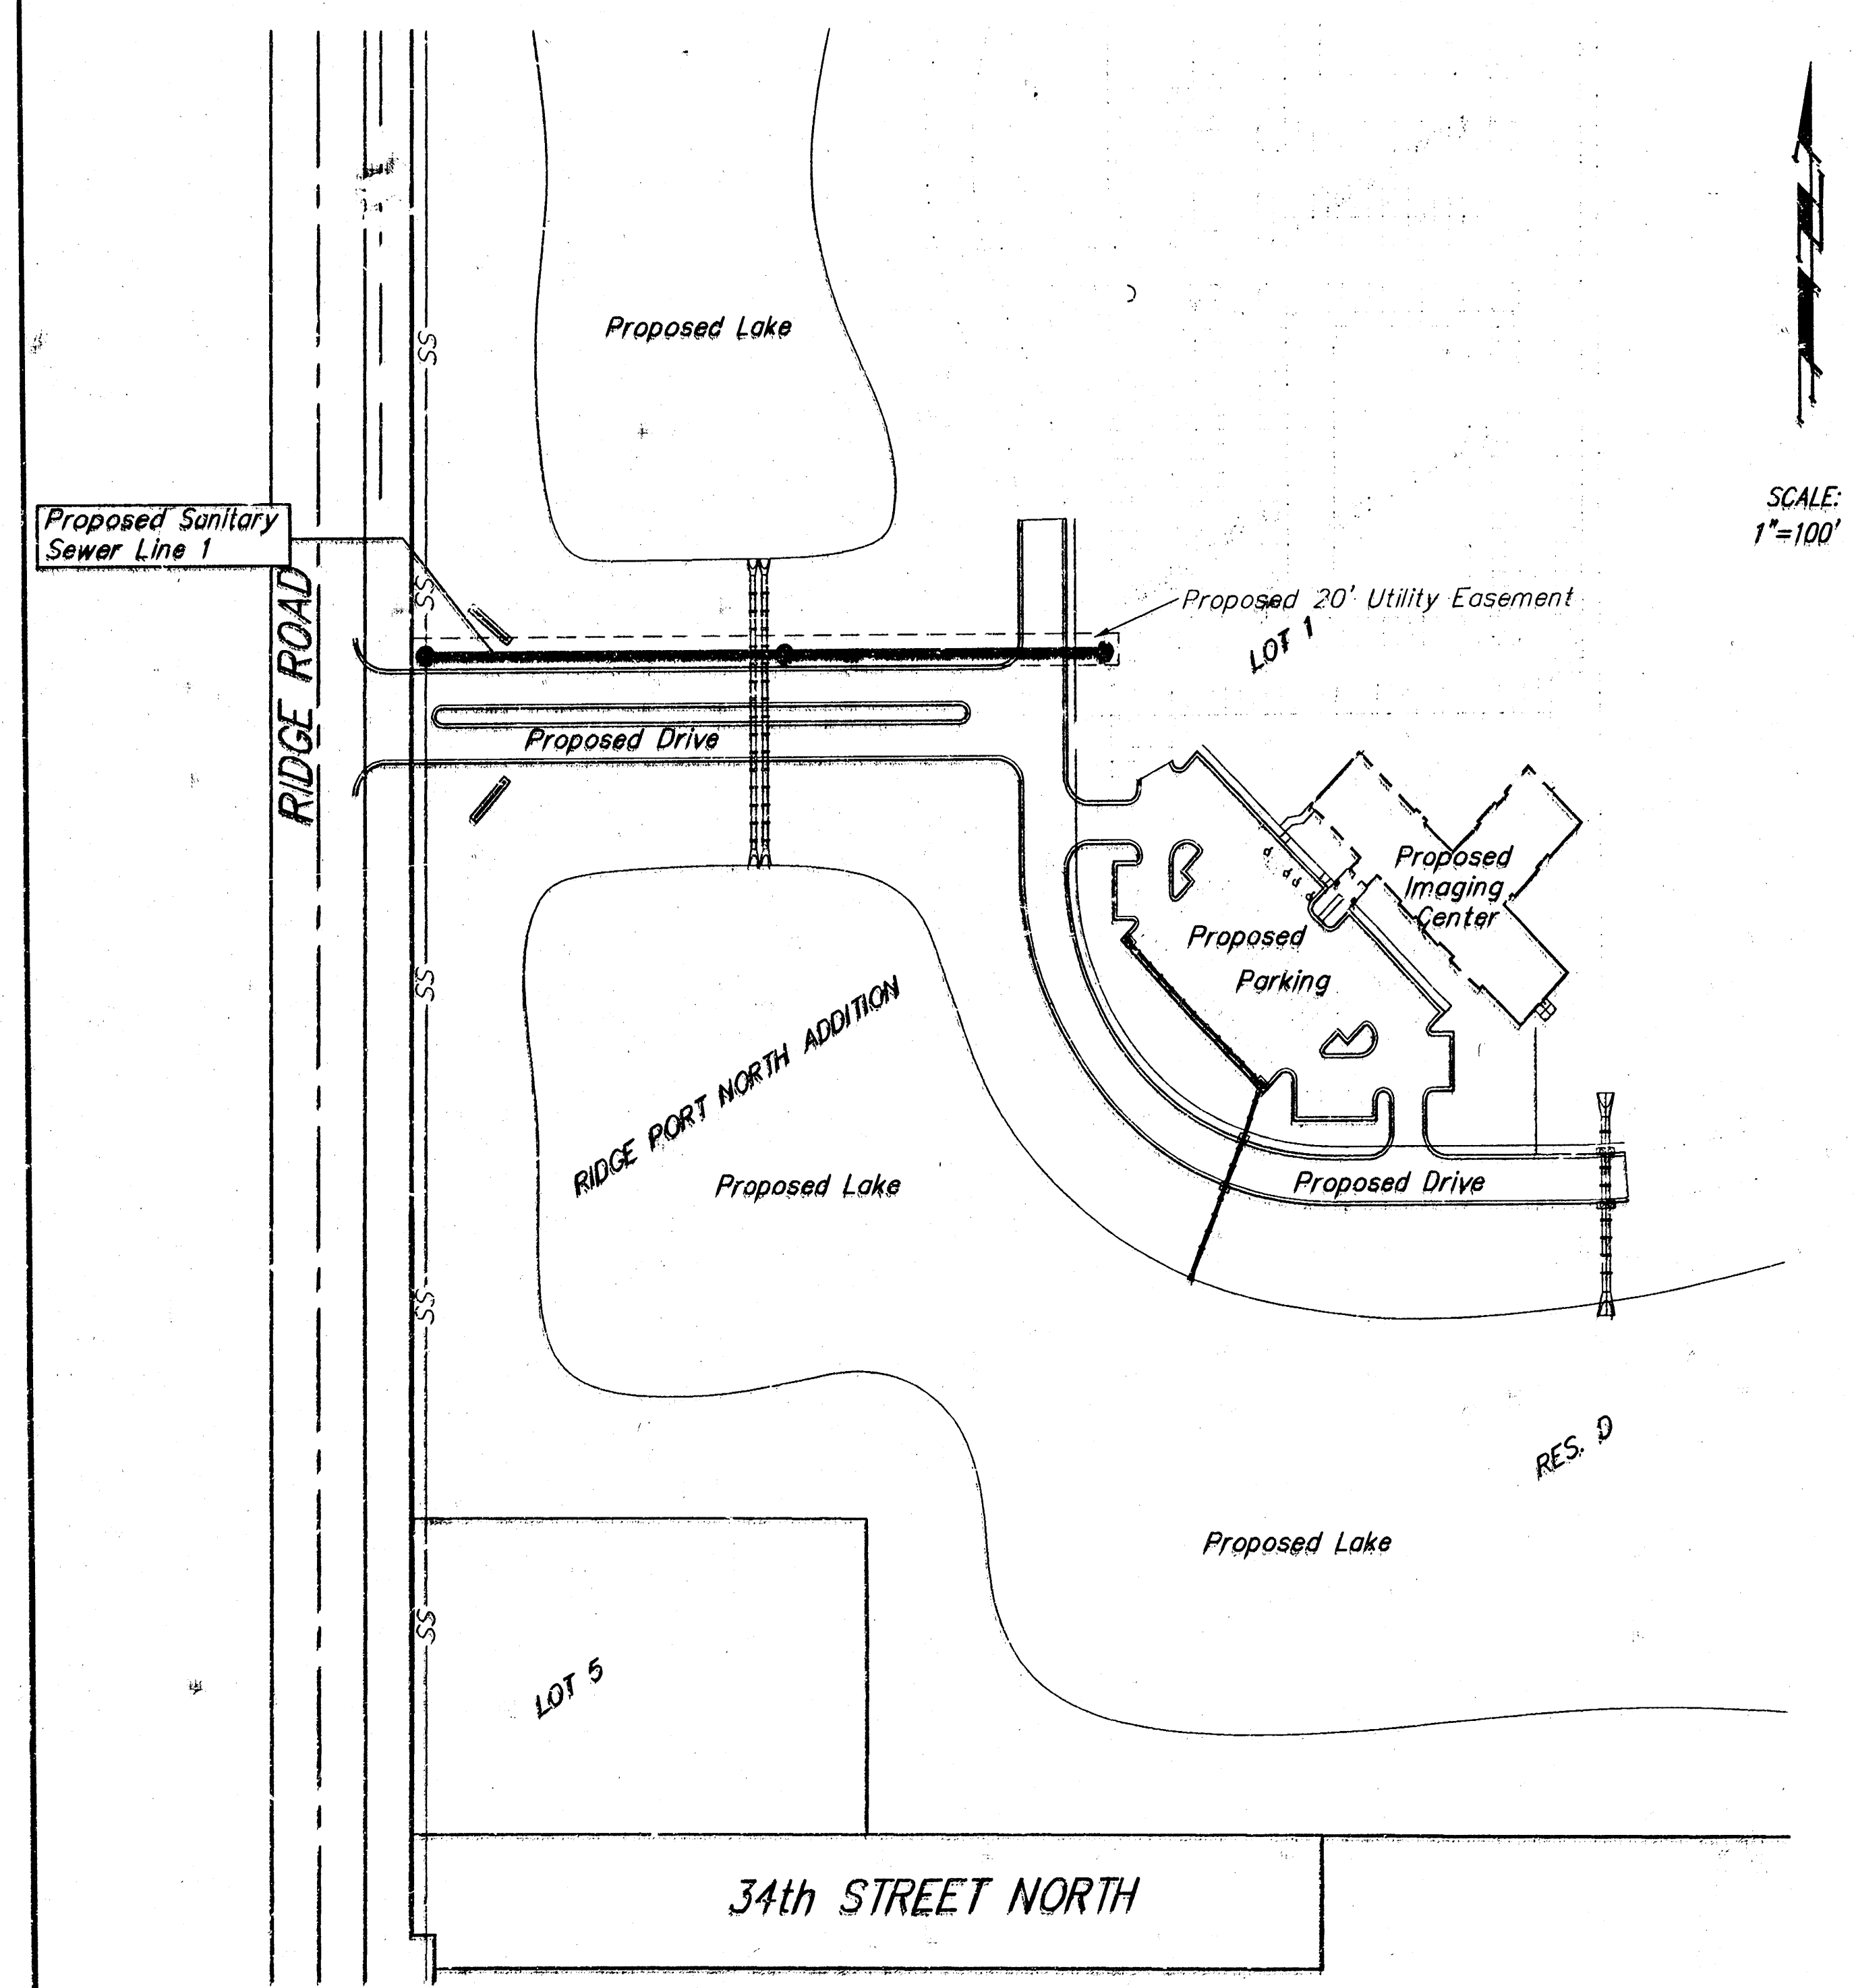

APPROVED AS NOTED
BY CITY ENGINEER OF WICHITA
Sanitary Sewers URH 9/17/99
NOTE TO CONTRACTORS
Installation, inspection and testing for this project is to be provided by a Licensed Consulting Engineering Firm under contract with the Owner/Developer. Said inspection to be in accordance with the City of Wichita standard construction engineering practices and certified by a Licensed Professional Engineer. No work shall be performed in dedicated easements or public right-of-way by the Contractor without such inspection nor shall any work be commenced without written authorization by the City Engineer. All Construction and Materials shall comply with the City of Wichita Specifications and Standards (on file and available in the City Engineer's Office).

Booked
P-117
3-13-DD
RDL

Built by
WILCO CAT CONST.

Location Map




PROJECT INSPECTED + ASBUILT
BY BAUGHMAN COMPANY, P.A. 3/2000 JMN

BAUGHMAN COMPANY P.A.
ENGINEERING, SURVEYING, & PLANNING
316-262-7271 • 315 ELLIS • WICHITA, KANSAS 67211


16-10-4-B

BENCHMARKS:

1. "□" S.E. Cor. Bridge Deck 1/2 Mile N. Of 29th St. N. On Ridge Rd.
ELEV. = 139.14 City Datum (1326.54 M.S.L.)
2. 60d Step Bench E. Side HLP 1936' S Of @ 37th St. N. E. Side Ridge
ELEV. = 140.81 City Datum (1328.21 M.S.L.)
3. 60d Step Bench E. Side HLP 1405' S Of @ 37th St. N. E. Side Ridge
ELEV. = 141.18 City Datum (1328.58 M.S.L.)
4. 60d Step Bench E. Side HLP 592' S Of @ 37th St. N. E. Side Ridge
ELEV. = 142.14 City Datum (1329.54 M.S.L.)
5. Co. B.M. " " On S. Huguard RCBC 73' W. Of @ Ridge Road On 37th St. N.
ELEV. = 144.12 City Datum (1331.52 M.S.L.)

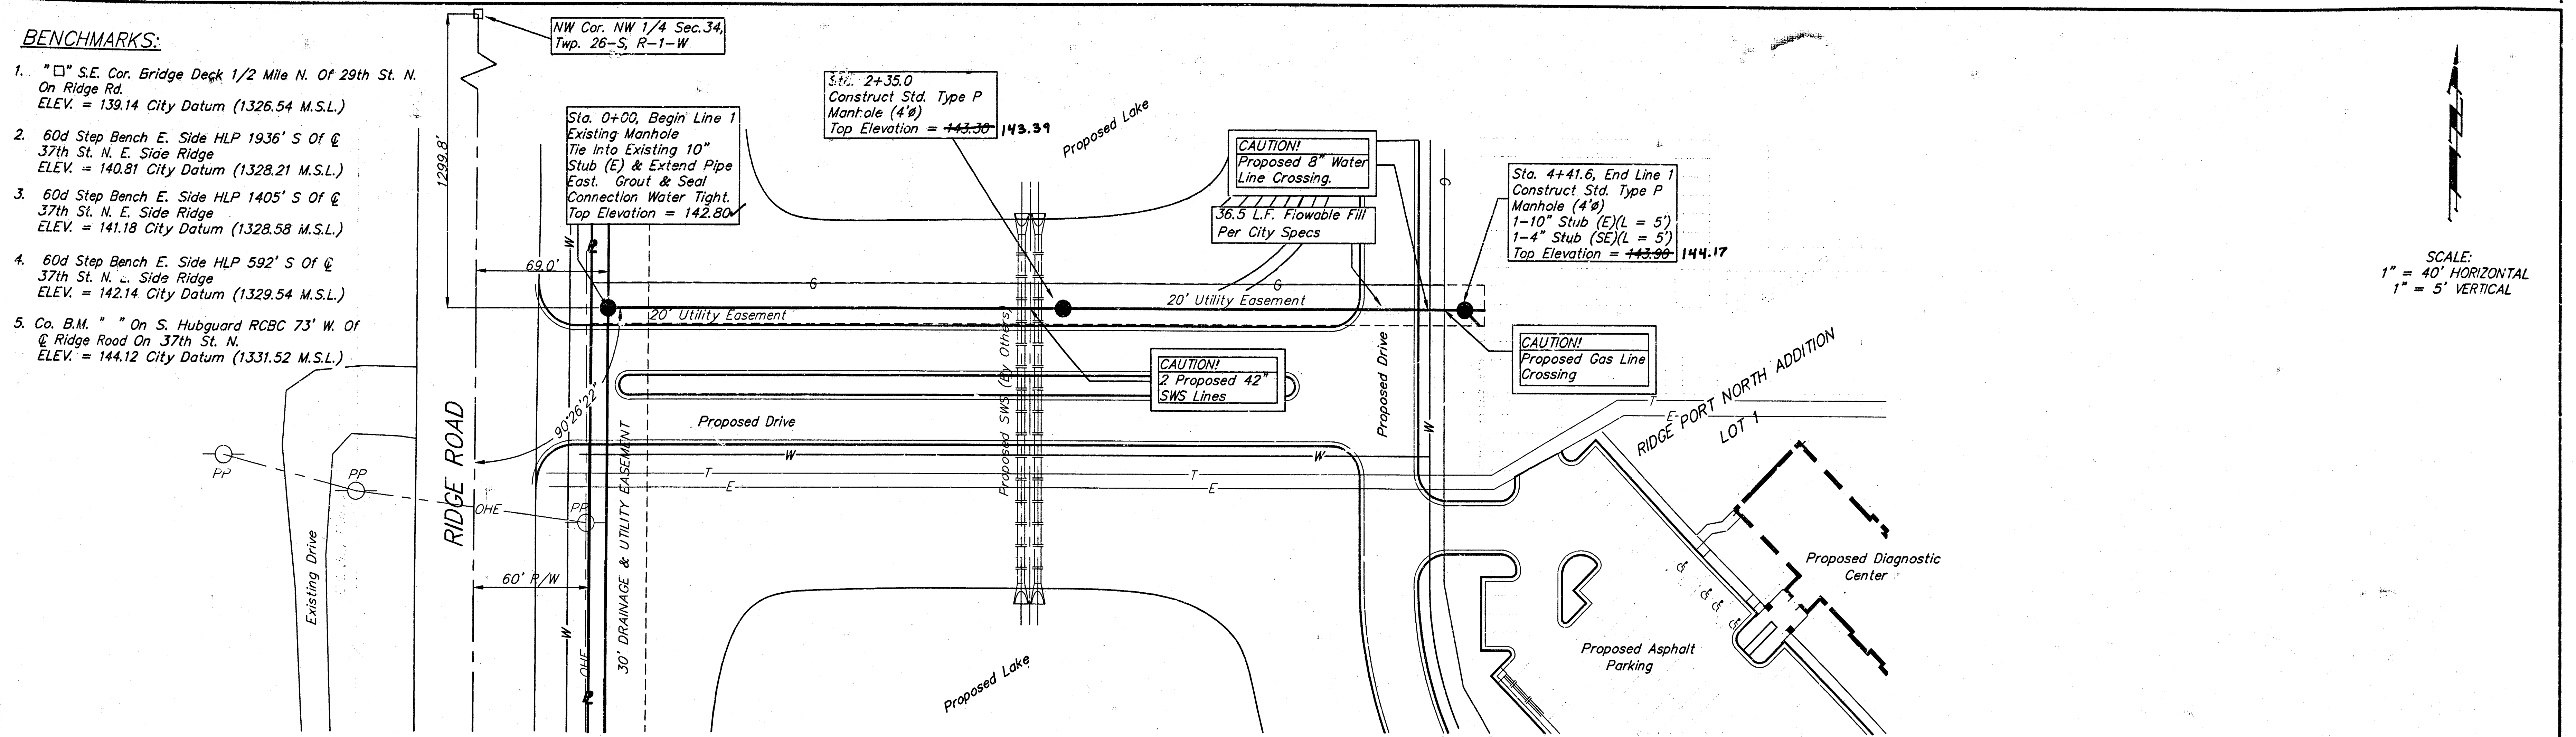

SCALE:
1" = 40' HORIZONTAL
1" = 5' VERTICAL

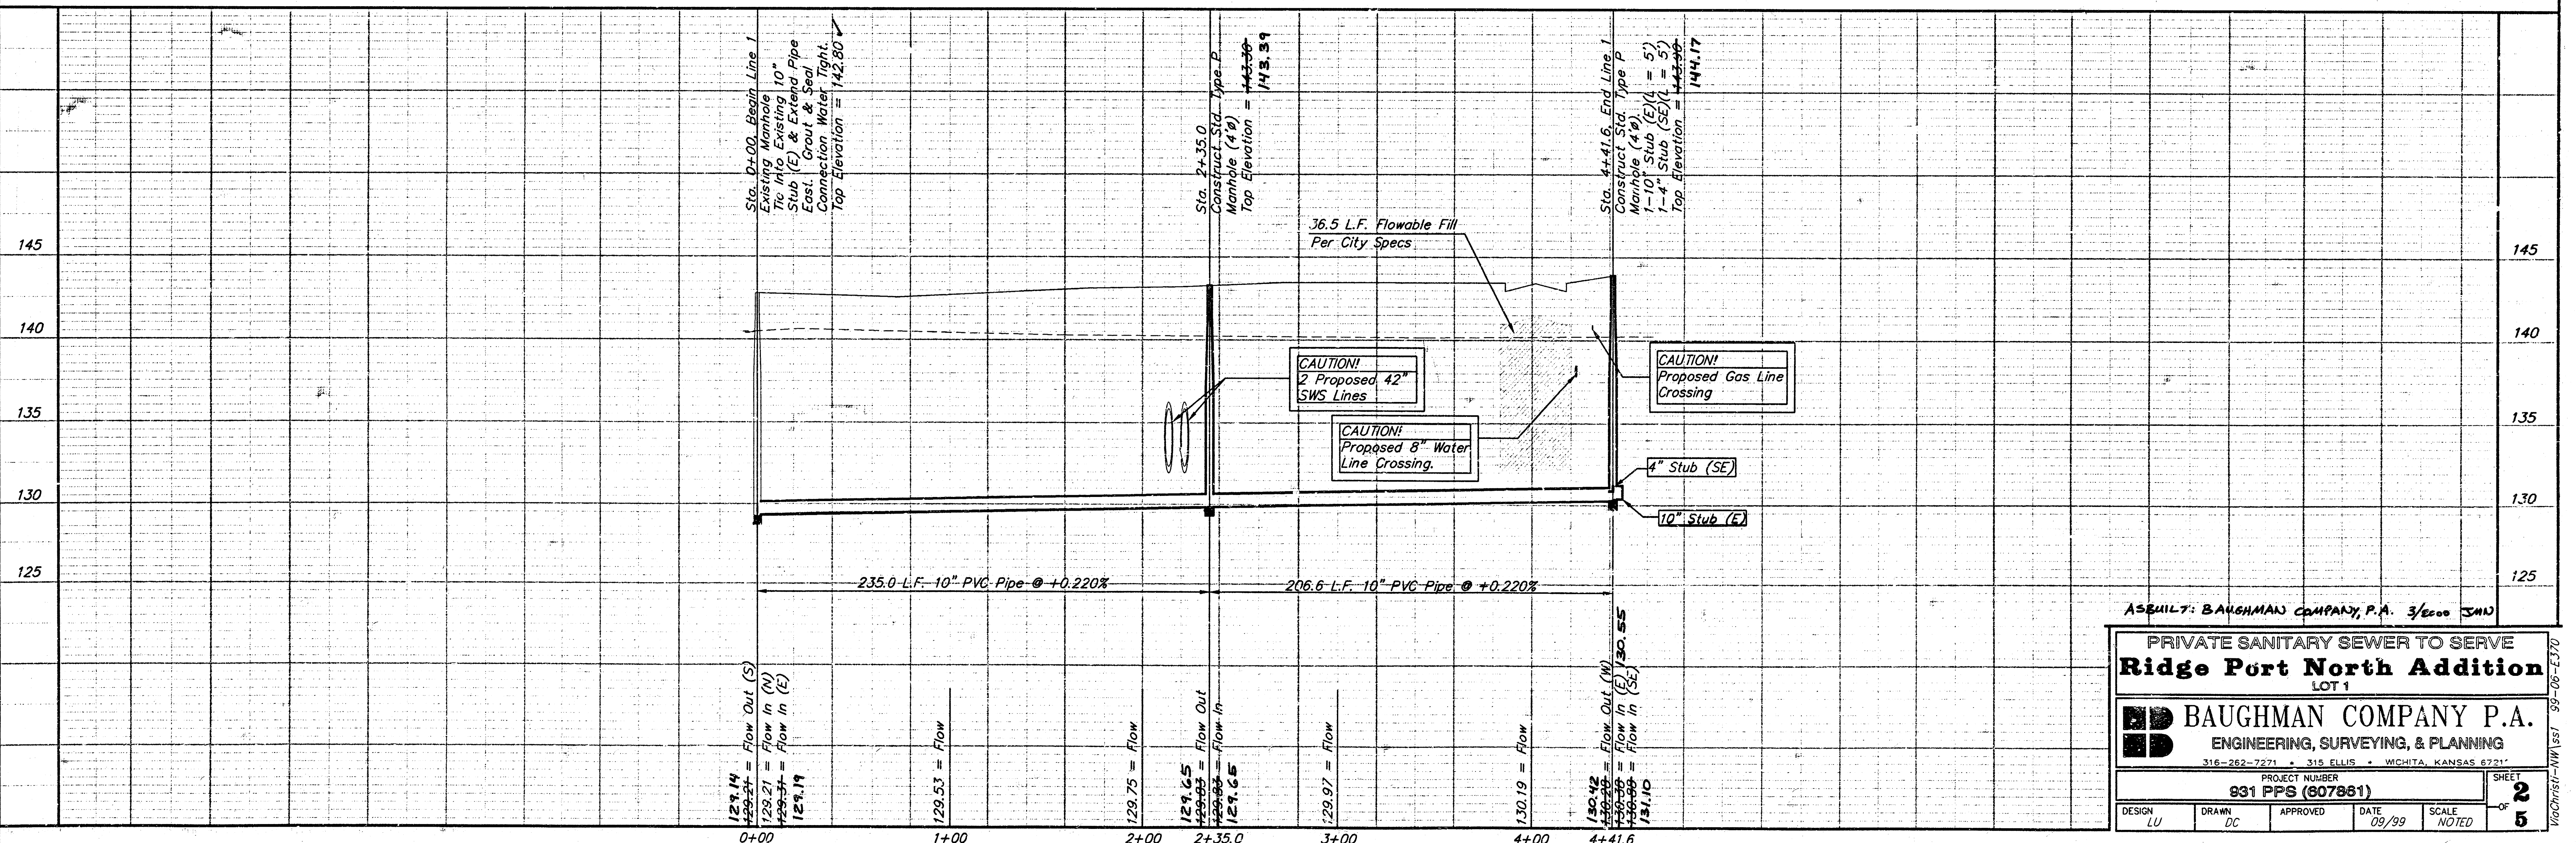

ASSEMBLY: BAUGHMAN COMPANY, P.A. 3/2000 JMD

**PRIVATE SANITARY SEWER TO SERVE
Ridge Port North Addition
LOT 1**


BAUGHMAN COMPANY P.A.
ENGINEERING, SURVEYING, & PLANNING
315-282-7271 • 315 ELLIS • WICHITA, KANSAS 67211

PROJECT NUMBER: **931 PPS (907881)**

DESIGN: LU DRAWN: DC APPROVED: DATE: 09/99 SCALE: NOTED

SHEET: **2** OF **5**

SEWER APPURTENANCES DETAILS

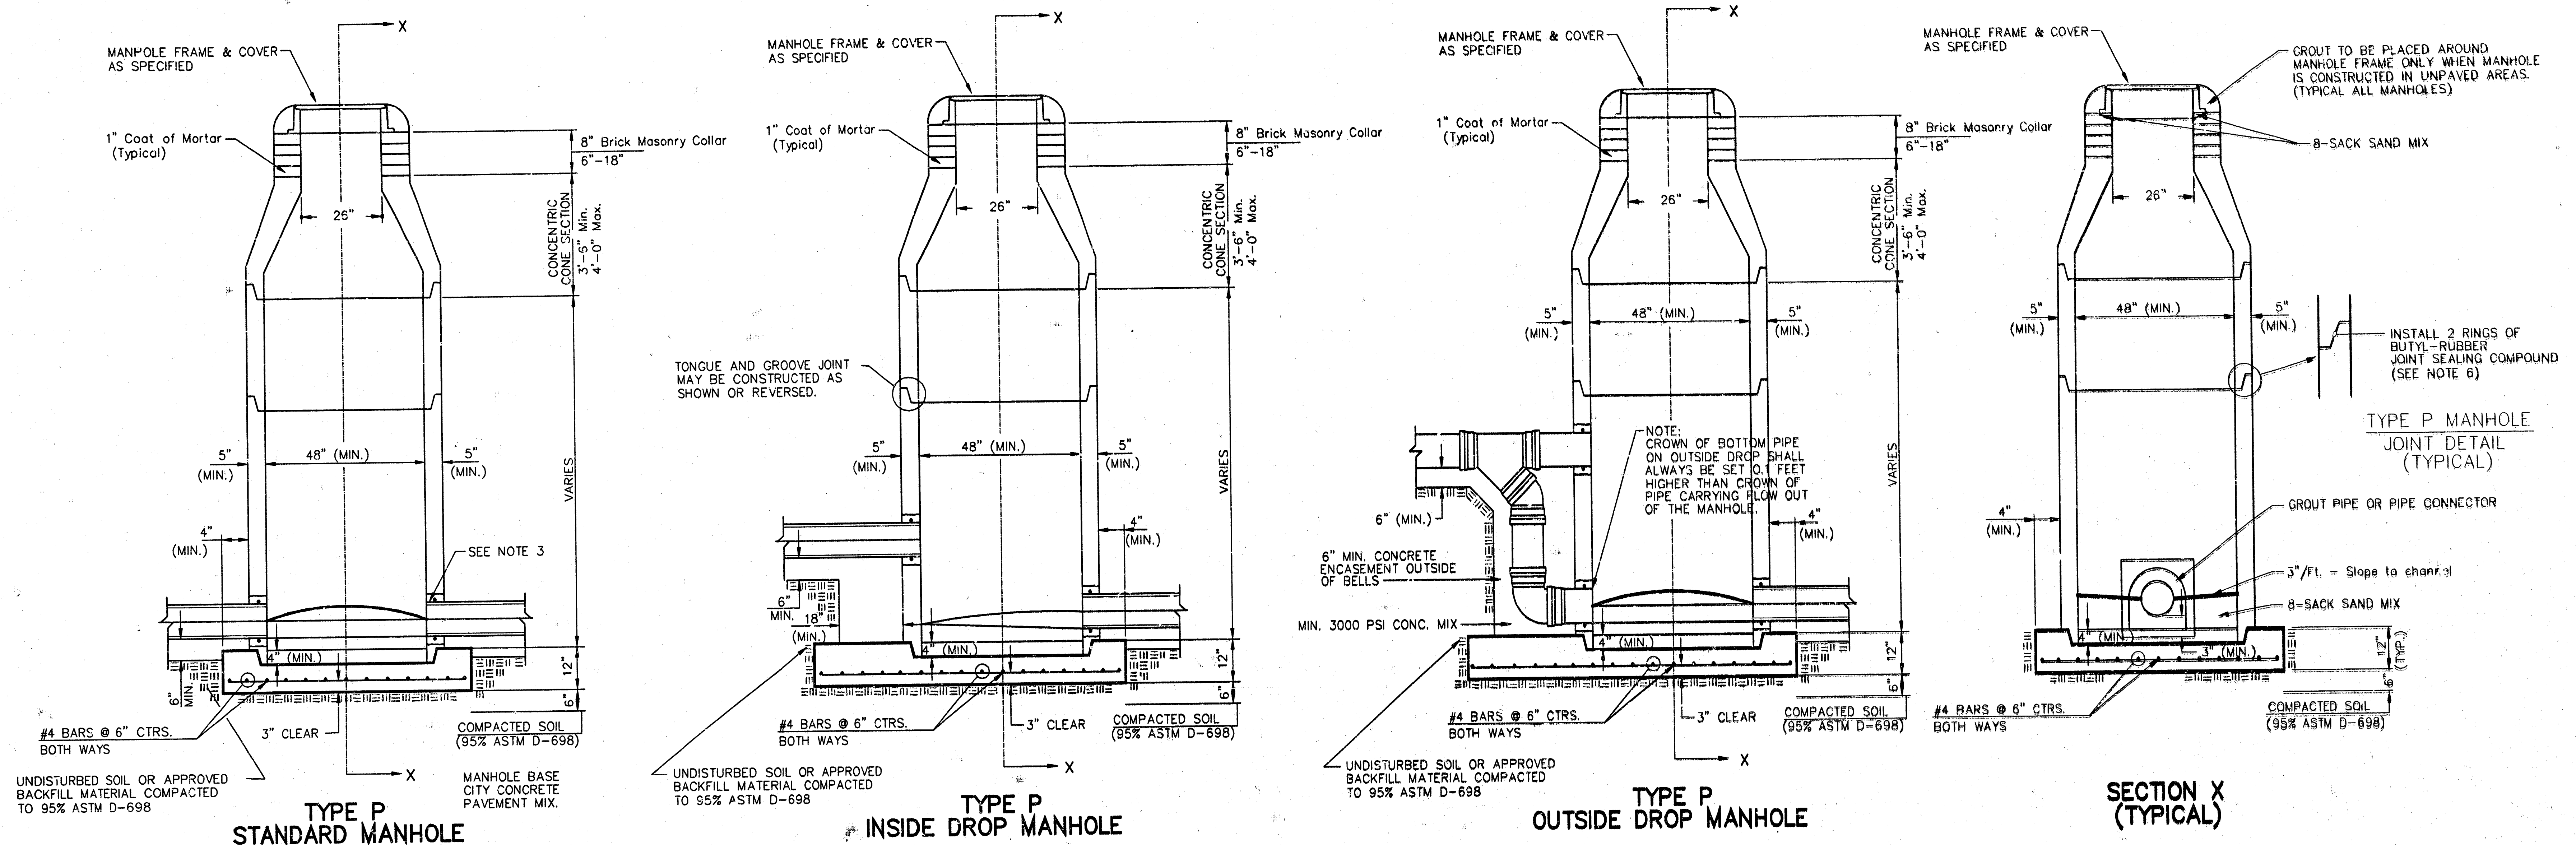


GENERAL NOTES

- ALL PRECAST CONCRETE MANHOLE SECTIONS SHALL CONFORM TO THE LATEST REVISIONS OF A.S.T.M. C478 AS MODIFIED BY THE SPECIFICATIONS.
- NON-SHRINK GROUT SHALL BE NON-METALLIC TYPE.
- APPROVED FLEXIBLE WATERSTOP GASKETS SHALL BE INSTALLED TO JOIN THE SEWER TO THE MANHOLE WALL WHEN A.B.S. COMPOSITE PIPE OR P.V.C. PIPE IS USED. FOR OTHER TYPES OF PIPE THE SEWER PIPE SHALL BE GROUTED IN PLACE WITH NON-SHRINK GROUT. THE SEWER PIPE SHALL BE SUPPORTED WITH CONCRETE ENCASEMENT A MINIMUM OF 3 FEET FROM THE MANHOLE WALL AND TO THE FIRST JOINT FOR V.C.P. SUCH THAT THE JOINT REMAINS FLEXIBLE.
- ALL INSIDE SURFACES OF THE CONCRETE MANHOLE WHICH WOULD BE EXPOSED TO SEWER GAS SHALL BE COATED WITH 2 COATS INEMEC SERIES 66 HI-BUILD EPOXYLINE, DRY THICKNESS OF 8 MILS (MIN.)
- EXTERIOR MANHOLE WALLS SHALL BE COATED WITH 1 COAT MOBILARMA 633 BITUMINOUS COATING.
- JOINT SEALING COMPOUND SHALL BE KENT SEAL NO. 2 OR APPROVED EQUAL.
- PRECAST MANHOLES SHALL BE SET AT LEAST 4 INCHES INTO THE MANHOLE BASE.
- TOP OF MANHOLE FLOOR SLAB SHALL BE AT LEAST 3 INCHES BELOW THE FLOW LINE OF THE OUTLET PIPE TO INSURE SUFFICIENT MINIMUM THICKNESS OF SHAPED INVERT.
- LIFTING HOLES SHALL BE FILLED WITH NON-SHRINK GROUT AND THE INTERIOR SURFACE COATED AS SPECIFIED.
- MORTAR USED IN MASONRY CONSTRUCTION SHALL CONTAIN 8 SACKS OF CEMENT PER CUBIC YARD. CONCRETE USED IN MANHOLE BASES SHALL CONFORM TO THE REQUIREMENTS OF CONCRETE FOR CONCRETE PAVEMENT CONSTRUCTION AS SPECIFIED IN THE CITY STANDARD PAVING SPECIFICATIONS USING CITY CONCRETE PAVEMENT MIX WITHOUT AIR ENTRAINING ADMIXTURE. MORTAR SHALL BE PLACED AROUND THE MANHOLE RING AS SHOWN ON THE DRAWINGS WHEN MANHOLES ARE CONSTRUCTED IN UNPAVED AREAS. MANHOLES CONSTRUCTED WHERE PIPE SIZES ARE SMALLER THAN 24\"

- REINFORCING STEEL SHALL BE INSTALLED IN THE MANHOLE BASES AND SHALL CONSIST OF NO. 4 BARS PLACED ON 6\"
- OPENINGS SHALL BE CUT INTO THE MANHOLE WALL WHEN OUTSIDE DROPS ARE CONSTRUCTED ON EXISTING MANHOLES. SUCH OPENINGS CUT INTO EXISTING MANHOLES SHALL BE AS SMALL AS PRACTICAL TO FACILITATE INSTALLING AND GROUTING THE NEW PIPE IN PLACE. WATERSTOP GASKETS SHALL BE USED WITH P.V.C. AND A.B.S. COMPOSITE PIPE. THE NEW PIPE SHALL BE GROUTED INTO THE OPENING USING AN APPROVED NON-SHRINK GROUT FOR THE FULL MANHOLE WALL THICKNESS. THE EXTERIOR OF THE COMPLETED CONNECTION SHALL BE SEALED WITH AN APPROVED BITUMINOUS COATING SUCH THAT THE CONNECTION WILL BE WATER TIGHT. FLOOR OF MANHOLE SHALL BE MODIFIED TO FORM NEW FLOW CHANNEL FOR THE NEW CONNECTION AS INDICATED BY THE DRAWING. THIS WORK, INCLUDING MODIFICATION OF MANHOLE FLOOR, SHALL BE PAID FOR AT THE UNIT PRICE BID FOR OUTSIDE DROP STACK CONSTRUCTED ON EXISTING MANHOLE.
- THE FLOORS OF ALL MANHOLES SHALL BE SHAPED WITH FLOW CHANNELS SUCH THAT THE MANHOLES WILL BE SELF CLEANING AND FREE OF AREAS WHERE SOLIDS COULD BE DEPOSITED AS SEWAGE FLOWS THROUGH THE MANHOLE FROM ALL INLET PIPES TO THE OUTLET PIPE. FLOW CHANNELS SHALL BE FORMED TO MATCH THE BOTTOM HALVES OF THE INFLOWING PIPES AND THE OUTFLOWING PIPE AS SHOWN BY THE DRAWINGS EXCEPT FOR INSIDE DROP MANHOLES. FLOW CHANNELS FOR INSIDE DROP MANHOLES SHALL BE CONSTRUCTED AS INDICATED BY THE DRAWING. MANHOLE FLOORS SHALL HAVE SLOPES OF 3 INCHES PER FOOT IN THE AREAS OUTSIDE OF THE FLOW CHANNELS SLOPED TOWARD THE FLOW CHANNELS. PIPES LAID THROUGH MANHOLES SHALL HAVE THE TOP HALF REMOVED TO NEAT LINES FOR THE FULL INSIDE DIAMETER OF THE MANHOLE. MANHOLE FLOORS SHALL THEN BE SHAPED AROUND THE BOTTOM HALF OF THE PIPE WHICH FORMS THE FLOW CHANNEL.
- PIPES INSTALLED WITHIN THE EXCAVATION MADE FOR THE MANHOLE SHALL BE CRADLED WITH CONCRETE TO THE LIMITS OF THE MANHOLE EXCAVATION. WHEN CLAY PIPE IS USED, THE CRADLE SHALL EXTEND TO THE FIRST JOINT OUTSIDE THE MANHOLE. THE CRADLE SHALL BE TERMINATED AT THE CLAY PIPE JOINT IN A MANNER WHICH WILL MAINTAIN THE FLEXIBILITY OF THE JOINT. MOST OF CRADLE WITHIN MANHOLE EXCAVATION OR TO CLAY PIPE JOINTS ADJACENT TO MANHOLE SHALL BE INCLUDED IN THE UNIT PRICE BID FOR THE MANHOLE.

- MANHOLE COVER CASTINGS AND MANHOLE FRAME CASTINGS SHALL CONFORM TO THE REQUIREMENTS AS INDICATED IN THE STANDARD SPECIFICATIONS AND AS SHOWN IN THE STANDARD DETAIL DRAWING.
- THE VERTICAL DROP IN INSIDE DROP MANHOLES SHALL NOT EXCEED 2' FOR INFLOWING PIPES SIZED 12\"
- STANDARD MANHOLES AND STANDARD INSIDE DROP MANHOLES SHALL BE BID AS STANDARD MANHOLES FOR THE TYPE AND DIAMETER INDICATED. OUTSIDE DROP MANHOLES SHALL BE BID AS STANDARD OUTSIDE DROP MANHOLES FOR THE TYPE AND DIAMETER INDICATED. ALL MANHOLE DIAMETERS WILL BE 4' UNLESS INDICATED OTHERWISE.
- A BRICK MASONRY COLLAR SHALL BE INSTALLED BETWEEN THE CAST IRON FRAME AND THE CONCENTRIC CONE. THE COLLAR WILL HAVE 8\"

ALTERNATE CONSTRUCTION IN UNPAVED AREAS

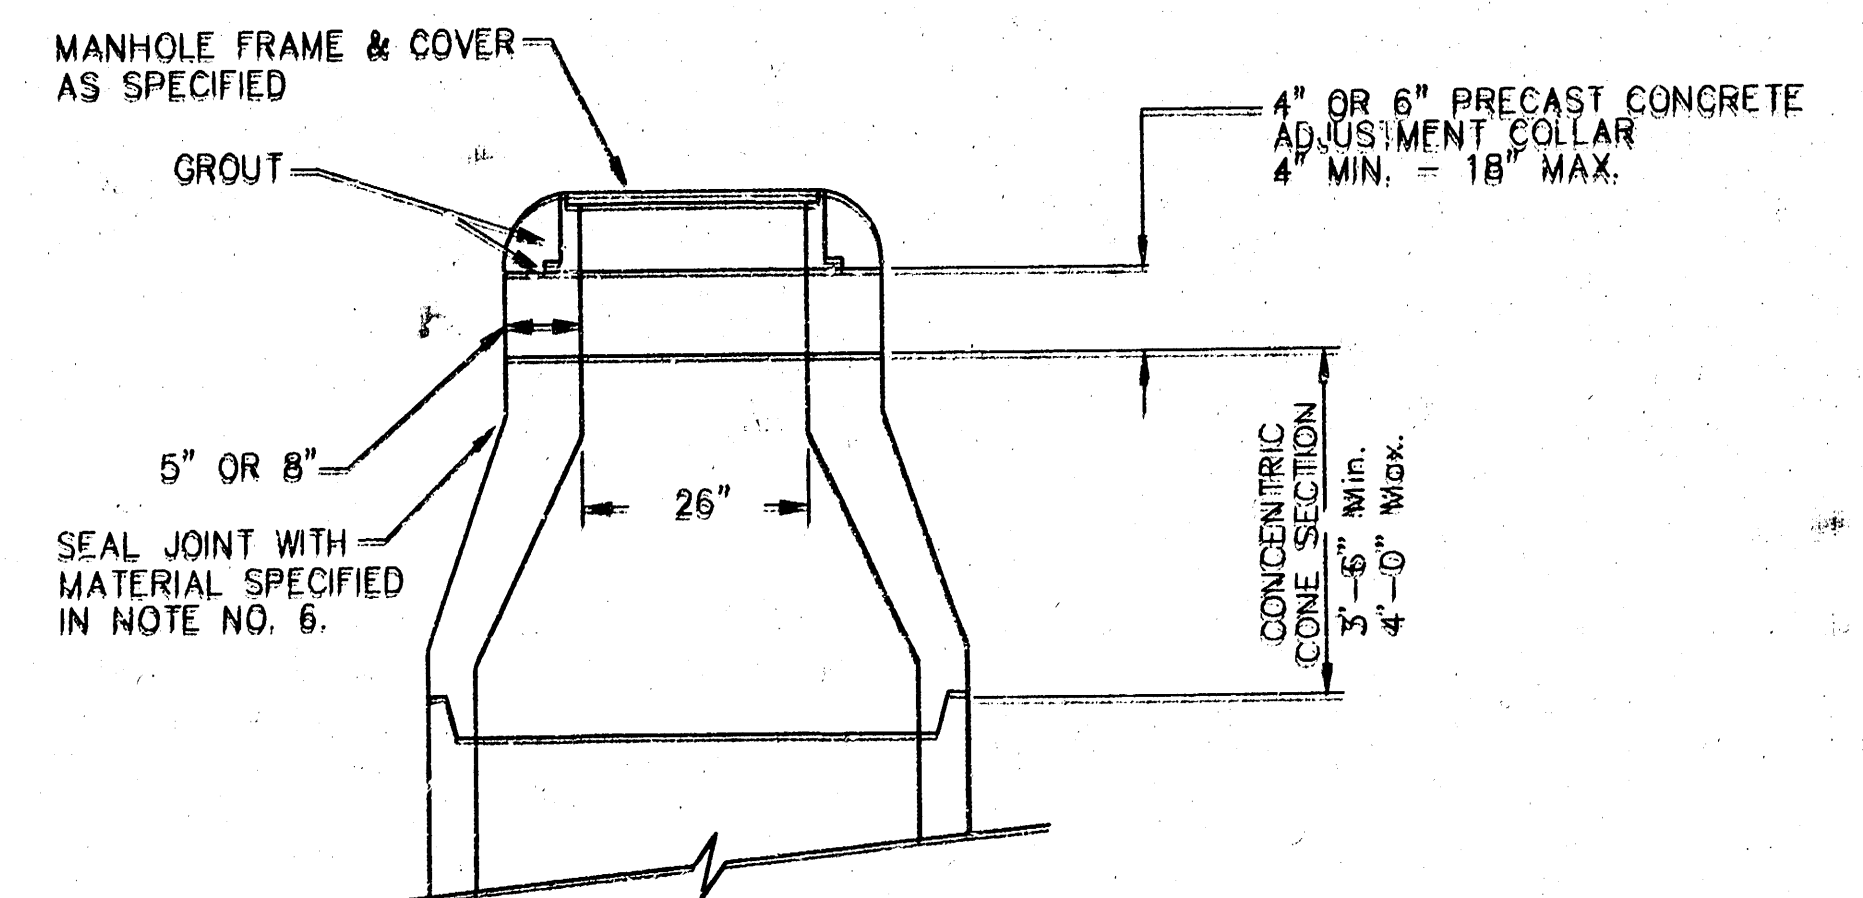


CITY OF WICHITA			
STD. MANHOLE DETAILS			
SEWER APPURTENANCES			
BAUGHMAN COMPANY P.A.			
ENGINEERING, SURVEYING, & PLANNING			
316-262-7271 • 316-2115 • WICHITA, KANSAS 67211			
PROJECT NUMBER		SHEET	
931 PPS (507861)		3	
DESIGN	DRAWN	APPROVED	DATE
STAFF	STAFF	STAFF	09/99
SCALE		NONE	
		5	

MANHOLE COVER
Weight = 180 Lbs.


MANHOLE FRAME AND COVER DETAIL

ADOPTED AS STANDARD DESIGN BY
CITY OF WICHITA, KANSAS

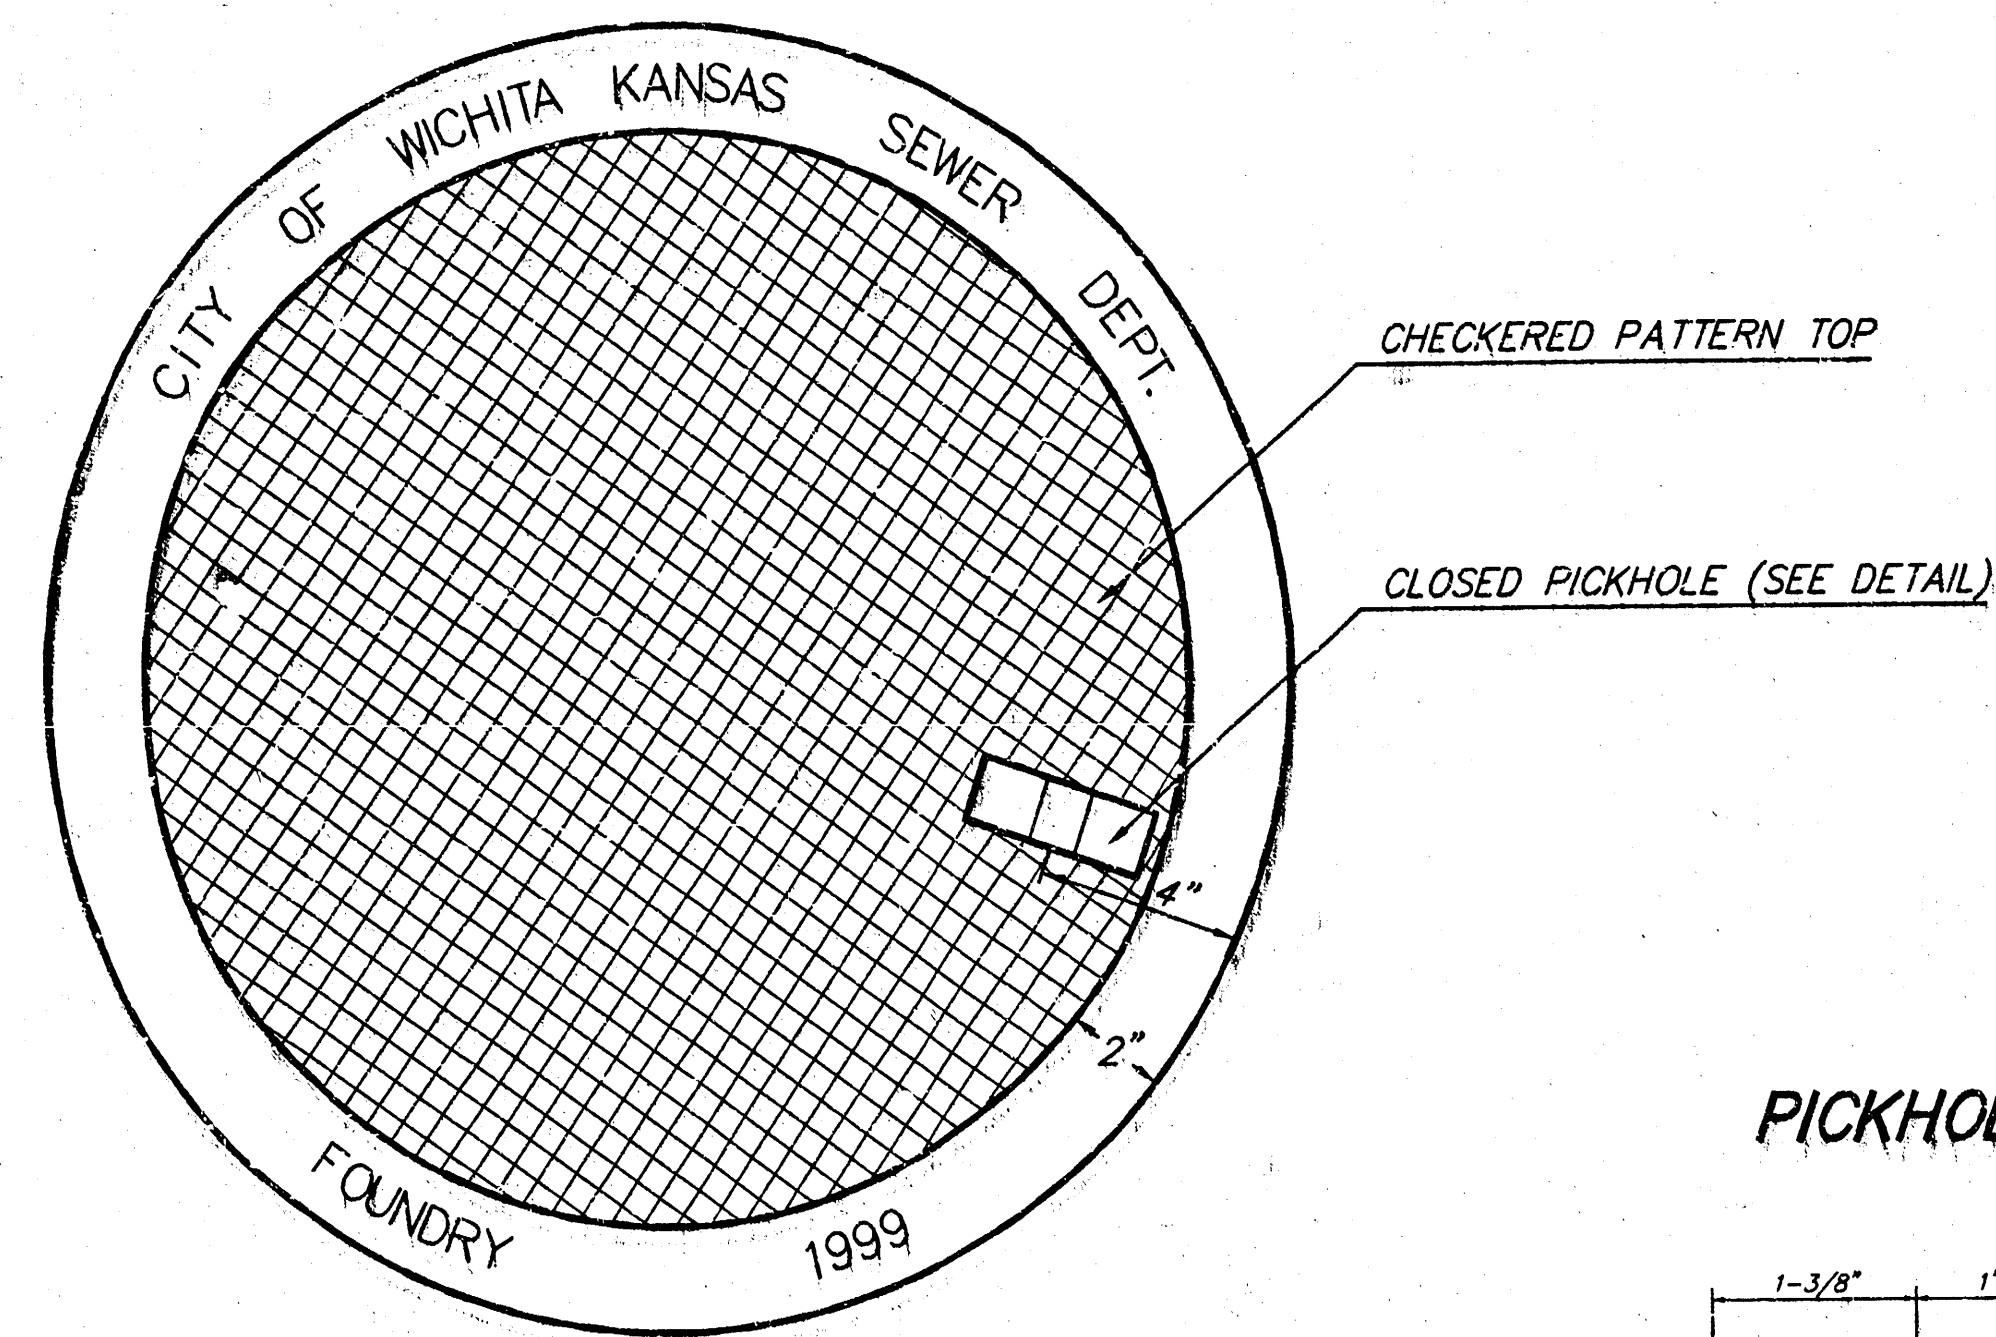


TOP VIEW


PICKHOLE DETAIL

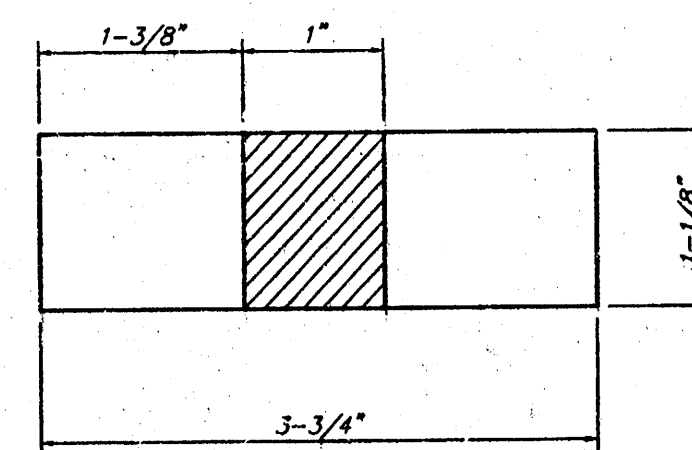


TOP VIEW

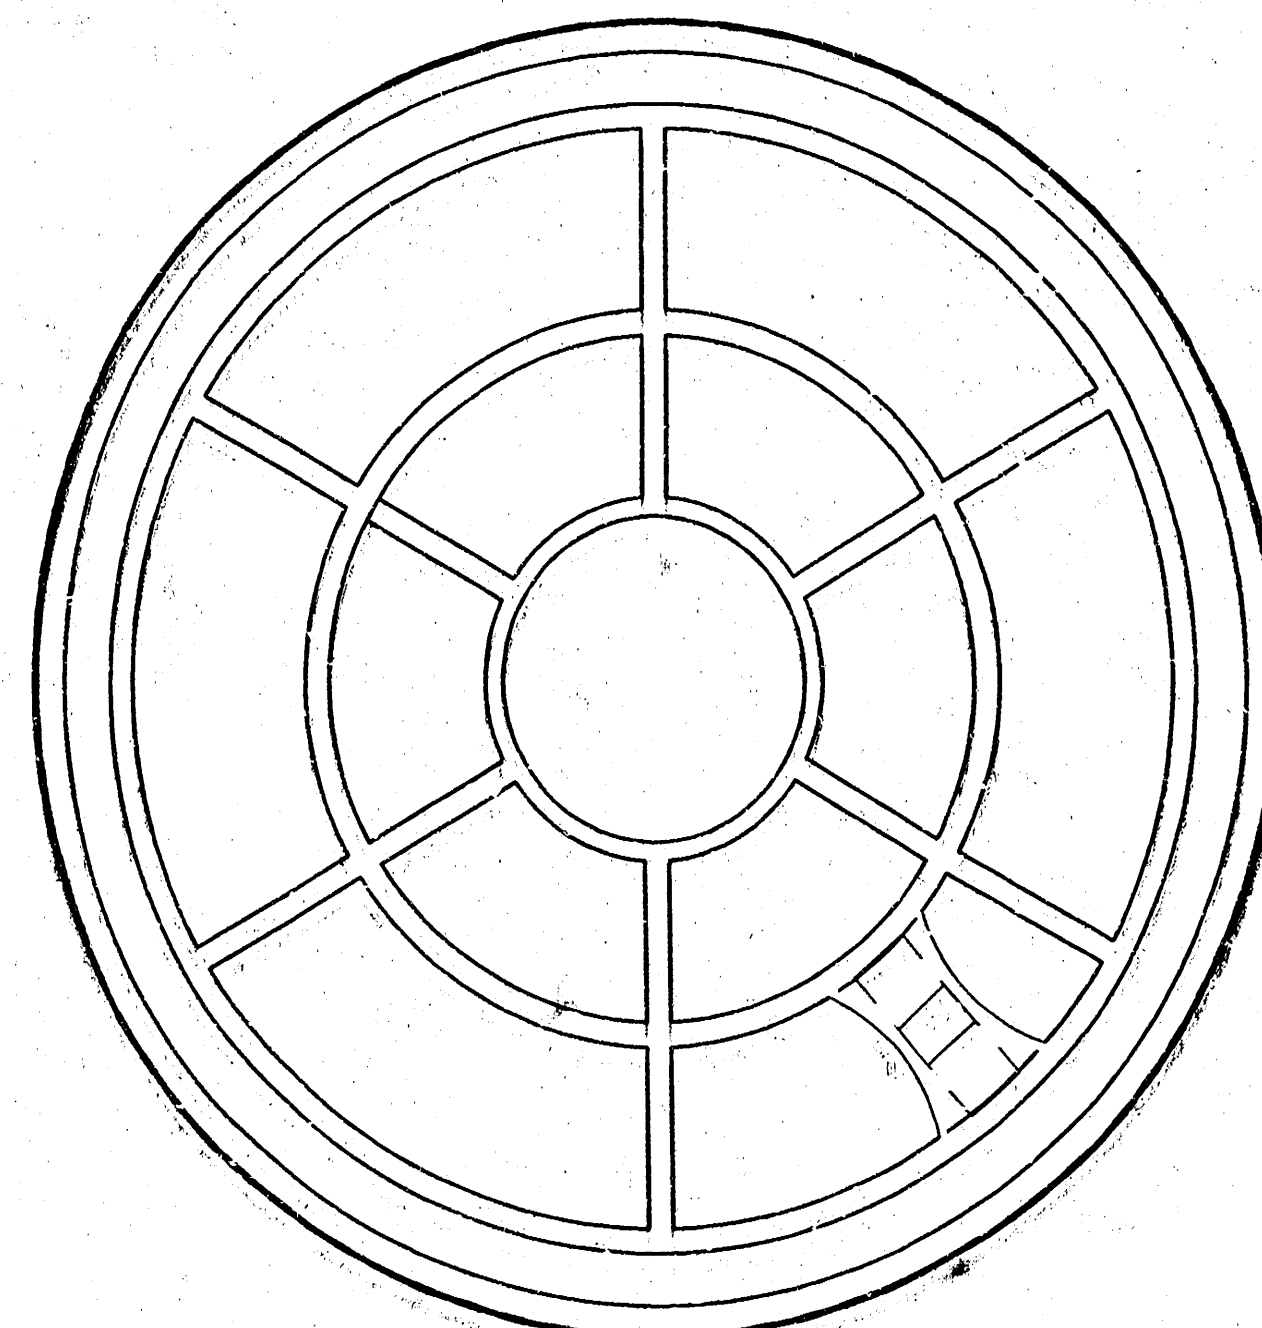

BOTTOM VIEW

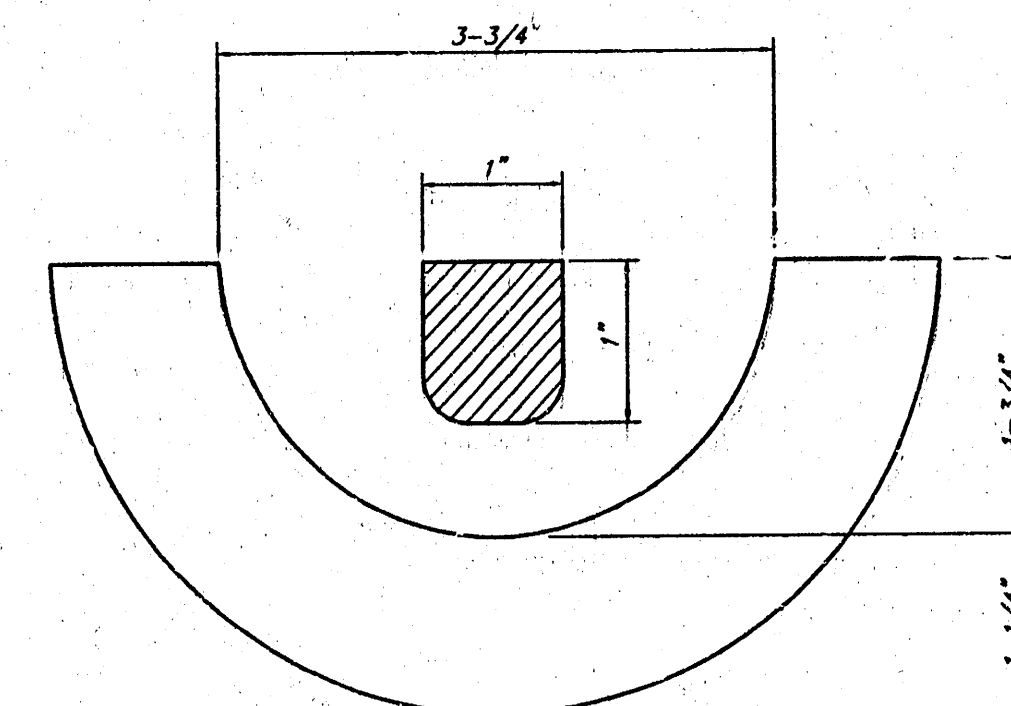


SECTION VIEW

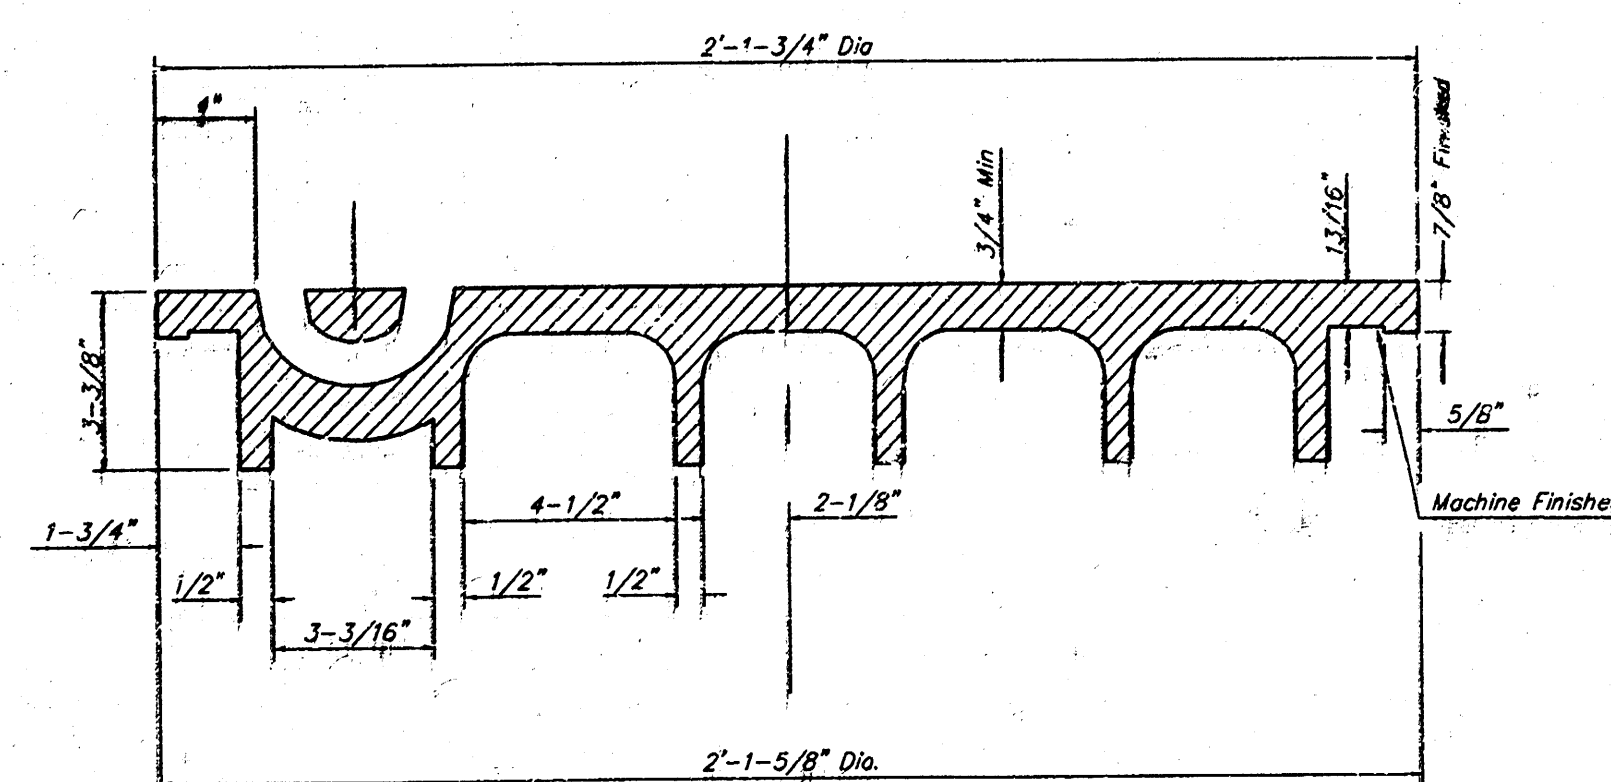


SECTION VIEW

MANHOLE FRAME
Weight = 145 Lbs.

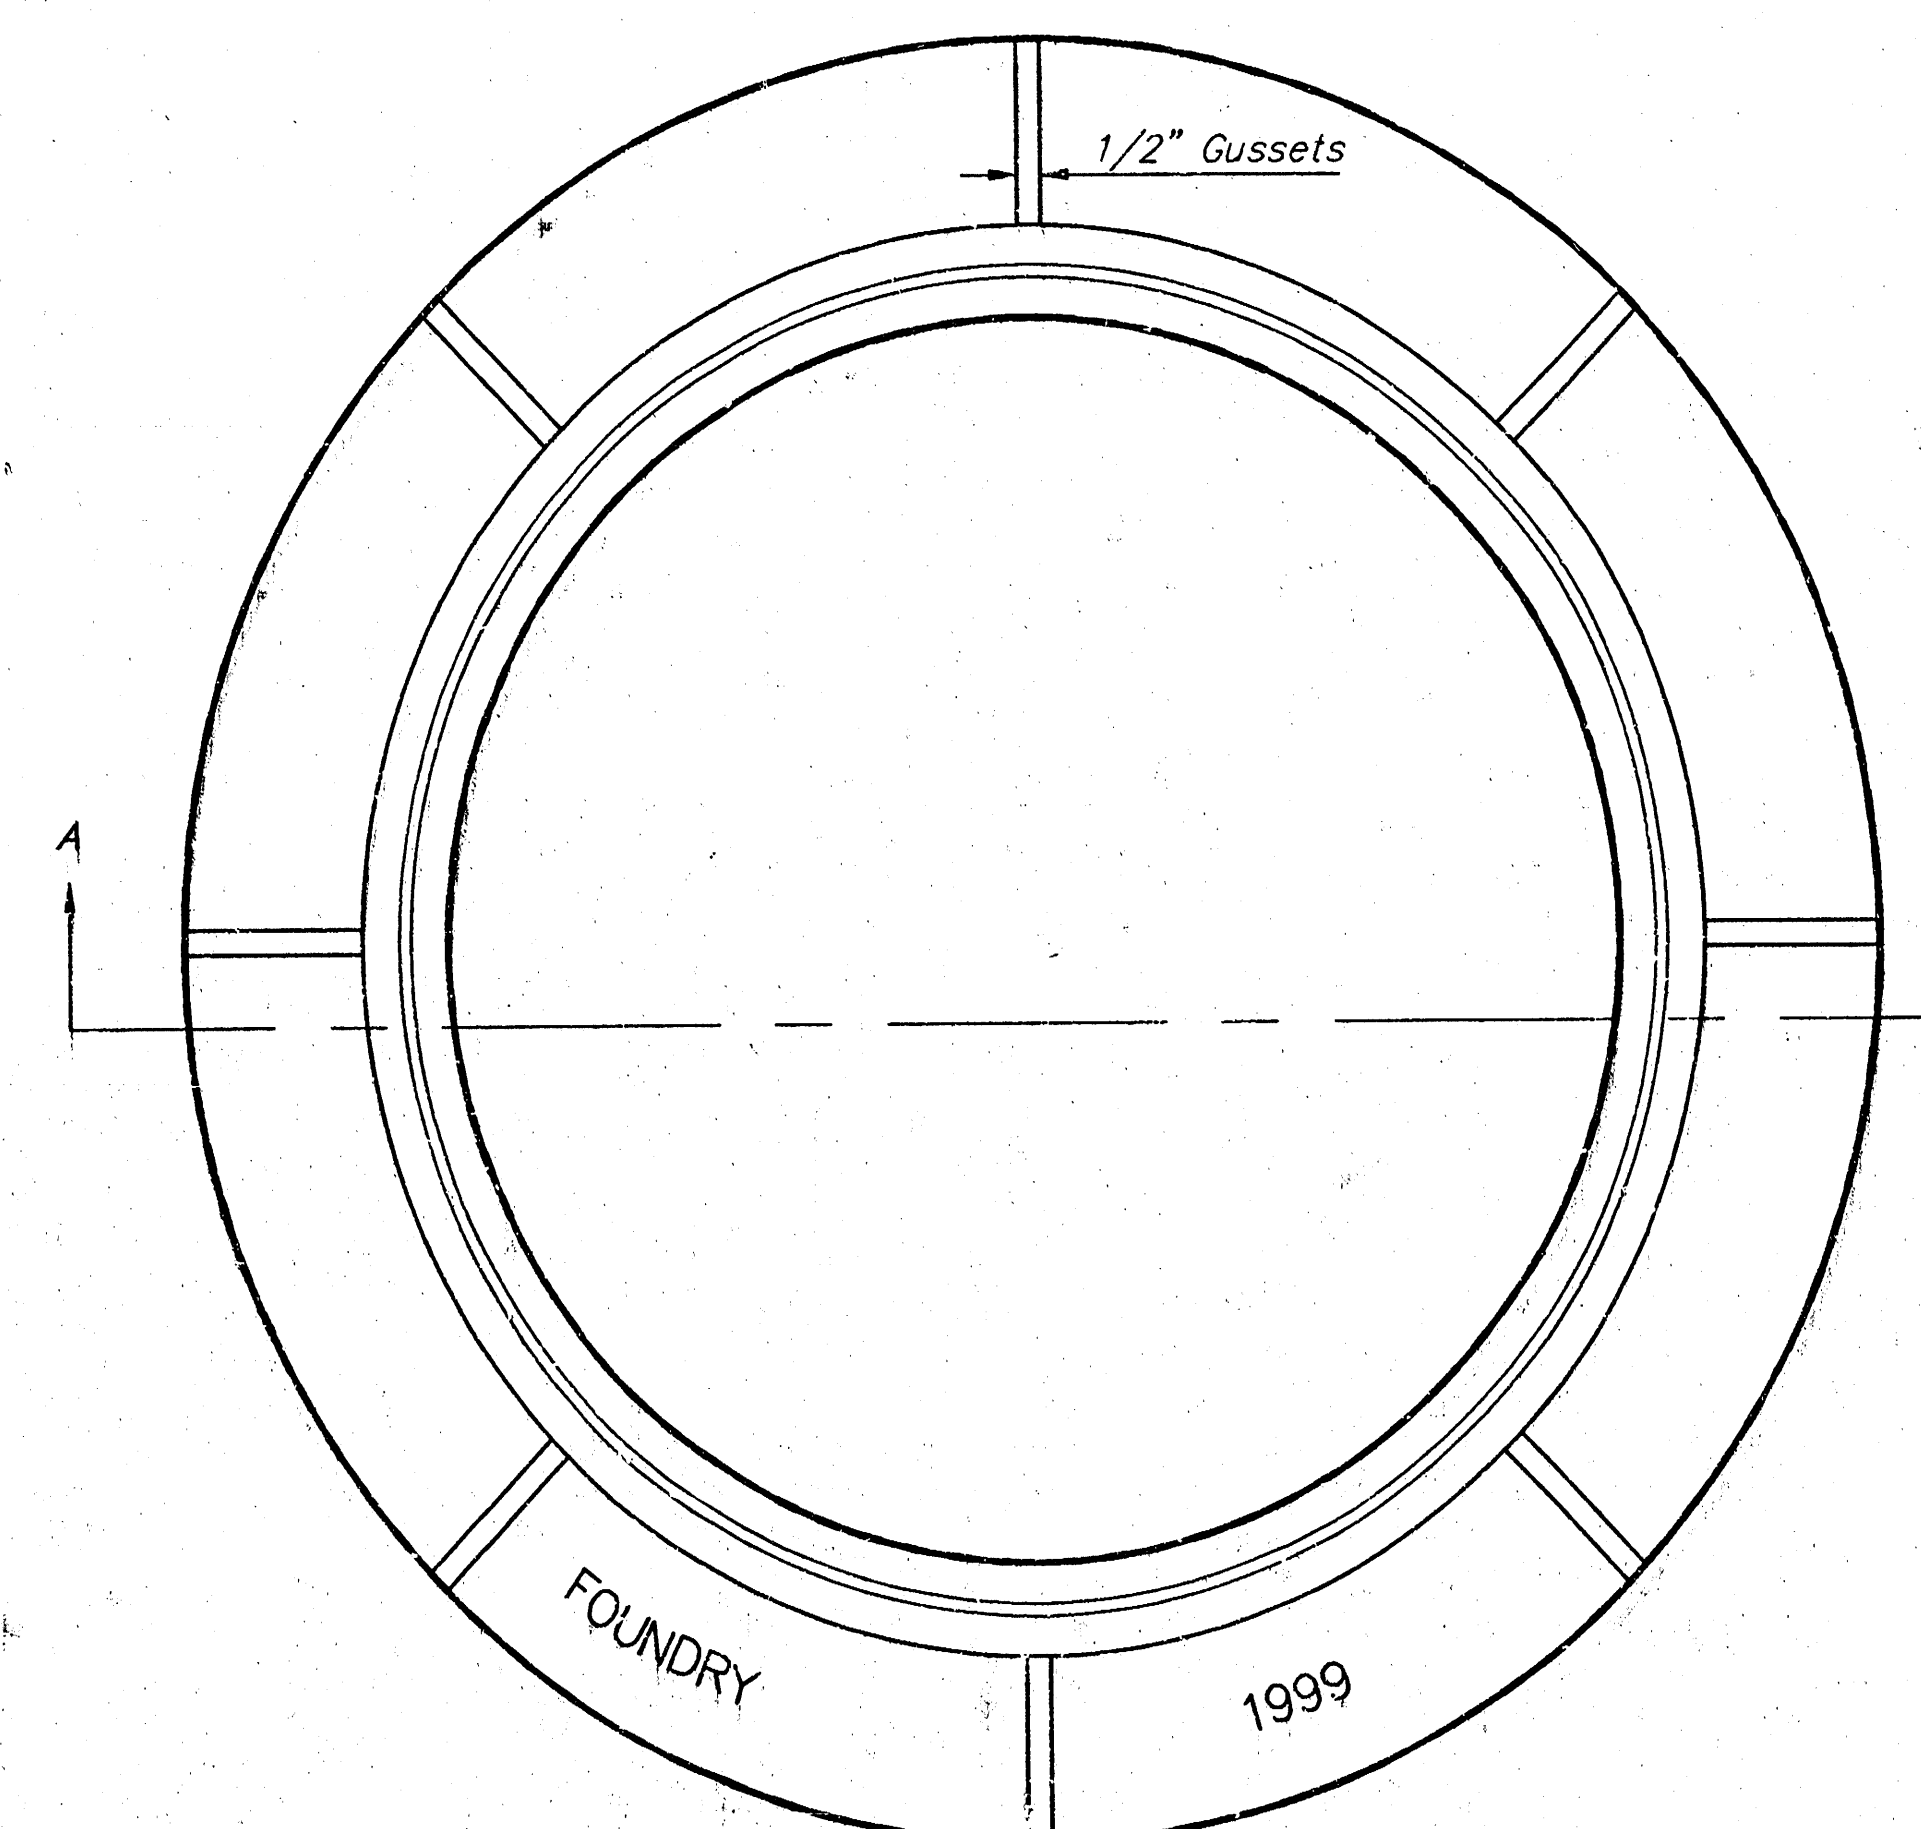

TOP VIEW

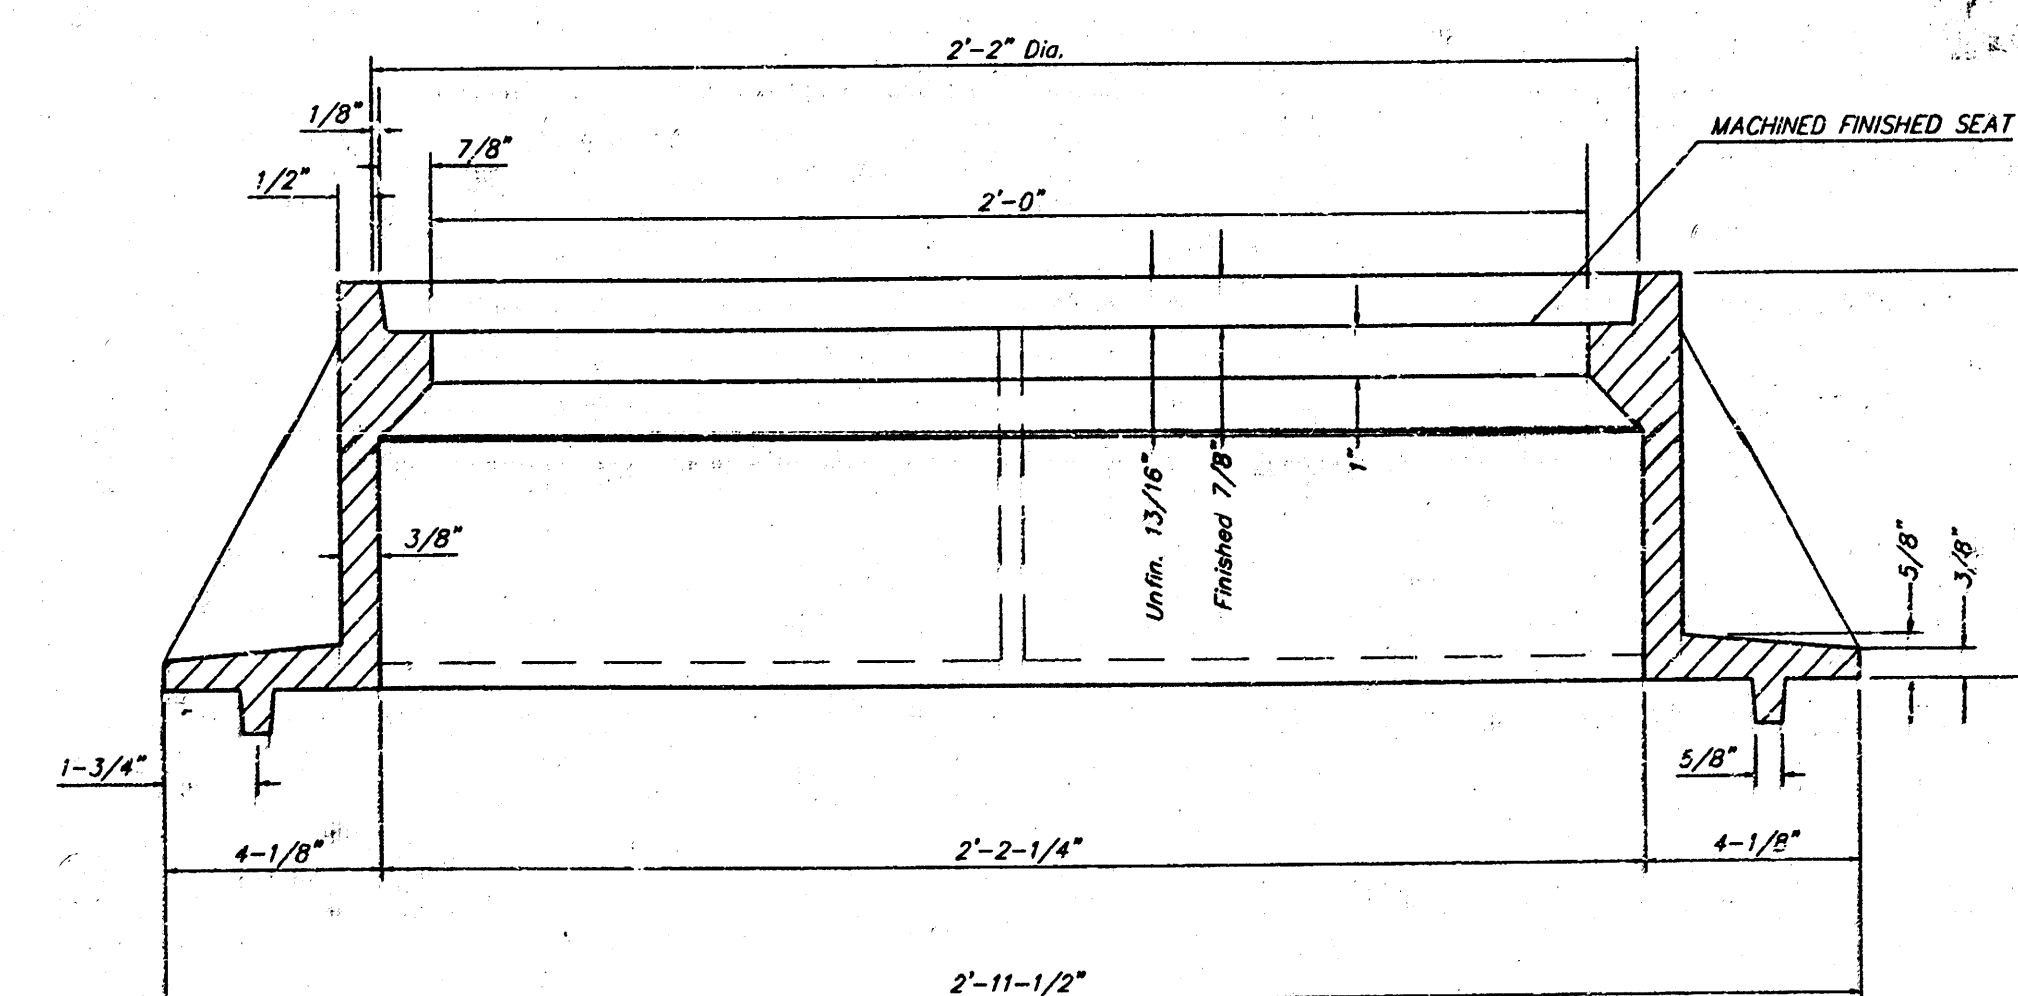

SECTION A-A

GENERAL NOTES

MANHOLE CASTINGS SHALL BE MANUFACTURED USING GOOD QUALITY GRAY IRON CONFORMING TO CLASS 150, A.T.M. DESIGN. DIMENSIONS AND WEIGHTS SHOWN ON THE DETAILED DRAWINGS SHALL BE CONSIDERED AS MINIMUM REQUIREMENTS AND ANY DEVIATIONS FROM THE DIMENSIONS SHOWN MUST BE SPECIFICALLY APPROVED. THE FINISHED CASTINGS SHALL BE OF UNIFORM QUALITY, FREE FROM BLOWHOLES, POROSITY, HARD SPOTS, SHRINKAGE DISTORTIONS OR OTHER DEFECTS.

MANHOLE CASTINGS SHALL BE COATED WITH AN ASPHALT PAINT RESULTING IN A SMOOTH, TOUGH AND TENACIOUS COATING WHICH IS NOT BRITTLE OR TACKY.

MANHOLE CASTINGS SHALL BE MANUFACTURED SUCH THAT A COVER MANUFACTURED BY ANY ONE FOUNDRY WILL FIT INTERCHANGEABLY INTO A FRAME MANUFACTURED BY ANOTHER FOUNDRY AND STILL MEET ALLOWABLE CLEARANCES AND NON-ROCKING REQUIREMENTS. THIS WILL REQUIRE MANUFACTURING OF THE MATCHING FACES ON THE COVER AND THE FRAME TO CLOSE TOLERANCES.


THE OUTSIDE CIRCUMFERENCE OF THE VERTICAL FACE OF THE COVER AND THE INSIDE CIRCUMFERENCE OF THE VERTICAL FACE OF THE FRAME RESPECTIVELY SHALL BE MANUFACTURED TO TOLERANCES SUCH THAT THE CLEARANCE BETWEEN THE COVEK AND FRAME WILL NOT EXCEED 1/8" AT ANY POINT AROUND THE CIRCUMFERENCE OF THE COVER. THE SEATING SURFACES BETWEEN THE COVER AND FRAME SHALL BE MACHINED SUCH AS THESE SURFACES SHALL MAKE FULL CONTACT FOR THEIR FULL CIRCUMFERENCE TO PRECLUDE THE COVER FROM ROCKING IN THE FRAME.

THE MANHOLE FRAME AND COVER SHALL BE MARKED WITH LETTERING INDICATING THE NAME OF THE MANUFACTURER AND THE YEAR WHEN THE COVER OR FRAME WAS CAST. THE COVER SHALL BE FURTHER IDENTIFIED WITH REGARDS TO OWNERSHIP USING LETTERS AT LEAST 1 INCH IN HEIGHT. THIS IDENTIFICATION SHALL BE "CITY OF MOHITA SEWER DEPARTMENT". THE WORD DEPARTMENT MAY BE ABBREVIATED. THE TEXTURE OF THE TOP SURFACE OF THE COVER SHALL BE MANUFACTURED IN A CHECKERED PATTERN DESIGN AS INDICATED ON THE DRAWINGS. BLOCKOUTS SHALL BE UTILIZED TO HIGHLIGHT THE LETTERING. THE TOTAL AREA OF SMOOTH SURFACE BLOCKOUT SHALL NOT EXCEED THE AREA AS INDICATED ON THE DRAWINGS. POSITIONING OF SMOOTH BLOCKOUTS AND LETTERING MAY VARY FROM THAT SHOWN ON THE DETAILED DRAWING.

MANHOLE FRAME AND COVER DETAIL					
ADOPTED AS STANDARD DESIGN BY CITY OF WICHITA, KANSAS					
 BAUGHMAN COMPANY P.A. ENGINEERING, SURVEYING, & PLANNING 316-262-7271 P.O. BOX 100 WICHITA, KANSAS 67211					
PROJECT NUMBER					
931 FPS (607861)					
DESIGN	DRAWN	APPROVED	DATE	SCALE	SHEET
1/2" = 1' (ACT)			09/99	1/4" = 1' (N/A)	4 of 5






RIDGE PORT NORTH ADDITION

WICHITA, SEDGWICK COUNTY, KANSAS

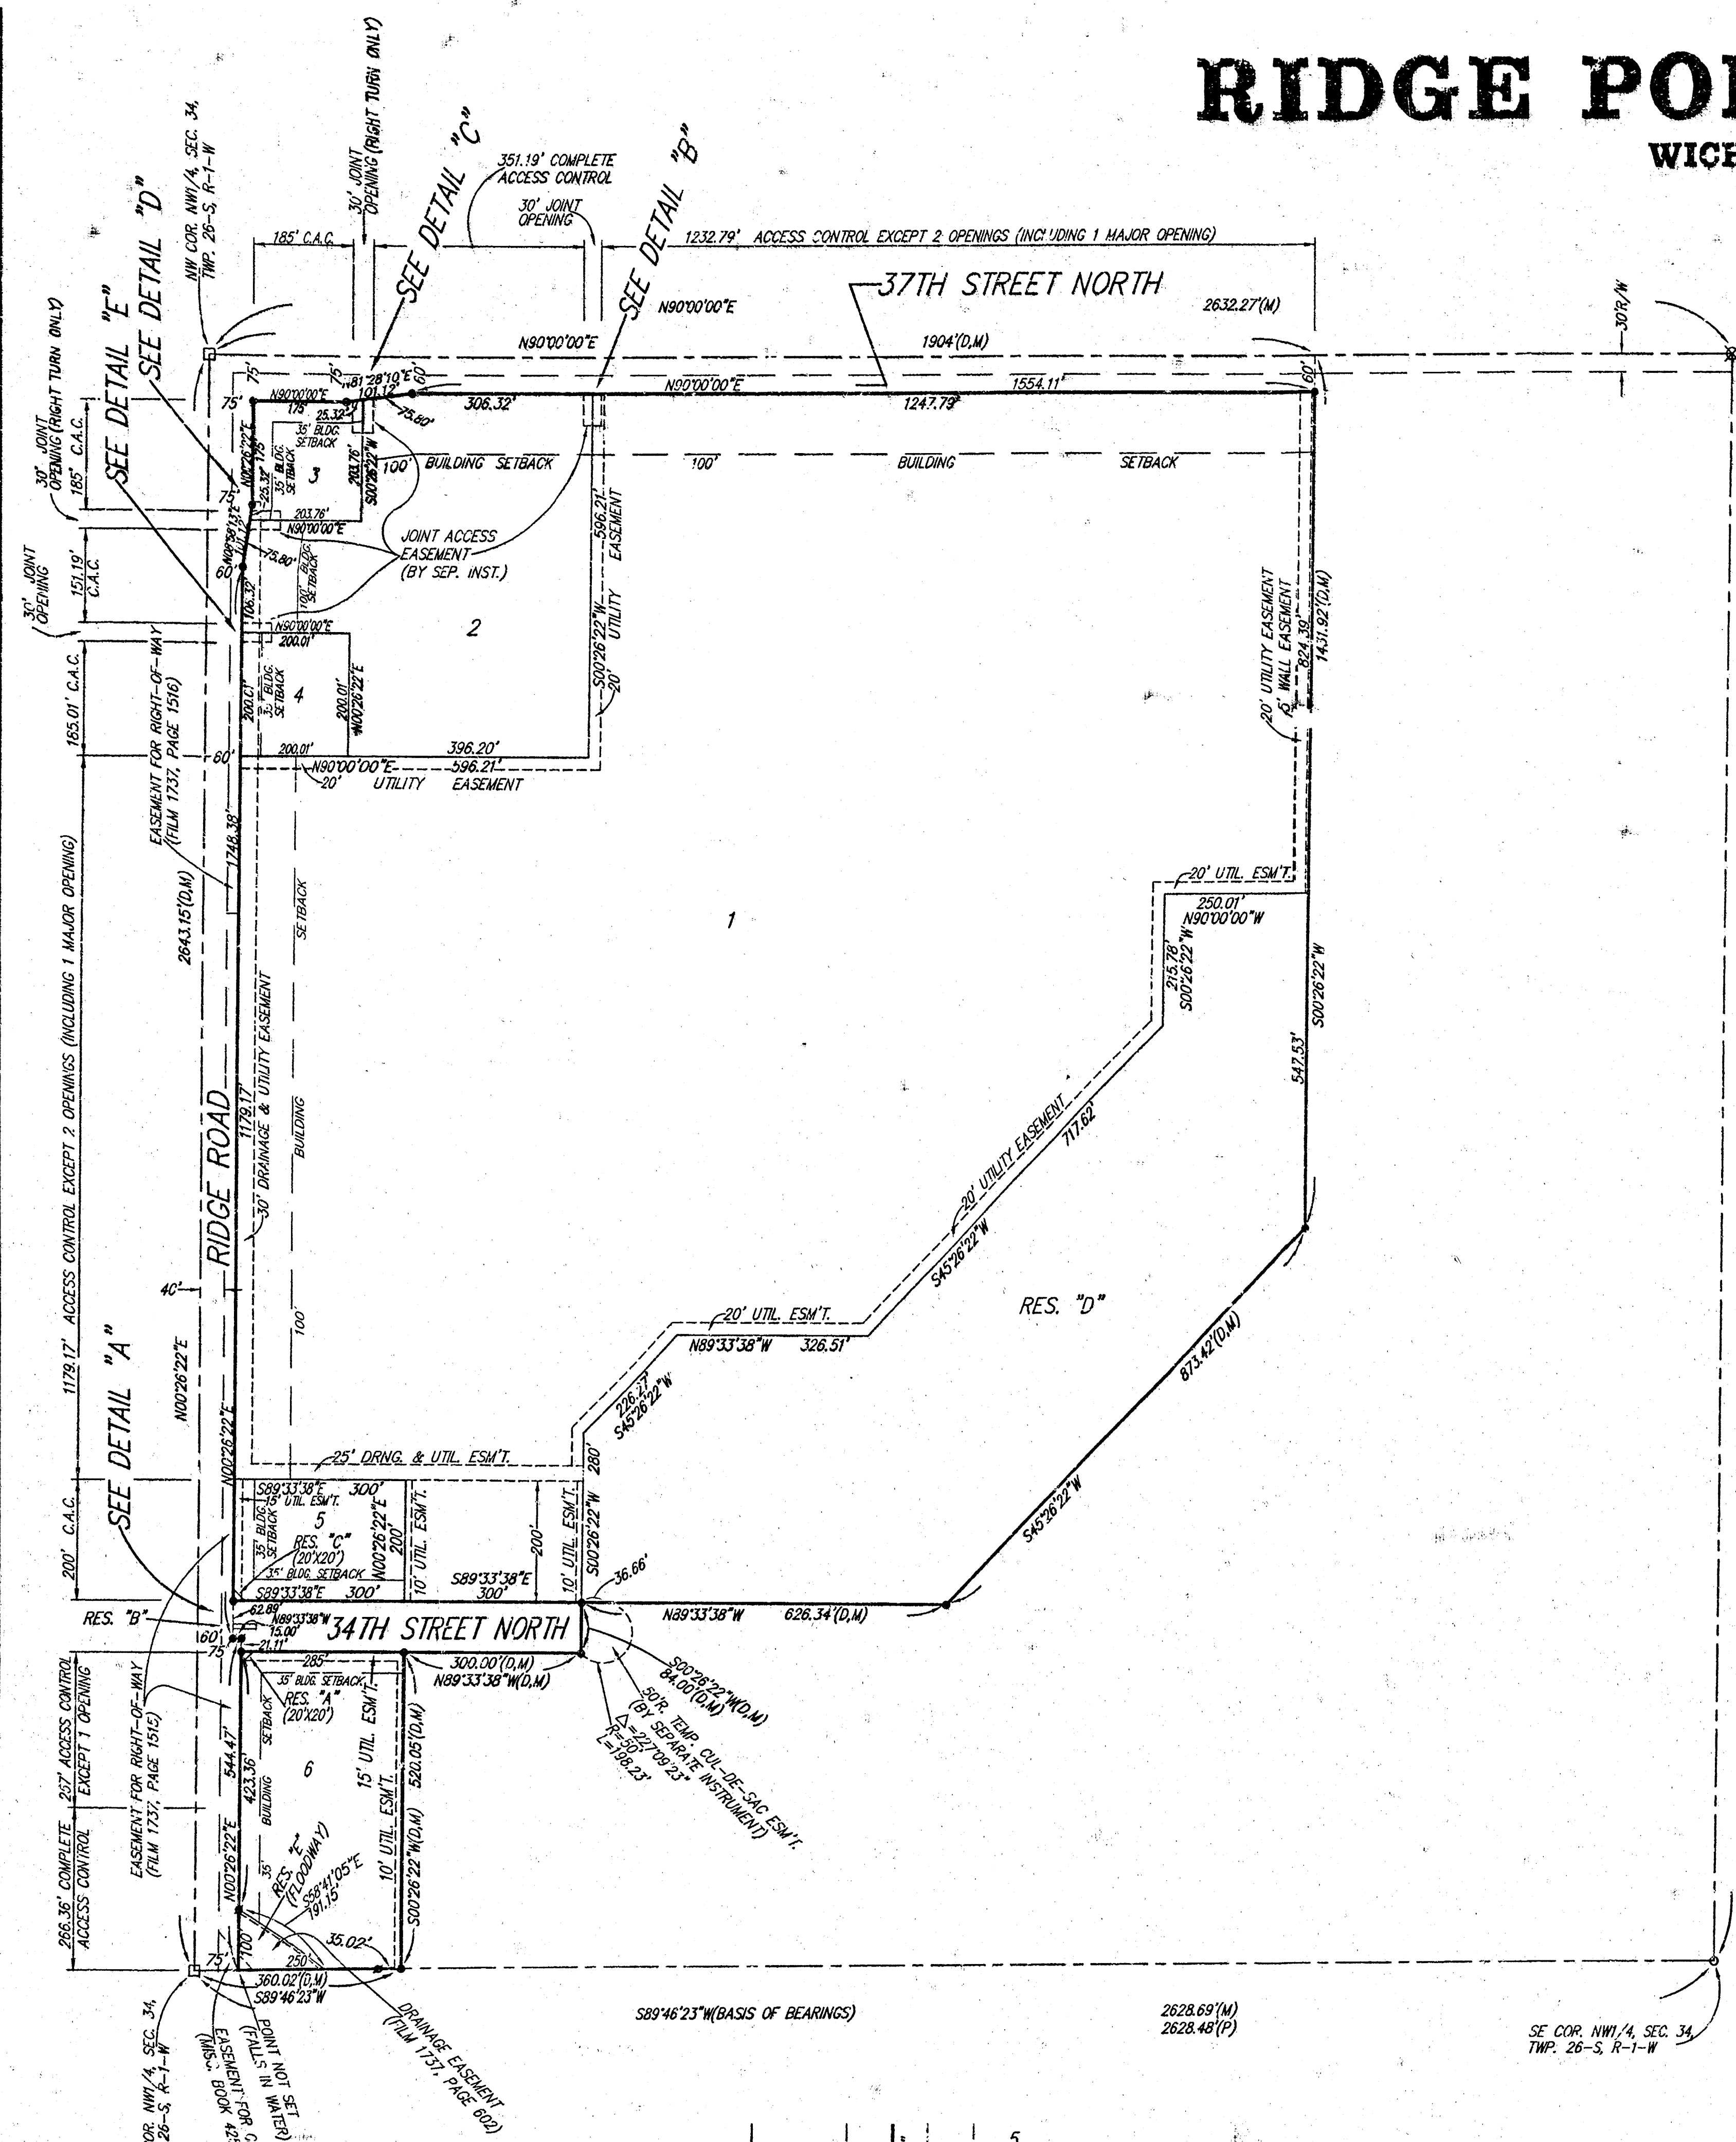

- (M) = MEASURED
 - (D) = DEPICTED
 - (P) = PLATTED
- = 1/4" REBAR W/ "BAUGHMAN" CAP (FOUND)
 - = 1/4" REBAR W/ "BAUGHMAN" CAP (SET)
 - = 3/8" IRON (FOUND)
 - = 3/8" IRON (SET)
 - = RAILROAD SPOKE (FOUND)
 - = RAILROAD SPOKE (SET)
 - ⊗ = NAIL IN 1/2" IRON (FOUND)

NOTE: ADDITIONAL BUILDING SETBACK REQUIREMENTS PER COMMUNITY UNIT PLAN DP-237.

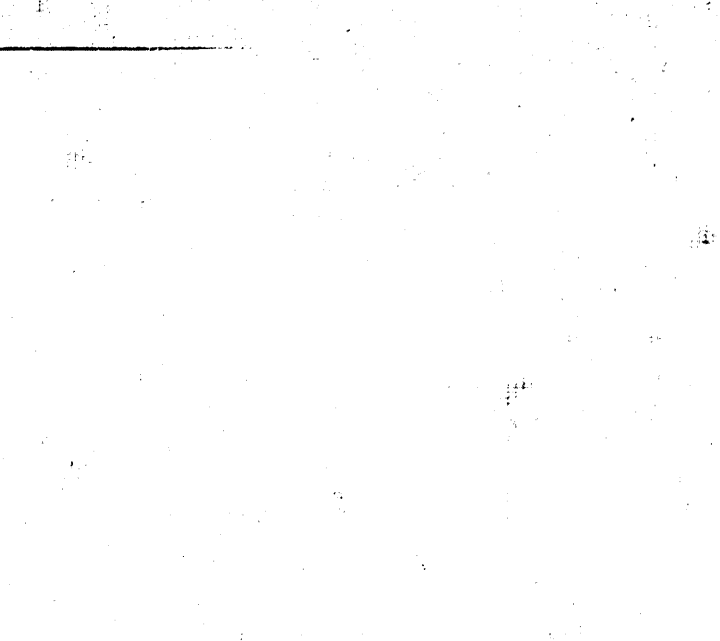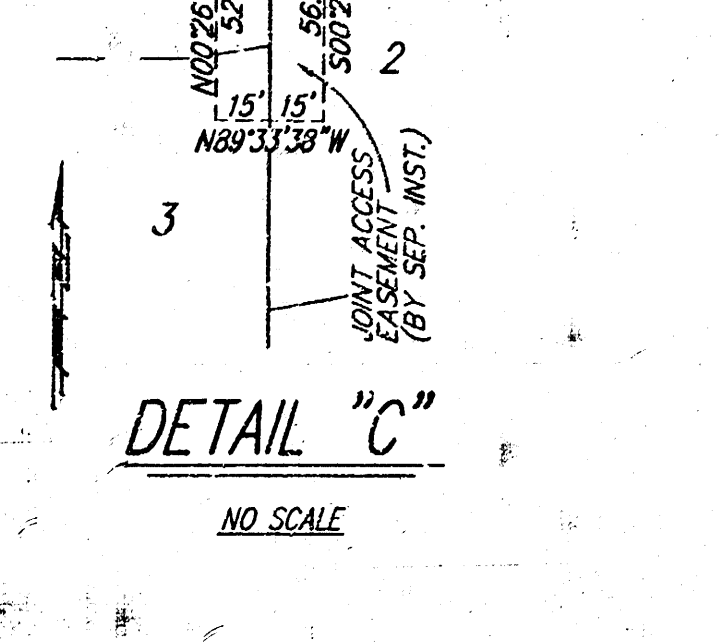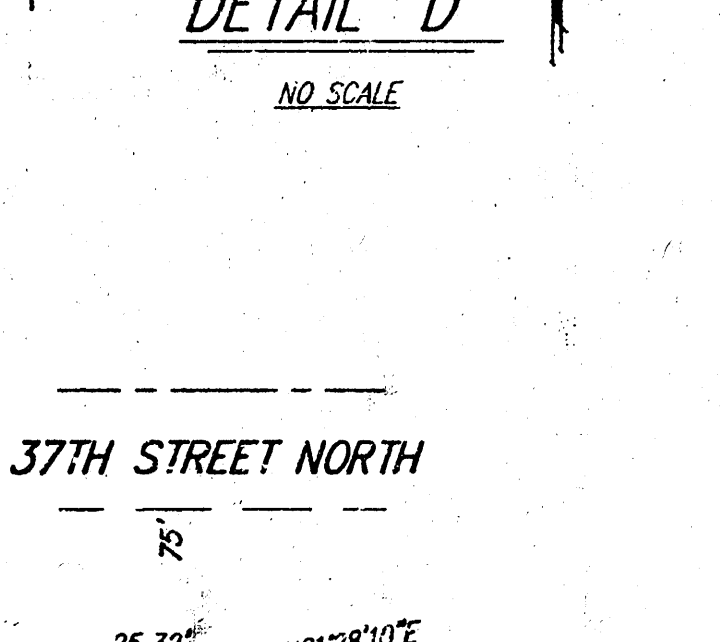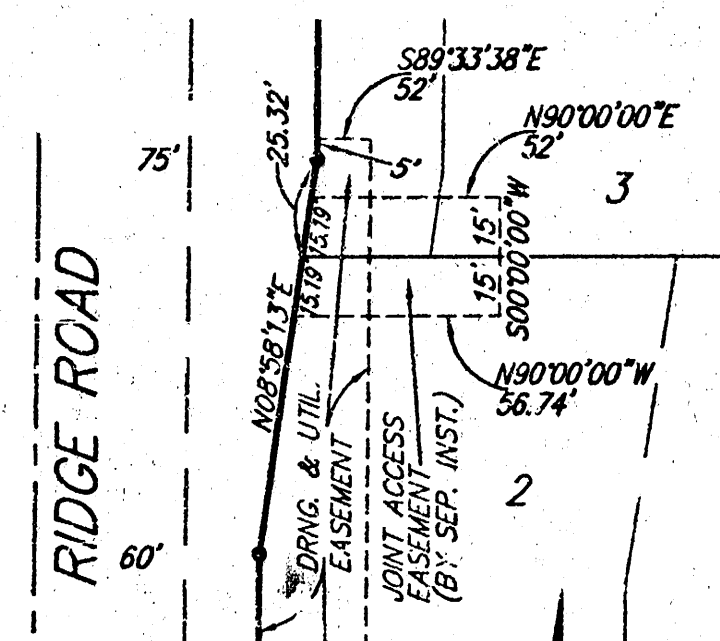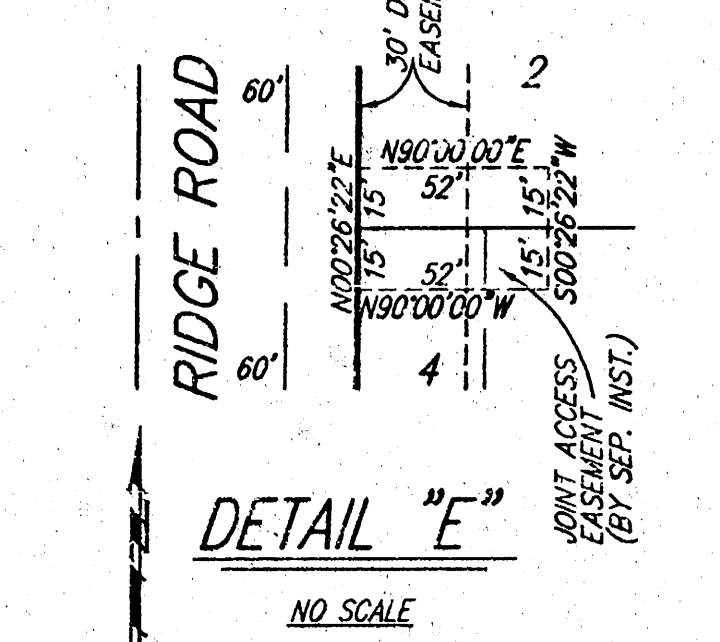

BLOCK	LOT	ELEVATION (CITY DATUM)
1	1	144.6
1	2, 3, 4	144.6
1	5	142.8
1	6	142.6

BENCHMARK: CITY DISC - SW COR. RIDGE RD. & 29TH ST. NO. 80.8' S. & 63.7' W. OF E. BOTT. ELEV. = 139.15 CITY DATUM (1328.55 M.S.L.)

NOTE: NO BUILDING PERMITS ARE TO BE ISSUED FOR ANY LOTS WITHIN "RIDGE PORT NORTH ADDITION" UNLESS THE LOWEST FLOOR CAN BE CONSTRUCTED AT OR ABOVE THE BASE FLOOD ELEVATION OR UNLESS THE CITY OF WICHITA HAS REVIEWED A LETTER OF MAP REVISION FROM THE FEDERAL EMERGENCY MANAGEMENT AGENCY WHICH WILL THEN ALLOW BUILDINGS TO BE CONSTRUCTED AT THE LOWEST OPENING AS SPECIFIED ABOVE.

State of Kansas) SS
Sedgwick County) We, Baughman Company, P.A. Surveyors in aforesaid County and State do hereby certify that we have surveyed and platted "RIDGE PORT NORTH ADDITION", Wichita, Sedgwick County, Kansas and that the accompanying plat is a true and correct exhibit of the property surveyed, described as follows: A tract of land in the NW 1/4 of Sec. 34, Twp. 26-S R-1-W of the 6th P.M., Sedgwick County, Kansas, described as follows: Beginning at the NW corner of said NW 1/4; thence N90°00'00"E along the north line of said NW 1/4, 1904.00 feet; thence S00°26'22"W parallel with the west line of said NW 1/4, 1431.92 feet; thence S45°26'22"W, 873.42 feet; thence N89°33'38"W, 626.34 feet to a point 660 feet normally distant east of the west line of said NW 1/4; thence S00°26'22"W parallel with the west line of said NW 1/4, 84.00 feet; thence N89°33'38"W, 300.00 feet; thence S00°26'22"W parallel with the west line of said NW 1/4, 520.05 feet to a point on the south line of said NW 1/4; thence S89°46'23"W along the south line of said NW 1/4, 360.02 feet to the SW corner of said NW 1/4; thence N00°26'22"E along the west line of said NW 1/4, 2643.15 feet to the point of beginning, all being subject to road rights-of-way of record.

Existing public easements and dedications being vacated by virtue of K.S.A. 12-512(b).

Michael G. Conrey, Surveyor
LS-974
KANSAS
Michael G. Conrey

Know all men by these presents that we, the undersigned, have caused the land in the surveyors certificate to be platted into Lots, Streets, and Reserves to be known as "RIDGE PORT NORTH ADDITION", Wichita, Sedgwick County, Kansas. The utility easements are hereby granted as indicated for the construction and maintenance of all public utilities. The drainage and utility easements are hereby granted as indicated for drainage purposes and for the construction and maintenance of all public utilities. The wall easement is hereby granted as indicated for the construction and maintenance of a private screening wall and utility main lines and service lines shall be allowed to cross this easement. The streets are hereby dedicated to and for the use of the public. Reserves "A" and "C" are hereby reserved for landscaping, entry monuments, utilities, screening walls, and open space. Reserve "B" is hereby reserved for landscaping, open space, utilities, entry monuments, and streets. Reserve "D" is hereby reserved for drainage purposes, ponds, landscaping, open space, berms, gazebos, screening walls, and sidewalks. Reserve "E" is hereby reserved for floodway, drainage purposes, and open space, and no buildings shall be constructed or placed on or within said Reserve "E", nor shall any fill, change of grade, creation of channel, or any other work be carried on without the permission of the appropriate governing body. Reserves "A", "B", "C", "D", and "E" shall be owned and maintained by the lot owners association for the addition. All abutters rights of access to or from Ridge Road and to or from 37th Street North shall be as indicated on the face of the plat. The Minimum Building Pad Elevations for the lowest opening to the structures shall be as indicated on the face of the plat.

Ken-Win Farms, Inc.
Bruce K. Ott, President
R & R Realty, LLC
Joy W. Russell, Manager
Kevin M. Mullen, Manager
Via Christi Property Services, Inc.
David M. Mohr, President

State of Kansas) SS
Sedgwick County) The foregoing instrument acknowledged before me, this 31st day of March, 1999, by Bruce K. Ott, President of Ken-Win Farms, Inc., on behalf of the corporation.

My App'l. Exp. 5-1-2001
Diana L. Bower, Notary Public
Diana L. Bower
Notary Public - State of Kansas
My App'l. Exp. 5-1-2001

State of Kansas) SS
Sedgwick County) The foregoing instrument acknowledged before me, this 31st day of March, 1999, by day W. Russell, Manager of R & R Realty, LLC, on behalf of the company.

My App'l. Exp. 5-1-2001
Judith M. Terhune, Notary Public
Judith M. Terhune
Notary Public - State of Kansas
My App'l. Exp. 5-1-2001

This plat of "RIDGE PORT NORTH ADDITION", Wichita, Sedgwick County, Kansas has been submitted to and approved by the Wichita-Sedgwick County Metropolitan Area Planning Commission, Wichita, Kansas.
Dated this 14th day of January, 1999
Wichita-Sedgwick County Metropolitan Area Planning Commission

William M. Johnson, Chairman
Marvin S. Krout, Secretary

This plat approved and all dedications shown hereon accepted by the City Council of the City of Wichita, Kansas, this 25th day of May, 1999.

Bob Knight, Mayor
Pat Burnett, City Clerk

Entered on transfer record this 7th day of June, 1999.
James Alford, County Clerk

State of Kansas) SS
Sedgwick County) This is to certify that this plat has been filed for record in the office of the Register of Deeds, this 9th day of June, 1999, at 1:50 o'clock A.M. and is duly recorded.

Bill Meek, Register of Deeds
Linda Kizile, Deputy

We the undersigned, holders of a mortgage on the above described property, do hereby consent to this plat of "RIDGE PORT NORTH ADDITION", Wichita, Sedgwick County, Kansas.

Intrust Bank, N.A.
GARY D. SCHMITT, V.P. (Title)

State of Kansas) SS
Sedgwick County) The foregoing instrument acknowledged before me, this 3rd day of April, 1999, by GARY D. SCHMITT, SENIOR VICE-PRESIDENT of the Intrust Bank, N.A., on behalf of the bank.

My App'l. Exp. 8-27-2001
Rhonda M. von Mosch, Notary Public
Rhonda M. von Mosch
Notary Public - State of Kansas
My App'l. Expires 8-27-2001

State of Kansas) SS
Sedgwick County) The foregoing instrument acknowledged before me, this 31st day of March, 1999, by Kevin M. Mullen, Manager of R & R Realty, LLC, on behalf of the company.

My App'l. Exp. 11-7-2001
Judith M. Terhune, Notary Public
Judith M. Terhune
Notary Public - State of Kansas
My App'l. Expires 11-7-2001

State of Kansas) SS
Sedgwick County) The foregoing instrument acknowledged before me, this 31st day of March, 1999, by David M. Mohr, President of Via Christi Property Services, Inc., on behalf of the corporation.

My App'l. Exp. 5-1-2001
Diana L. Bower, Notary Public
Diana L. Bower
Notary Public - State of Kansas
My App'l. Exp. 5-1-2001

10 10 04 08
BAUGHMAN COMPANY P.A.
ENGINEERING, SURVEYING & PLANNING
316-282-7271 • 315 ELLIS • WICHITA, KANSAS 67201
F:\PLAT\GOWAN\JMG-000