

STATION 0+00 (25' WEST OF E. SENECA)
CONNECT TO EXISTING 8" SANITARY SEWER
STUB WITH LIKE TYPE PIPE

STATION 0+08.8 - CONSTRUCT STANDARD
MANHOLE, TOP ELEVATION = 84.13 84.35

REMOVE AND REPLACE EXIST. CONC. SIDEWALK
ONLY AS NECESSARY FOR CONSTRUCTION.

REMOVE AND REPLACE PRIVACY
FENCE ONLY AS NECESSARY
FOR CONSTRUCTION

STATION 4+50.2 - CONSTRUCT STANDARD
MANHOLE, TOP ELEVATION = 84.70
8" STUB WEST 84.04

INSPECTION AND TESTING FOR THIS PROJECT TO BE PROVIDED
BY A LICENSED CONSULTING ENGINEERING FIRM UNDER CONTRACT
WITH THE OWNER/DEVELOPER. SAID INSPECTION TO BE IN
ACCORDANCE WITH THE CITY OF WICHITA STANDARD CONSTRUCTION
ENGINEERING PRACTICES AND CERTIFIED BY A LICENSED PROFESSIONAL
ENGINEER. NO WORK SHALL BE PERFORMED IN DEDICATED EASEMENTS
OR PUBLIC RIGHT-OF-WAY BY THE CONTRACTOR WITHOUT SUCH
INSPECTIONS, NOR SHALL ANY WORK BE COMMENCED IN DEDICATED
EASEMENTS OR PUBLIC RIGHT-OF-WAY WITHOUT WRITTEN AUTHORIZATION
BY THE CITY ENGINEER.

APPROVED AS NOTED
By CITY ENGINEER OF WICHITA


Sanitary Sewers VRH 11/1/94
Storm Sewers _____
Driveway Approaches _____
Water Mains _____
Paving _____

GENERAL NOTES

- Underground utility service lines and overhead utility pole lines are to be adjusted as necessary by others prior to construction unless the plans specifically call for their adjustment be the Contractor or unless the plans specifically identify a utility to be adjusted by its owner during construction. Existing utilities and their location, as shown on the plat's, represent the best information obtainable for design. Location information has been obtained from the various utility companies and is either from company record drawings or company provided field locations. The Contractor will be required to work around existing utilities within the right-of-way which do not conflict with proposed construction.
- Trees and shrubs in public right-of-way which are in direct conflict with proposed new construction shall be removed by the Contractor with the Engineer's approval. Trees and shrubs which are not in direct conflict with proposed new construction shall be saved and protected from damage.
- The Contractor shall be responsible for preserving property irons. The Contractor will be required to re-establish any property irons which are damaged or destroyed by his construction operations. Such irons shall be re-established by a licensed land surveyor or a licensed professional engineer in accordance with state laws.
- The Contractor shall contact Kansas One Call at 687-2470 to have underground utilities located prior to construction of this project.
- All un-urbed areas to be seeded according to City of Wichita specifications.

Scale: 1" = 20' Plan
1" = 5' Profile (Vert.)
o = Iron

50TH STREET SOUTH

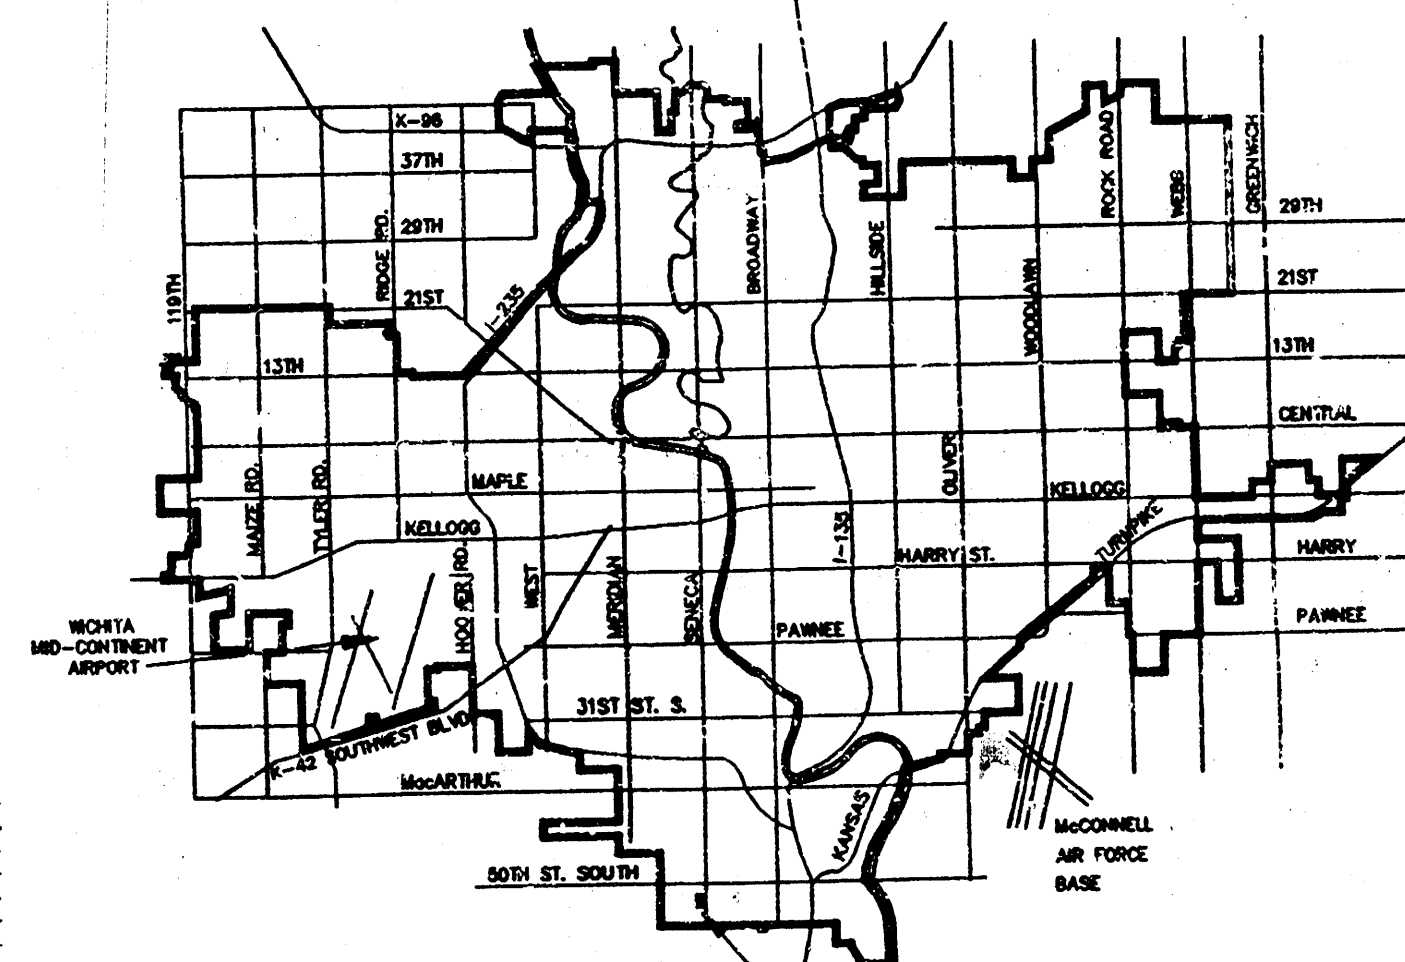

VICINITY MAP

PROJECT LOCATION

AS BUILT
5-11-95

NOTE STATIONING CHANGE
to Allow of 0+00 M.H.

PRIVATE SANITARY SEWER EXTENSION TO
SERVE LOTS 31-34 A. VERNE ROBERTS ADDN.

SRB 924 NORTH MAIN 318-284-8008
WICHITA, KANSAS 67211 FAX 284-4821
SAVOY, RUGGLES & BOHM, P.A.
ENGINEERING & SURVEYING

PROJECT NUMBER
488 PPS - 607861

DRAWN: C. Bohm DESIGN: C. Bohm REVIEW: TCR DATE: 8-9-94 UTILITY: CMB SRB JOB: 146e

REVISED
10-4-94

1

1