


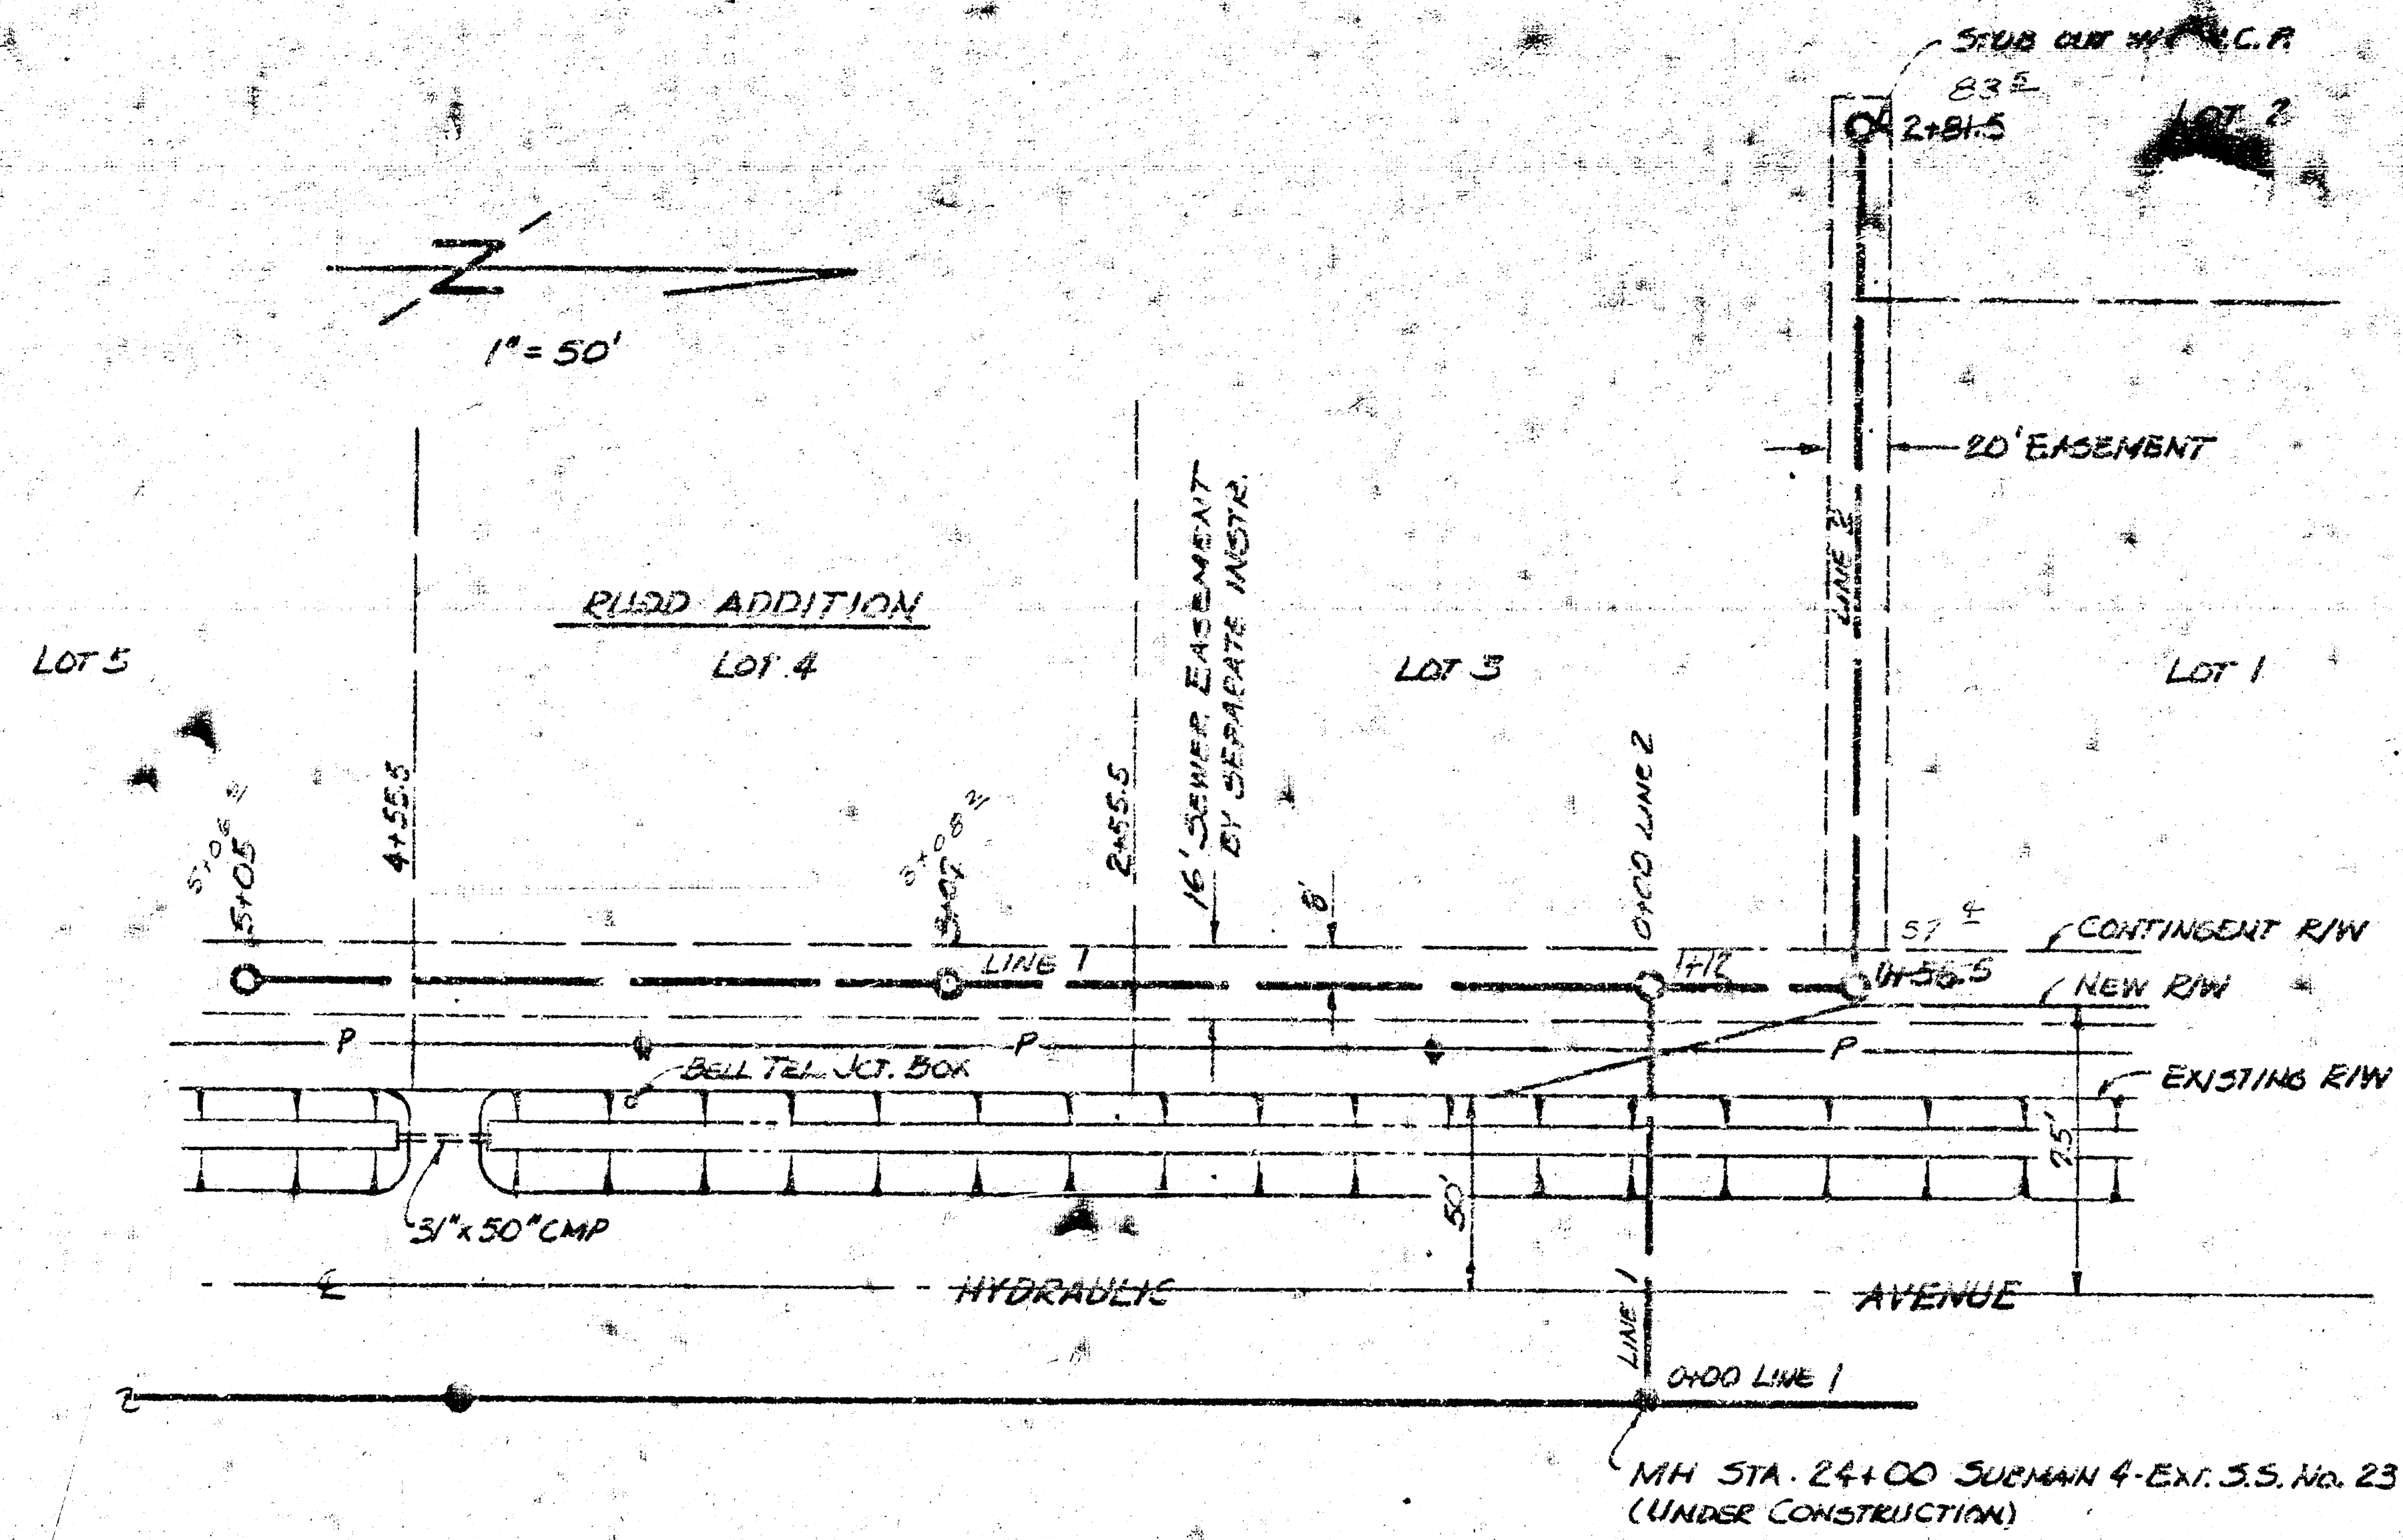


NOTE TO CONTRACTOR
 This project will be constructed under the supervision of the CITY ENGINEER and conforming to the SPECIFICATIONS of the CITY OF WICHITA. The CONTRACTOR will reimburse the City of Wichita for all cost of ~~materials~~ and inspection.

APPROVED AS NOTED
 By CITY ENGINEER OF WICHITA
 Sanitary Sewers: 2-8-95
 Storm Sewers: _____
 Drains: _____

SCALE
 1" = 50' HORIZ.
 1" = 5' VERT.

NOTES:
 CASING FOR BORINGS SHALL BE 16" SCH. 40 STEEL PIPE. CASING TO BE NEW OR APPROVED USED PIPE.
 ALL LINES TO BE SAND BACKFILLED AND FLUSHED

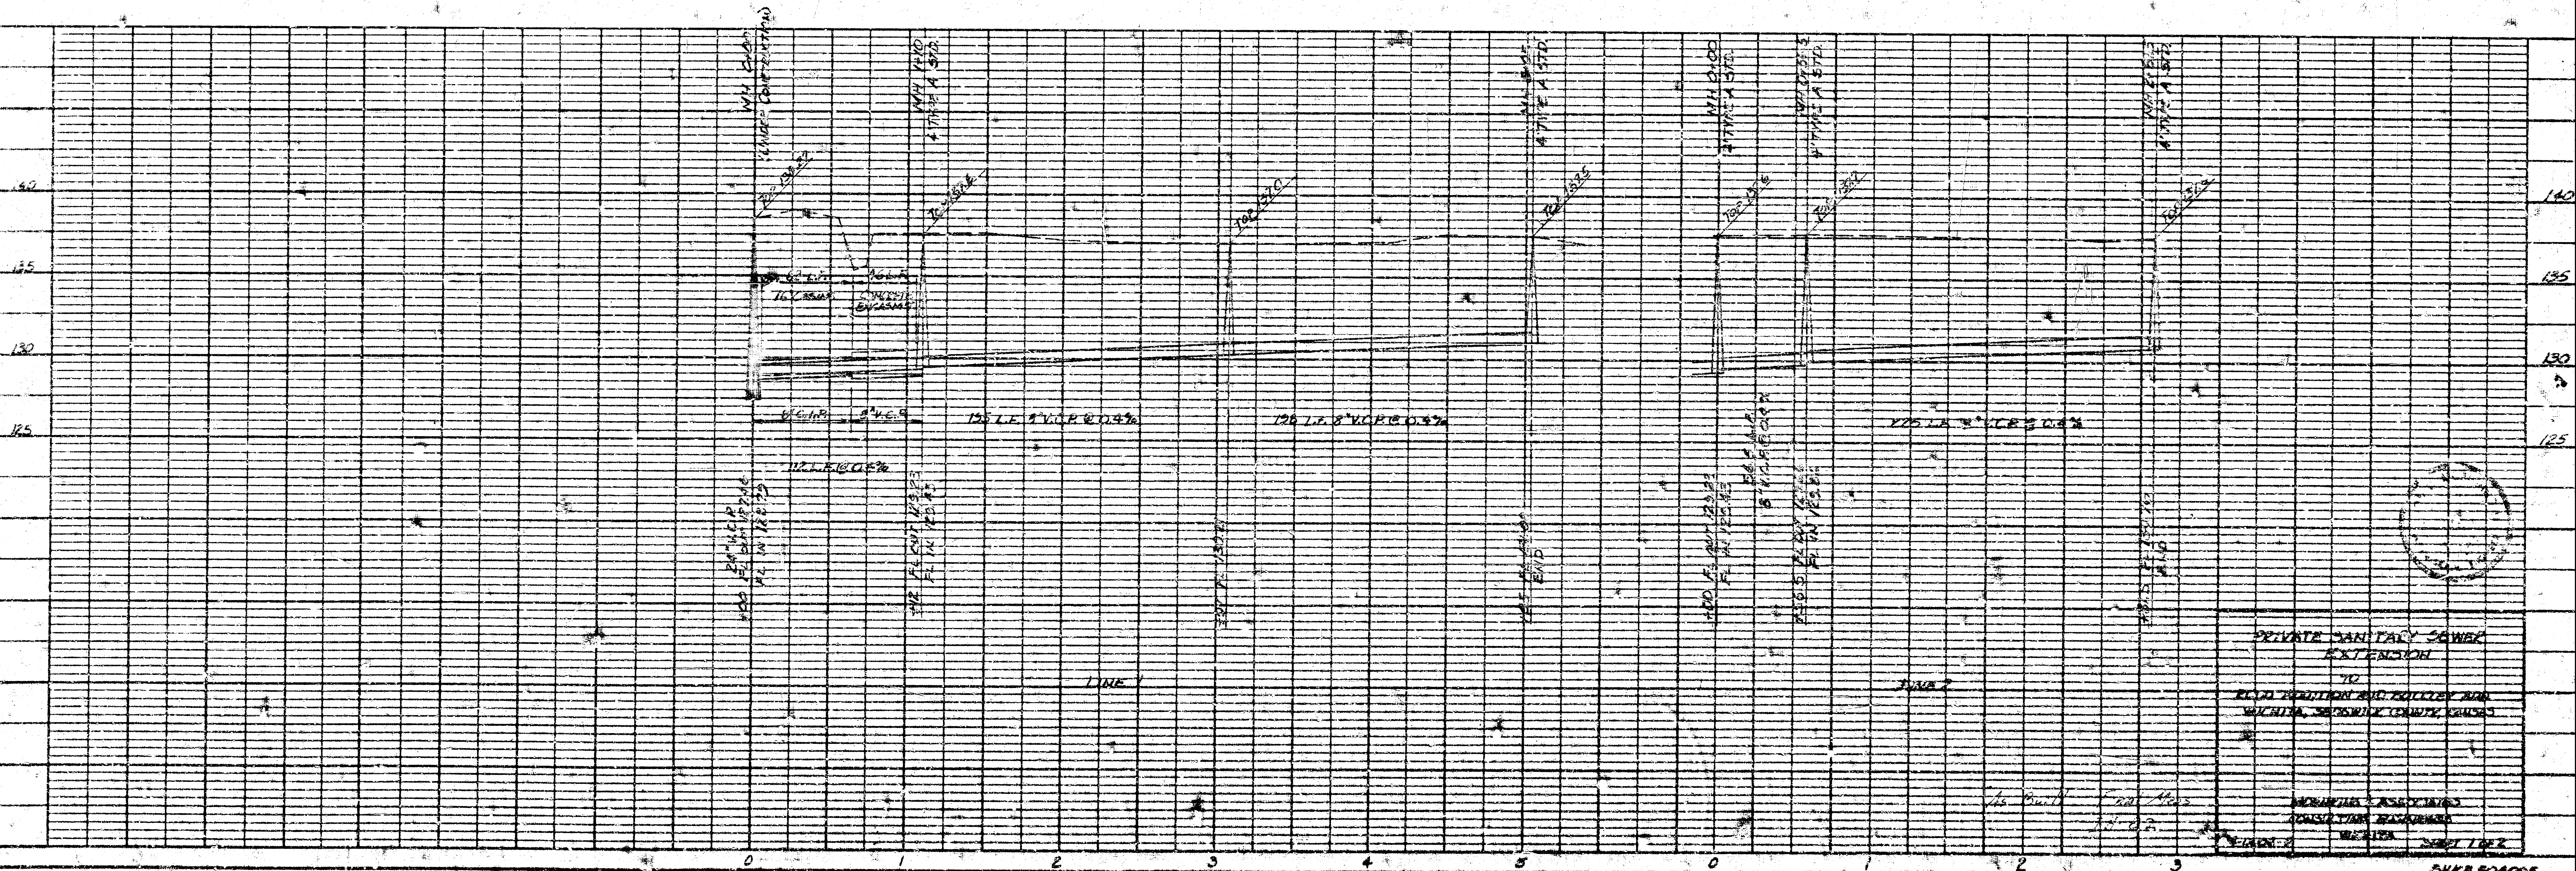

PRIVATE SANITARY SEWER EXTENSION
 TO
 ROAD FRONTION AND MILLER AND
 WICHITA, SEBASTIAN (DRAFT) CAUSE
 ADJUTANT CASSEY LINES
 CONSTRUCTION REVENUES
 WICHITA
 MAY 1907