



Survey by A. R. Ryan, D.L. No. 418-15
 Drawn by C. M. Dife
 Checked by

B. M. 117.06 "M" in Mueller Fire Hyd. S. E. cor. 10th & Minneapolis.

Plan Scale 1" = 40'
 Profile Scale 1" = 40' Horiz.
 1" = 4' Vert.

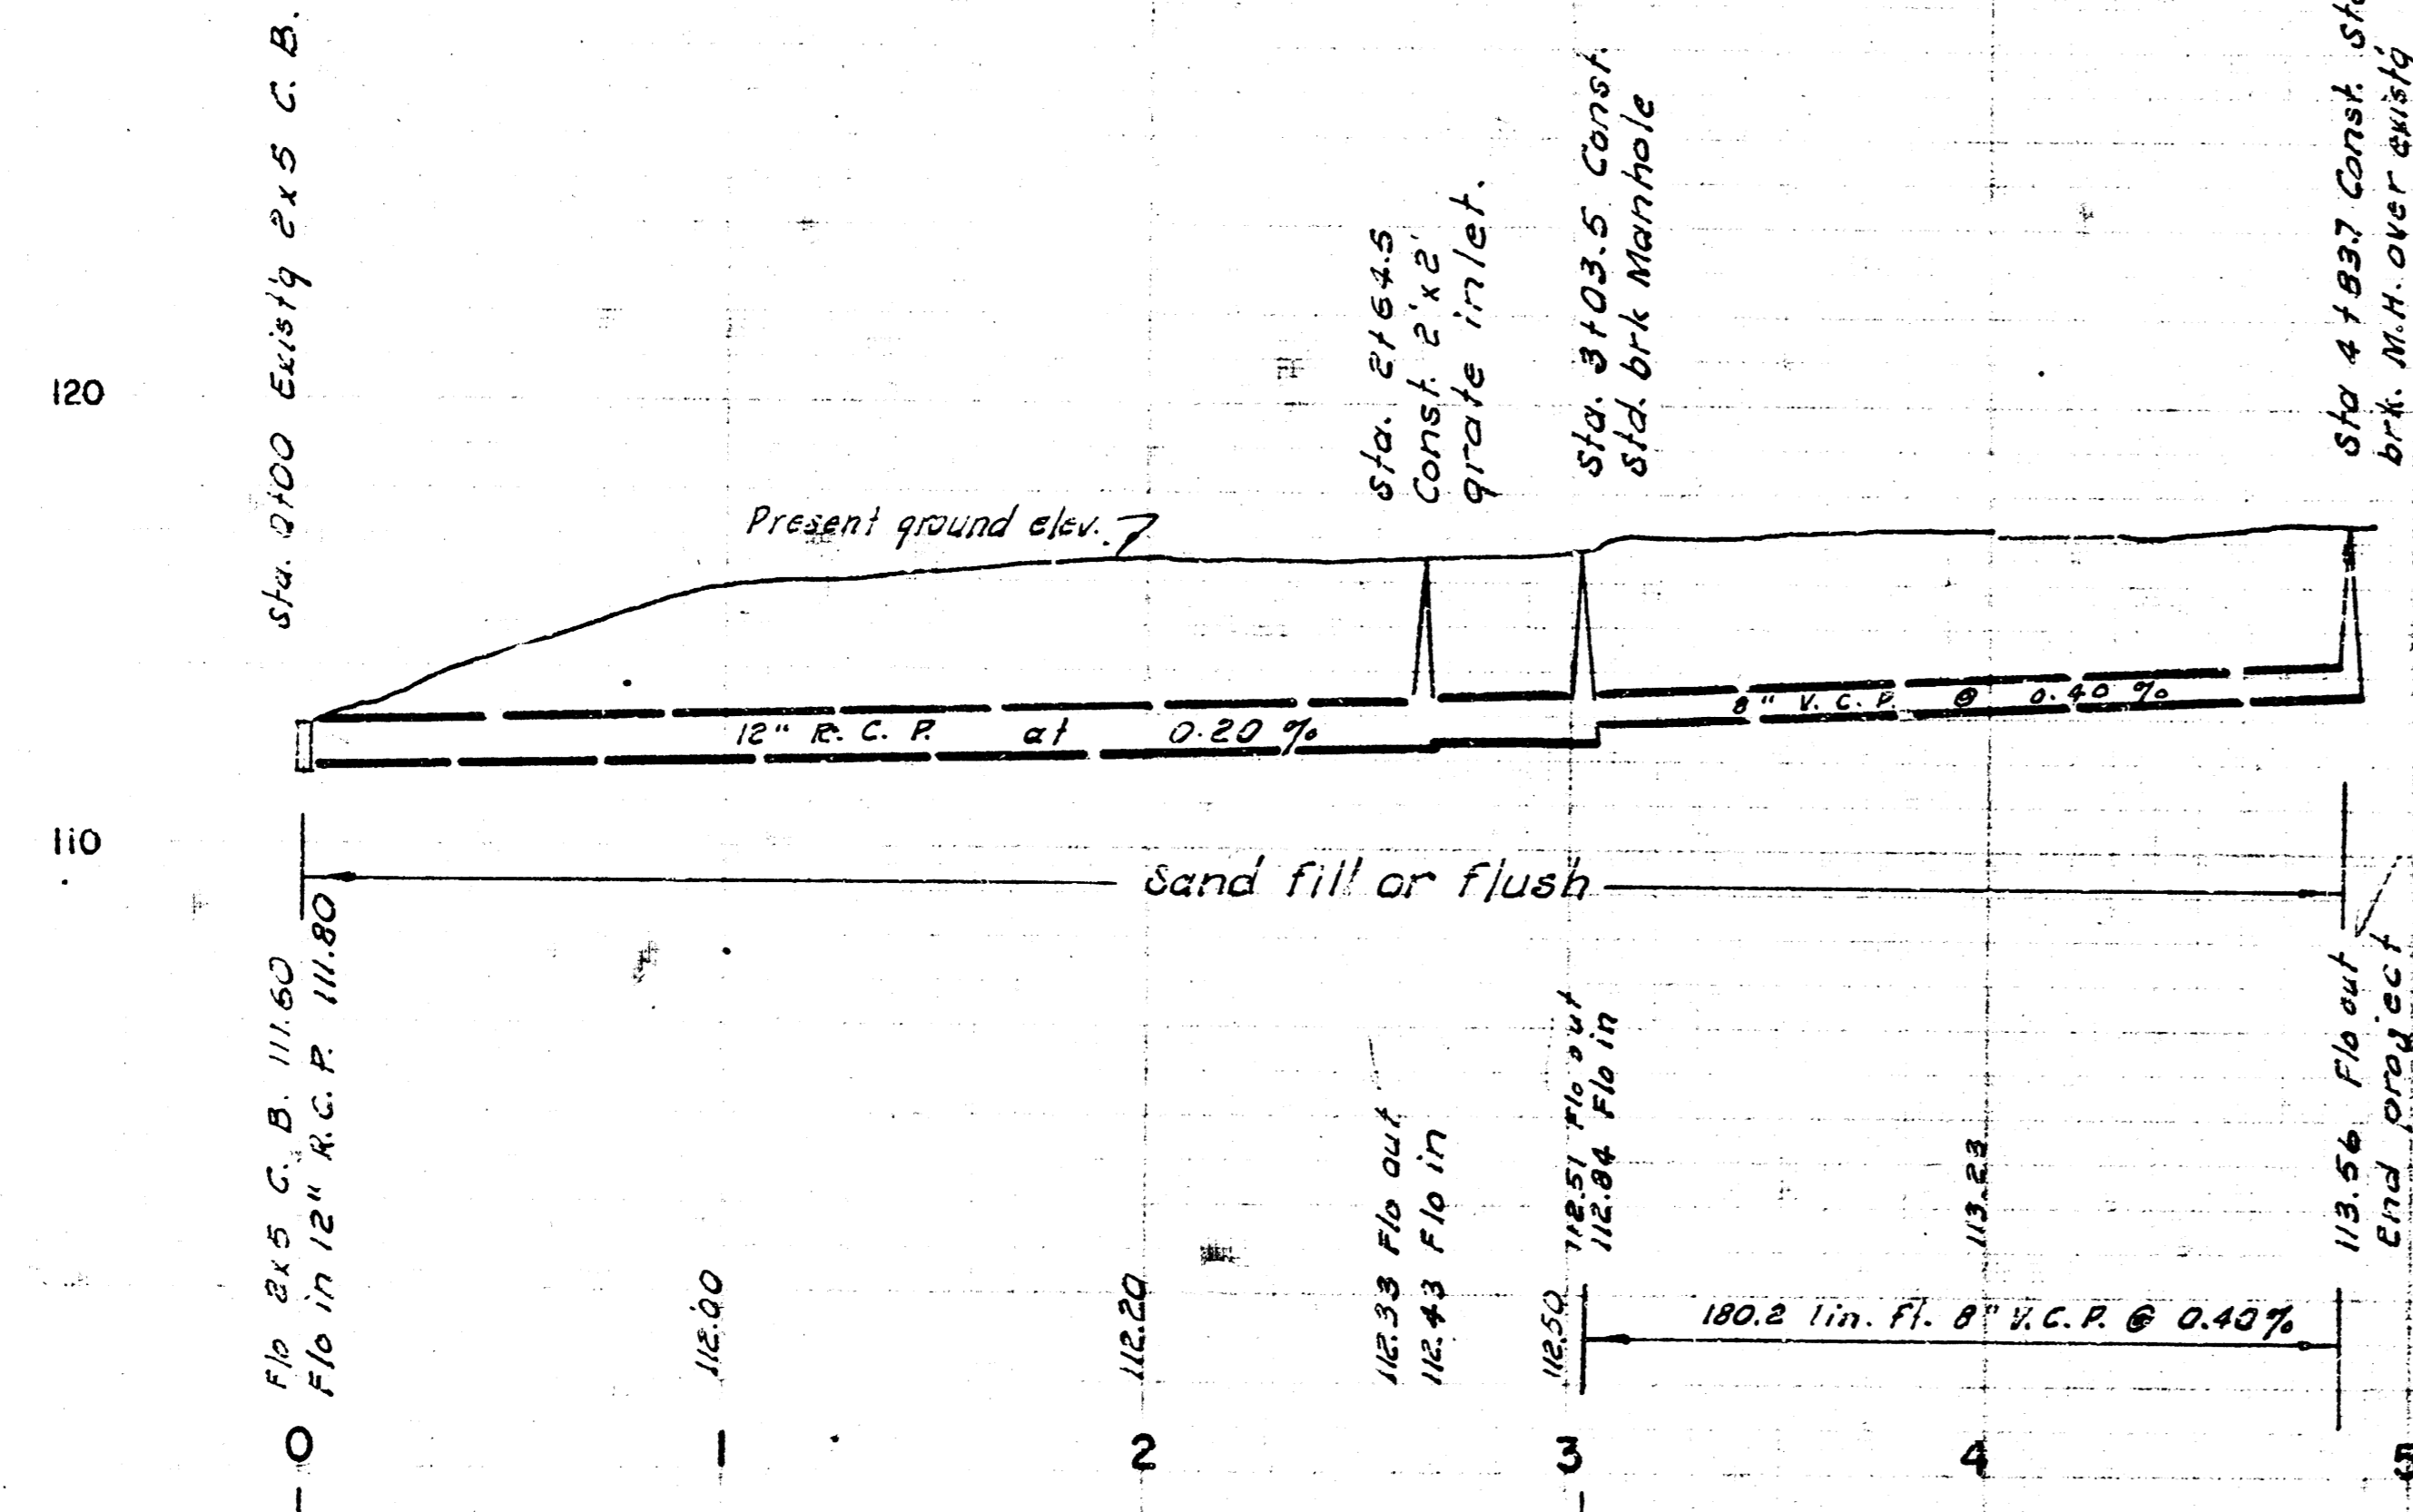


WICHITA - SEDGWICK COUNTY
 DEPT. OF PUBLIC HEALTH
STORM WATER SEWER
 SOUTHWEST COR. MINNESOTA & TENTH
 CITY OF WICHITA, KANSAS
 B. E. SMITH CITY ENGINEER
 OCT. 1962

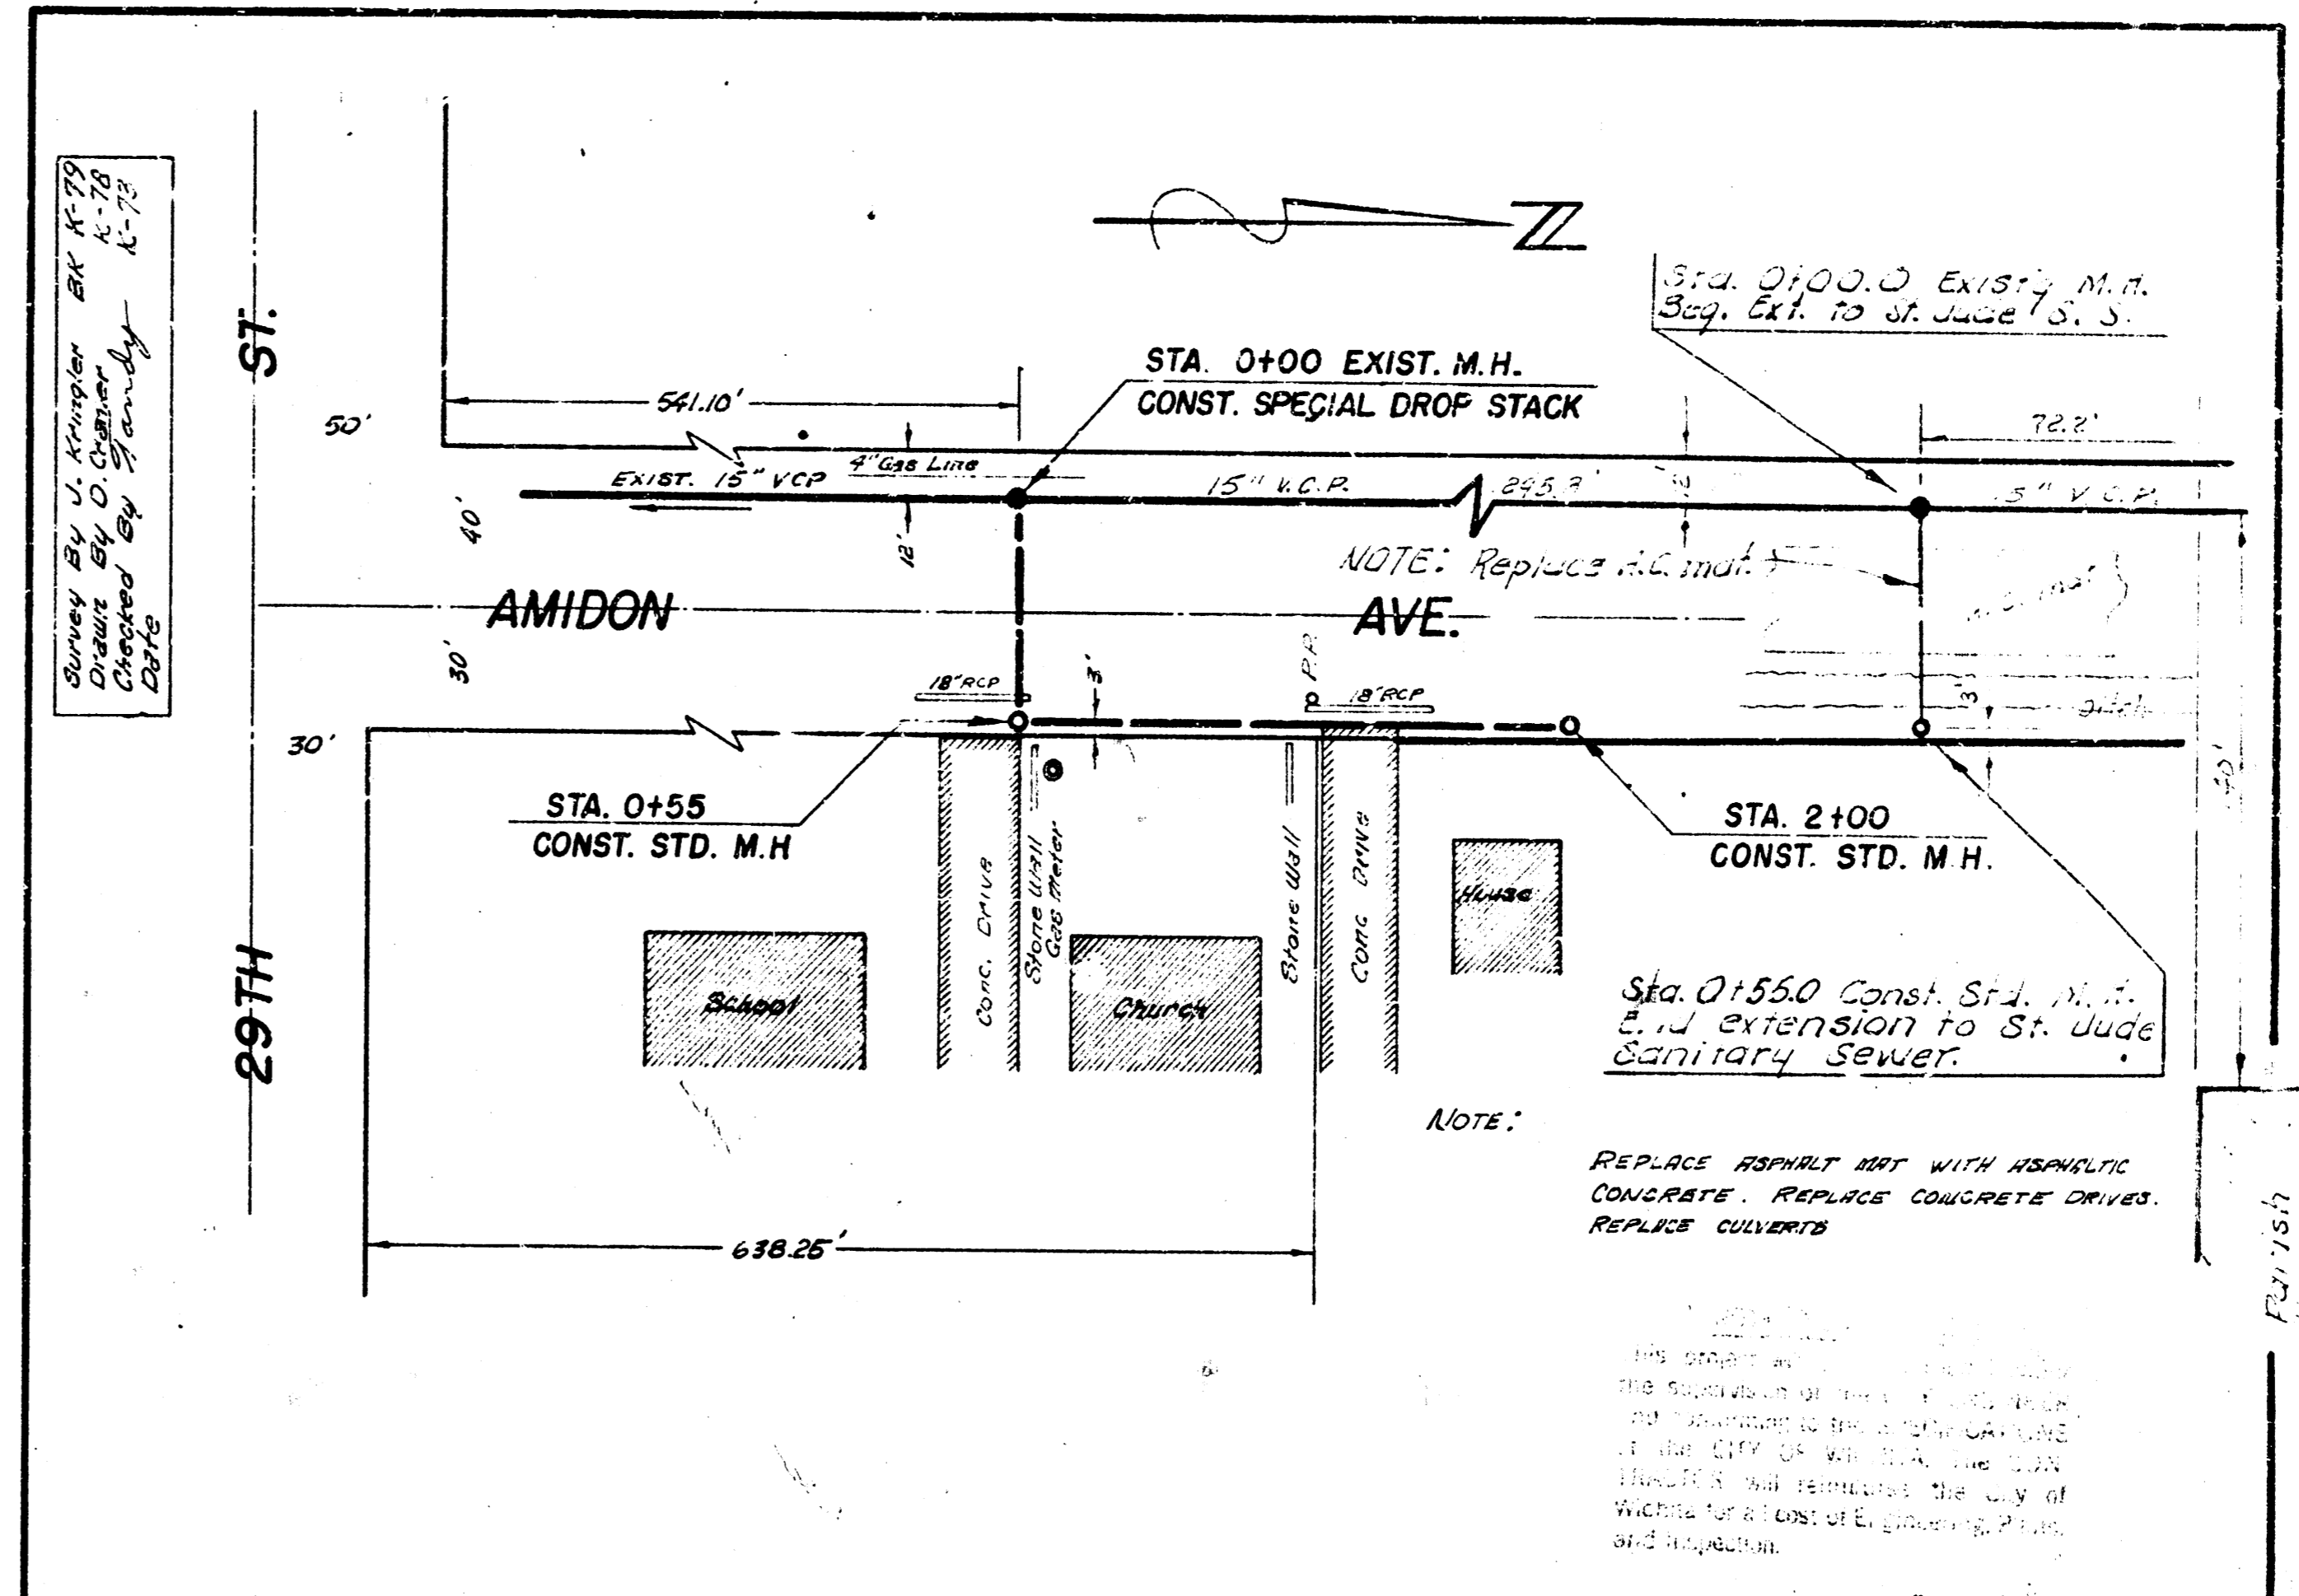

Survey by C. M. Dife
 Drawn by C. M. Dife
 Checked by

B. M. 127.22 STD. S.W. COR. 29TH & AMIDON

PLAN SCALE 1" = 40'
 PROFILE SCALE 1" = 40' HOR.
 1" = 4' VERT.

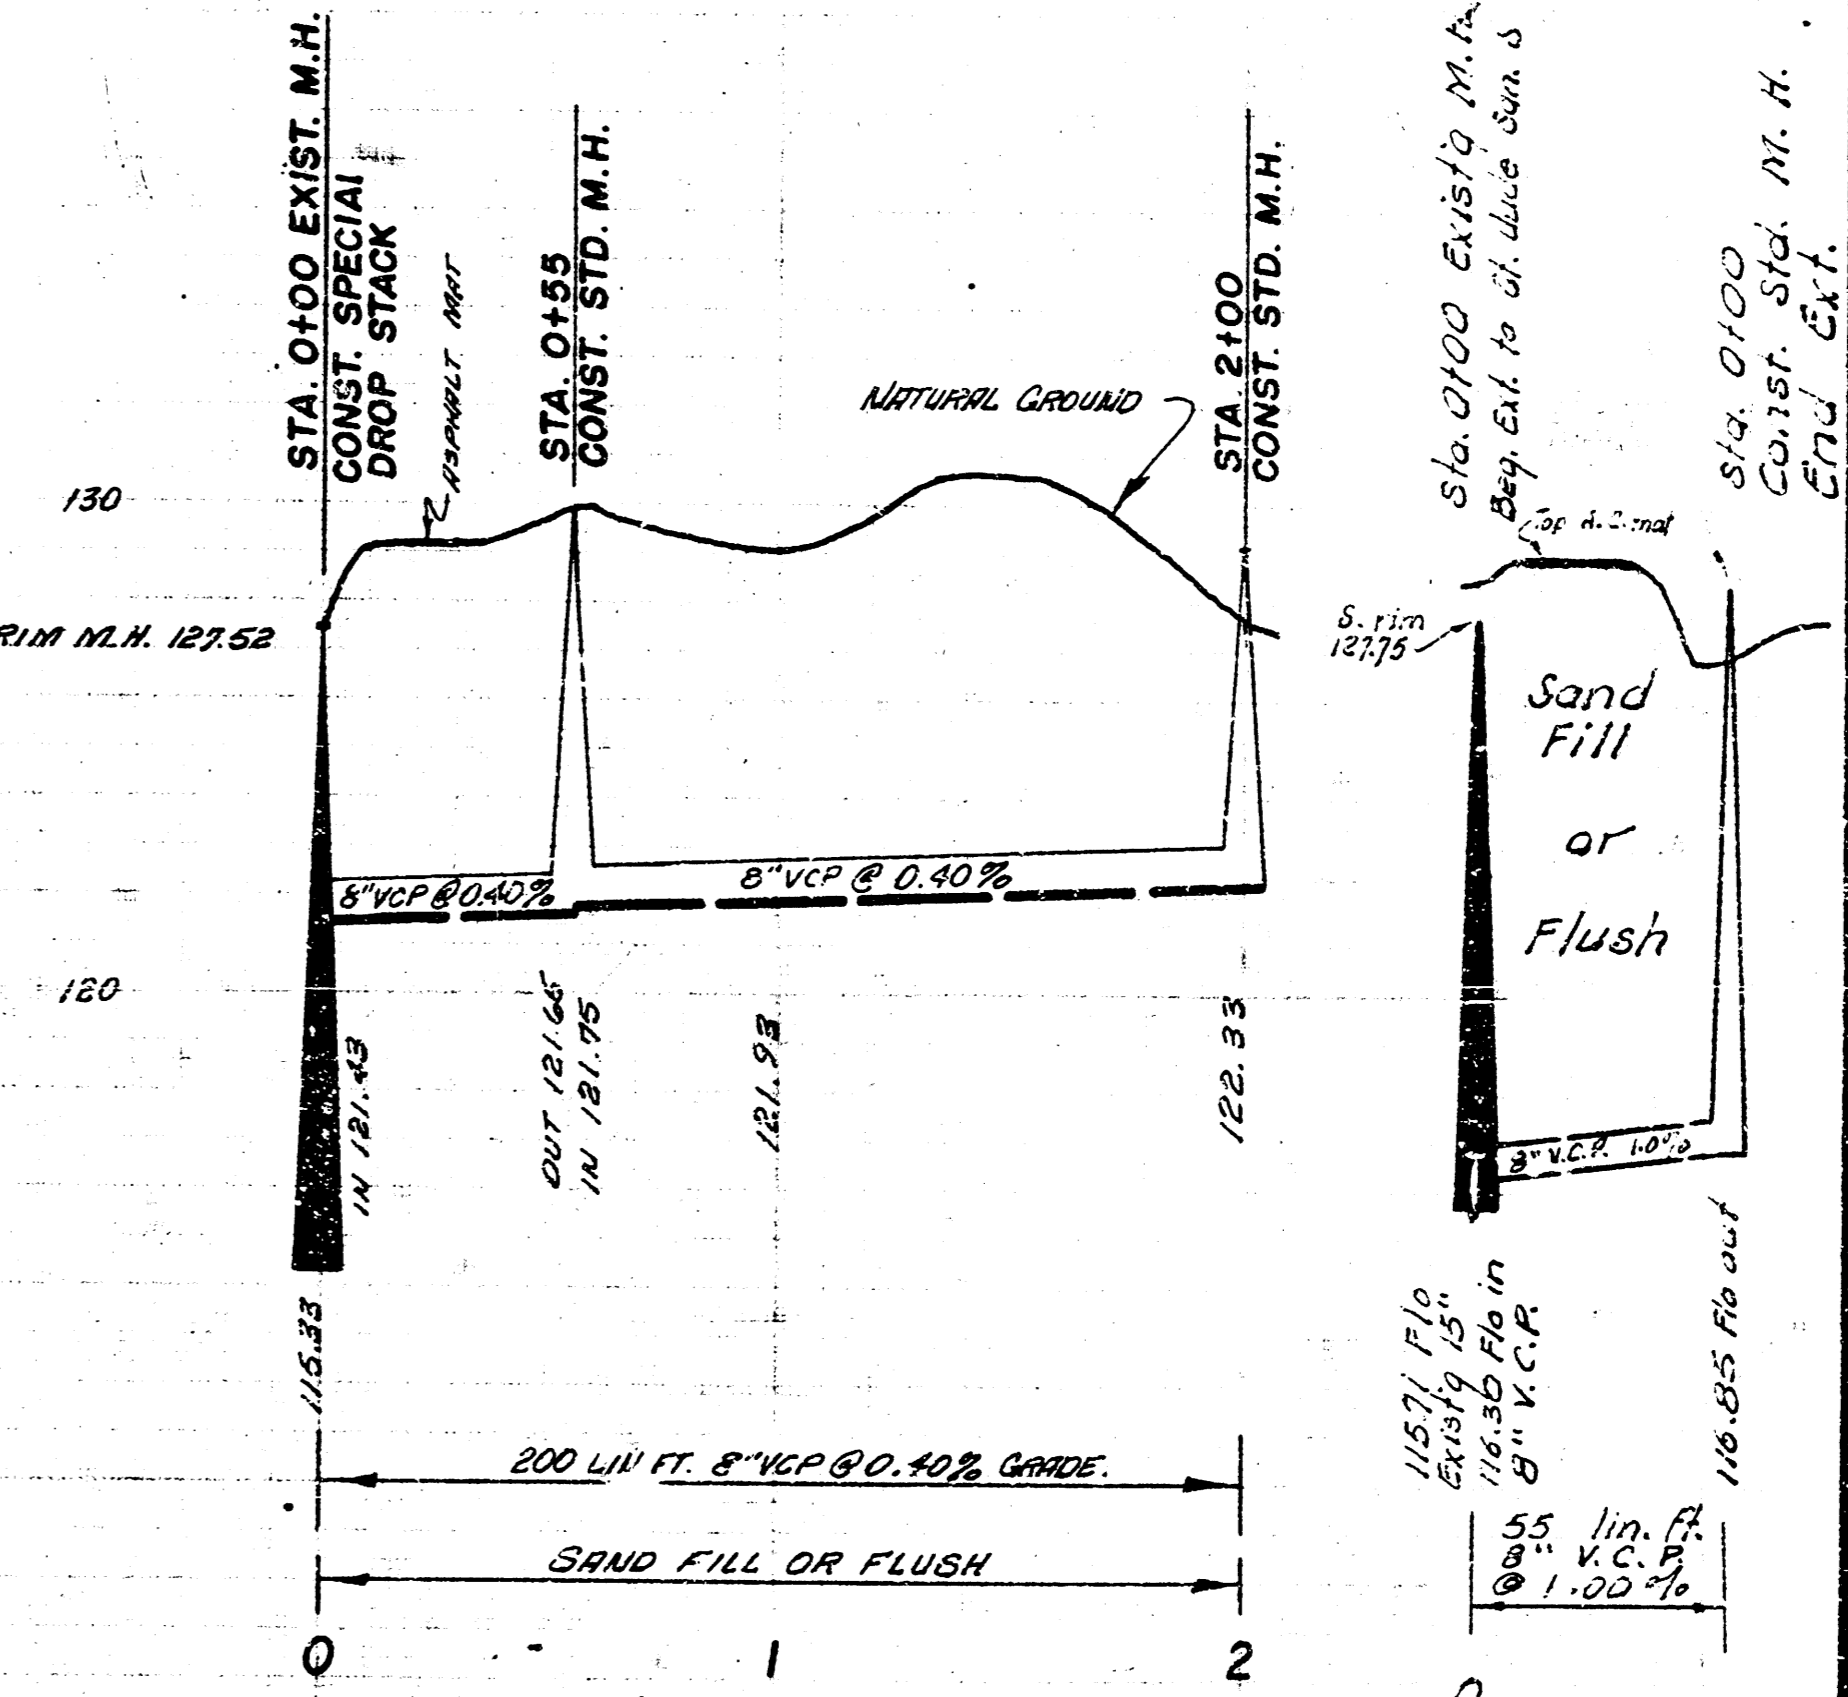

EXTENSION MAY 1964
ST. JUDE SAN. SEWER
 CITY OF WICHITA, KANSAS
 B. E. SMITH, CITY ENGINEER
 PRIVATE CONTRACT DATE June 1963

