


COUNTY	STATE	PROJECT NUMBER	FISCAL YEAR	SHEET NO.	TOTAL SHEETS
SFEDGWICK	KANSAS	PB-296	1997	1	1

As built 7/25/97

Private Project No. 727 PDS (607861)

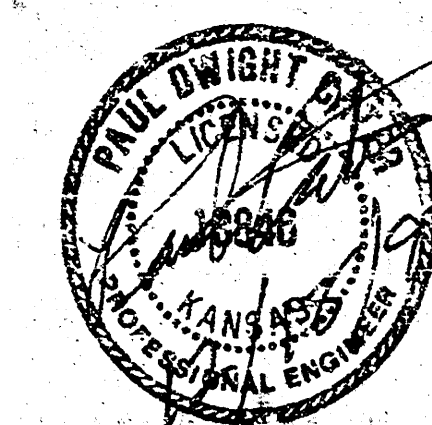

APPROVED AS NOTED
By CITY ENGINEER OF WICHITA

Sanitary Sewers VRH 6/17/9

Stem Seals



Drive-My Approach

at 11:00 a.m. on 11/11/2011.

1

NOTE TO CONTRACTOR

INSPECTION AND TESTING FOR THIS PROJECT IS TO BE PROVIDED BY A LICENSED CONSULTING ENGINEERING FIRM UNDER CONTRACT TO THE CITY ENGINEER. ALL INSPECTION AND TESTING SHALL BE IN ACCORDANCE WITH THE CITY OF WICHITA STANDARD CONSTRUCTION ENGINEERING PRACTICES AND CERTIFIED BY A LICENSED PROFESSIONAL ENGINEER. NO WORK SHALL BE PERFORMED IN DEDICATED EASEMENTS OR THE PUBLIC RIGHT-OF-WAY BY THE CONTRACTOR WITHOUT SUCH INSPECTION AND TEST SHALL ANY WORK BE COMMENCED IN A DEDICATED EASEMENT OR PUBLIC RIGHT-OF-WAY WITHOUT WRITTEN AUTHORIZATION BY THE CITY ENGINEER. CONSTRUCTION SHALL BE IN ACCORDANCE TO THE CITY OF WICHITA STANDARD SPECIFICATIONS.

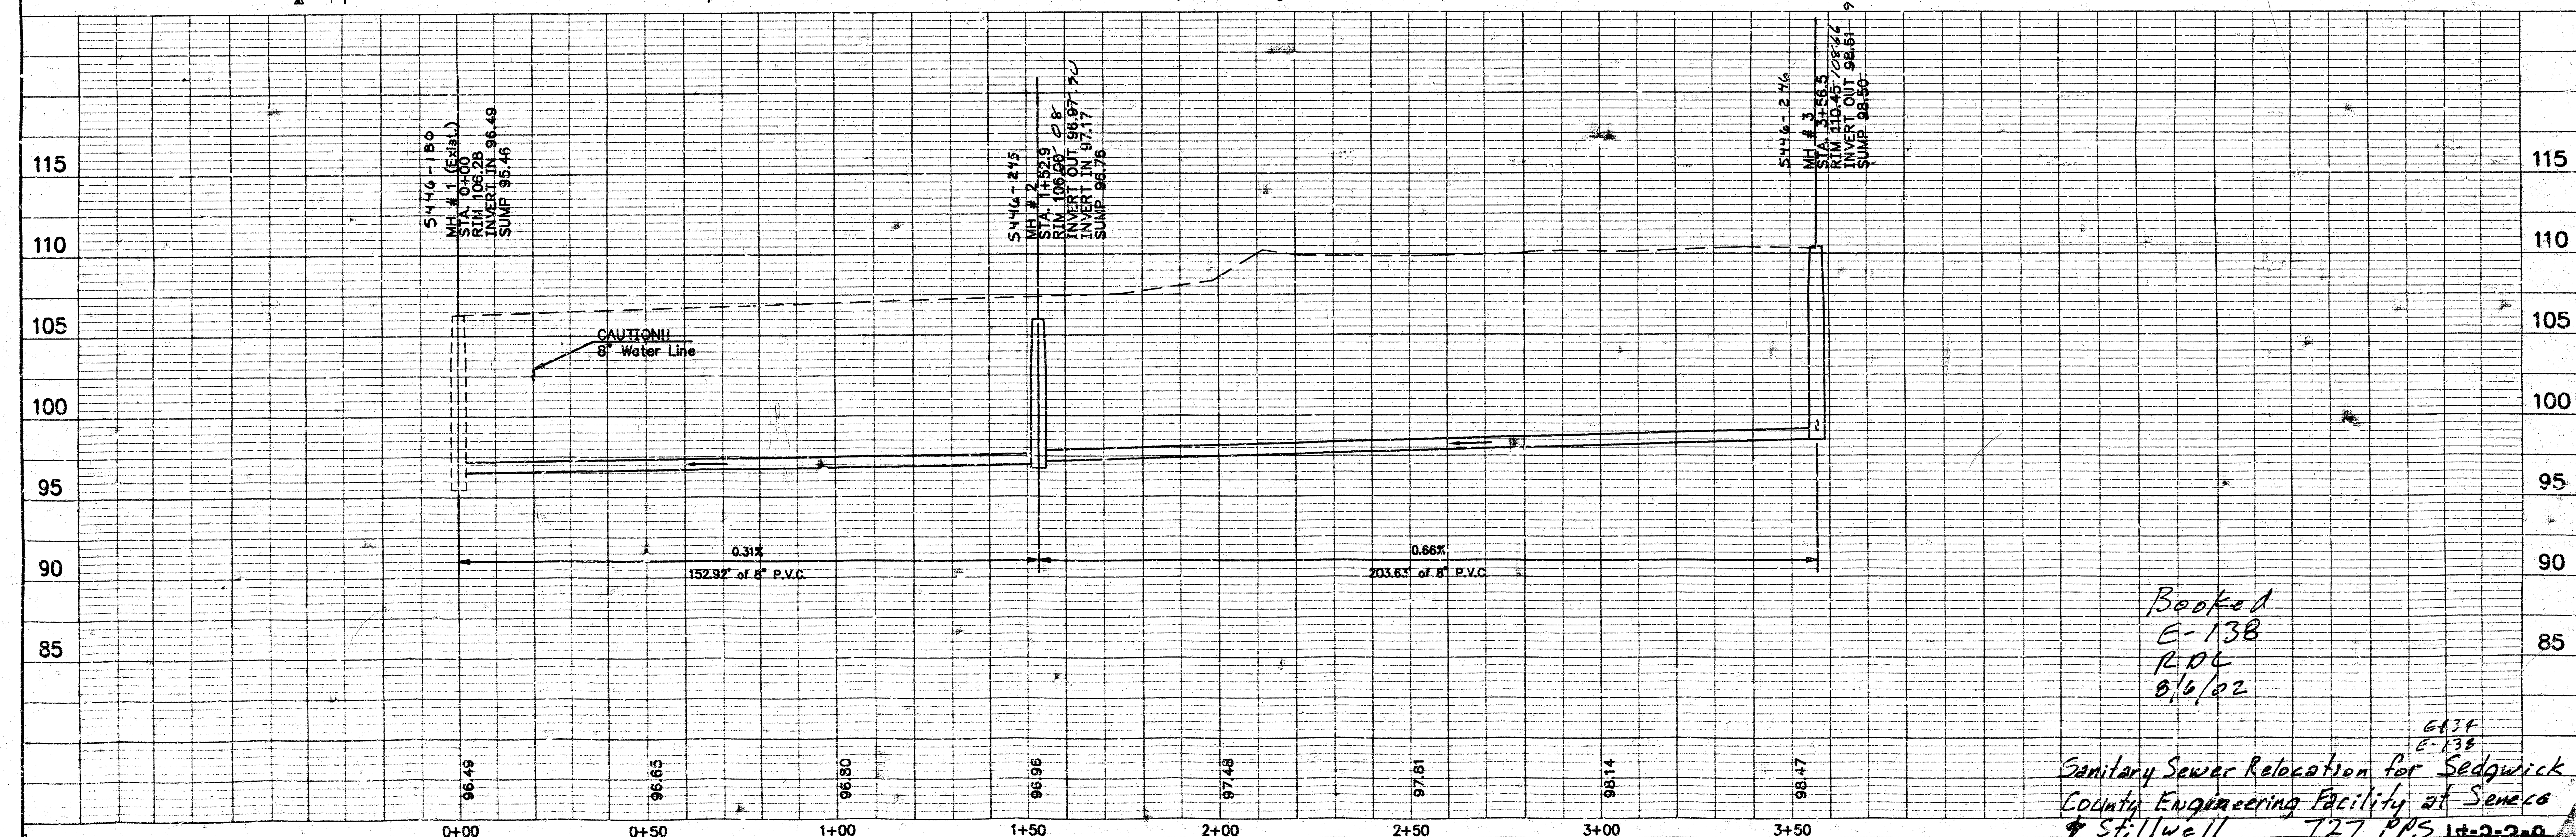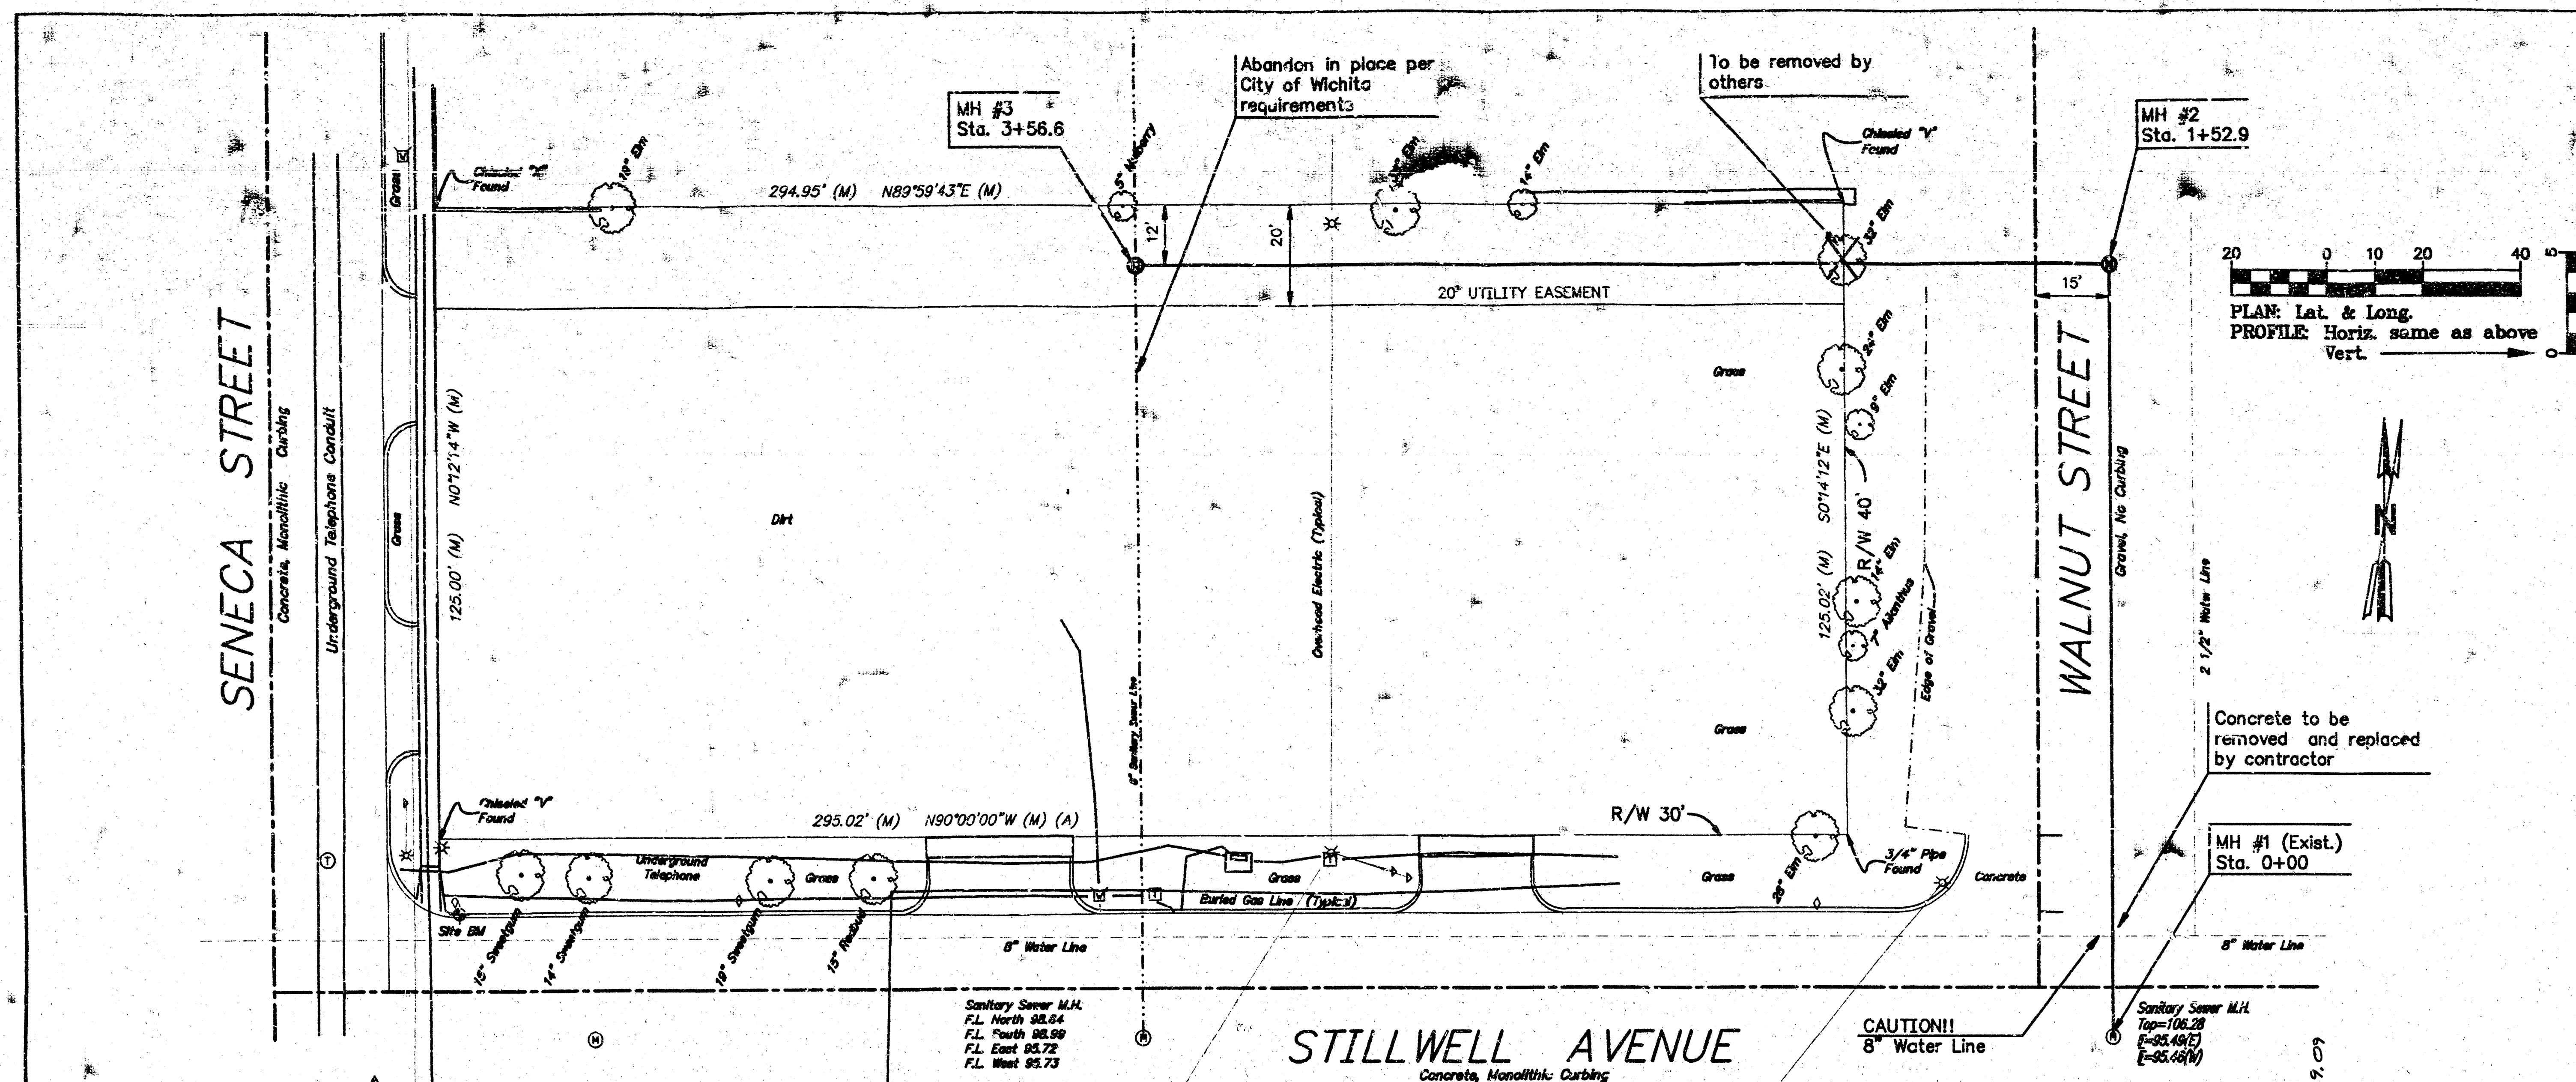

Booked
E-138
RDC
8/6/02

Sanitary Sewer Relocation for Sedgwick
County Engineering Facility at Seneca
& Stillwell T27 PPS 17-2-20