
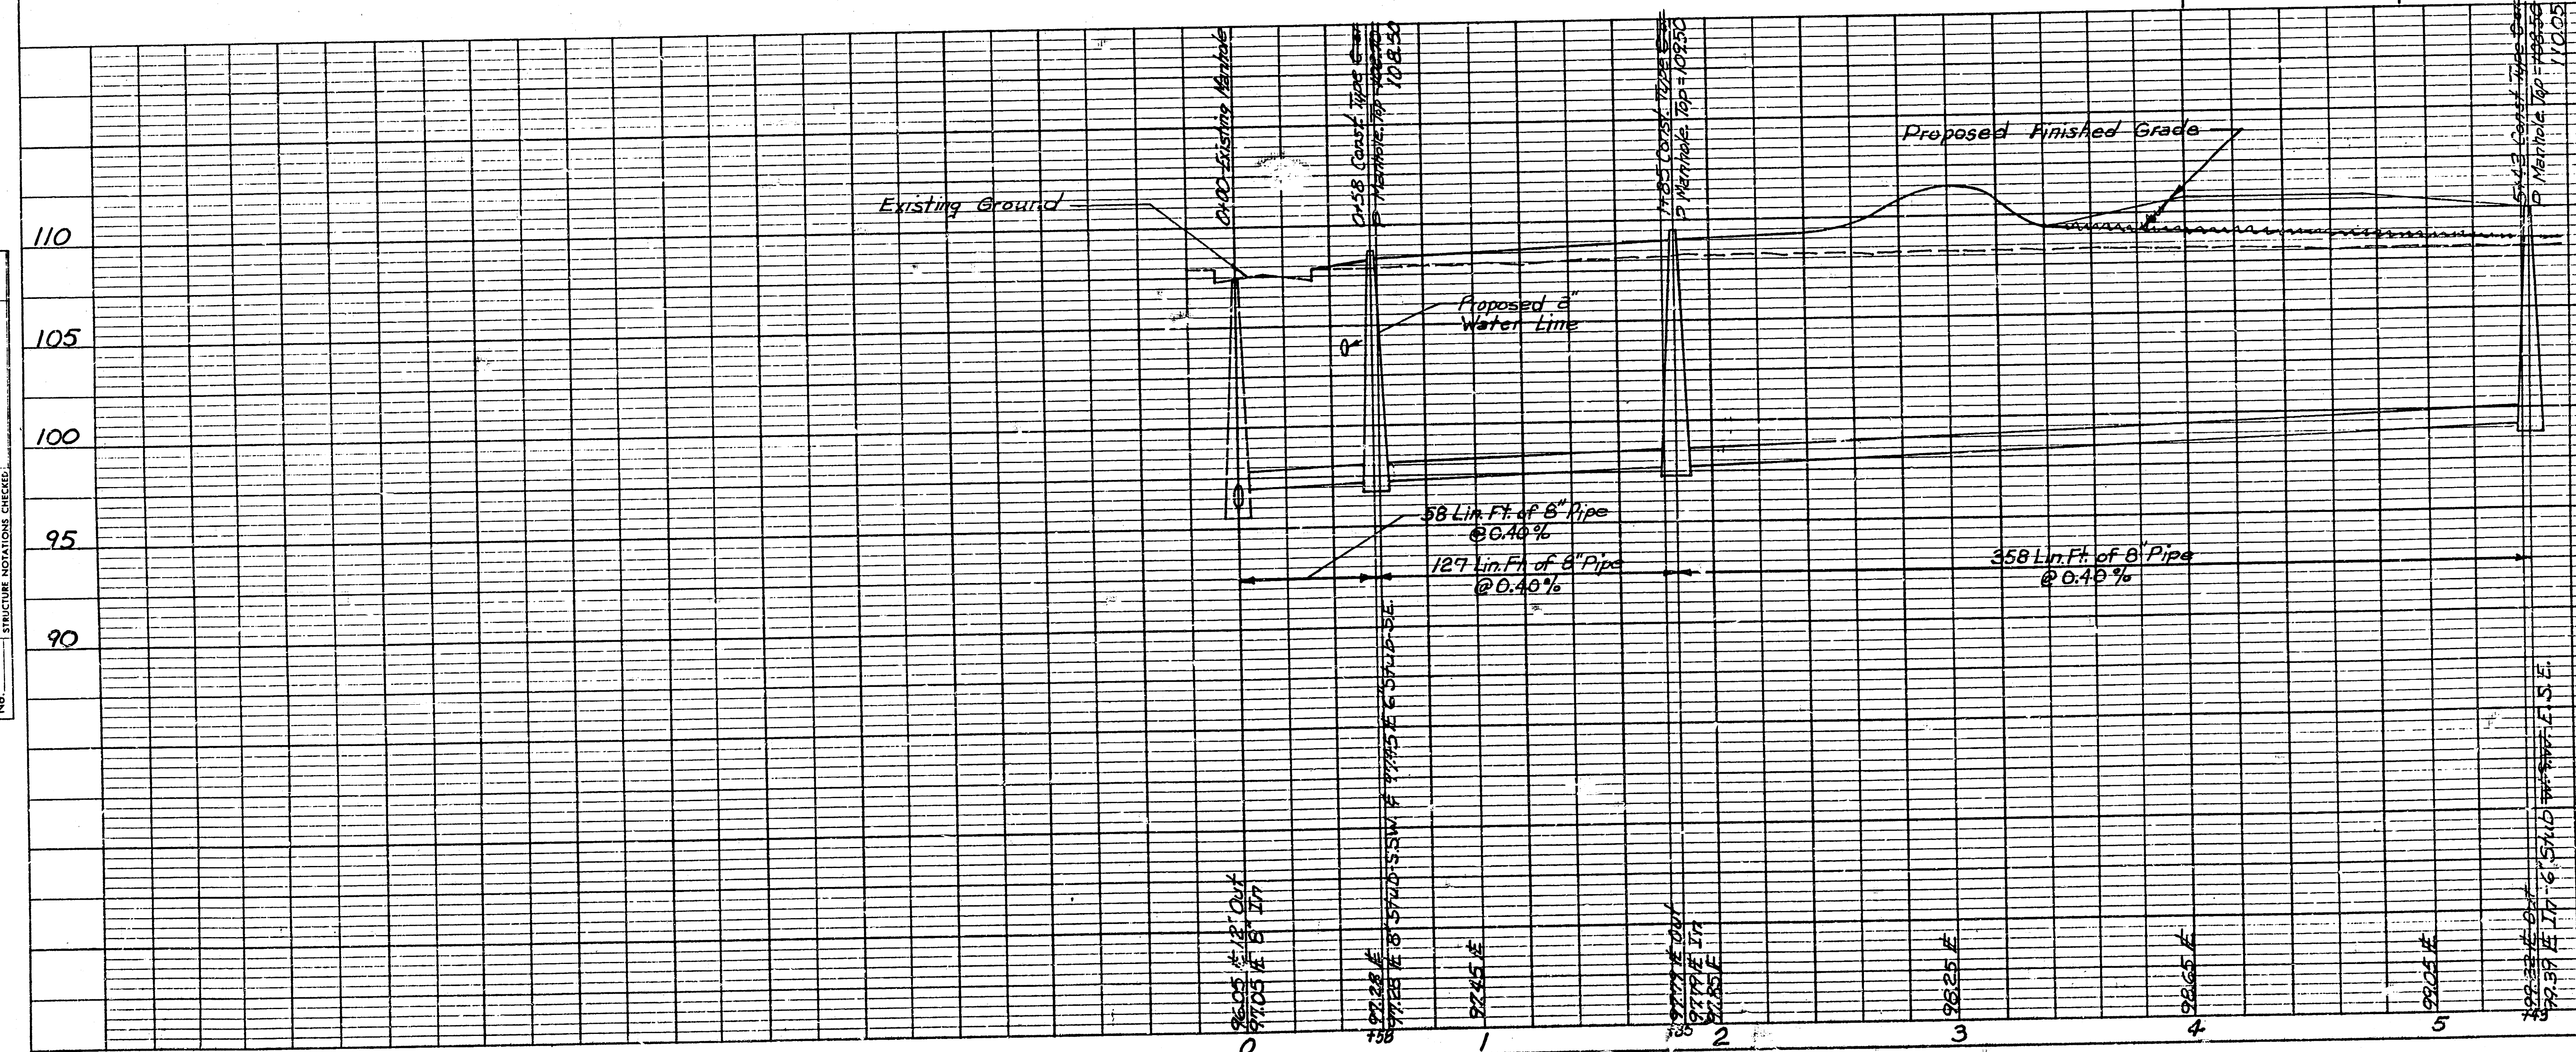
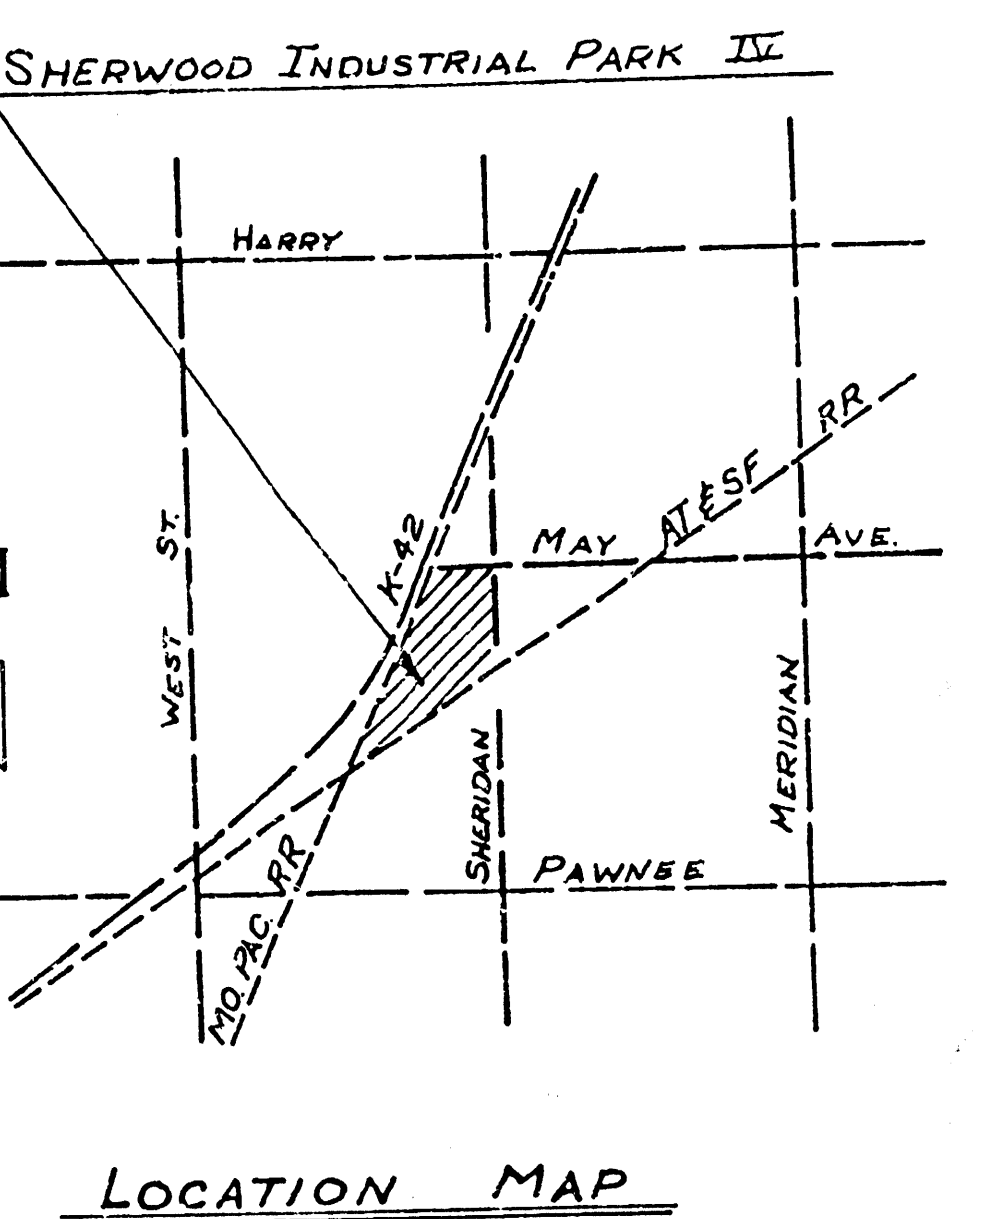


DATE	BY	REVIEWED	DATE
PLAN			
NOTE BOOK			
NO.			

DATE	BY	REVIEWED	DATE
PROFILE			
NOTE BOOK			
NO.			

- GENERAL NOTES**
- ALL ELEVATIONS SHOWN ARE CITY OF WICHITA DATUM (USGS-1187.4 - CITY DATUM).
 - CONTRACTOR WILL BE REQUIRED TO PROVIDE A MINIMUM ADVANCE NOTICE OF TWENTY-FOUR (24) HOURS TO UTILITY COMPANIES PRIOR TO STARTING ANY EXCAVATION AS FOLLOWS:
KANSAS ONE-CALL 1-800-344-7233
THE CONTRACTOR MUST NOTIFY THE FOLLOWING IN CASE OF AN EMERGENCY:
CABLEVISION 262-4270 OR 263-2061
KPL GAS SERVICE COMPANY 263-7511
KANSAS GAS & ELECTRIC 264-1141
ARIELA GAS COMPANY 942-8350 OR 263-8161
SOUTHWESTERN BELL TELEPHONE CO. 1-571-2611
CITY OF WICHITA SEWER MAINTENANCE 268-4071
 - ALL CONSTRUCTION AND MATERIALS TO COMPLY WITH CITY OF WICHITA SPECIFICATIONS AND STANDARDS.
 - CONTRACTOR SHALL NOT START WORK ON THE PROJECT UNTIL THE PROJECT INSPECTOR IS ASSIGNED TO THE PROJECT AND IS PRESENT ON THE SITE. ANY WORK DONE WITHOUT INSPECTION WILL BE REQUIRED TO BE UNCOVERED FOR INSPECTION.
 - THE CONTRACTOR SHALL BE RESPONSIBLE FOR PRESERVING PROPERTY IRONS. THE CONTRACTOR WILL BE REQUIRED TO RE-ESTABLISH ANY PROPERTY IRONS WHICH ARE DAMAGED OR DESTROYED BY HIS CONSTRUCTION OPERATIONS. SUCH IRONS SHALL BE RE-ESTABLISHED BY A LICENSED LAND SURVEYOR OR A LICENSED PROFESSIONAL ENGINEER IN ACCORDANCE WITH STATE LAWS. ALL COSTS FOR THIS WORK SHALL BE SUBSIDIARY TO OTHER ITEMS OF WORK.
 - TRAFFIC WILL BE AFFECTED ON MAY STREET DURING CONSTRUCTION. ONE LANE OF TRAFFIC SHALL BE MAINTAINED DURING CONSTRUCTION USING FLAG PERSONS AND BARRICADES AS NECESSARY DURING CONSTRUCTION HOURS.

Sta. 0+00 Existing Manhole
Top of Rim = 107.28
Install 8" Stub thru Manhole
Wall and restore Wall.
Rework Invert to Provide
Smooth Flow.

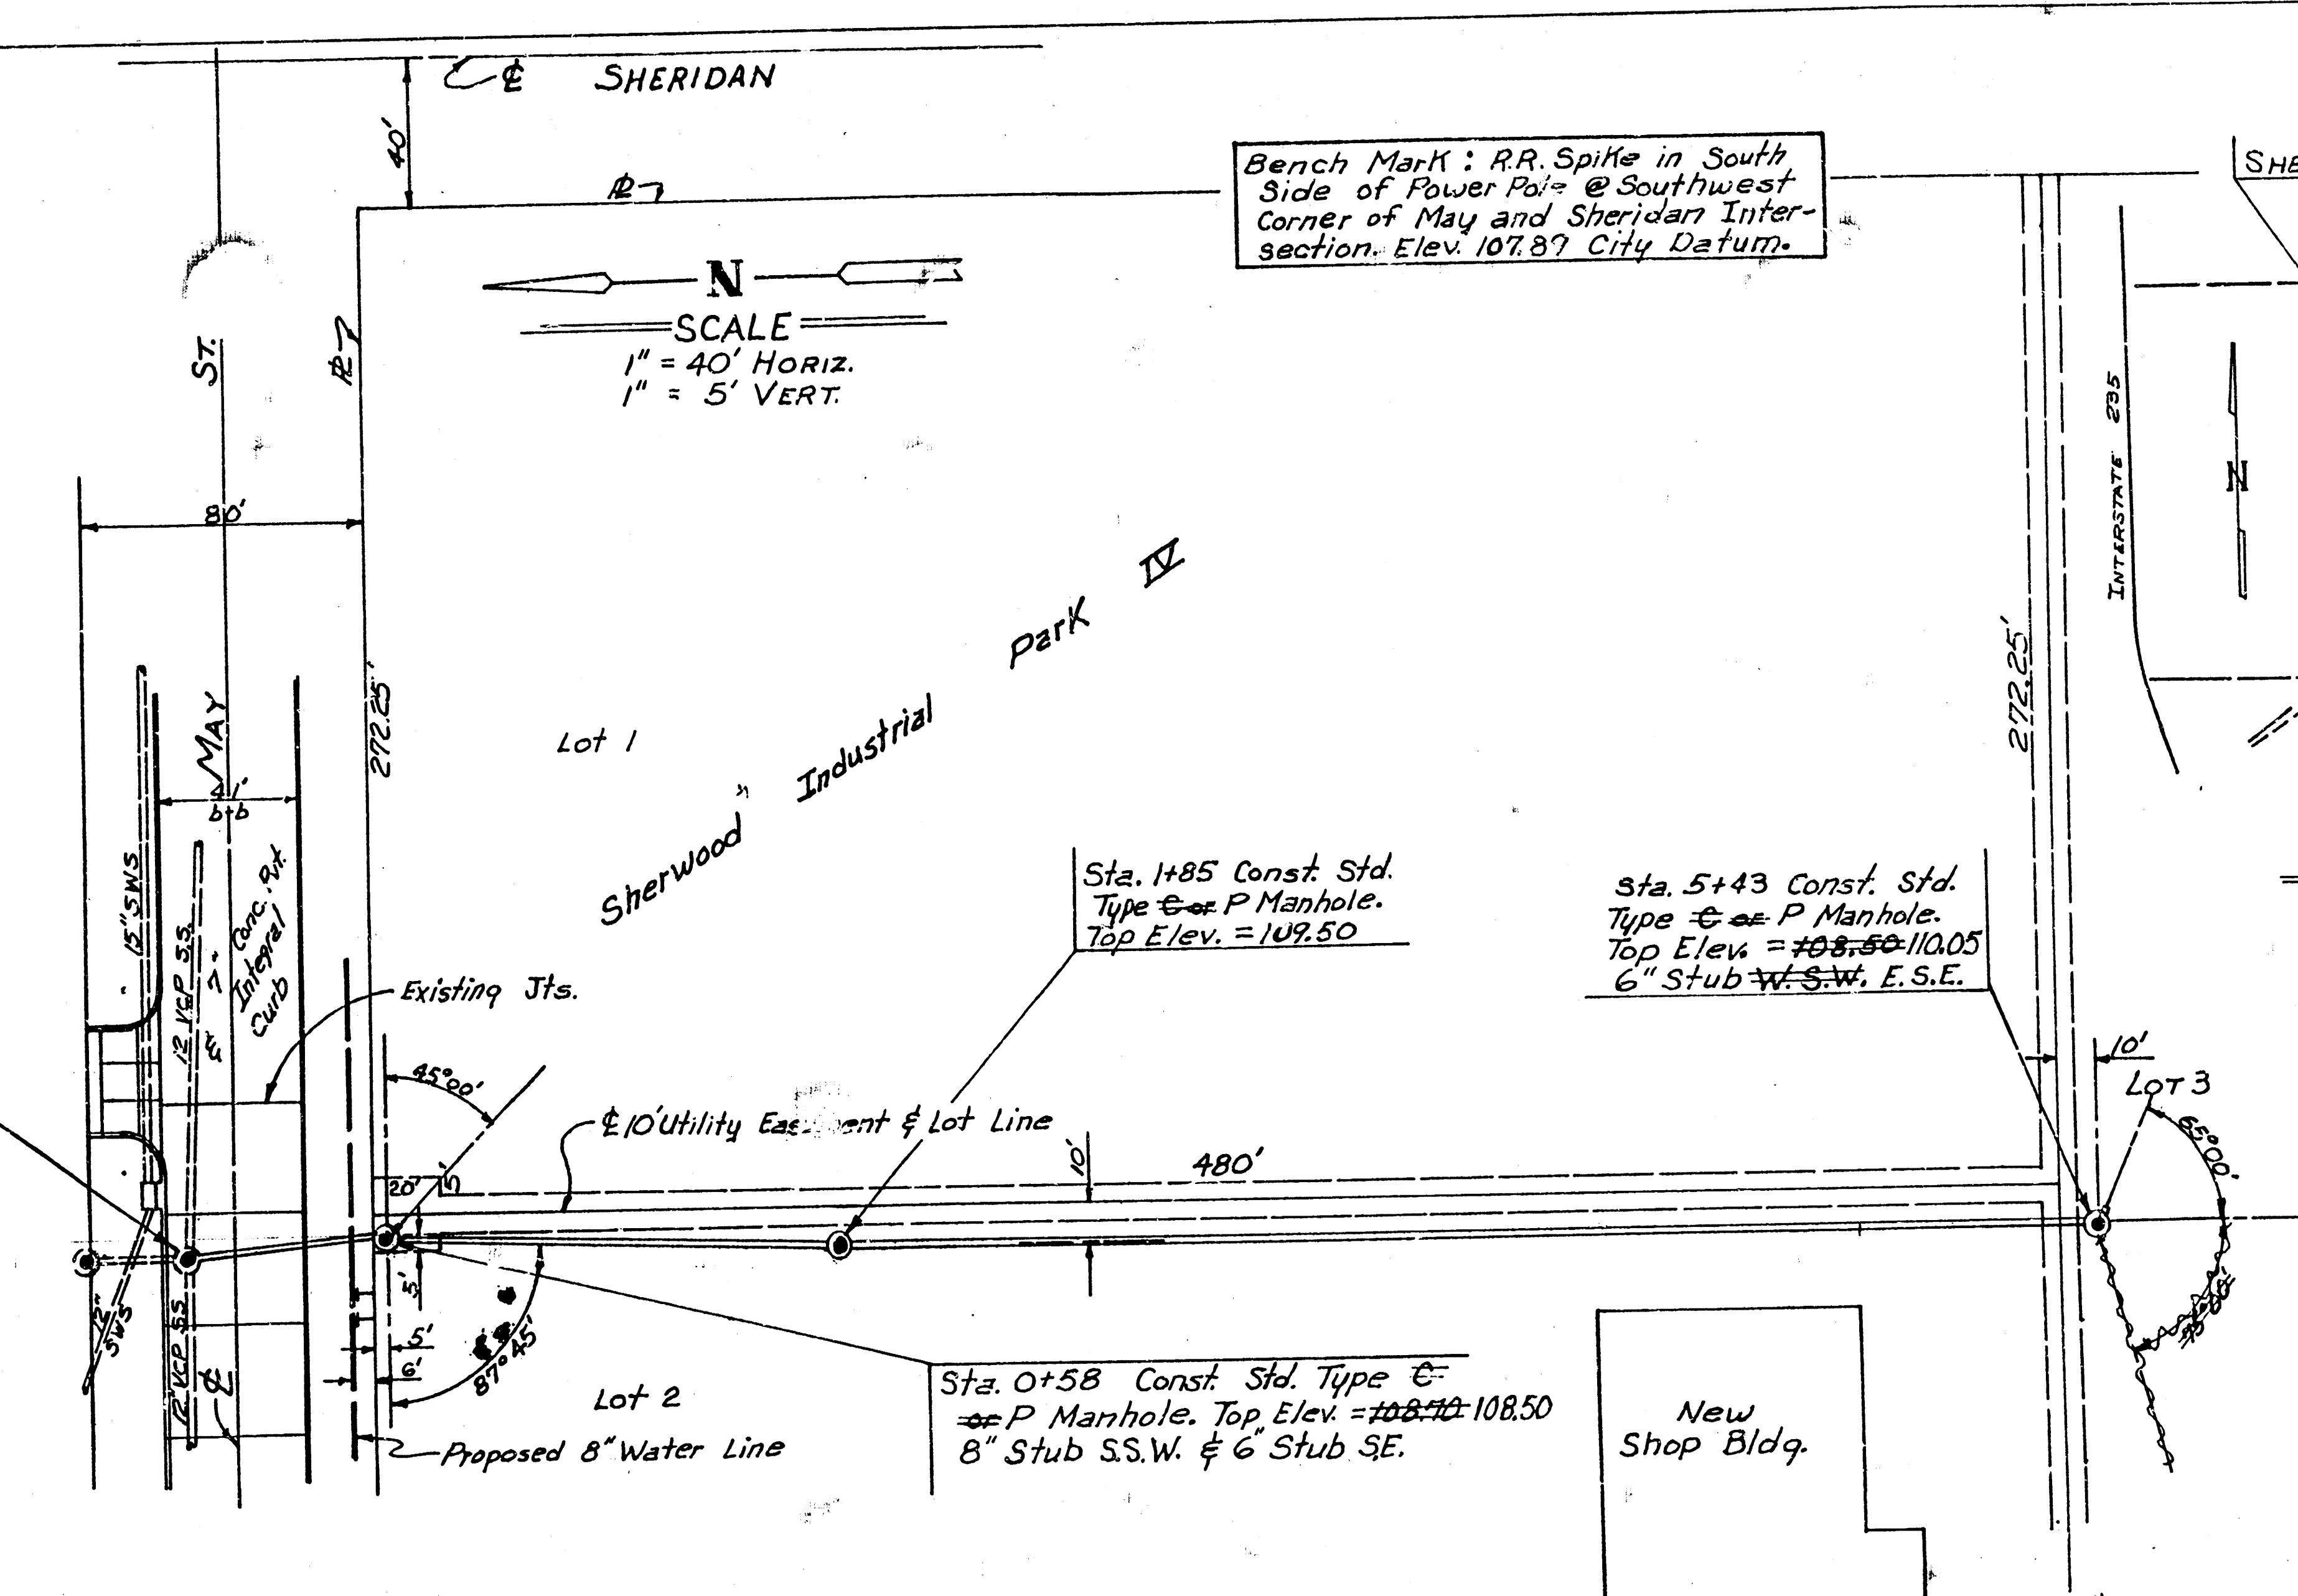

As Built 3-3-87 BHO

APPROVED AT WICHITA
BY CITY ENGINEER OF WICHITA
DATE: 10/1/88

NOTE TO CONTRACTOR:
INFORMATION AND TESTS FOR THIS PROJECT TO BE PROVIDED BY THE CONTRACTOR. THE CONTRACTOR SHALL BE RESPONSIBLE FOR THE PROTECTION OF ALL EXISTING UTILITIES AND STRUCTURES. NO WORK SHALL BE DONE WITHOUT THE WRITTEN PERMISSION OF THE CITY ENGINEER OF WICHITA. THE CONTRACTOR SHALL BE RESPONSIBLE FOR THE PROTECTION OF ALL EXISTING UTILITIES AND STRUCTURES. NO WORK SHALL BE DONE WITHOUT THE WRITTEN PERMISSION OF THE CITY ENGINEER OF WICHITA.

PRIVATE SANITARY SEWER TO SERVE
LOTS 1, 2 & 3
SHERWOOD INDUSTRIAL PARK IV
PROJECT NO. 468-76-245-8000 F000-000-186
CITY OF WICHITA, KANSAS

BILL H. OTTEN, P.E. OCTOBER 1988
18424 BARTLETT ST.
WICHITA, KANSAS 67212 721-3638

As Built 3-3-87 BHO

PLATE 1-SINGLE PLAN AND PROFILE-FULL LINE
PRINTED IN U.S.A.

FILMED FROM THE BEST
AVAILABLE COPY.....