


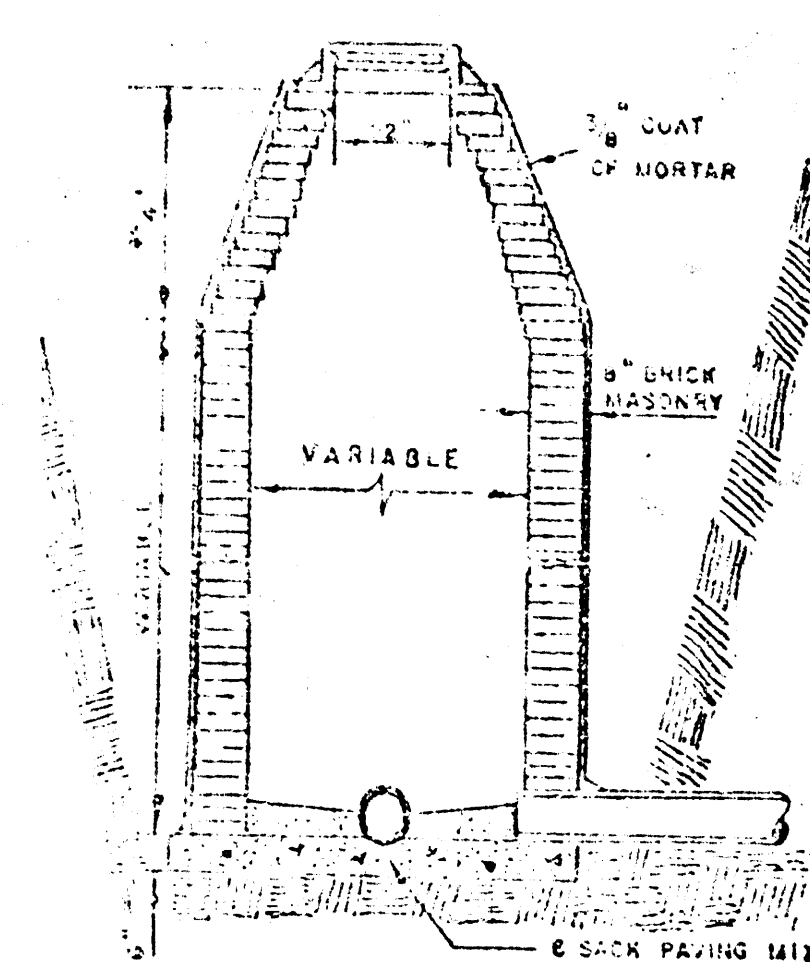


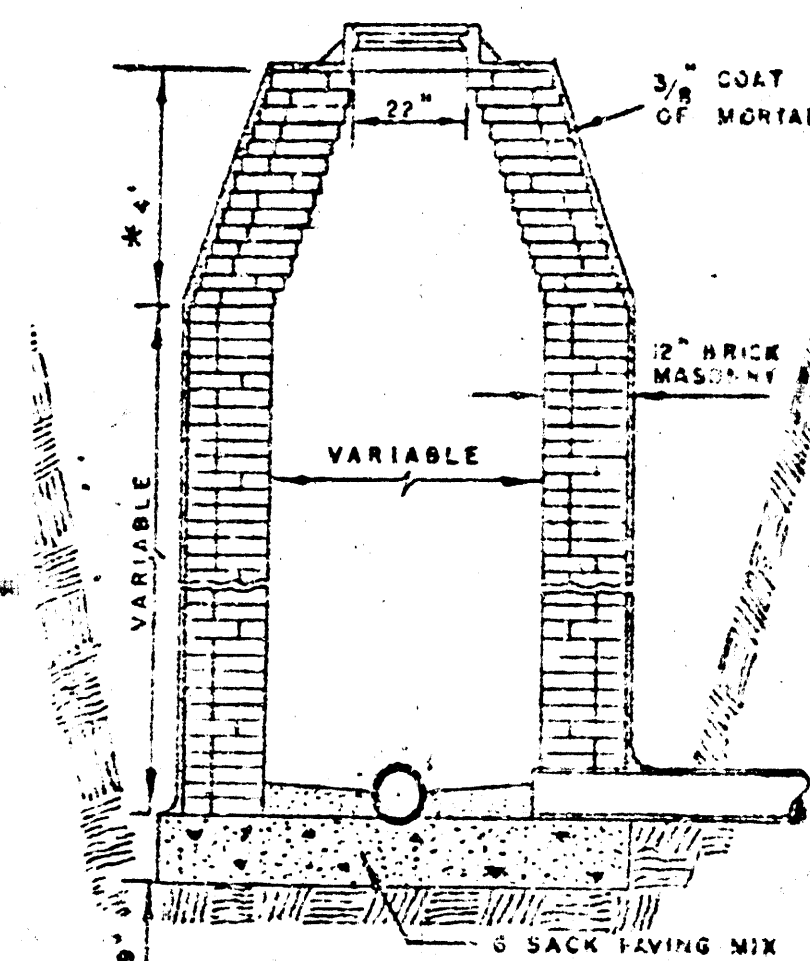


STANDARD MANHOLE
TYPE "A"
* 6" ON 5" DIA. M.H.

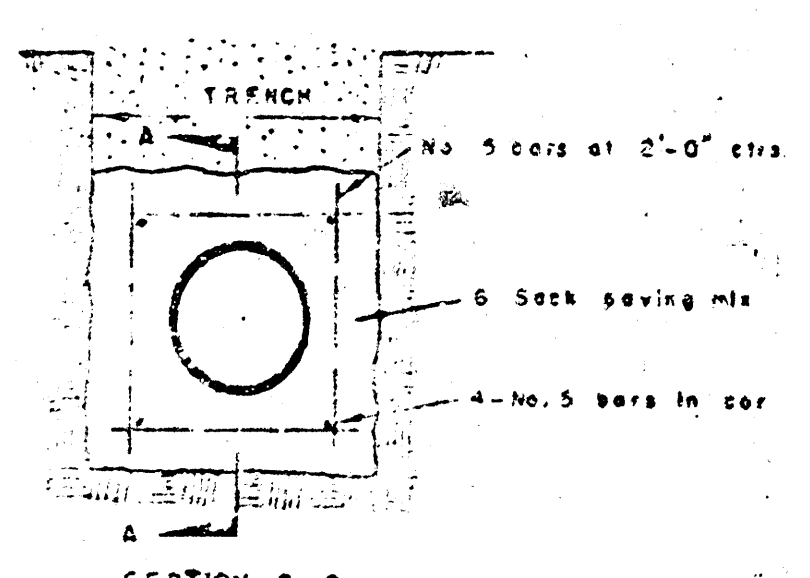

STANDARD MANHOLE
TYPE "B"

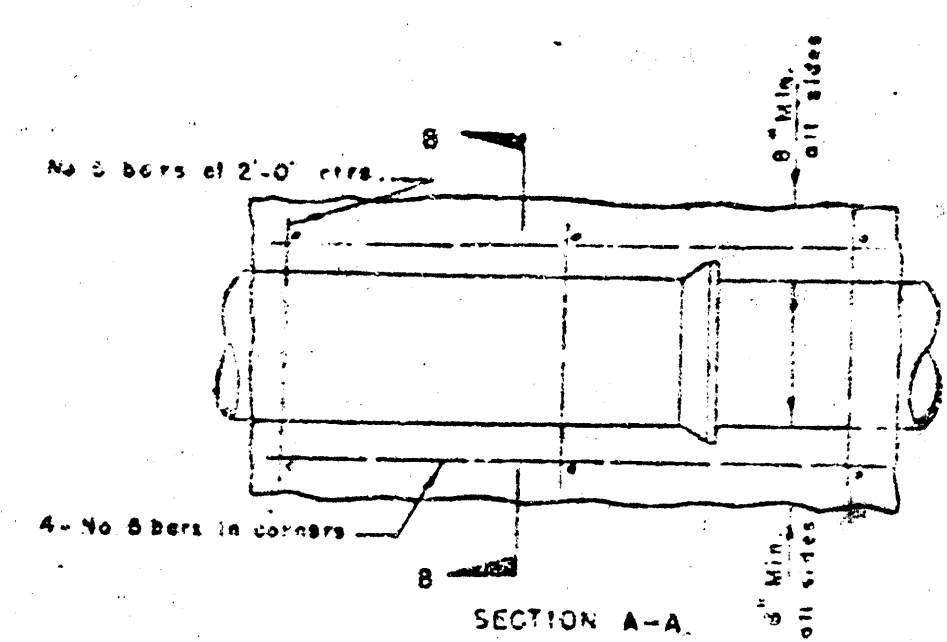

REINFORCED CONCRETE ENCASEMENT

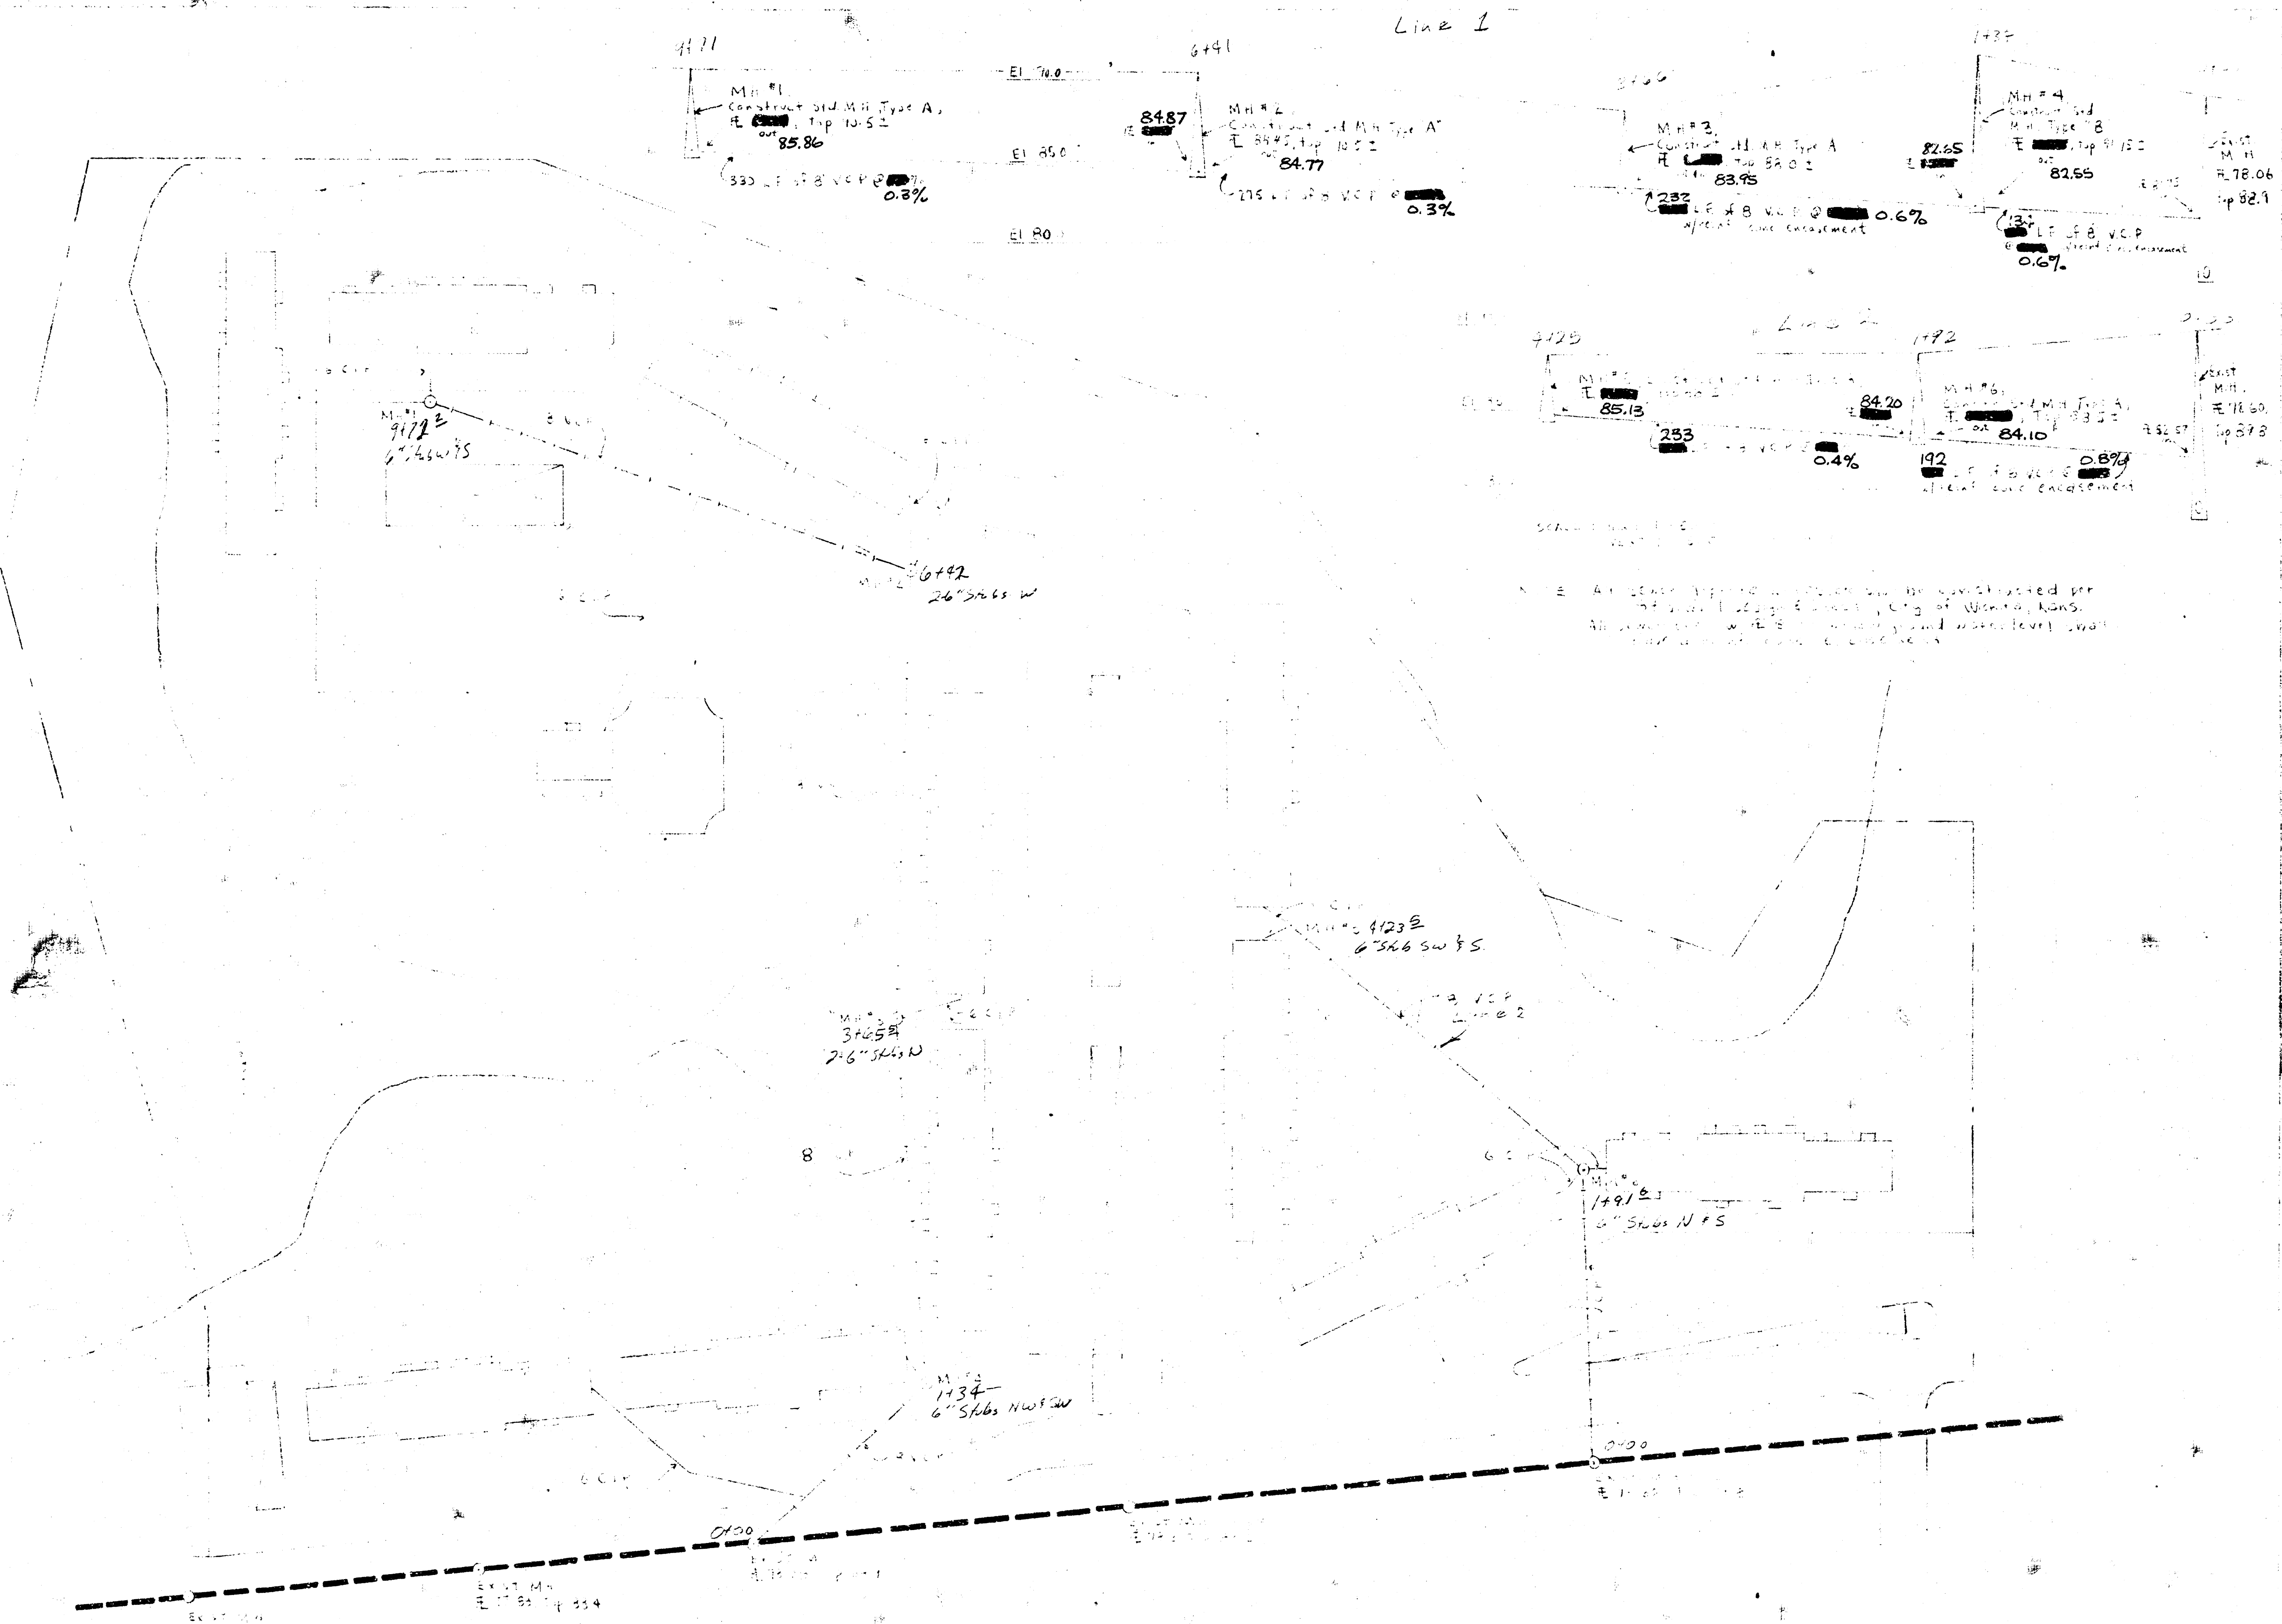

As Built