



APPROVED AS NOTED
 BY CITY ENGINEER OF WICHITA
 Sanitary Sewer Extension
 Date: _____
 Division: _____

NOT TO BE CONSIDERED
 The project shown on this plan was prepared under the supervision of the City Engineer and the City Engineer's Office. The City Engineer's Office is not responsible for the design or construction of the project. The City of Wichita is not responsible for the design or construction of the project.

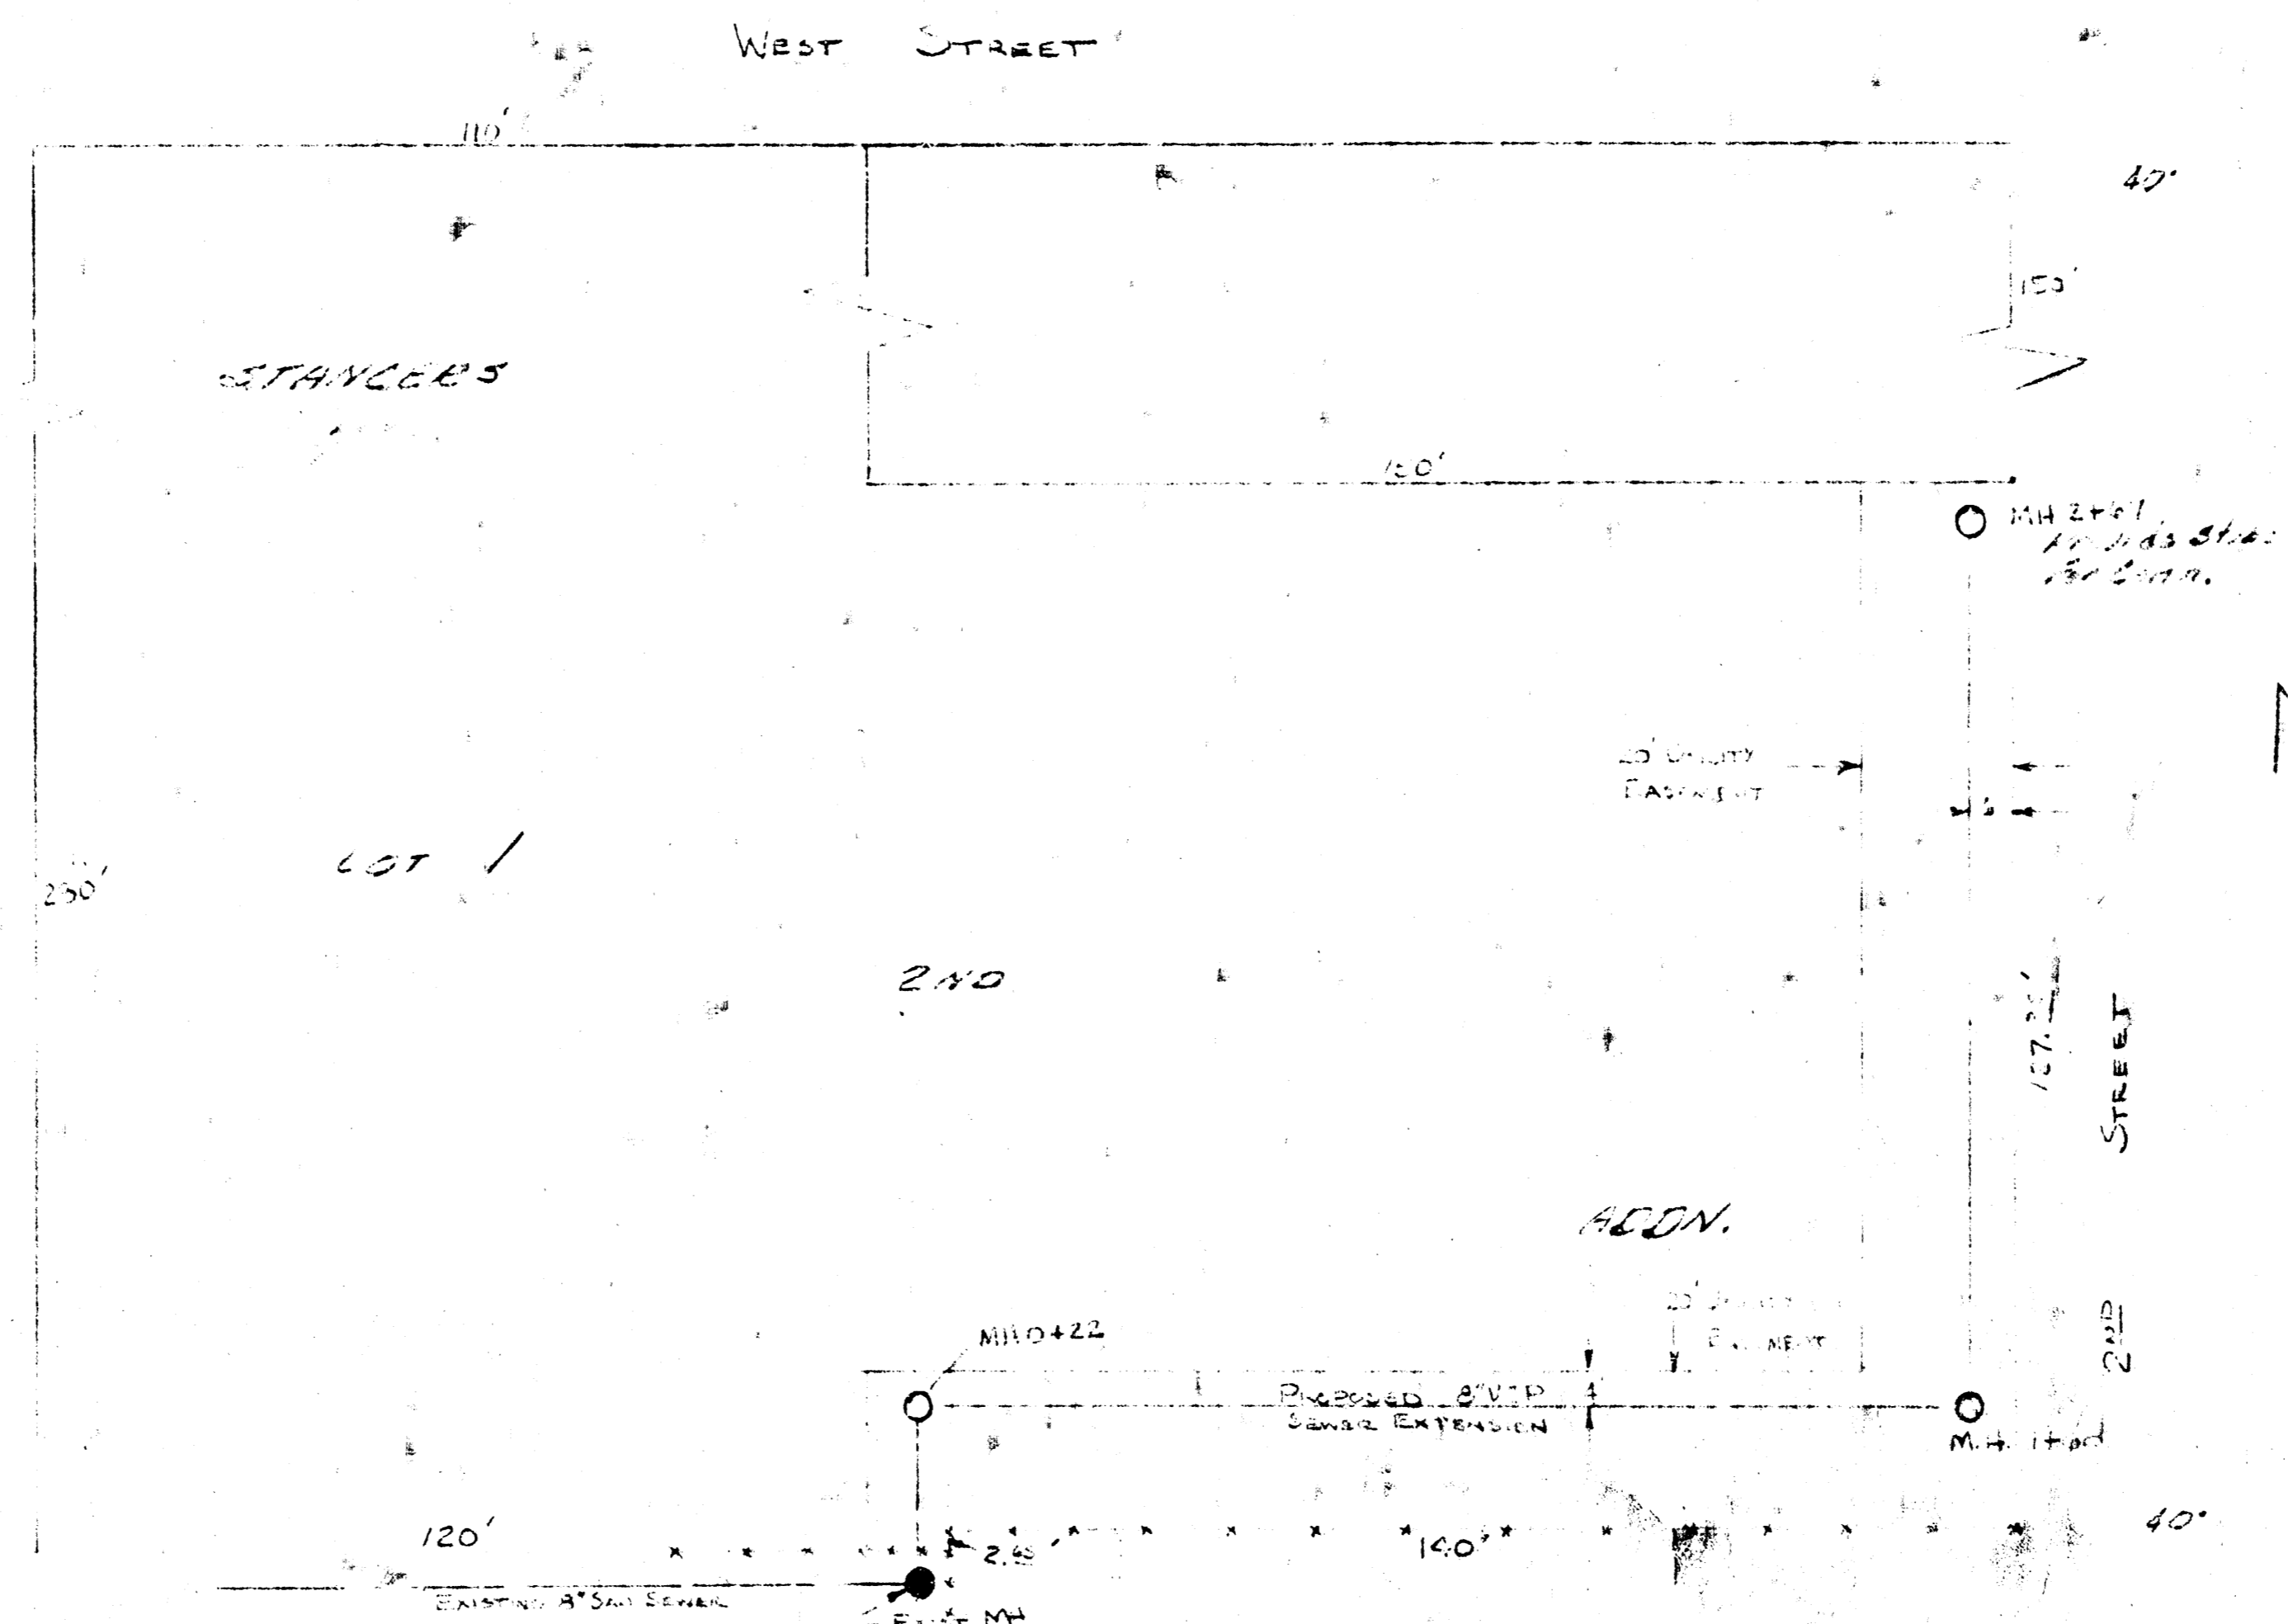

B.M. 120.80 West Rim East. MH 3+1 0+00

PLAN SCALE 1" = 20'
 PROFILE SCALE 1" = 20'
 1" = 4'

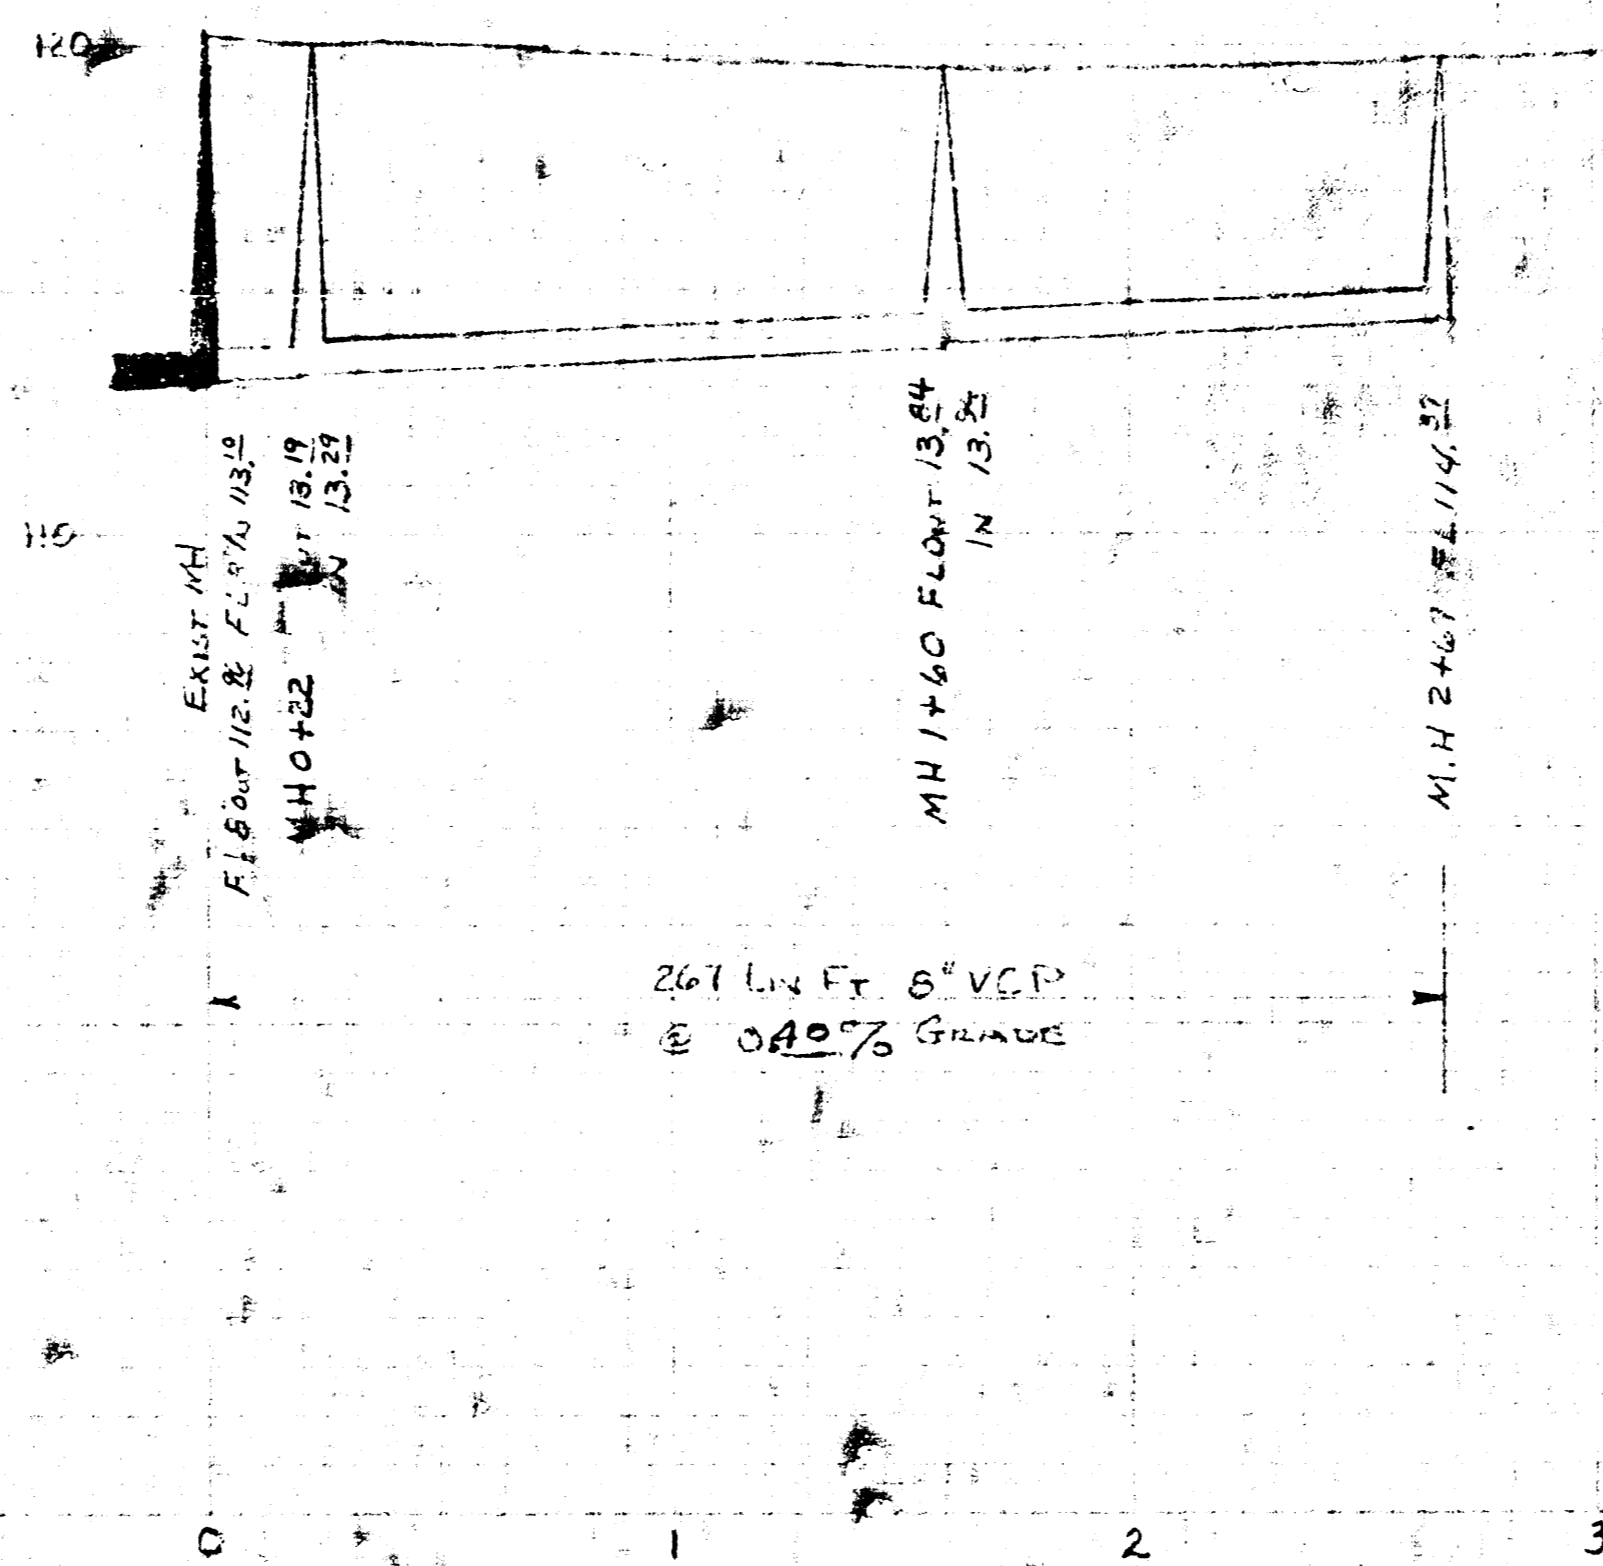

SANITARY SEWER EXT.
 STANCER'S 2ND ADDITION LOT 1
 CITY OF WICHITA, KANSAS
 APRIL-1971 - M.S.C.C.
 PRIVATE PEGS. J.C.L.