

PHASE 2

Private Sanitary Sewer Extension To Serve TOWNE PARC 2ND ADDITION

INDEX CODE 607549

Project No.

468-76-245-80001-000-000-200

City of Wichita, Kansas - Michael E. Lindebak, City Engineer

APPROVED AS NOTED

By CITY ENGINEER OF WICHITA

Sanitary Sewers 2/21/89 *[Signature]*

Storm Sewers _____

Driveway Approaches _____

Water Mains _____




Drainage _____

NOTE TO CONTRACTOR

INSPECTION AND TESTING FOR THIS PROJECT IS TO BE PROVIDED BY A LICENSED CONSULTING ENGINEERING FIRM UNDER CONTRACT WITH THE OWNER/OWNER'S REPRESENTATIVE. INSPECTION TO BE IN ACCORDANCE WITH THE CITY OF WICHITA STANDARD CONSTRUCTION ENGINEERING PRACTICES AND CERTIFIED BY A LICENSED PROFESSIONAL ENGINEER. NO WORK SHALL BE PERFORMED IN DEDICATED EASEMENTS OR THE PUBLIC RIGHT-OF-WAY BY THE CONTRACTOR WITHOUT SUCH INSPECTION AND SHALL ANY WORK BE COMMENCED IN DEDICATED EASEMENTS OR PUBLIC RIGHT-OF-WAY WITHOUT WRITTEN AUTHORIZATION BY THE CITY ENGINEER.

Index to the Plans

Title Sheet	1
Plan & Profile Line 1 & Line 1A	2
Plan & Profile Line 1 & Line 1B	3
Plan & Profile Line 2 & Line 3	4
Plan & Profile Line 4	5
Vertical Riser Detail	6

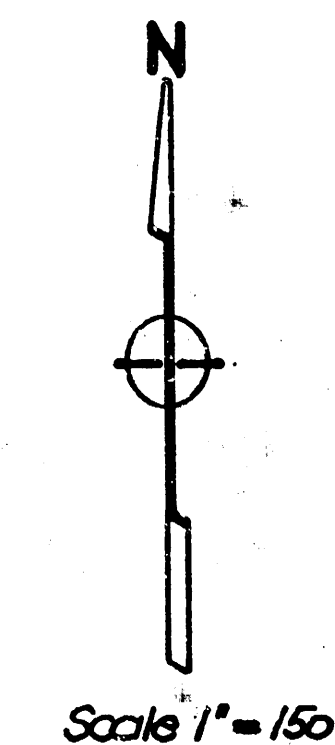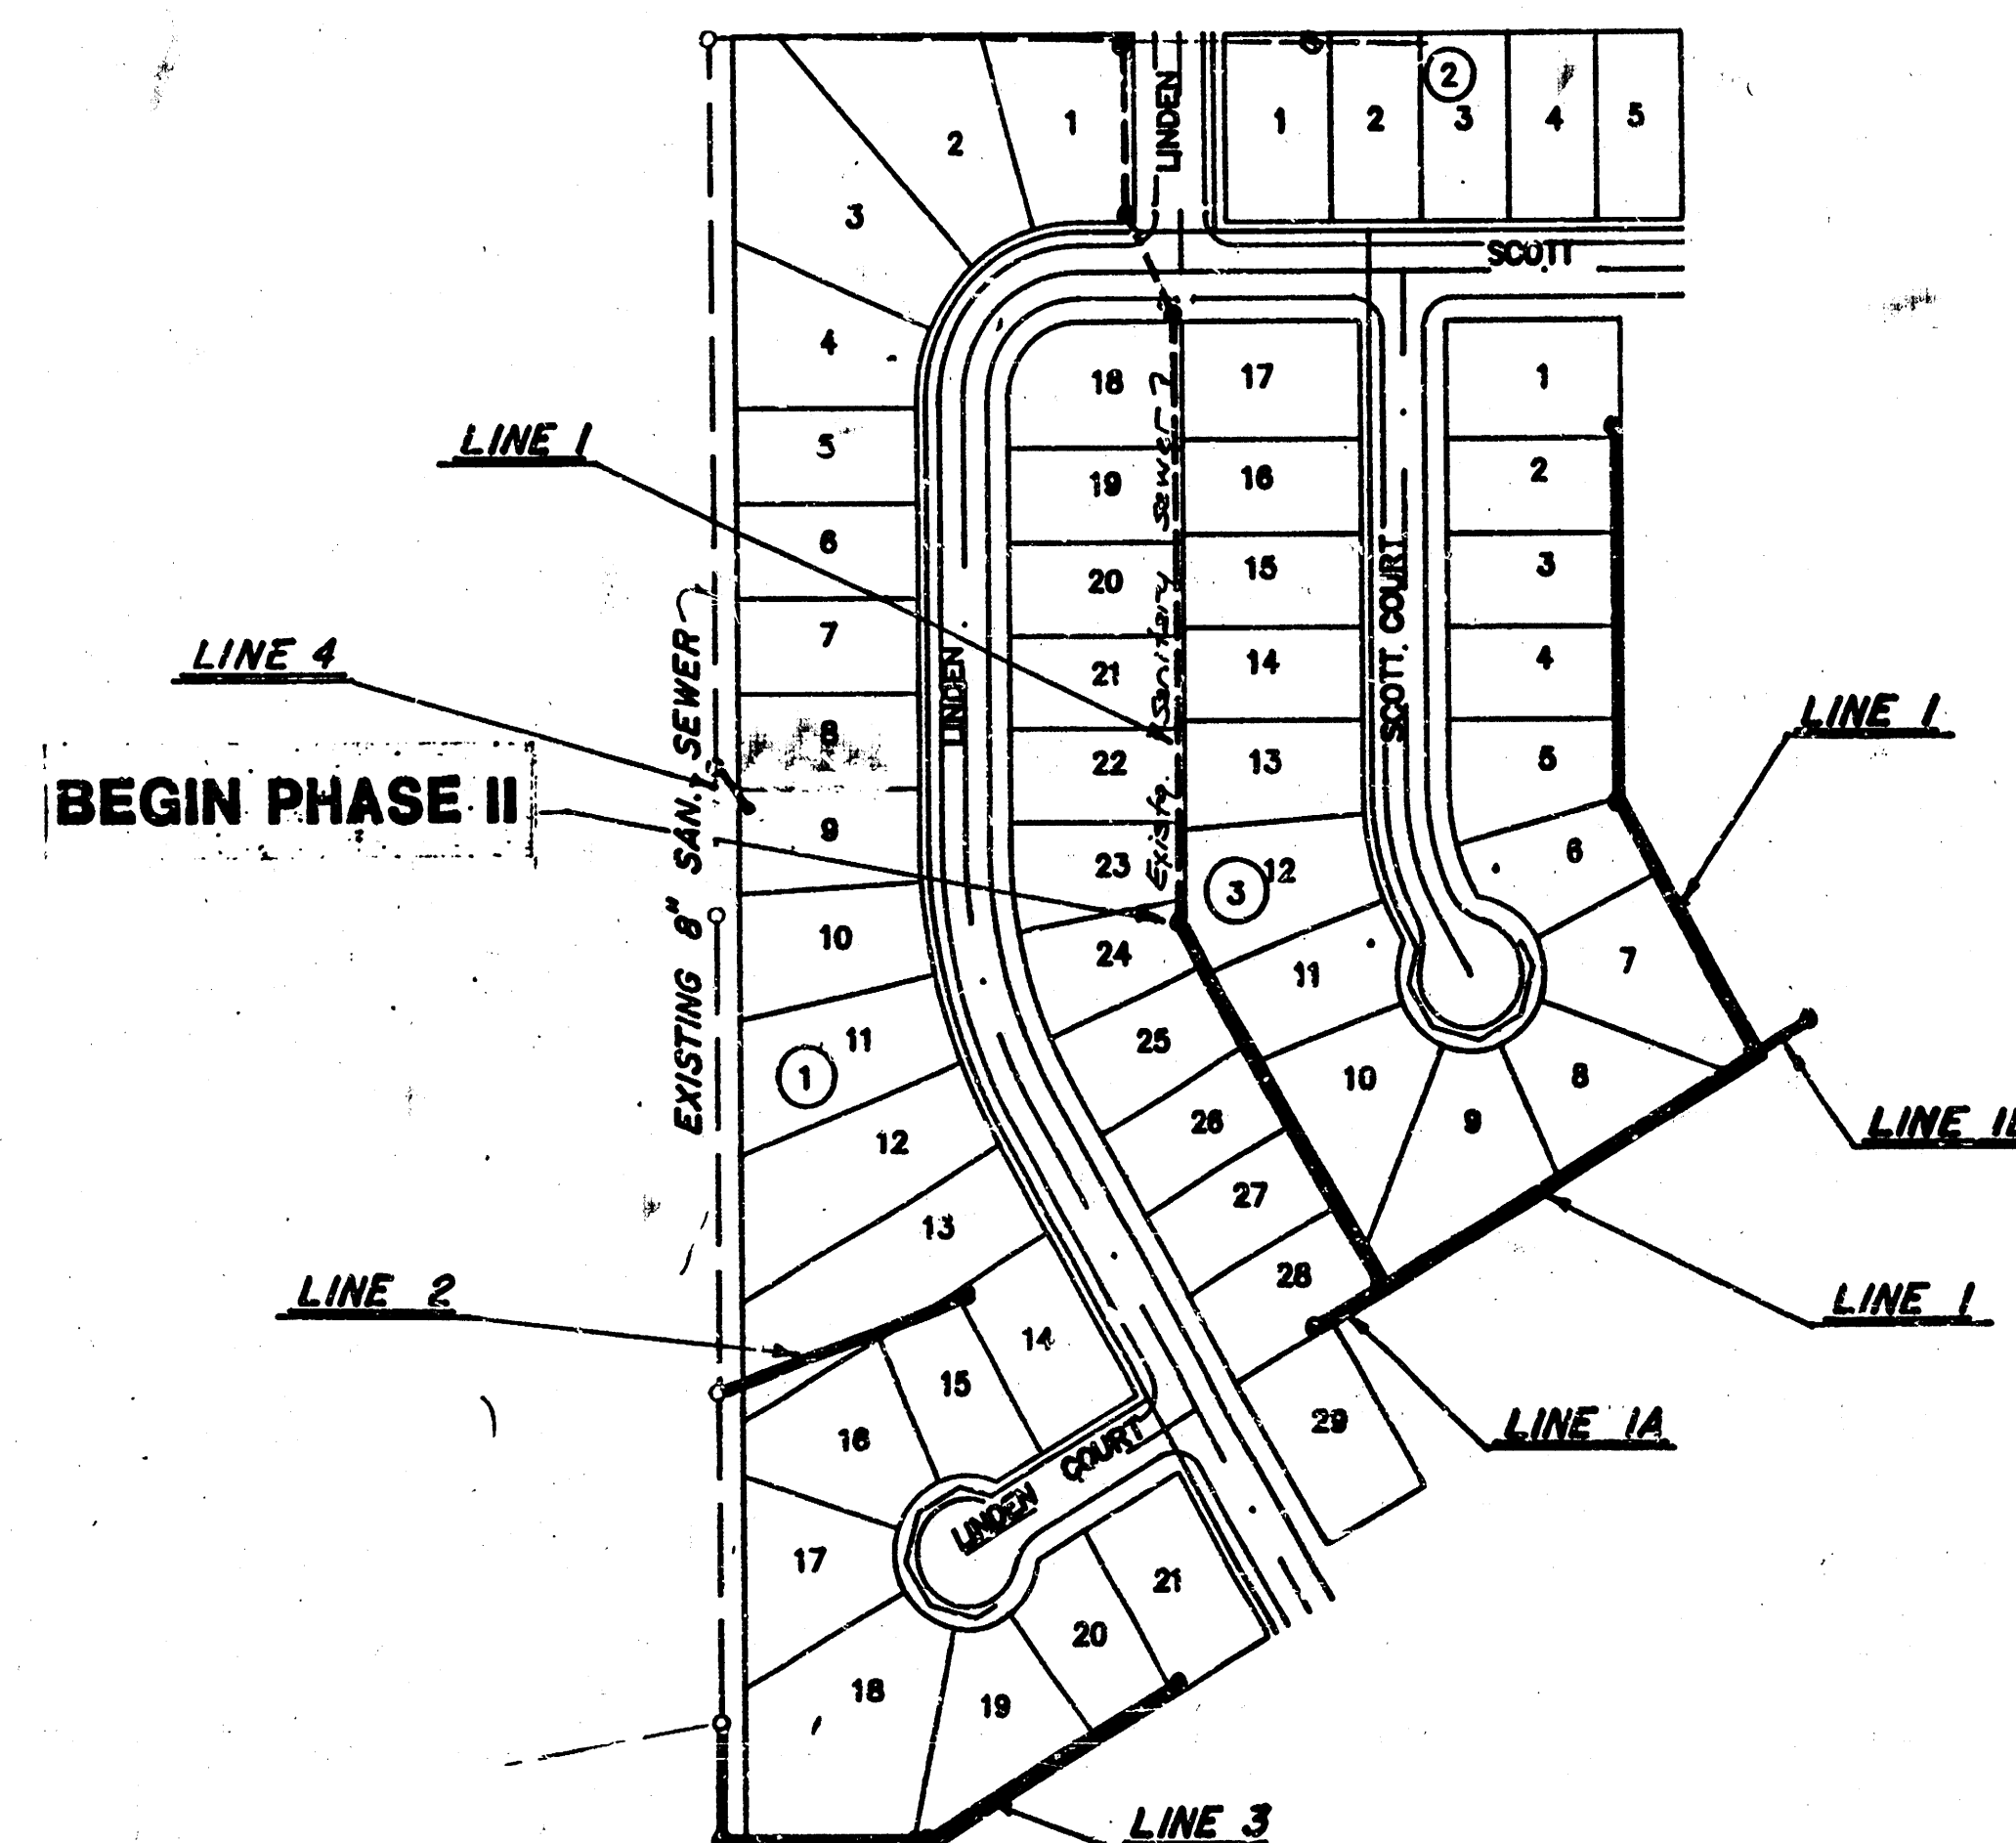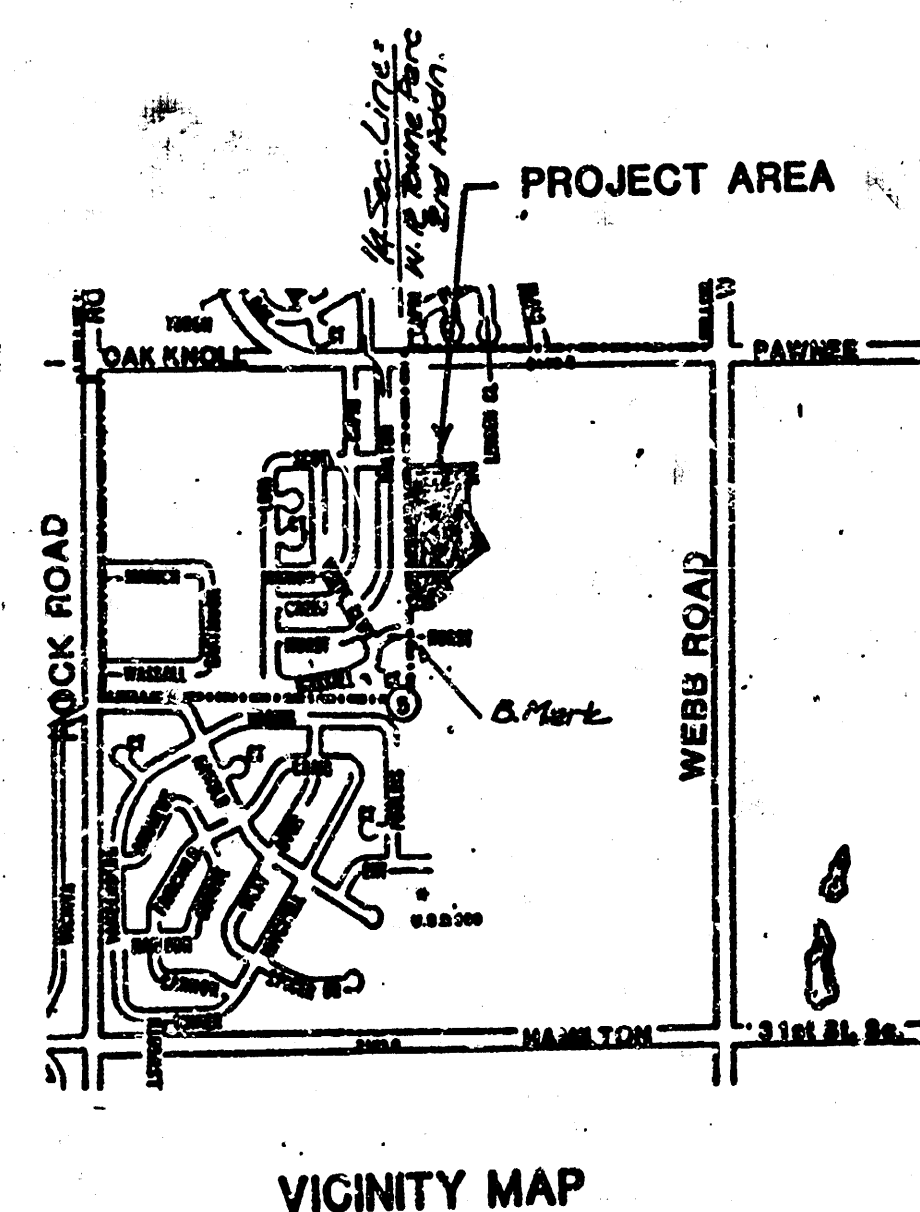

General Notes

- Underground utility services lines and overhead utility pole lines are to be adjusted as necessary by others prior to construction unless the plans specifically call for their adjustment by the Contractor or unless the plans specifically identify a utility to be adjusted by its owner during construction. Existing utilities and their location, as shown on the plans, represent the best information obtainable for design. The Contractor will be required to work around existing utilities within the right-of-way which do not conflict with proposed construction.
- The Contractor shall be responsible for preserving property irons. The Contractor will be required to re-establish any property irons which are damaged or destroyed by his construction operations. Such irons shall be re-established by a licensed land surveyor in accordance with state laws.





Rev. As-built 4-14-89 TCR
Rev. Add Line 4; 3/14/89 CS

BAUGHMAN COMPANY P. A.
SURVEYING & ENGINEERING
316/282-7271 • 315 ELLIS • WICHITA, KANSAS 67211



FILMED FROM THE BEST
AVAILABLE COPY

Bench Mark 1: 'd' Cut Top of Curb G8' ± W. of 1/4
Section Line, S. side of Hurst.
Elevation 211.22 City Datum

Bench Mark 2: 'd' Cut Top of Curb on the S. side
of Carson and W. R/W. of Udden.
Elevation 201.71 City Datum

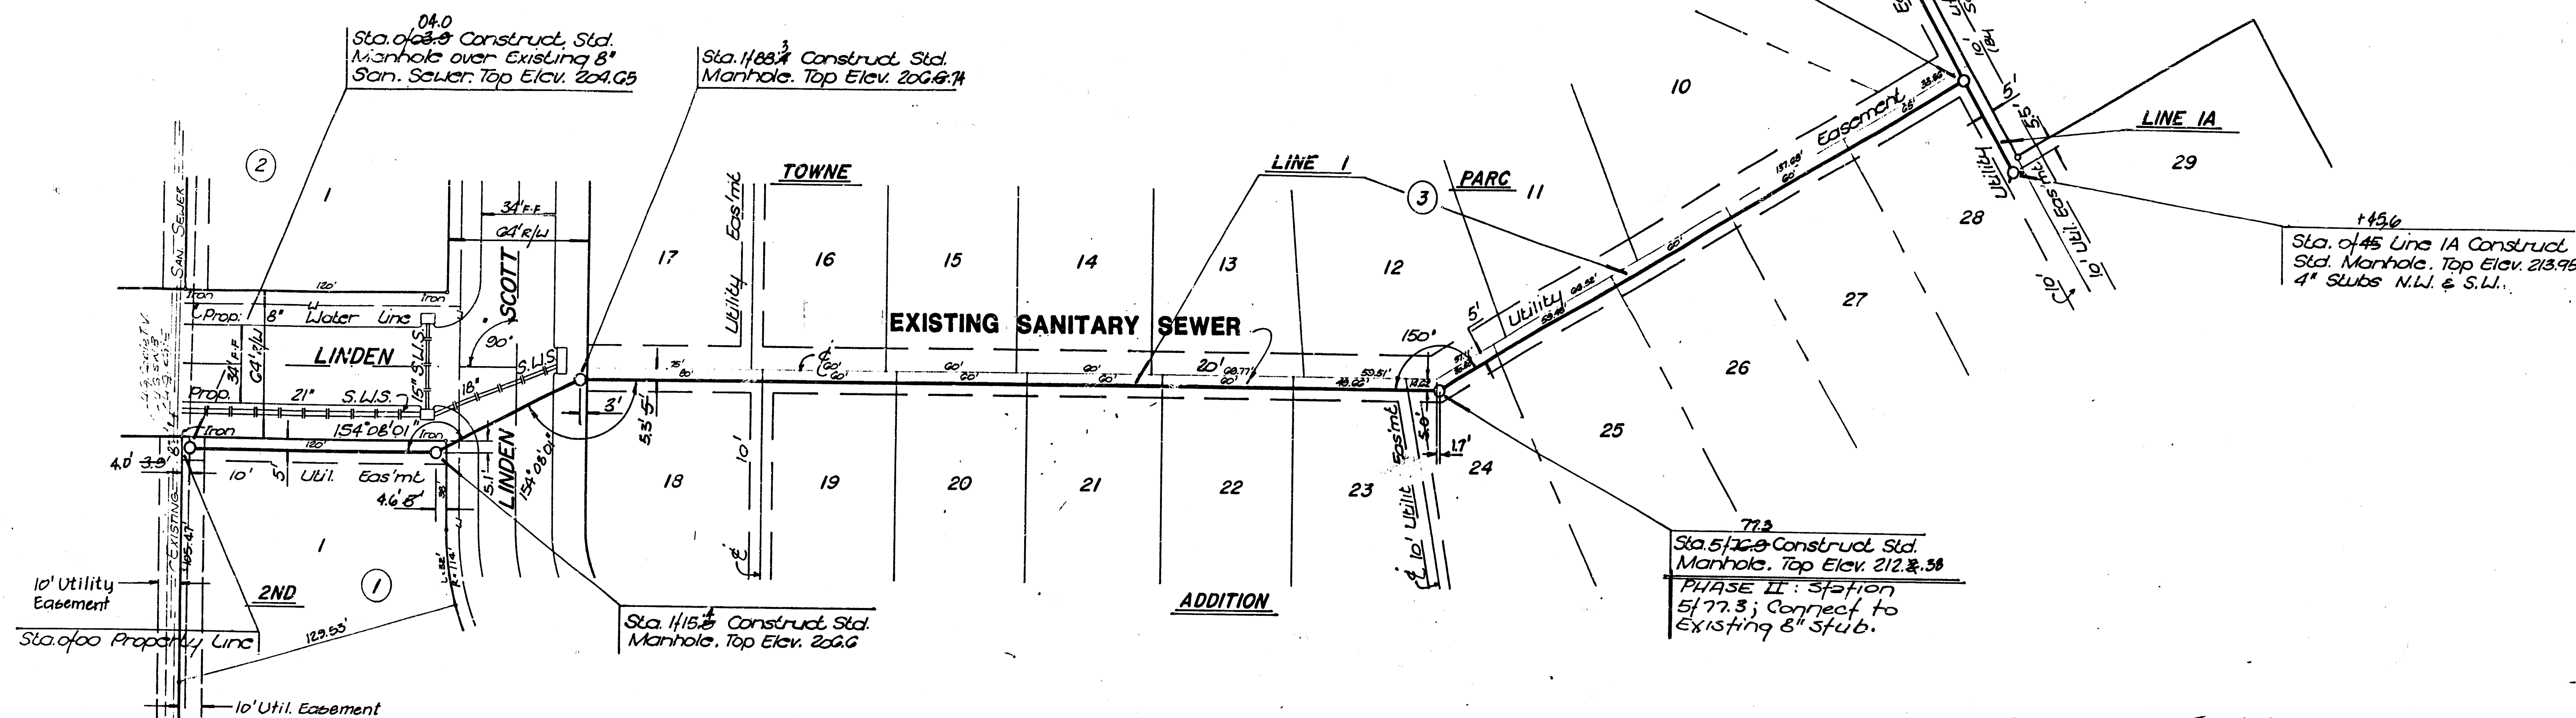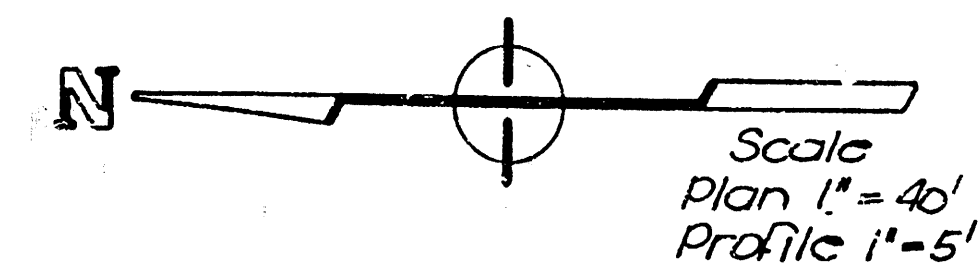

ALL MANHOLES ARE Type 'P'

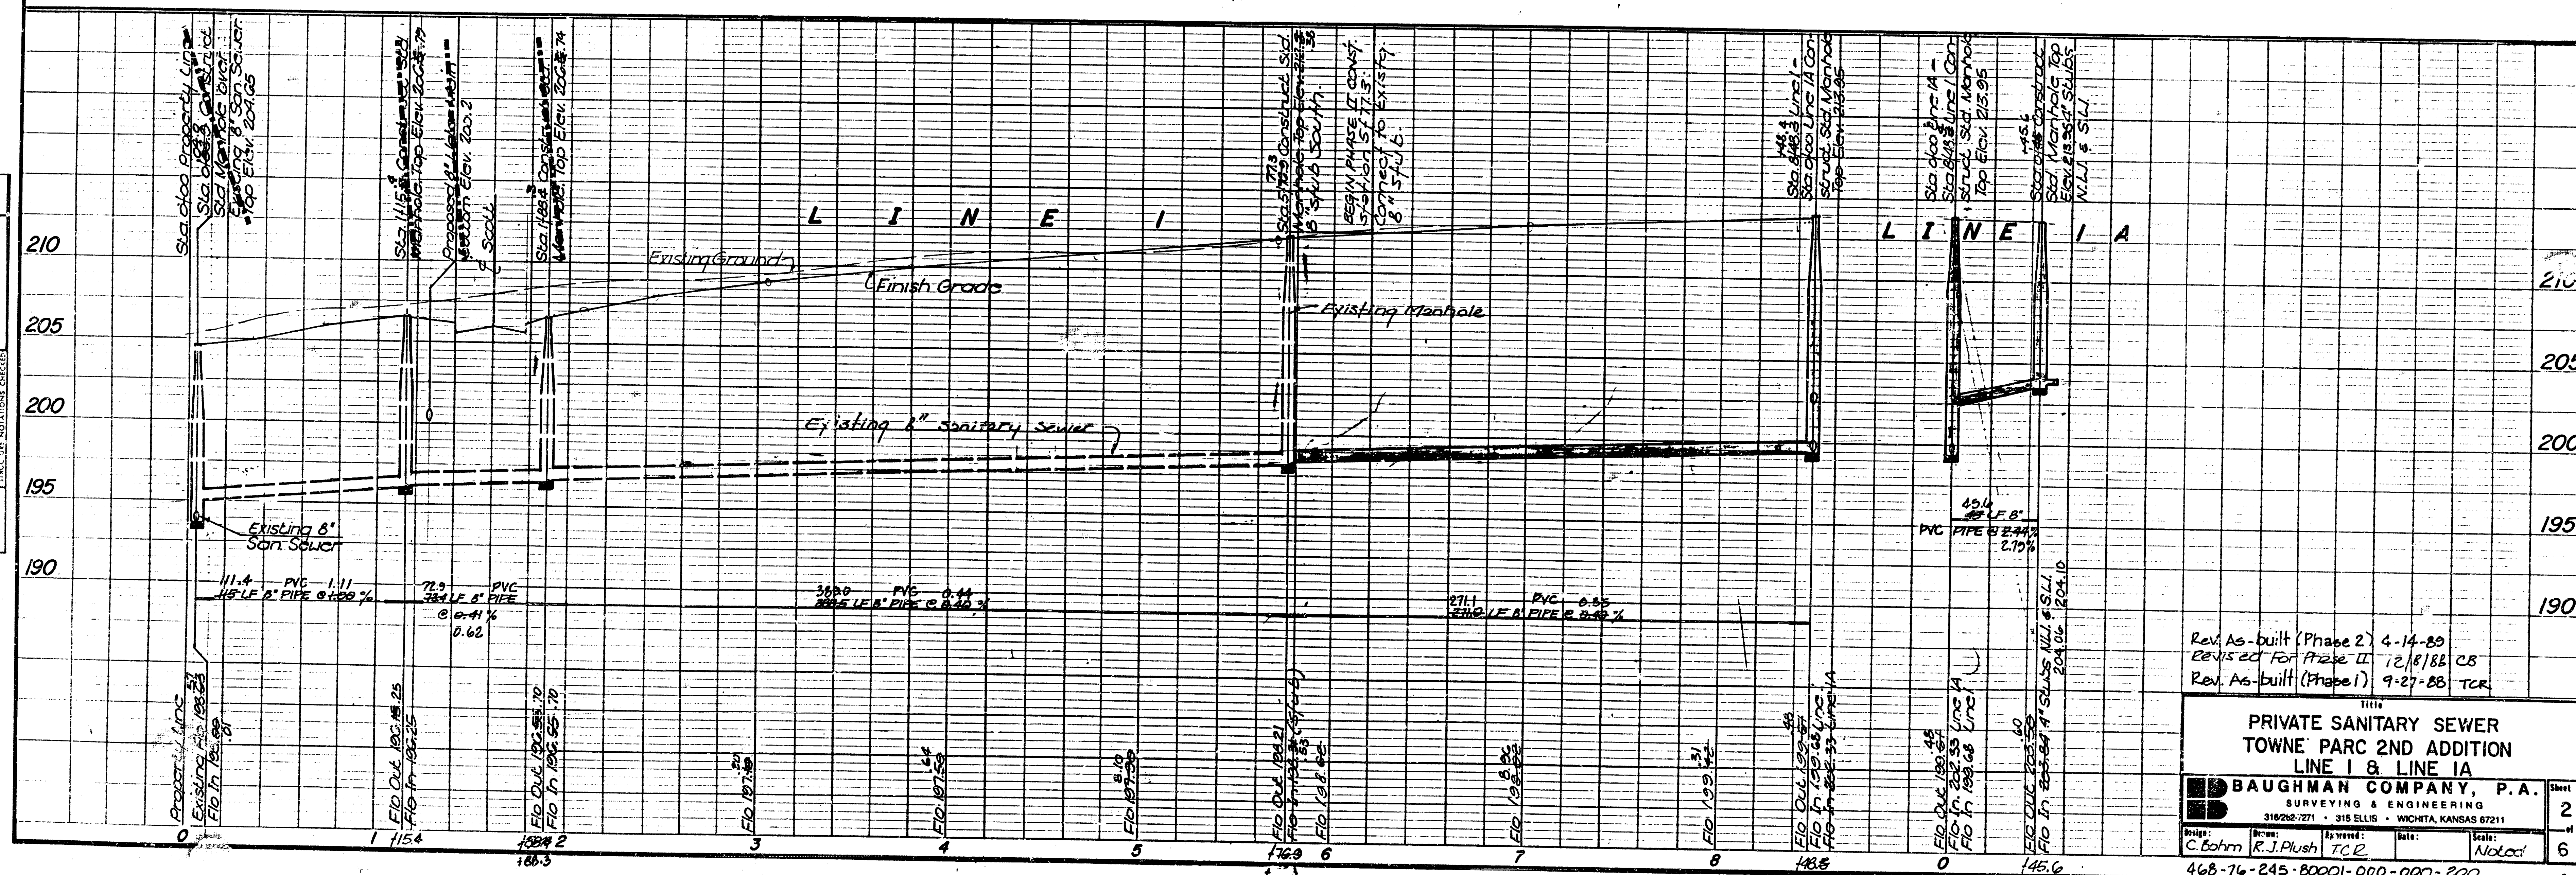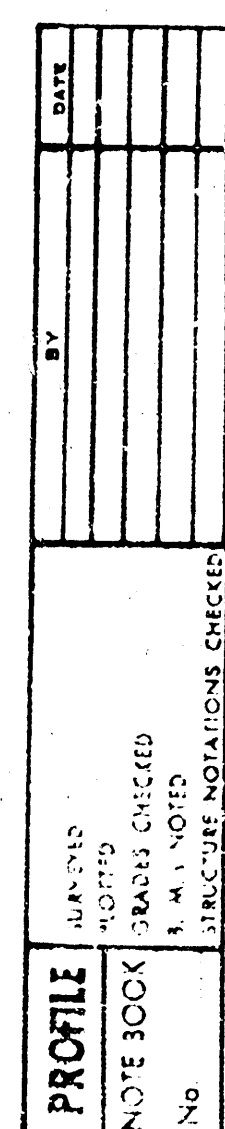

Rev. As-built (Phase 2)	4-14-89	
Revised For Phase II	12/8/88	CB
Rev. As-built (Phase I)	9-27-88	TCR

PRIVATE SANITARY SEWER
TOWNE PARC 2ND ADDITION
LINE 1 & LINE 1A

LINE 1 & LINE 1A

BAUGHMAN COMPANY, P.A.
SURVEYING & ENGINEERING
316/262-7271 • 315 ELLIS • WICHITA, KANSAS 67211

Design:	Drawn:	Approved:	Date:	Scale:
C. Bohm	R.J. Plush	T.C.R.		Noted

468-76-245-80001-000-000-220




FILMED FROM THE BEST
AVAILABLE COPY.....

BENCHMARKS

Bench Mark 1: 1" d. Cut Top of Curb 68' ± W. of 1/4 Section Line, S. side of Hurst. Elevation 211.22 City Datum

Bench Mark 2: 1" d. Cut Top of Curb on the S. side of Carson and W. R/W of Linden. Elevation 201.71 City Datum

CAUTION: U.S.G.S. Witness Marker: DO NOT DISTURB! Keep Away from Marker.

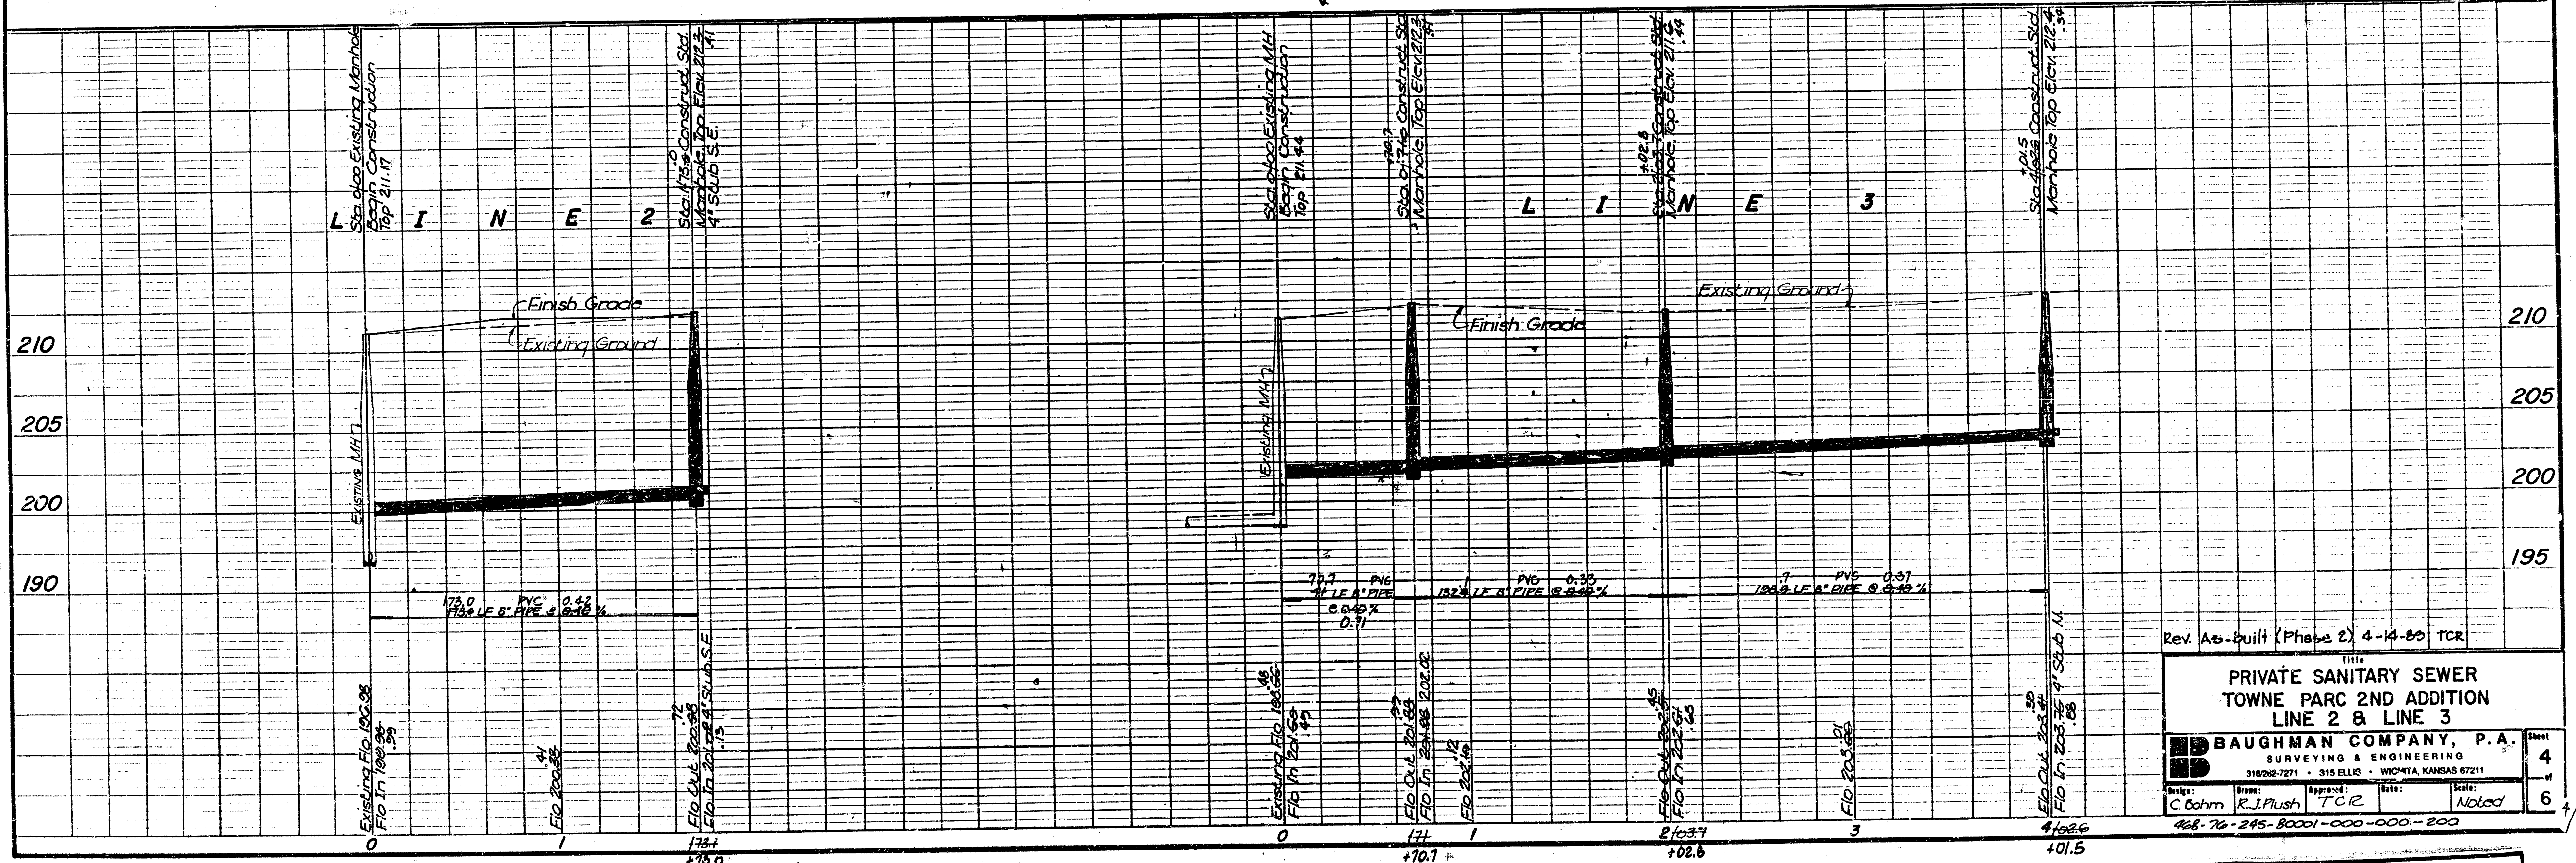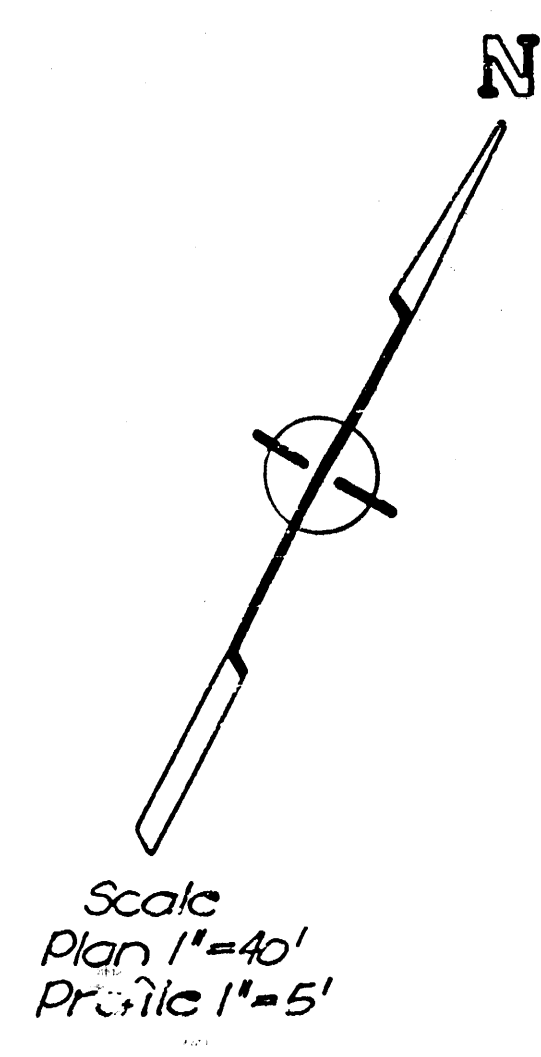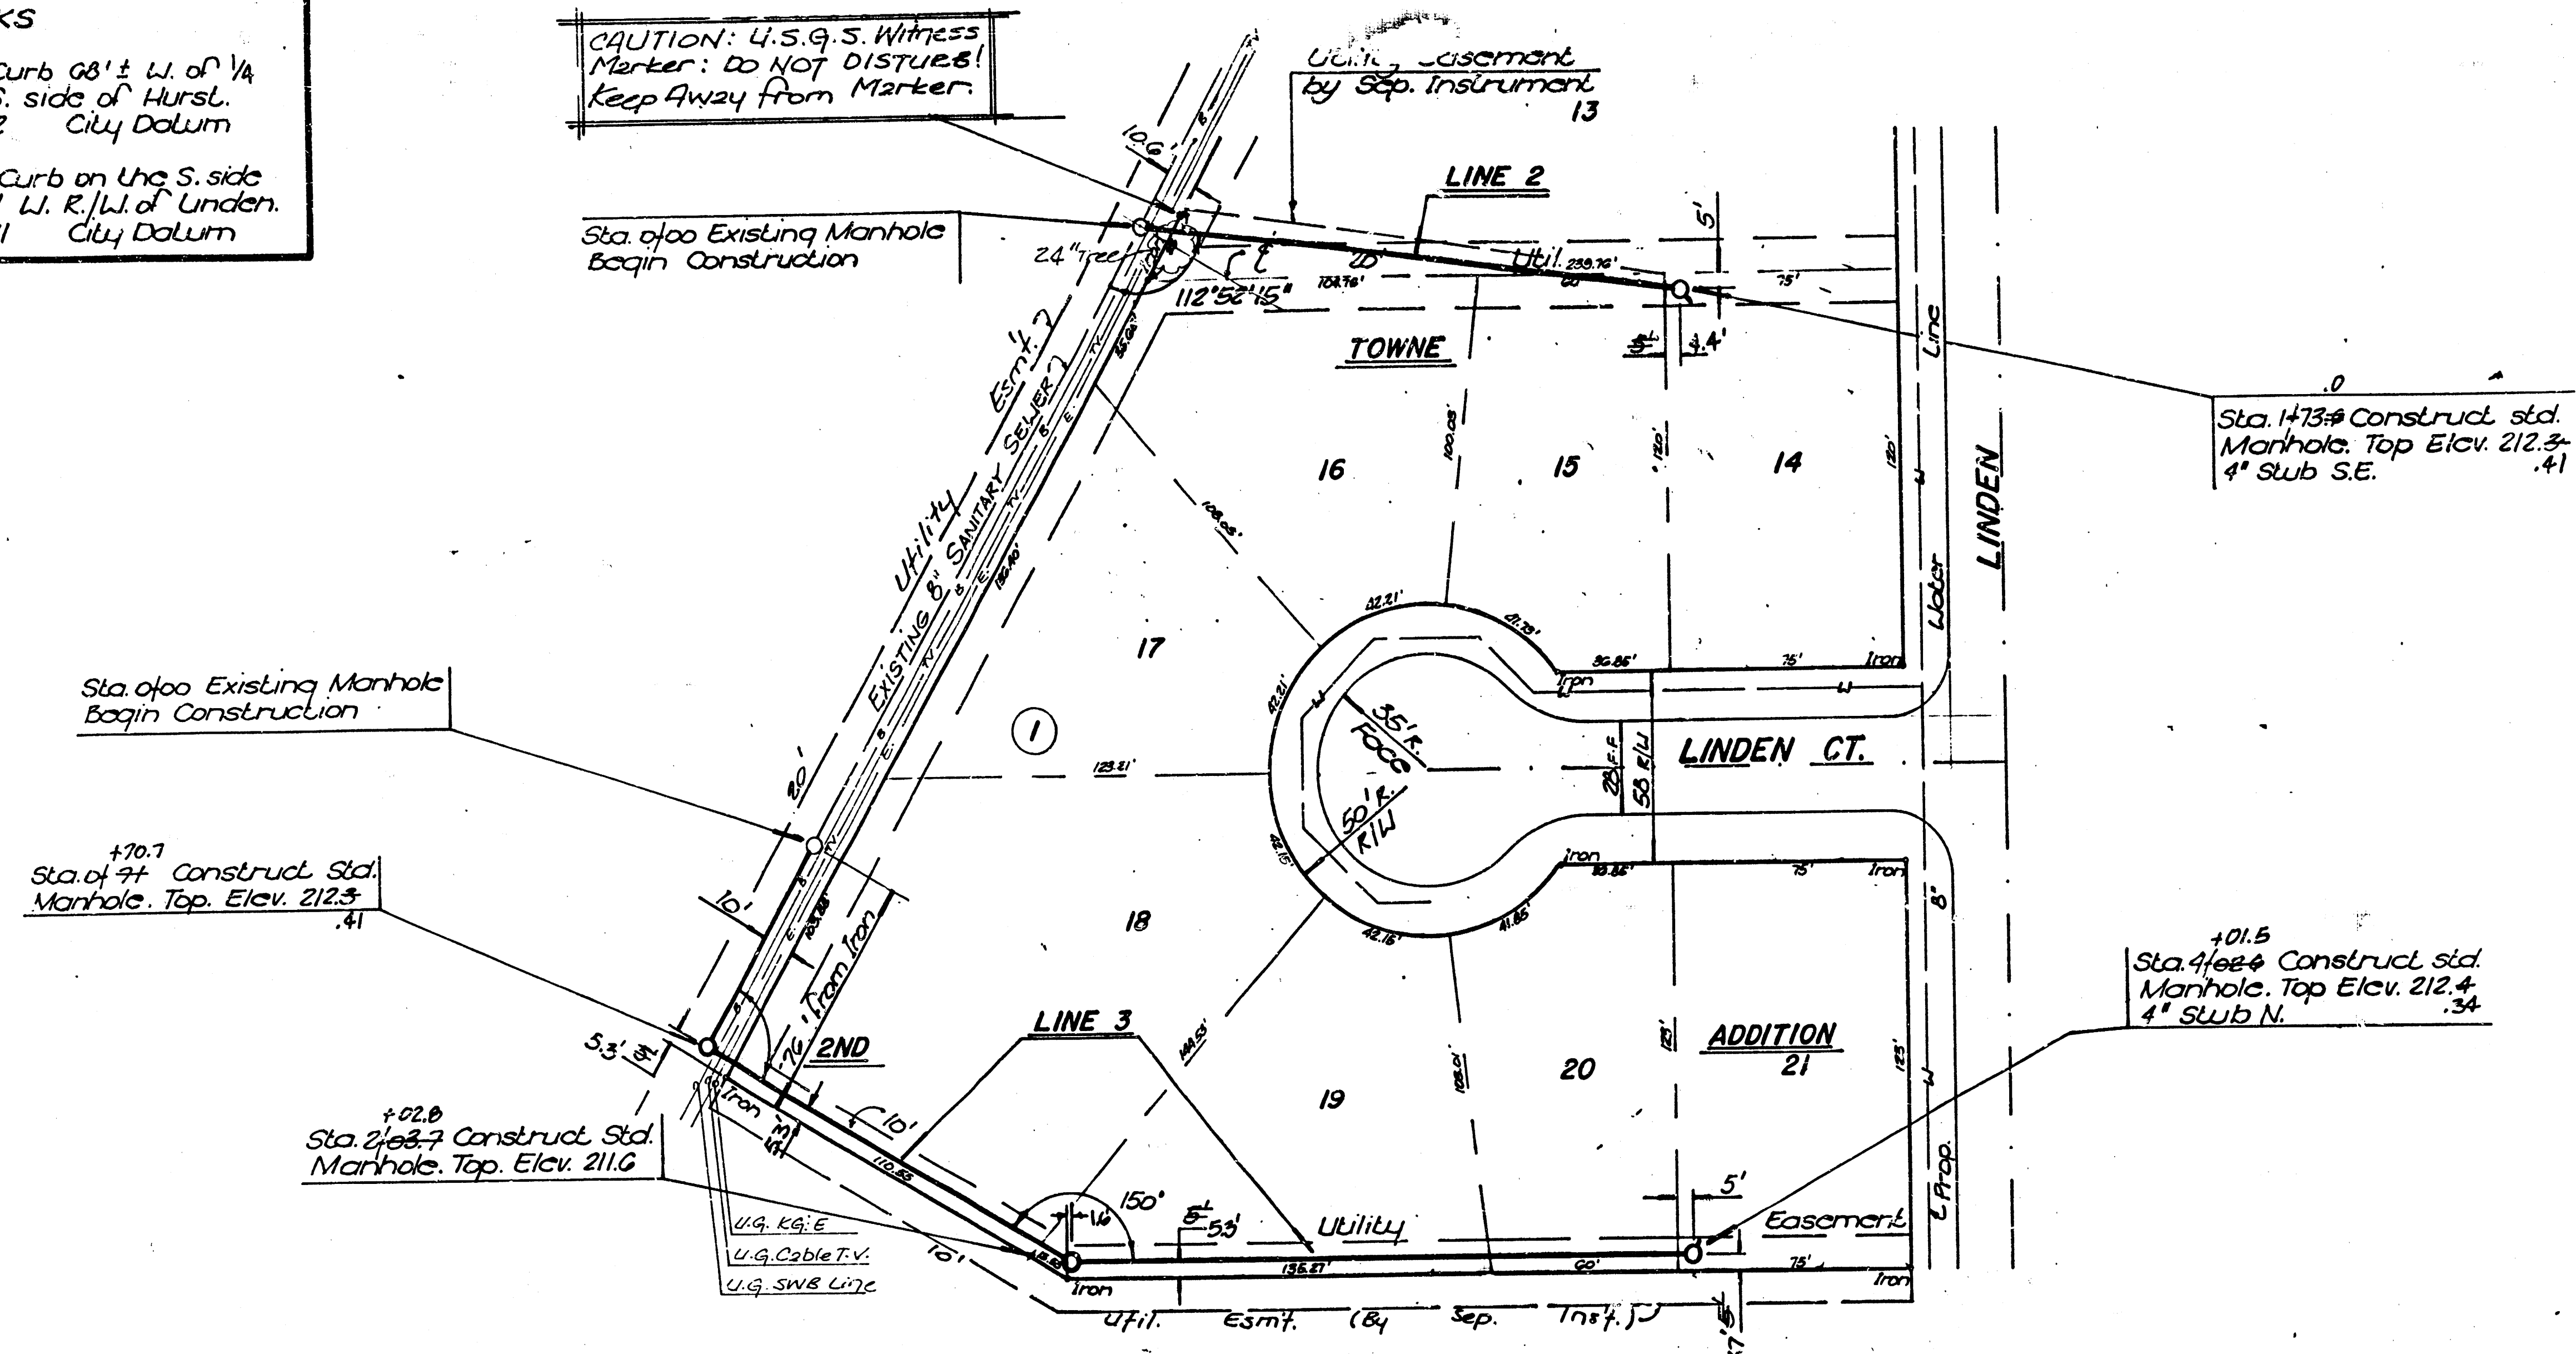

Rev. As-built (Phase 2) 4-14-85 TCR

**PRIVATE SANITARY SEWER
TOWNE PARC 2ND ADDITION
LINE 2 & LINE 3**

BAUGHMAN COMPANY, P.A.
SURVEYING & ENGINEERING
3102-202-7271 • 315 ELLIS • WICHITA, KANSAS 67211

Drawn: C. Bohm R.J. Plush TCR Date: Noted

**FILMED FROM THE BEST
AVAILABLE COPY.....**

BENCHMARKS

Bench Mark 1: 1'0" Cut Top of Curb 68'± W. of 1/4 Section Line, S. side of Hurst. Elevation 211.22 City Datum

Bench Mark 2: 1'0" Cut Top of Curb on the S. side of Carson and W. R./W. of Under. Elevation 201.71 City Datum

PLAN


DATE: _____

BY: _____

REVIEWED: _____


NOTED: _____

NO. _____

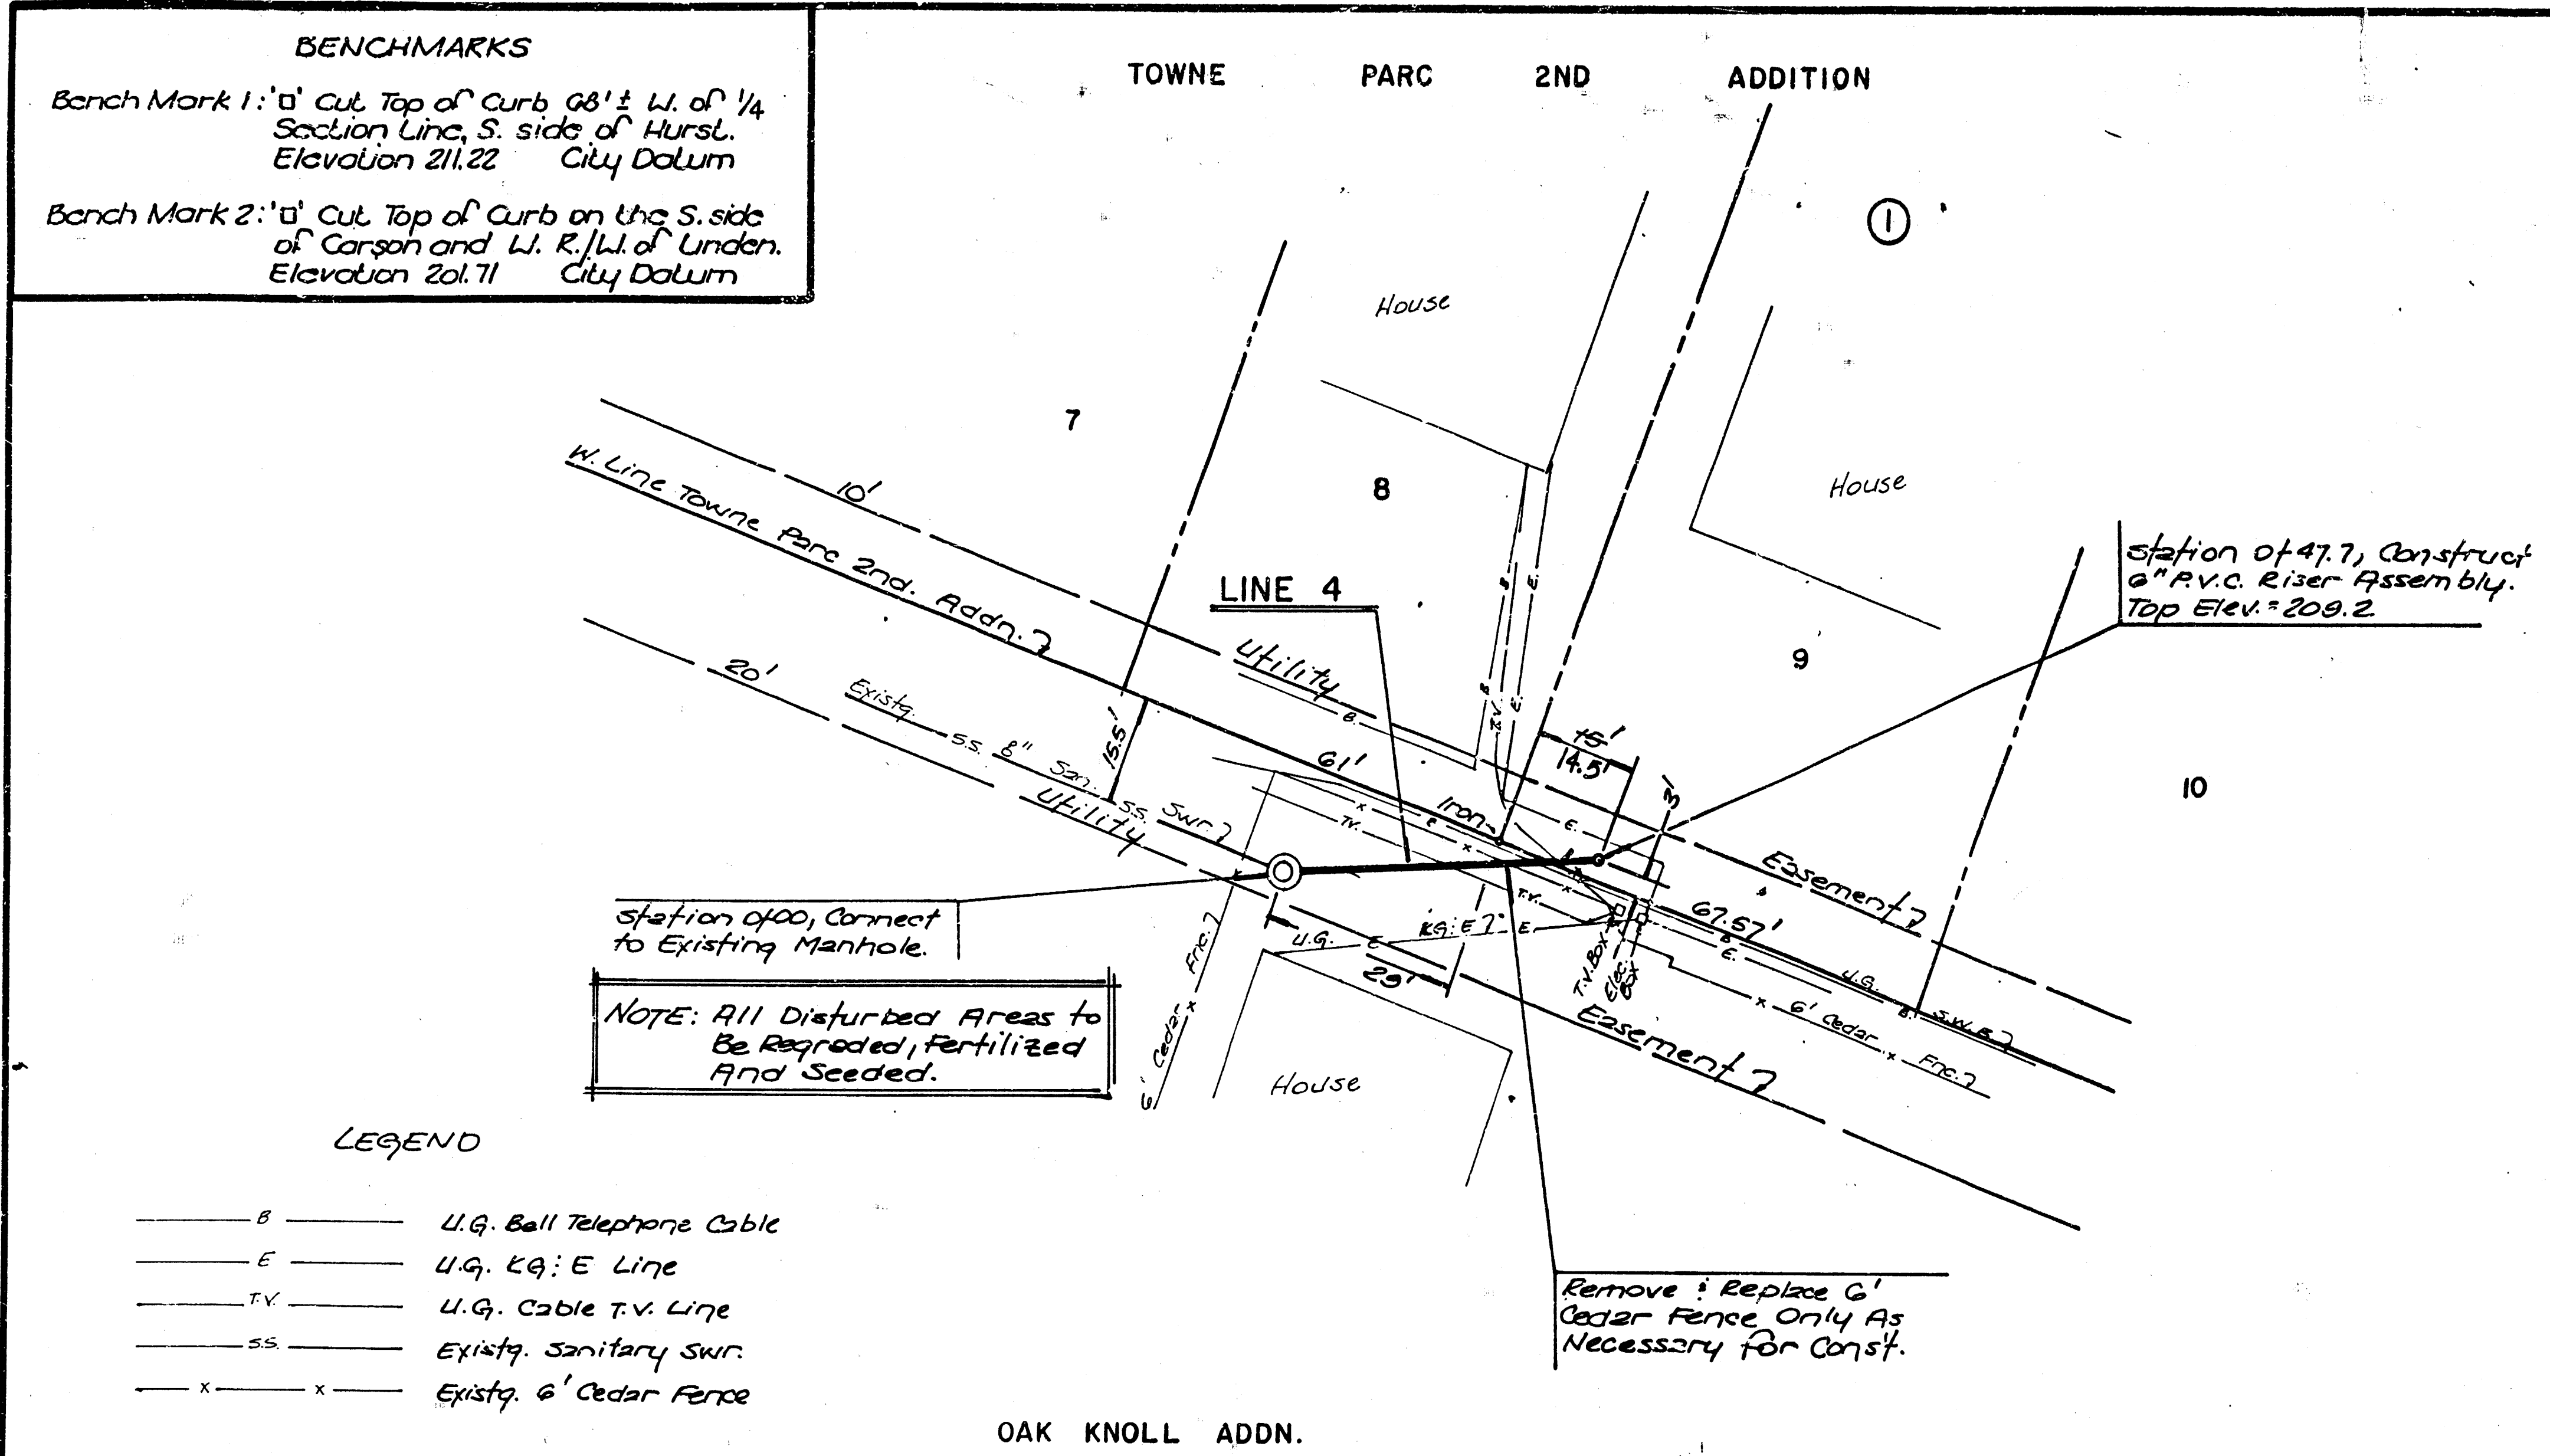

N

Scale: 1" = 20' Plan
1" = 5' Profile

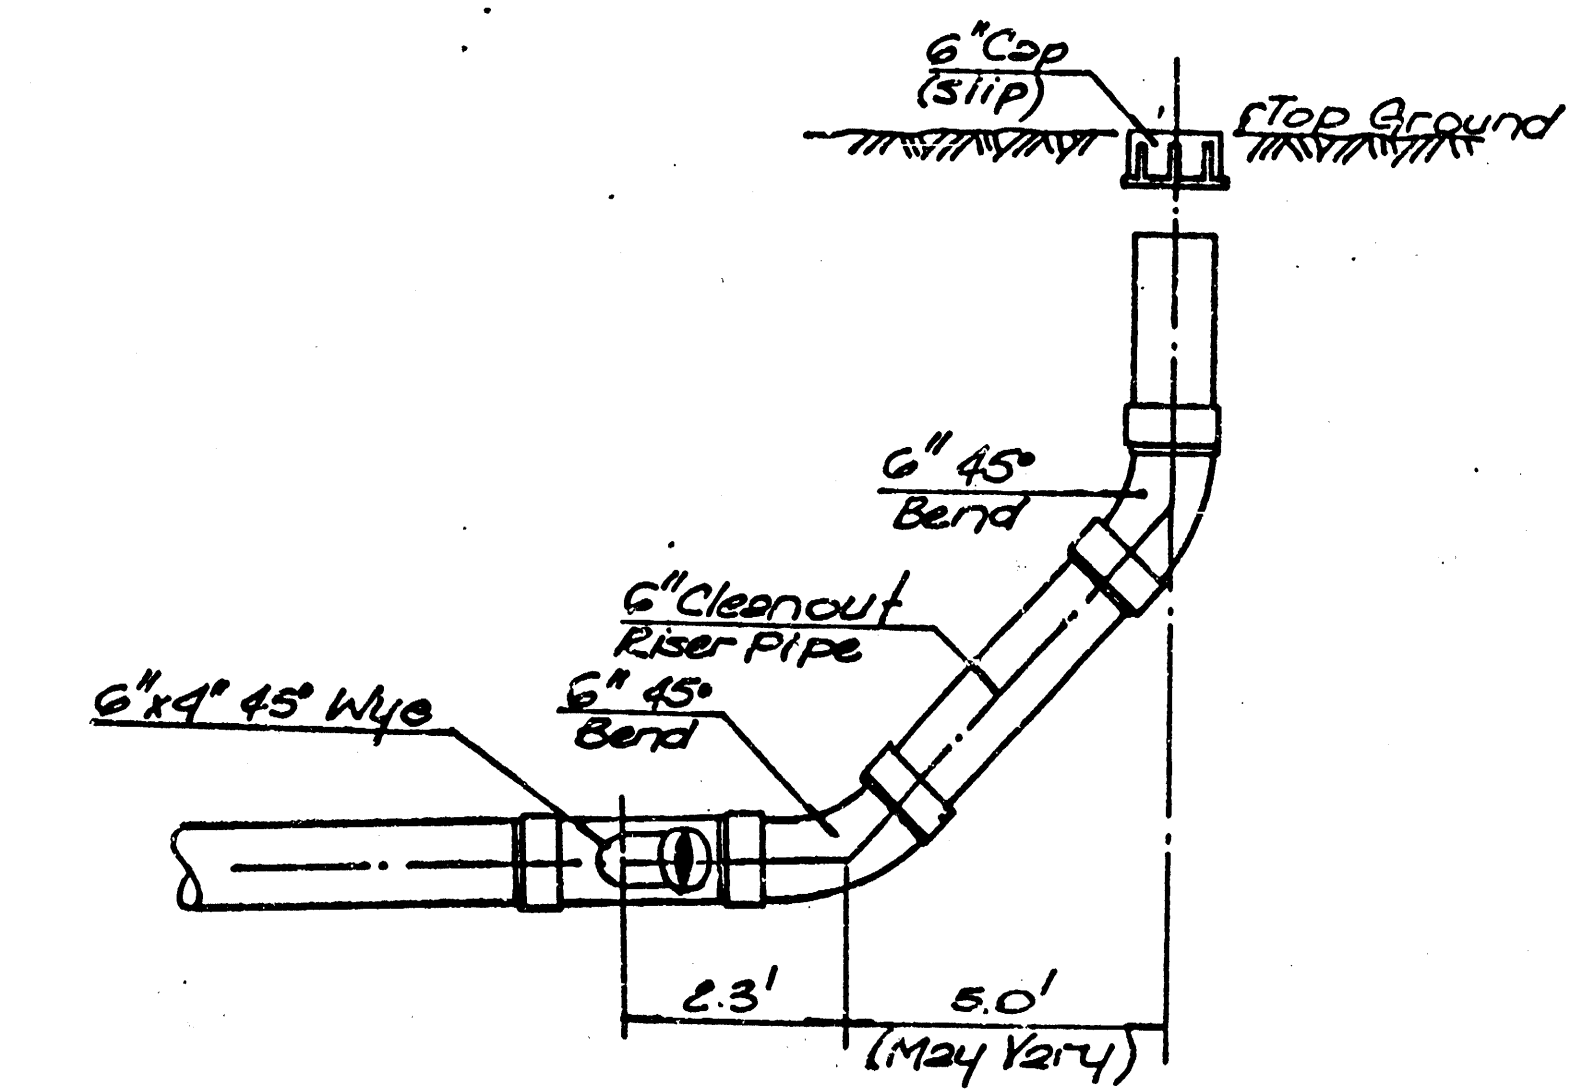

6" P.V.C. RISER CLEANOUT DETAIL

PROFILE


DATE: _____

BY: _____

REVIEWED: _____

NOTED: _____

NO. _____

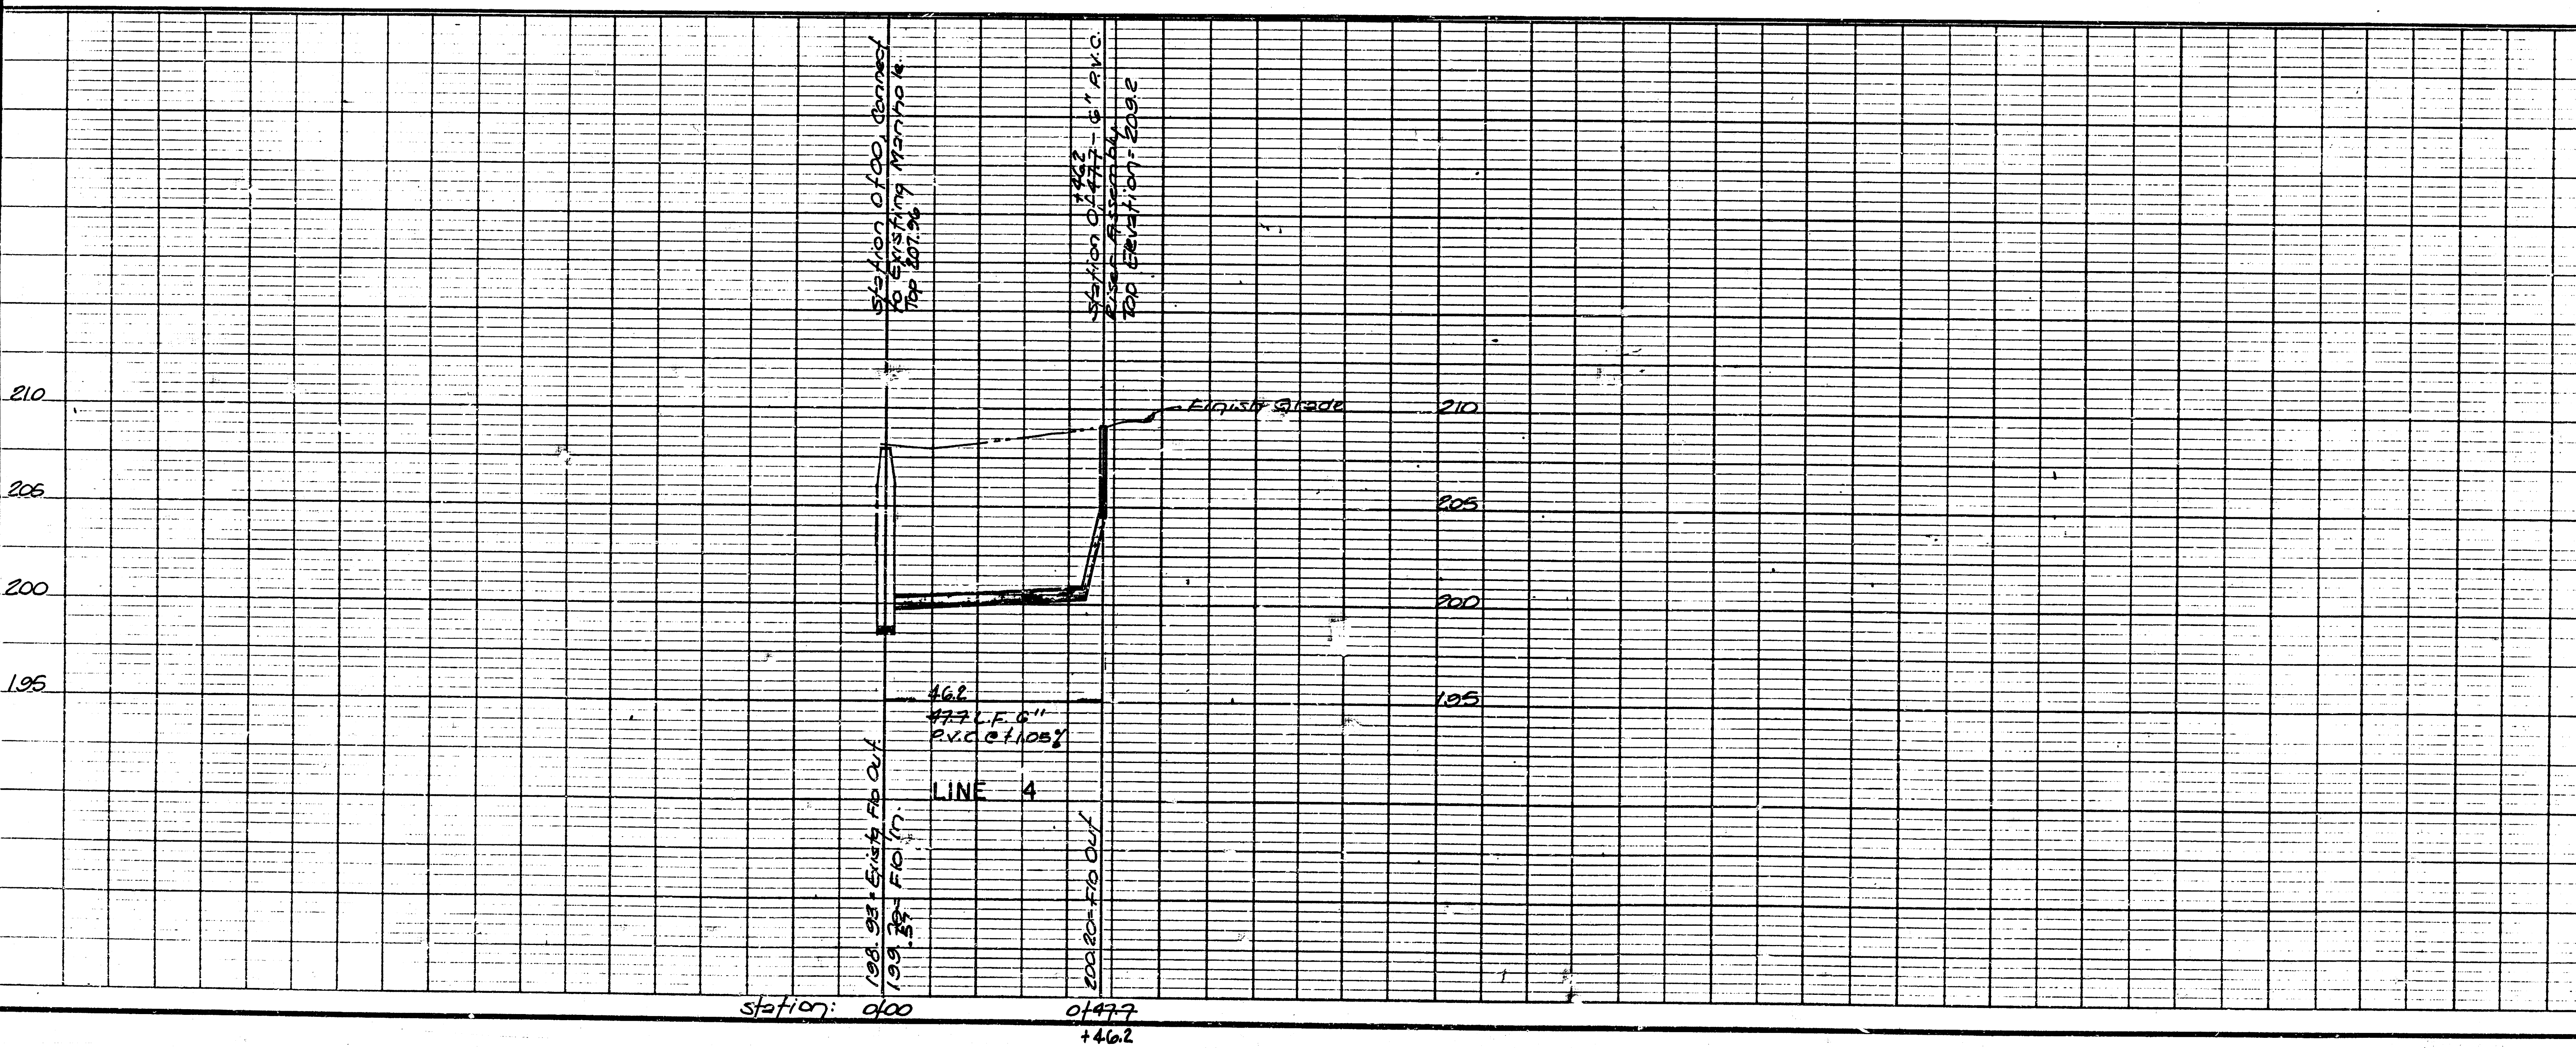

Rev: As-built (Phase 2) 4-14-89 TCR

PRIVATE SANITARY SEWER
TOWNE PARC 2ND ADDITION
LINE 4

BAUGHMAN COMPANY, P.A.
SURVEYING & ENGINEERING
310/282-7271 • 315 ELLIS • WICHITA, KANSAS 67211

Design: *Bohm* Drawn: *Bohm* Approved: *T.C.R.* Date: *3/89* Scale: *Noted*

Sheet 5 of 6



FILMED FROM THE BEST AVAILABLE COPY

VERTICAL RISER DETAIL

ADOPTED AS STANDARD DESIGN


BY

CITY OF WICHITA, KANSAS

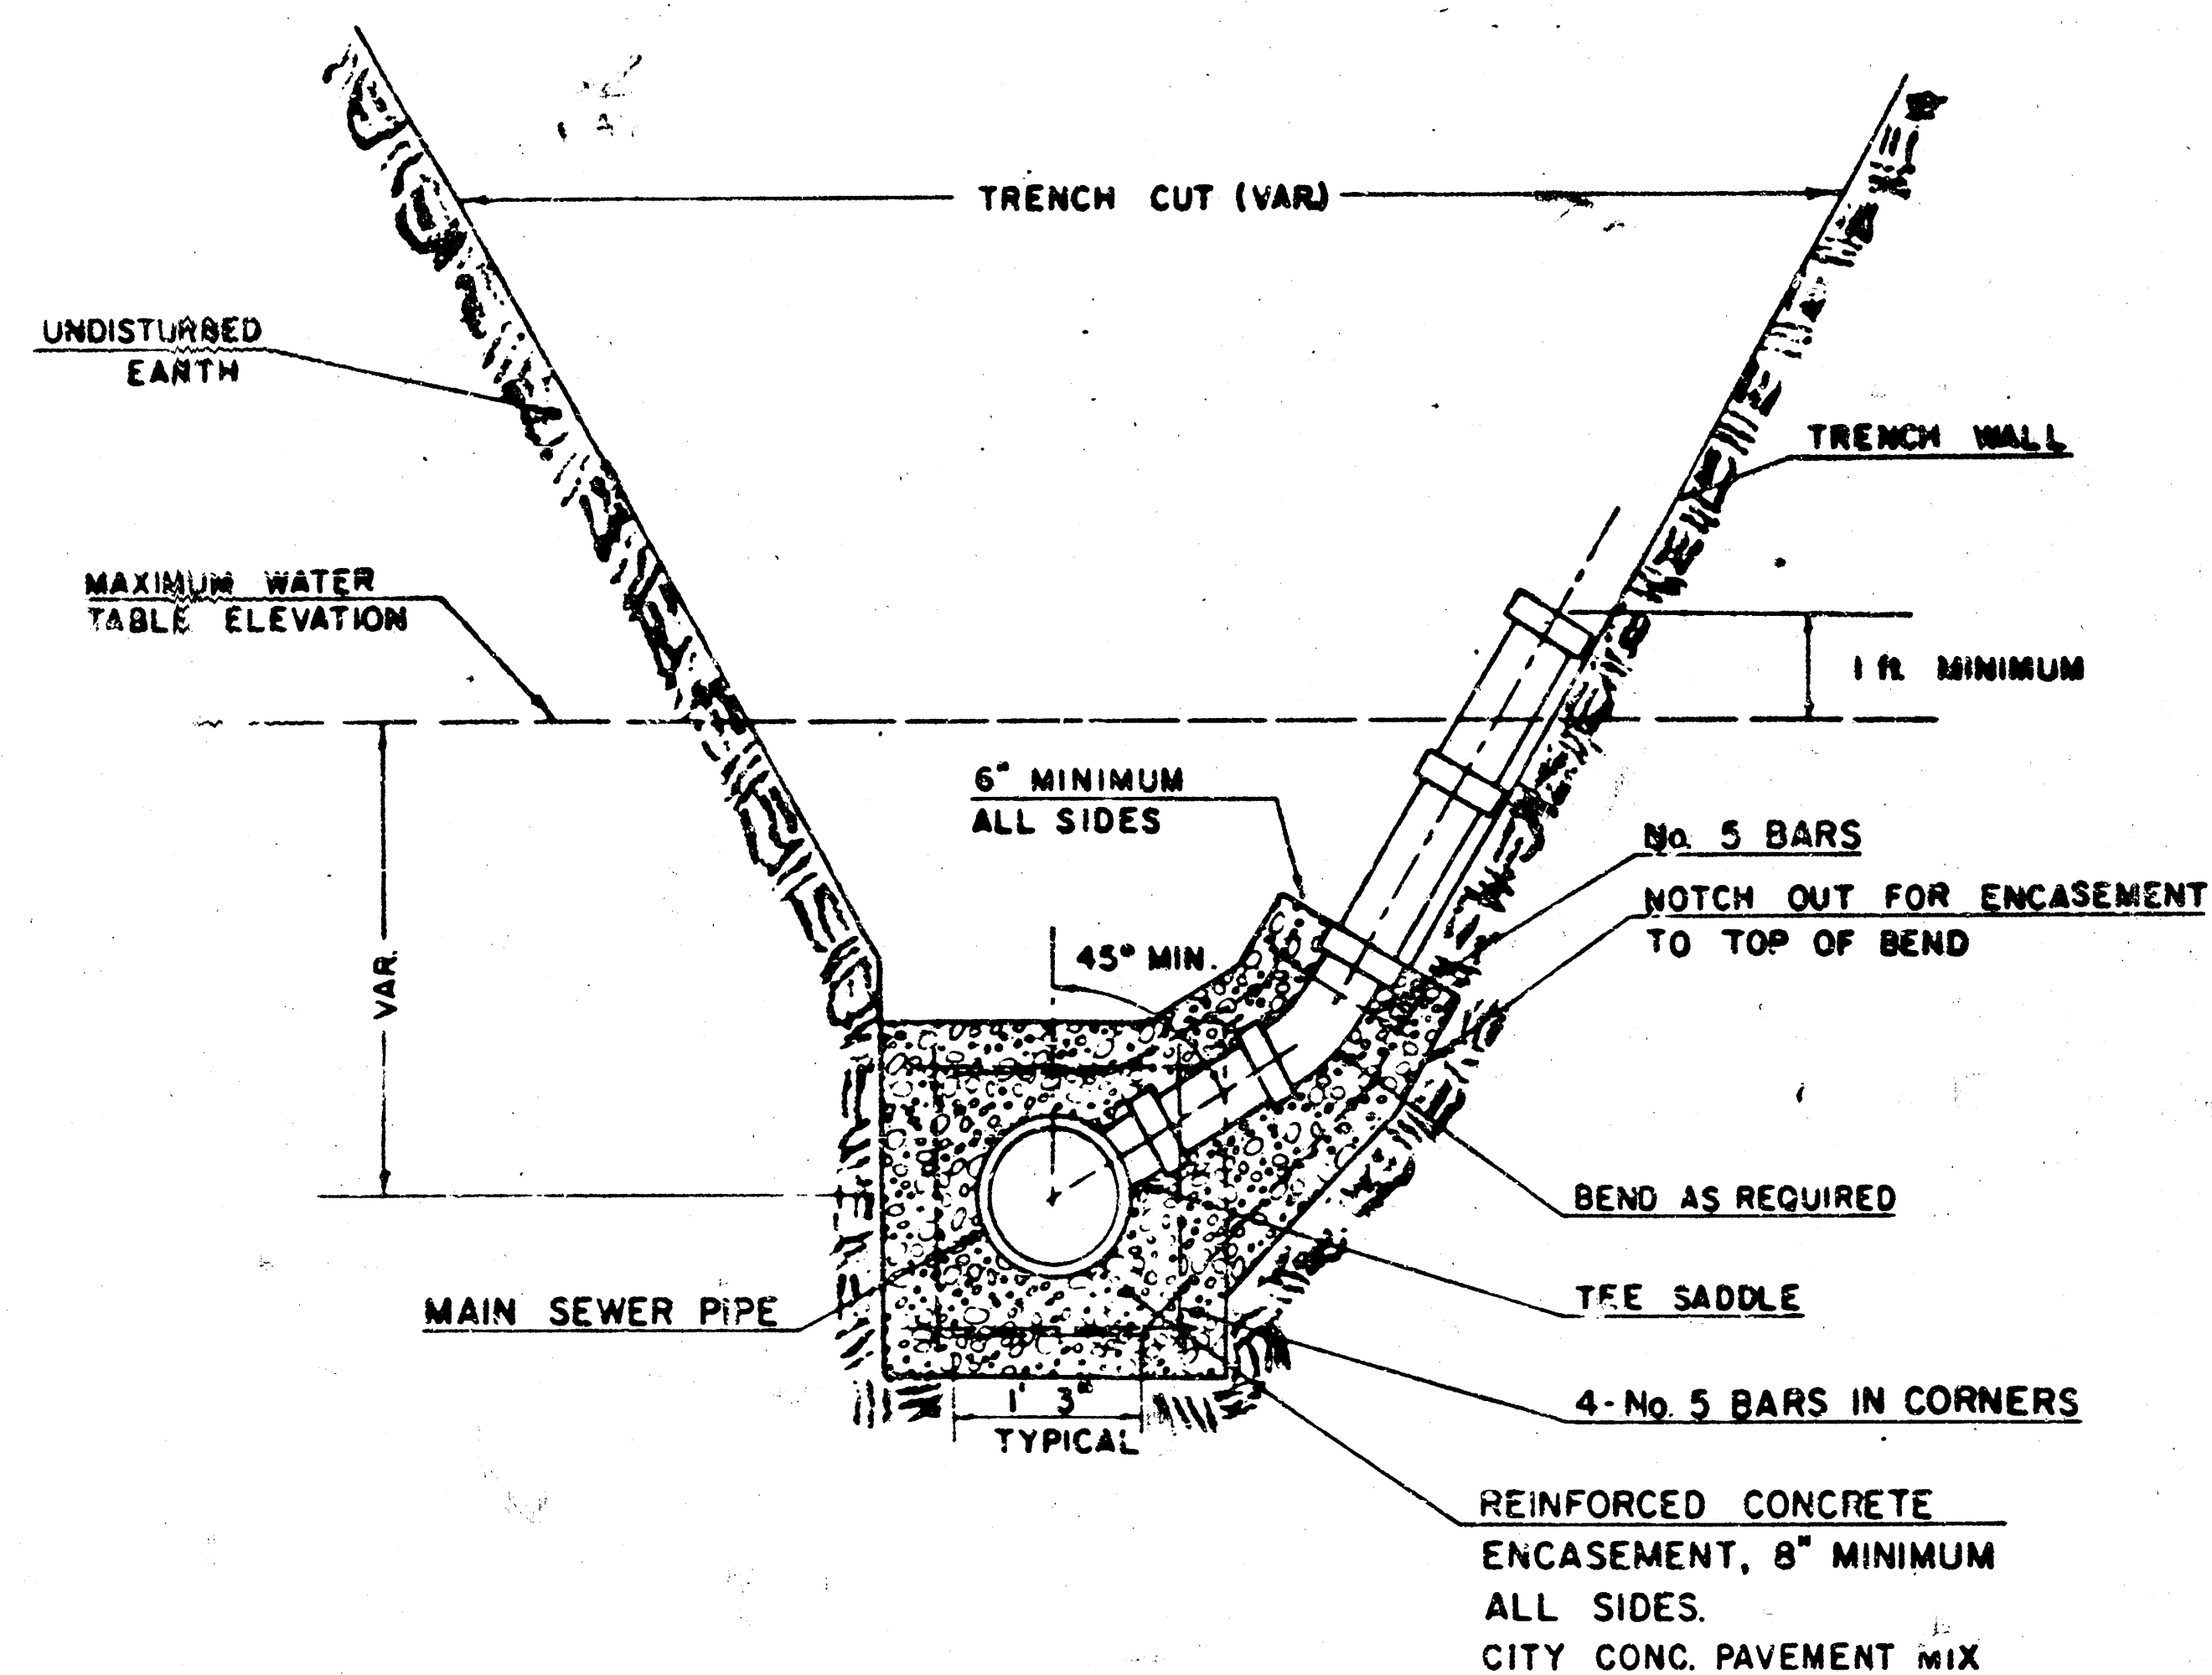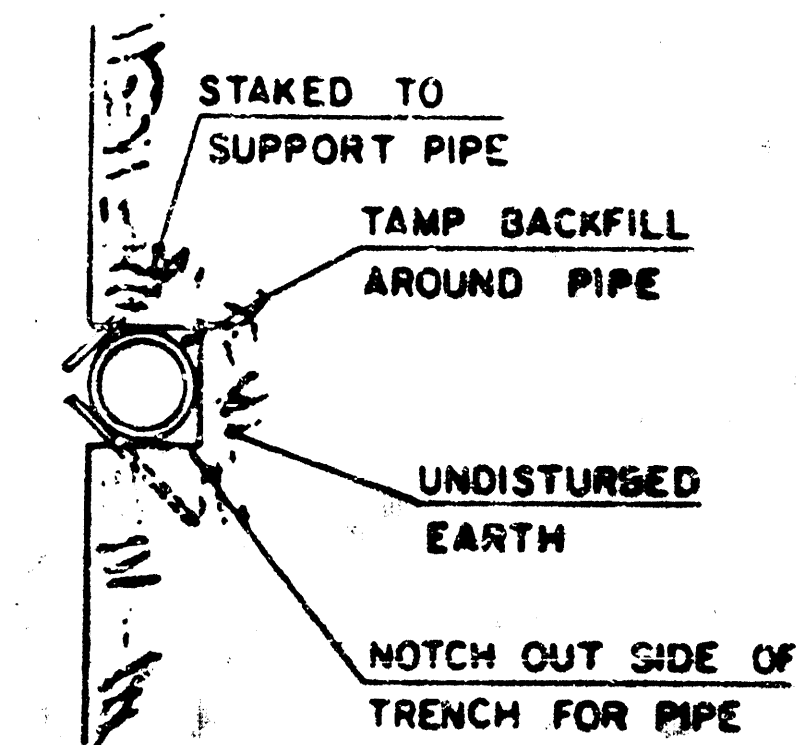

TYPICAL RISER FOR SLOPING TRENCH WALLS

NOTE:
TOP OF 4" OR 6" RISER PIPE TO BE EXTENDED TO AN ELEVATION OF 1 FT. MINIMUM ABOVE THE WATER TABLE ELEVATION, WHEN WATER EXISTS, OR TO AN ELEVATION SUITABLE FOR PROVIDING SERVICE TO THE LOT TO BE SERVED AND THEN PLUGGED.

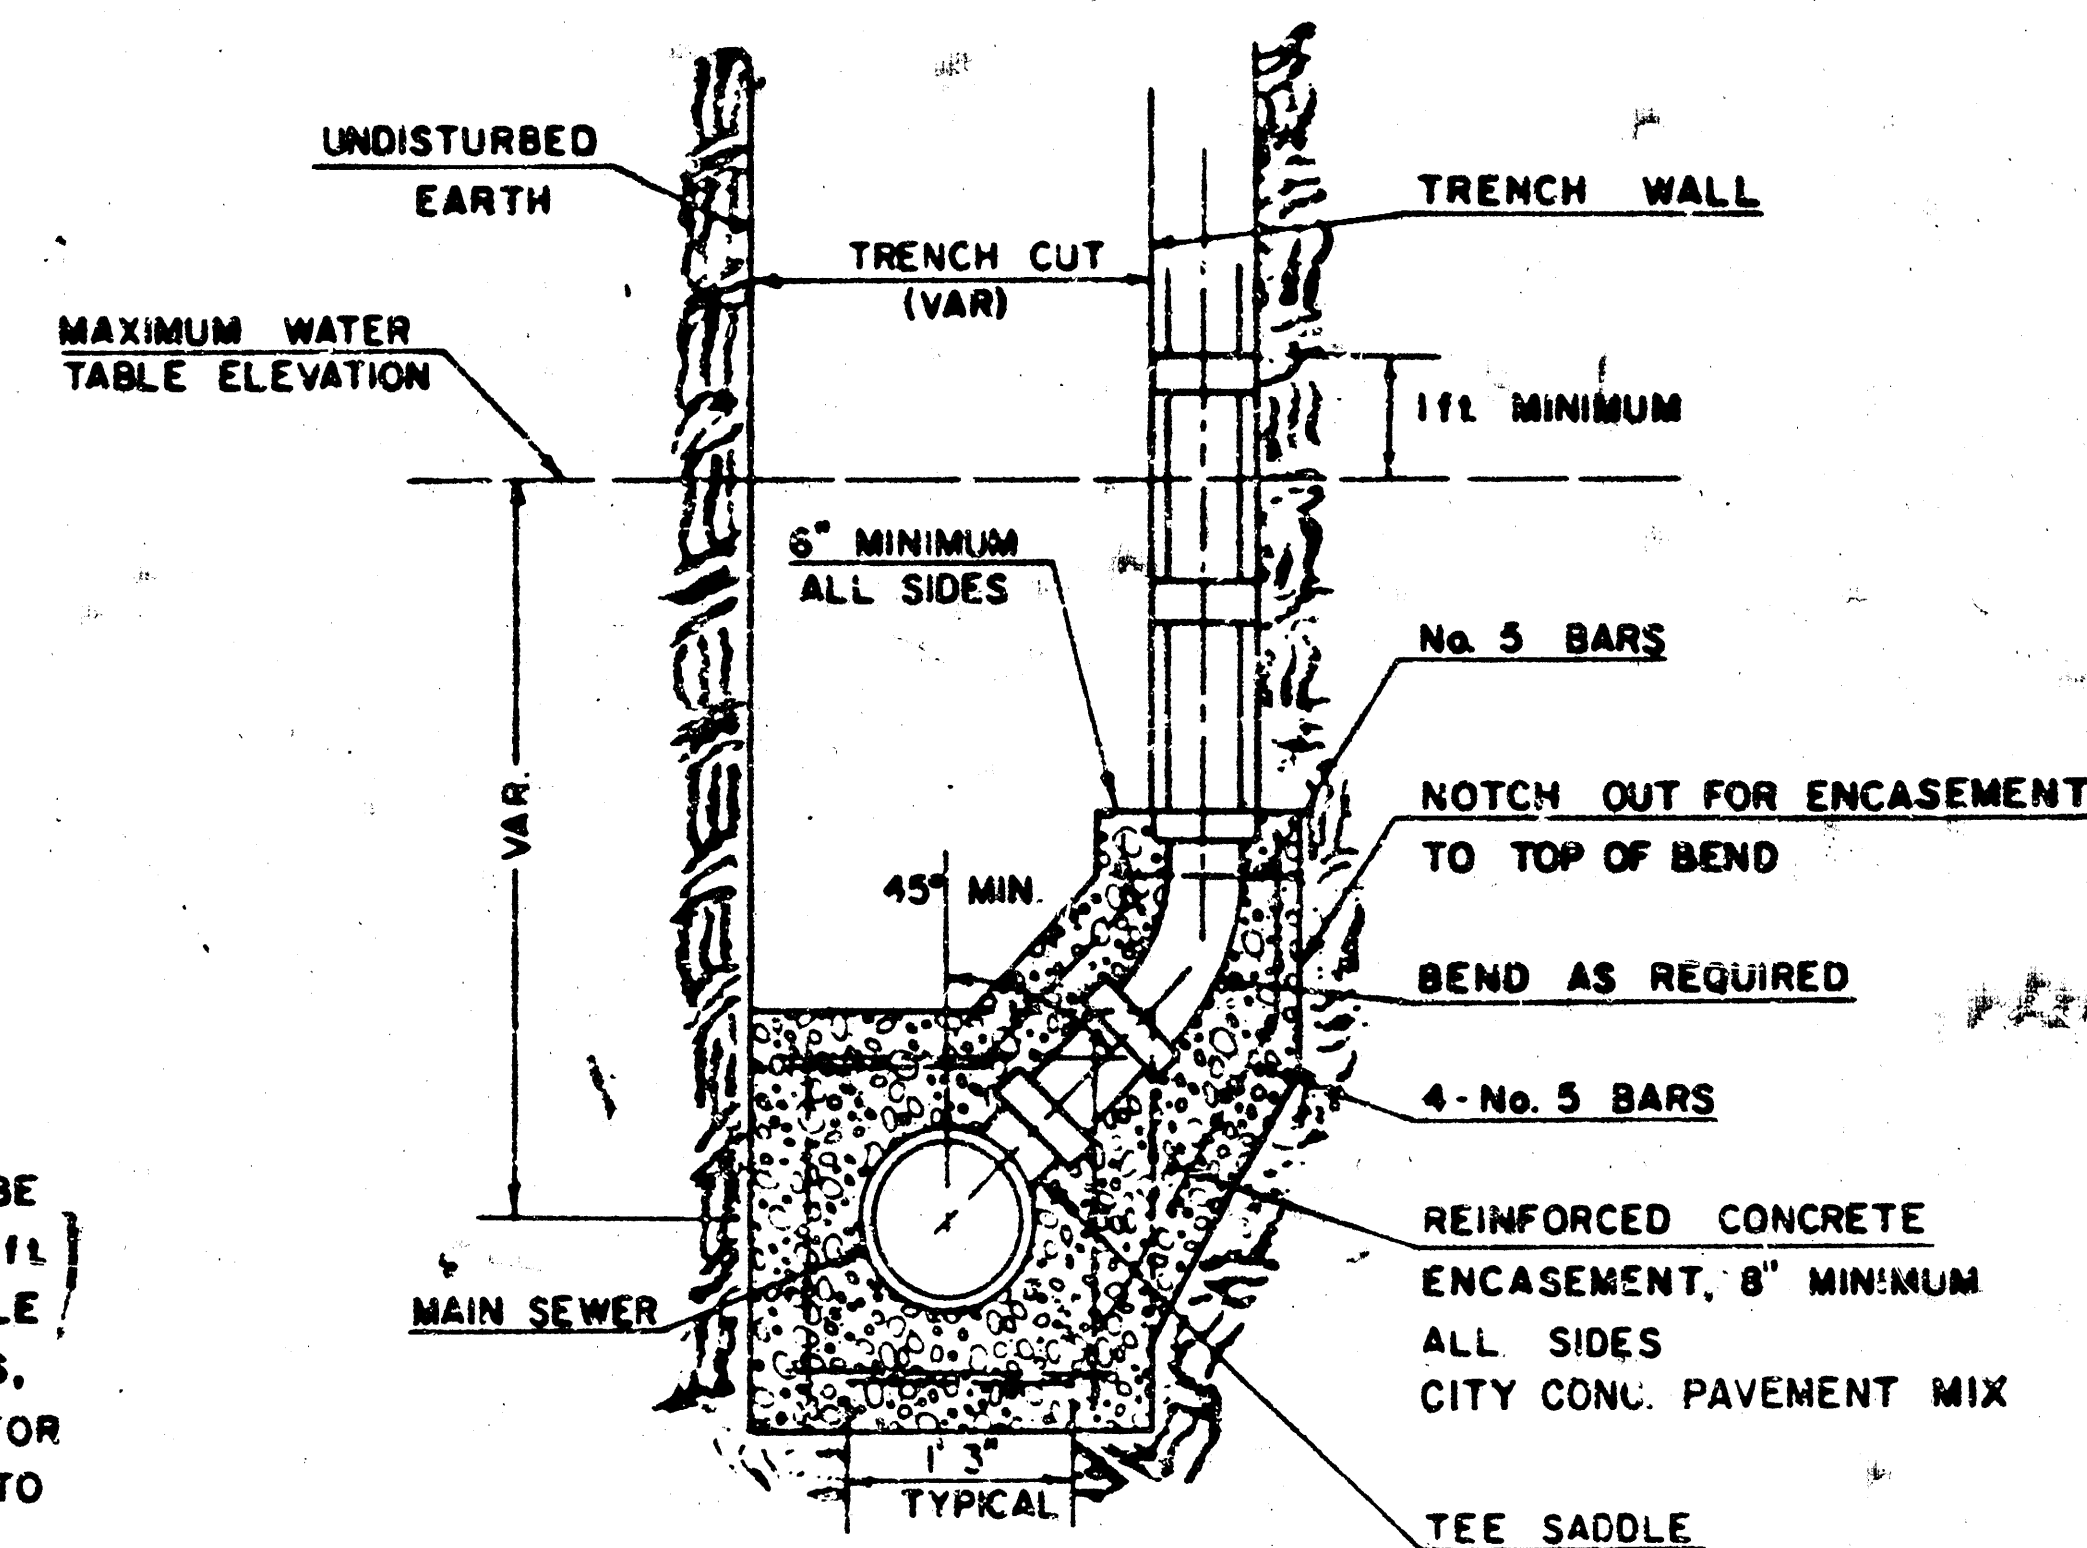

TYPICAL RISER FOR VERTICAL TRENCH WALLS

GENERAL NOTE

RISERS SHALL BE INSTALLED TO SERVE ALL LOTS OR TRACTS WHEN THE MAIN SEWER LINE IS BELOW THE WATER TABLE. RISERS SHALL ALSO BE INSTALLED TO SERVE ALL LOTS AND TRACTS WHEN THE MAIN SEWER LINE DEPTH IS SUCH THAT WOULD MAKE THE BUILDING SEWER LINE CONNECTION DIFFICULT. INSTALLATION OF RISERS BECAUSE OF MAIN LINE SEWER DEPTH SHALL BE AS APPROVED BY THE ENGINEER. THE LOCATION OF RISERS TO BE DEVELOPED PROPERTY SHALL BE APPROVED BY THE PROPERTY OWNER. PIPE STUBS SHALL BE INSTALLED IN MANHOLES WHERE LOCATIONS OF MANHOLES WILL PROVIDE SATISFACTORY SERVICE CONNECTIONS AS DETERMINED BY THE FIELD ENGINEER. THE VERTICAL DISTANCE BETWEEN THE FLOW LINE OF THE MANHOLE PIPE STUB AND THE FLOW LINE OF THE MAIN SEWER LINE SHALL NOT EXCEED 4 FT. MANHOLE PIPE STUBS SHALL NOT BE SET BELOW AN ELEVATION WHICH WILL PERMIT THE TOP OF THE INSIDE OF THE STUB TO MATCH THE TOP OF THE INSIDE OF THE MAIN SEWER PIPE. PIPE STUBS AND RISERS INSTALLED TO SERVE COMMERCIAL OR INDUSTRIAL PROPERTY SHALL BE 6 INCH. PIPE STUBS AND RISERS INSTALLED TO SERVE RESIDENTIAL PROPERTY MAY BE EITHER 6 INCH OR 4 INCH DEPENDING UPON THE AVAILABLE GRADE AND THE SIZE OF THE LOT AS DETERMINED BY THE FIELD ENGINEER. ENCASEMENT OF VITRIFIED CLAY MAIN SEWER PIPE SHALL EXTEND TO THE FIRST JOINT IN THE MAIN SEWER CLAY PIPE OF EACH SIDE OF THE RISER INSTALLATION. ENCASEMENT OF A.S.S. COMPOSITE OR P.V.C. MAIN SEWER PIPE SHALL EXTEND A MINIMUM OF 3 FT. ON BOTH SIDES OF THE CENTERLINE OF THE RISER. FOUR INCH AND SIX INCH RISER PIPE SHALL BE ENCASED WITH CONCRETE TO THE TOP OF THE BEND AS INDICATED IN THE DRAWINGS. FOUR INCH AND SIX INCH CLAY PIPE USED FOR RISERS SHALL BE EXTRA STRENGTH PIPE CONFORMING TO THE REQUIREMENTS OF THE LATEST REVISION OF A.S.T.M. DESIGNATION C700 WITH COMPRESSION JOINTS AS SPECIFIED FOR CLAY PIPE IN THE STANDARD SPECIFICATIONS. FOUR INCH AND SIX INCH A.S.S. OR P.V.C. PIPE SHALL BE PIPE APPROVED FOR USE IN THE CITY BY THE CHIEF PLUMBING AND MECHANICAL INSPECTOR FOR THE CENTRAL INSPECTION DIVISION OF THE DEPARTMENT OF HOUSING AND ECONOMIC DEVELOPMENT. LOCATION OF THE ENDS OF THE RISERS SHALL BE MARKED BY FASTENING GREEN COLORED PLASTIC TAPE TO THE END OF THE RISER WHICH SHALL BE EXTENDED TO THE GROUND SURFACE AS THE EXCAVATION IS BACKFILLED SUCH THAT THE COLORED TAPE WILL BE VISIBLE WHEN THE PROJECT IS COMPLETED. THE ENDS OF THE RISER PIPE AND MANHOLE STUBS SHALL BE CAPPED OR PLUGGED USING FITTINGS FURNISHED BY THE MANUFACTURER OF THE PIPE. CONTRACTOR'S METHODS FOR SUPPORTING AND BACKFILLING RISER PIPE SHALL BE APPROVED BY THE ENGINEER.

FURNISHING AND INSTALLING RISERS SHALL BE PAID FOR AT THE UNIT PRICES BID FOR 4" PIPE, 6" PIPE AND REINFORCED CONCRETE ENCASEMENT FOR THE VARIOUS MAIN SEWER PIPE SIZES INDICATED, WHICH PRICE SHALL INCLUDE ALL COSTS FOR COMPLETION OF THIS ITEM INCLUDING SADDLES, BENDS, CONCRETE, REINFORCING STEEL, CAPS OR PLUGS, AND ALL OTHER NECESSARY MATERIALS OR WORK. CONCRETE ENCASEMENT OF THE RISER PIPE TO THE TOP OF THE BEND AS SHOWN BY THE DRAWINGS WILL NOT BE PAID FOR DIRECTLY AND THE COST FOR THIS WORK SHALL BE CONSIDERED AS SUBSIDIARY TO THE OTHER ITEMS OF WORK.

THE PROJECT INSPECTOR SHALL REPORT ON INSPECTOR CARDS THE LOCATION OF ALL RISERS CONSTRUCTED AS MEASURED FROM THE NEAREST MANHOLE, THE DIRECTION OF SERVICE, THE ELEVATION OF THE TOP OF THE RISER, AND THE PAY QUANTITIES INVOLVED. THE PROJECT INSPECTOR SHALL ALSO REPORT ON INSPECTOR CARDS THE LOCATION, DIRECTION OF SERVICE, AND SIZE OF ALL STUBS INSTALLED IN MANHOLES.