


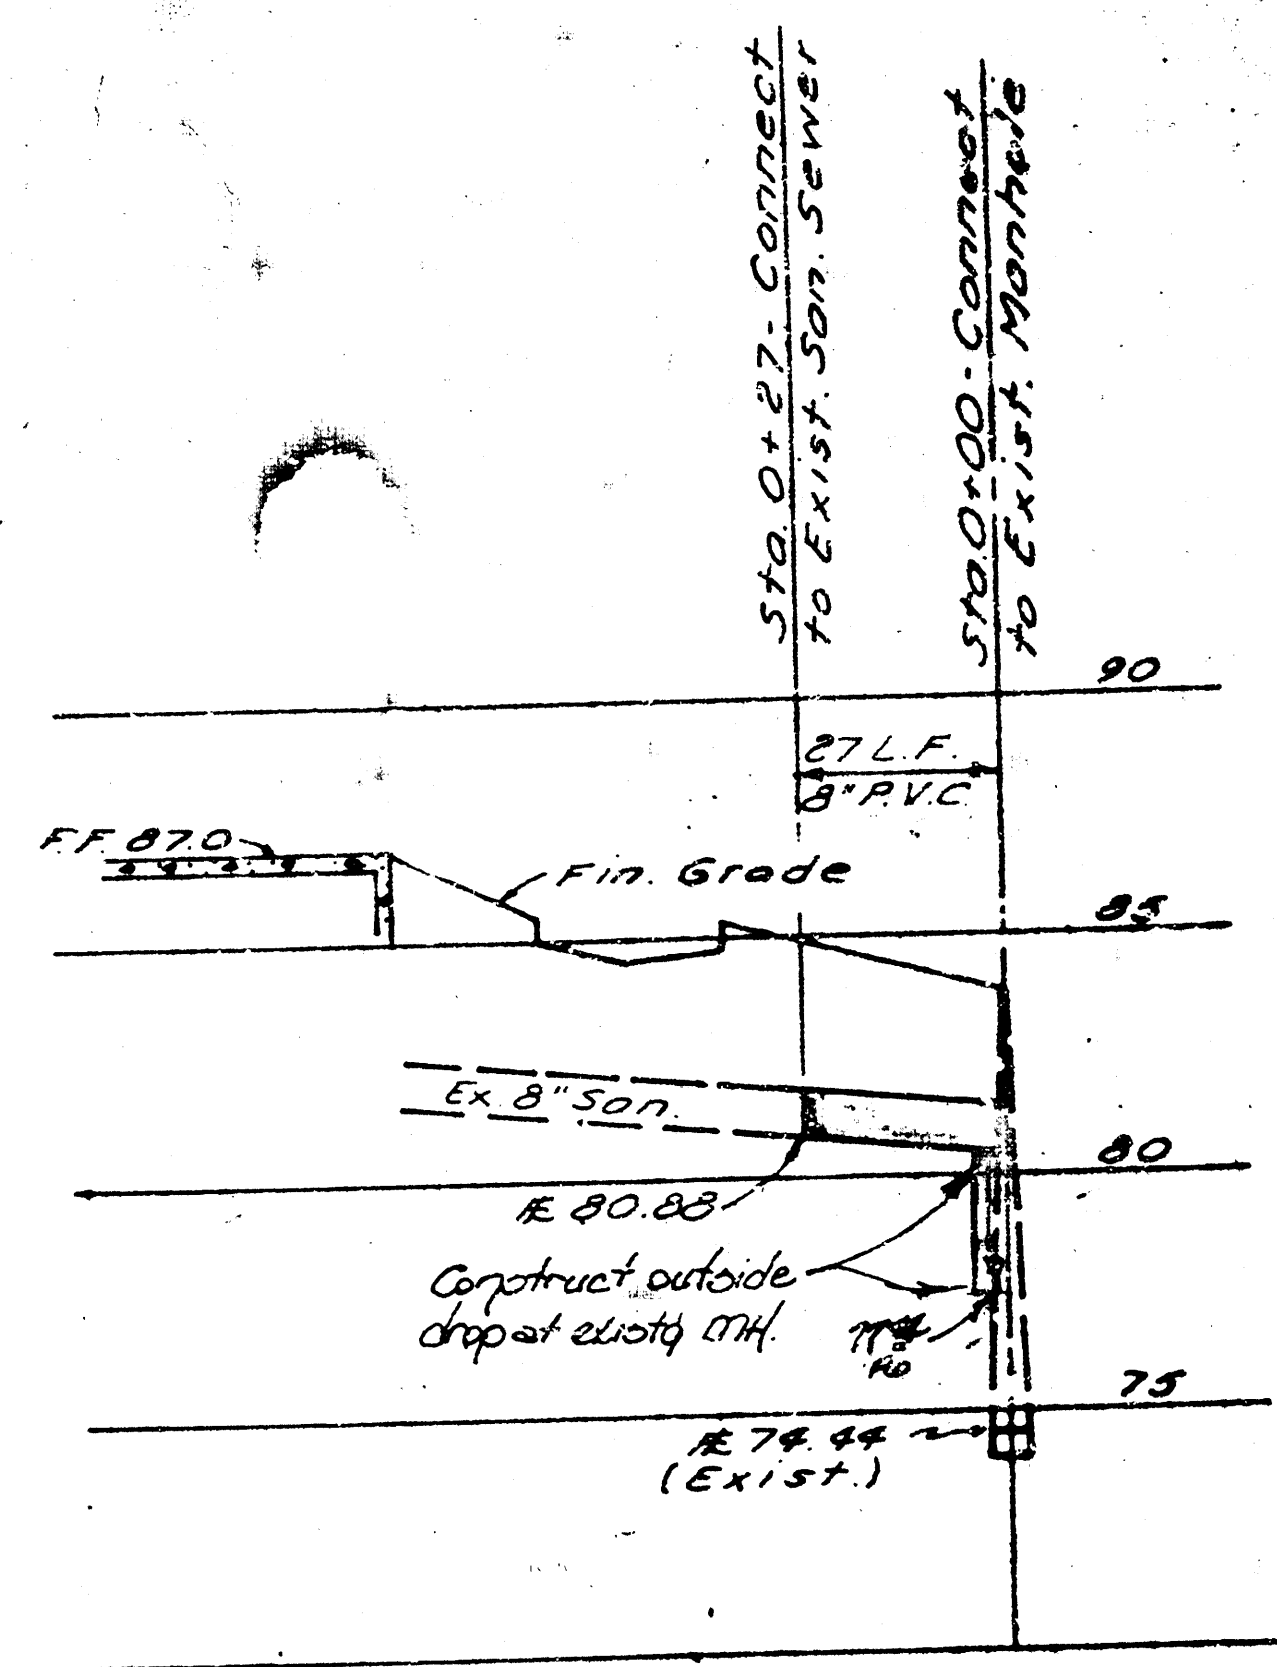

SANITARY SEWER PROFILE

GENERAL NOTES

Construction within 5' of the building shall be in compliance with the City Plumbing Code and will be inspected by Central Inspection. Televising and air testing will not be required.

APPROVED AS NOTED
By CITY ENGINEER OF WICHITA
Sanitary Sewers, *4/2/85*
Storm Sewers
Driveway Approaches

NOTE TO CONTRACTOR

This project will be constructed under the supervision of the CITY ENGINEER and conforming to the SPECIFICATIONS of the CITY OF WICHITA. The CONTRACTOR will pay the City of Wichita for all costs of plan review, inspection and booking per contract.


DATE REVIEWED 10-25-85
BY 1-4-86
TO 1-25-86

revisions
4-29-85 REV
SEWER

date drawn

J4
JEFF KREHBIEL
ASSOCIATES, P.C.
architecture planning

1300 West 10th St. WICHITA, KANSAS 67211
(316) 264-0000

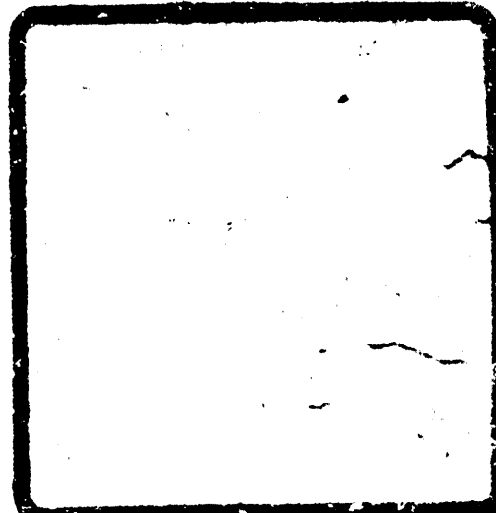


TURNPIKE INN
47th STREET SOUTH and LAURA
WICHITA, KANSAS

sheet 2 of 2
SITE GRADING PLAN



sheet
SG-1
of 1 sheets

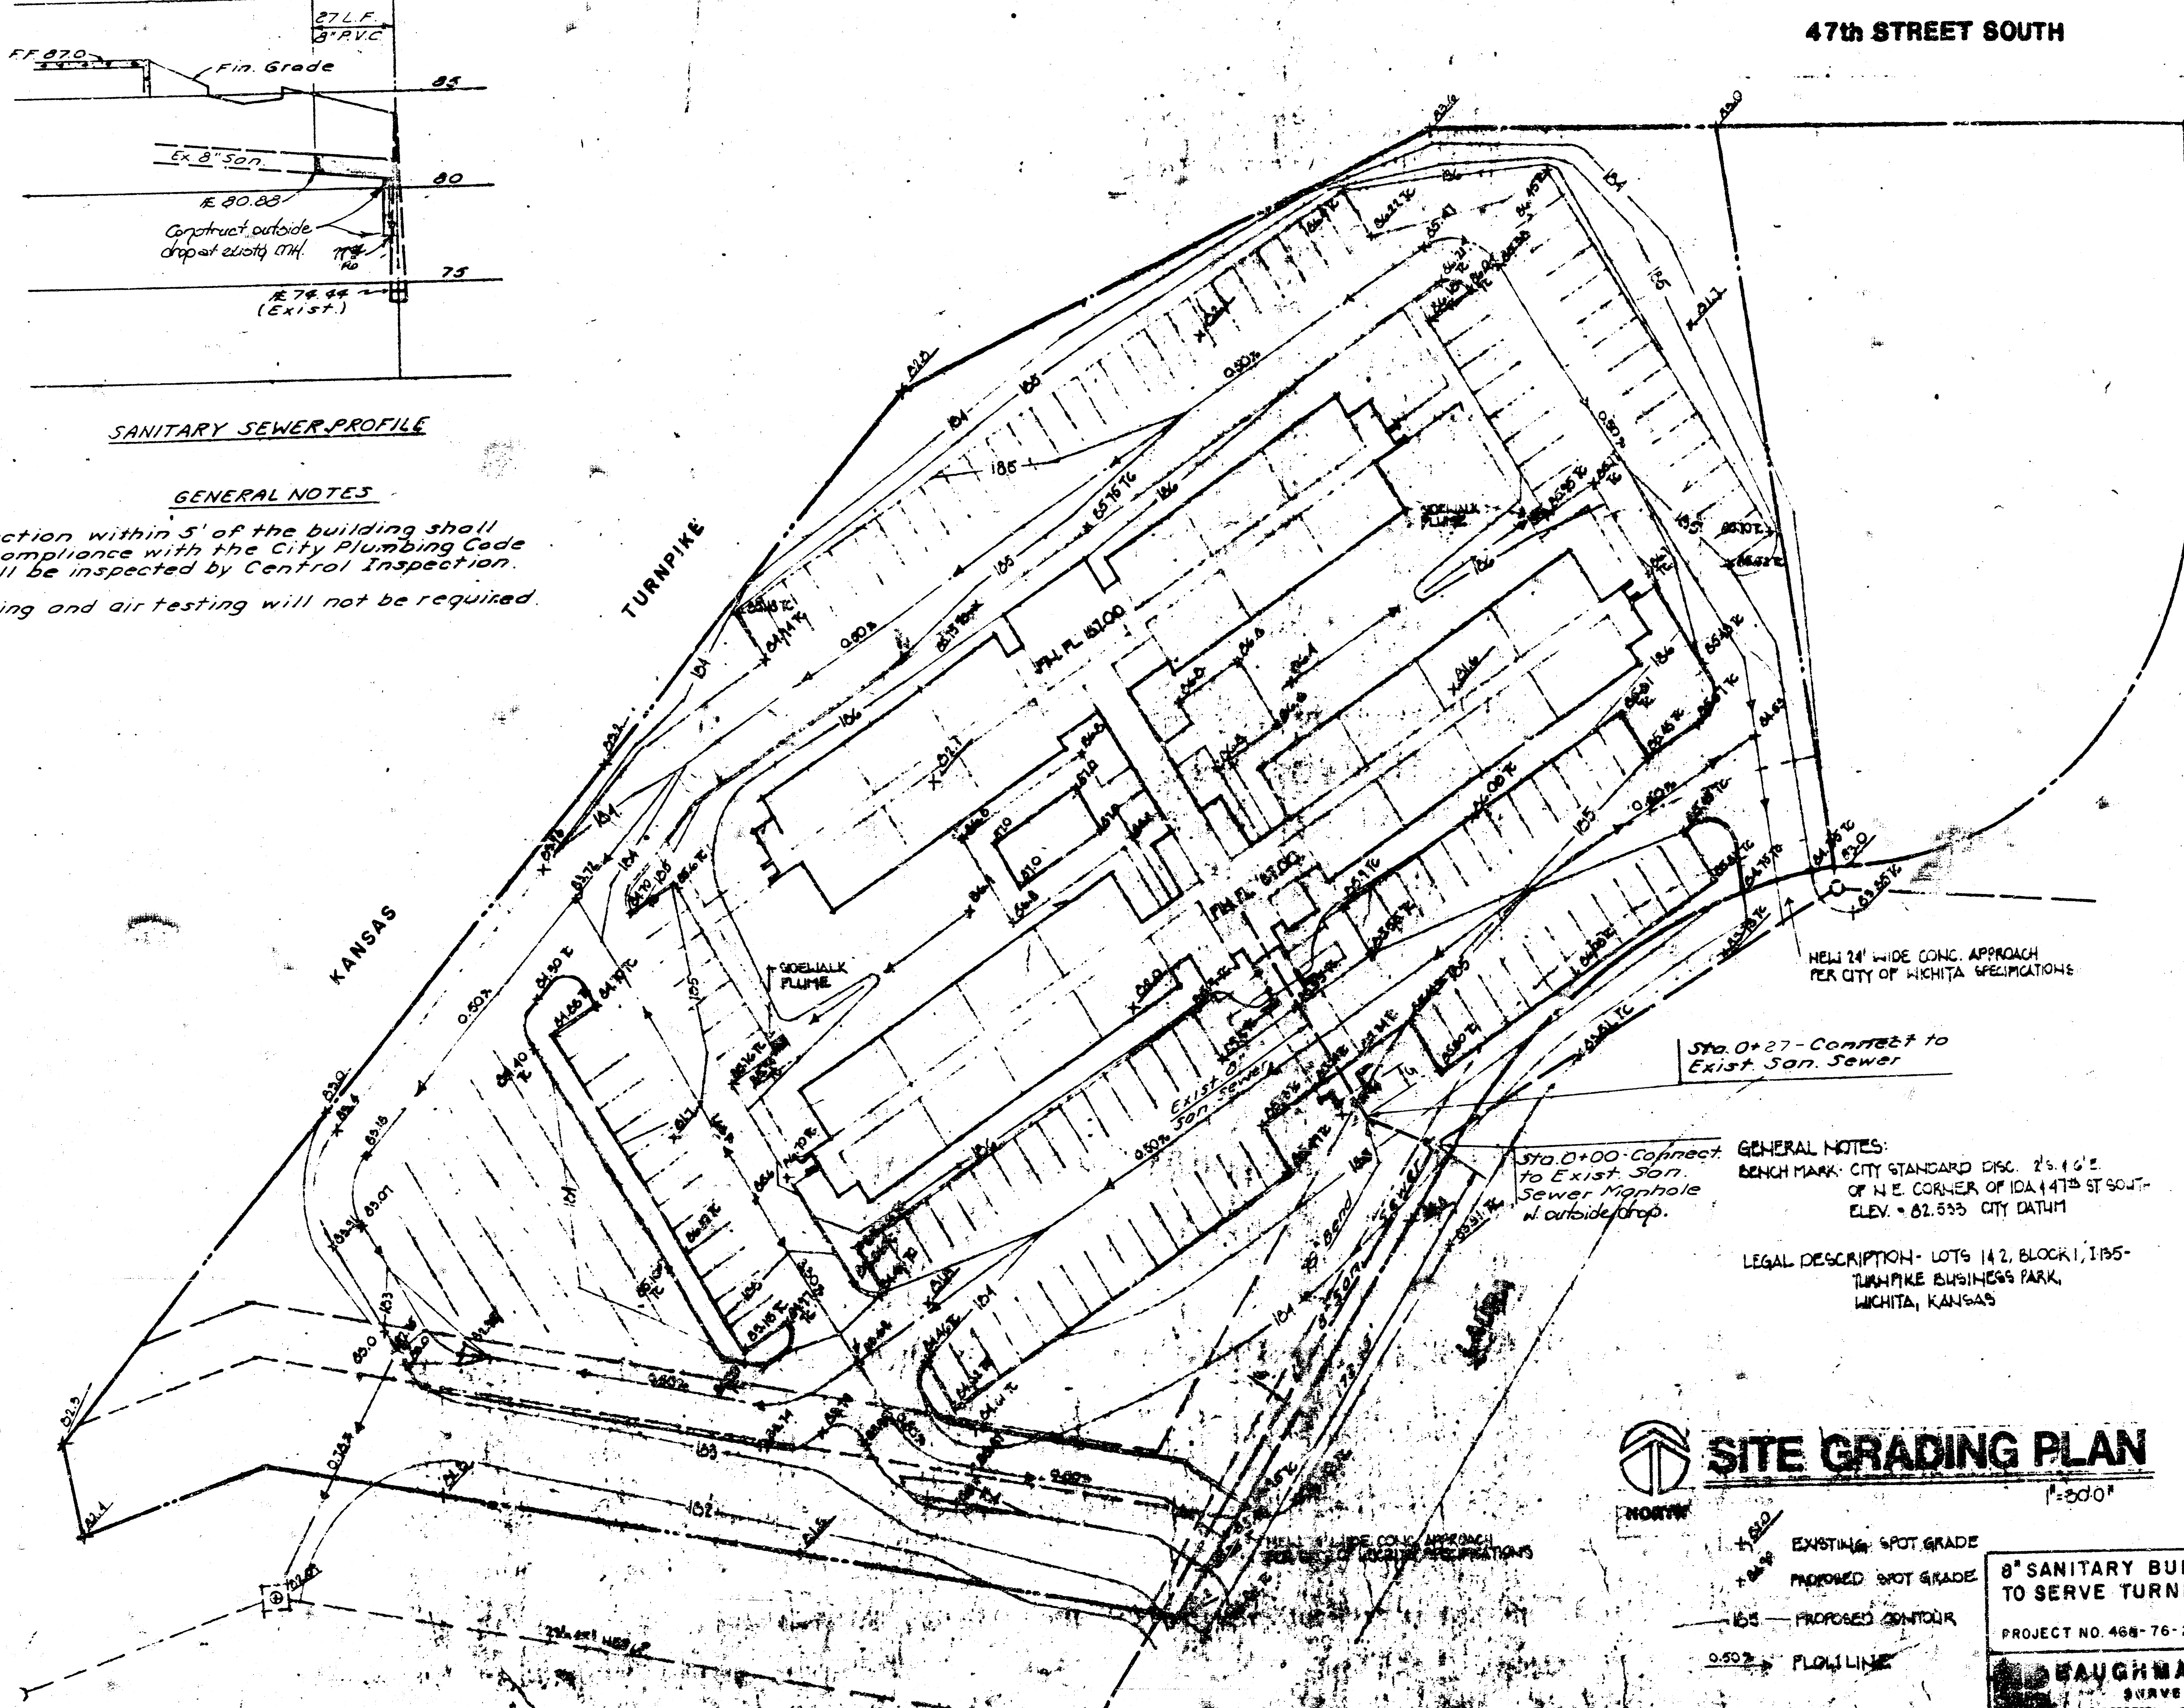

GENERAL NOTES:
BENCH MARK: CITY STANDARD DISC 25.46' E OF N.E. CORNER OF 10A 14TH ST SOUTH ELEV. = 82.555 CITY DATUM
LEGAL DESCRIPTION: LOTS 142, BLOCK 1, 1195 TURNPIKE BUSINESS PARK, WICHITA, KANSAS




SITE GRADING PLAN

- +8.00' EXISTING SPOT GRADE
- +8.00' PROPOSED SPOT GRADE
- 105' PROPOSED CONTOUR
- 0.50% FLOW LINE

8" SANITARY BUILDING SERVICE LINE TO SERVE TURNPIKE INN
PROJECT NO. 468-76-245-80001-OCO-000-016

BAUGHMAN COMPANY, P.A.
SURVEYING & ENGINEERING
1000 SOUTH 10TH ST. WICHITA, KANSAS 67211

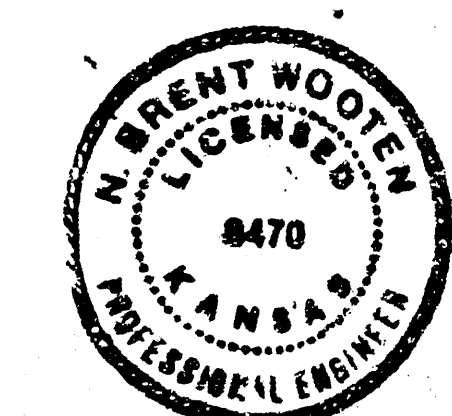

FILMED FROM THE BEST AVAILABLE COPY.....