



BENCHMARK: "V" Notch at S.W. corner, Lot 1.
Tyler Acres Sixth Addition.
Elev. = 148.76 City Datum

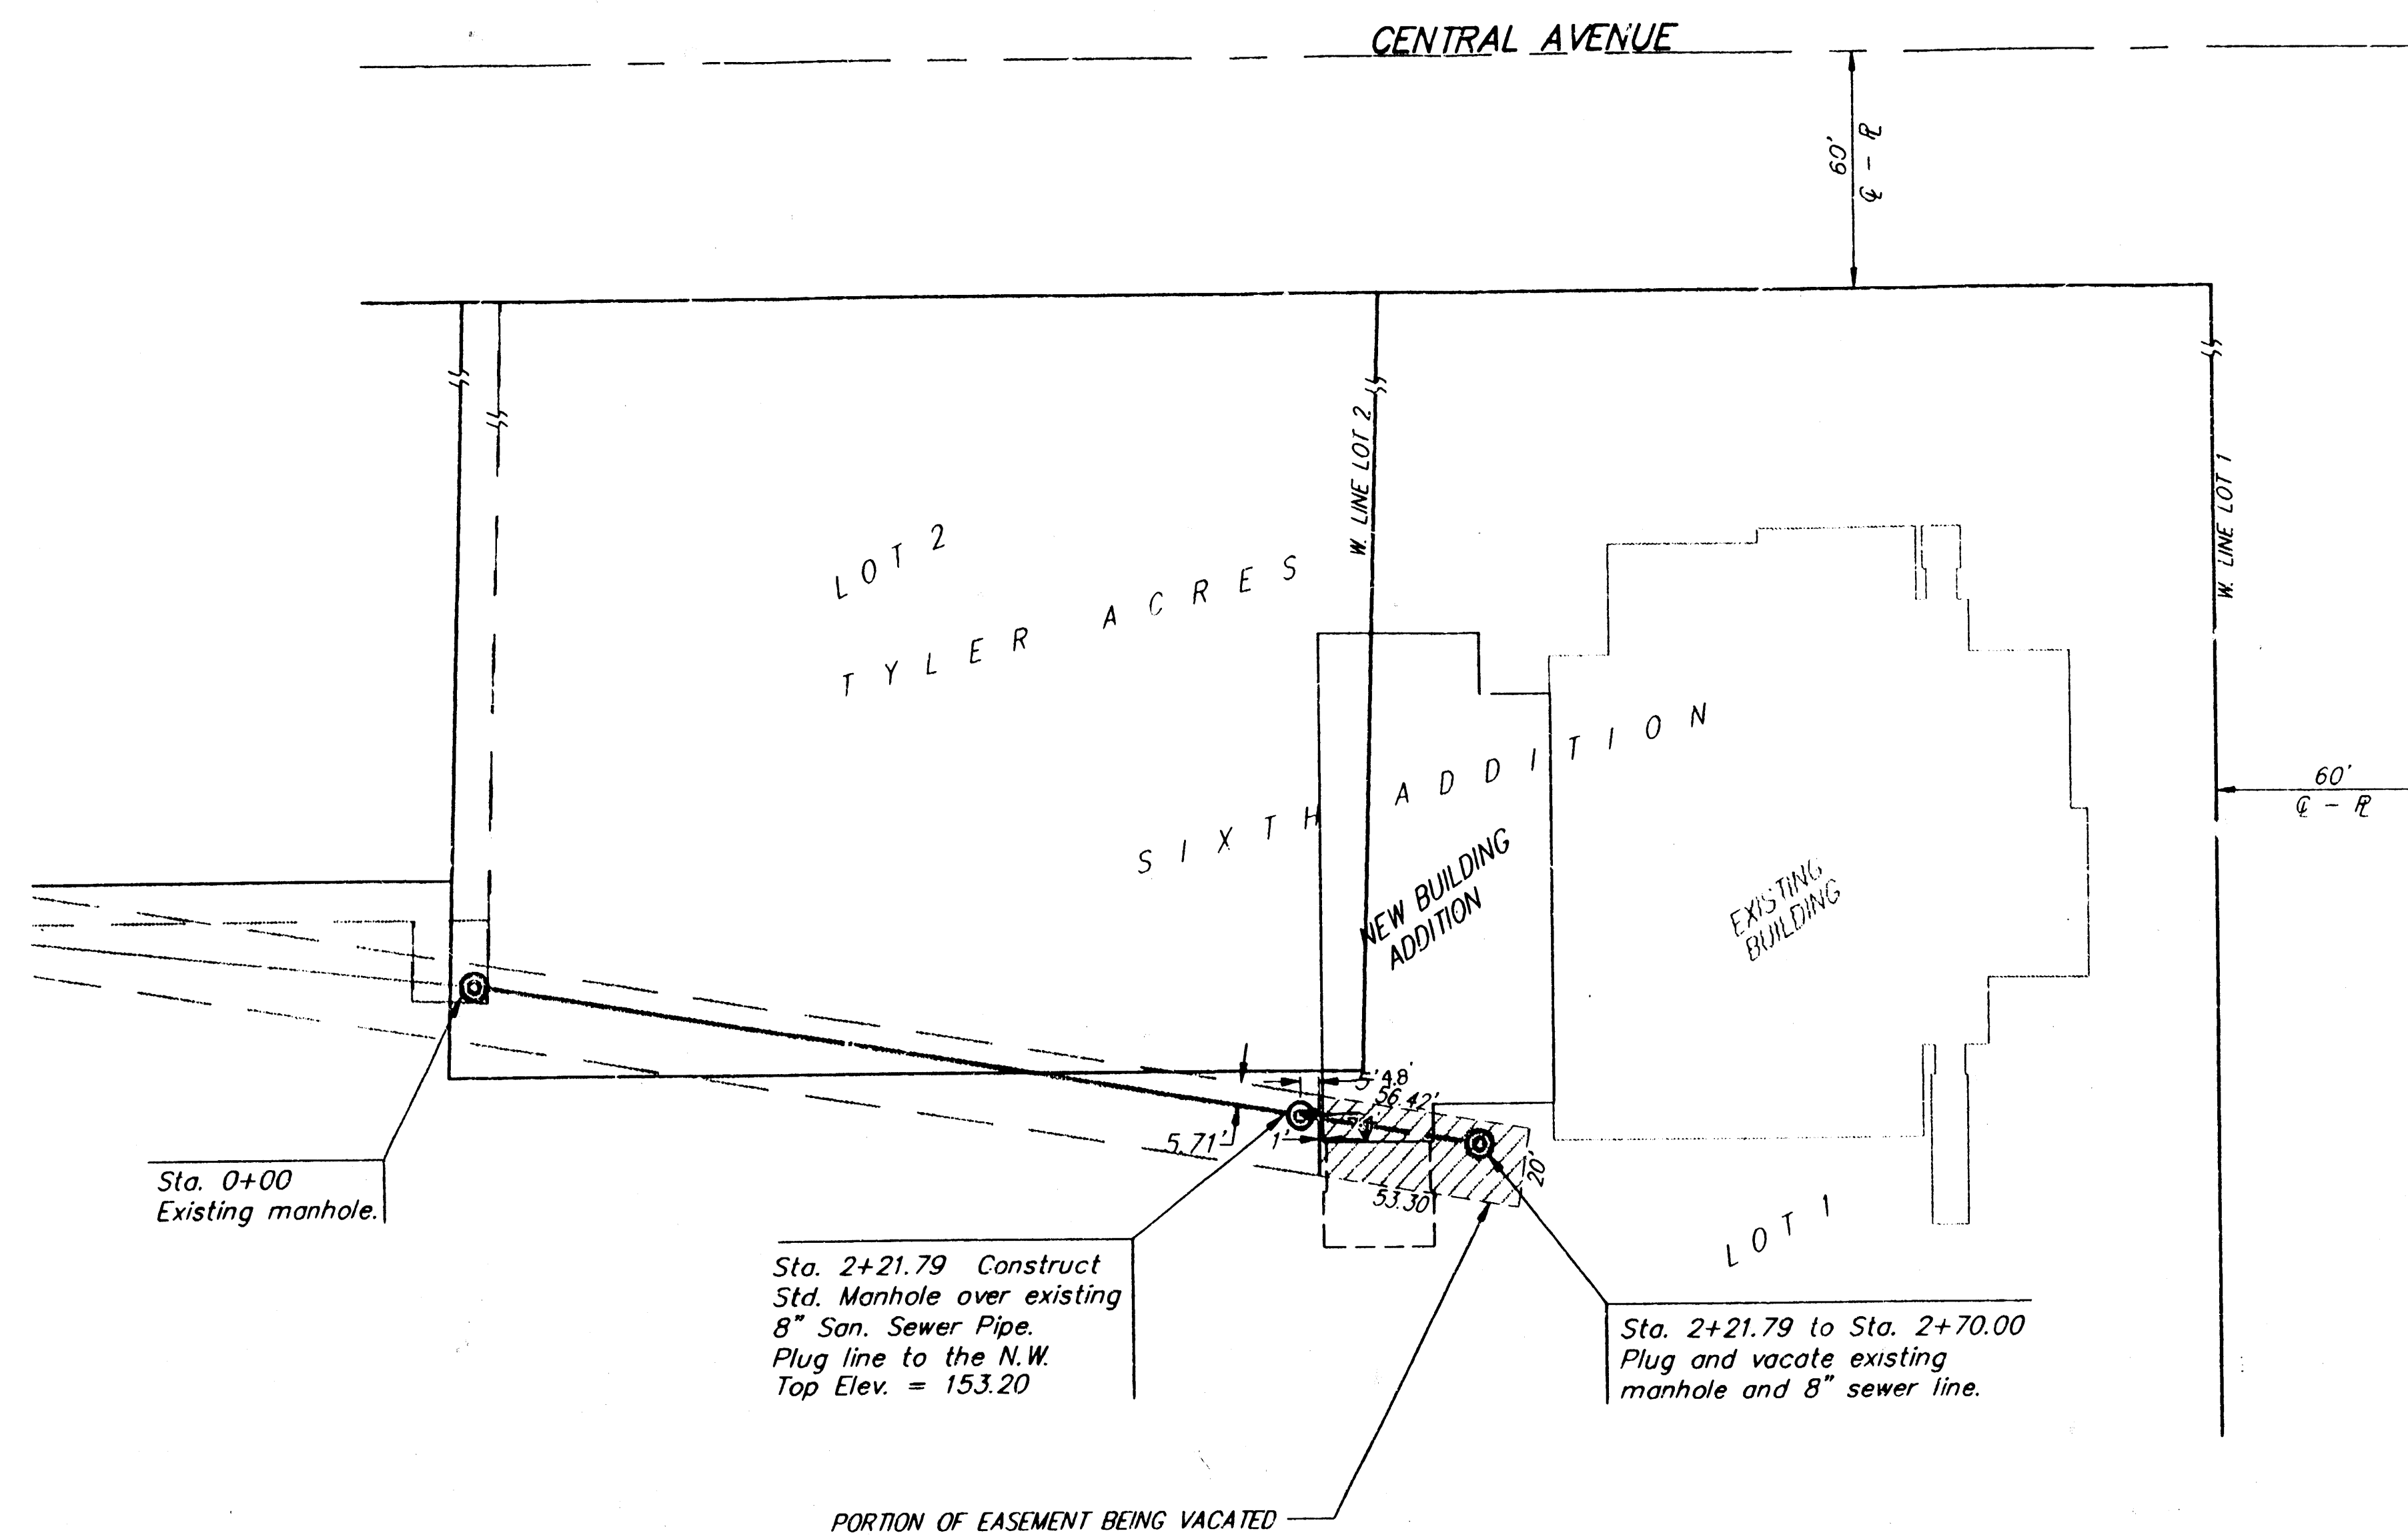

SCALE:
1" = 40' Horiz.
1" = 5' Vert.
• = Iron

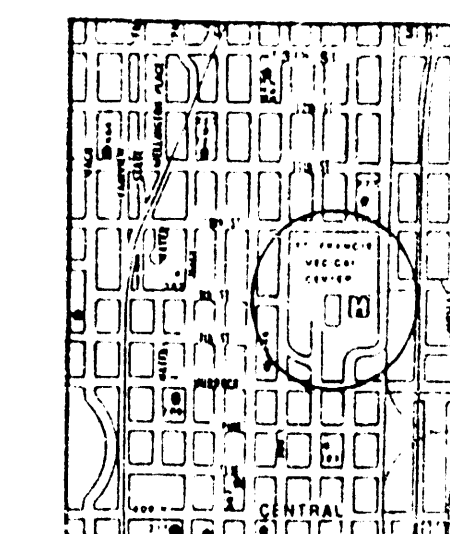


LOCATION MAP


APPROVED AS NOTED
BY CITY ENGINEER OF MOHITA
Sanitary Sewers VRH 5/17/93
Storm Sewers _____
Driveway Approaches _____
Water Mains _____
Paving _____

NOTE TO CONTRACTORS
Inspection and testing for this project is to be provided by a Licensed Consulting Engineering Firm under contract with the Owner/Developer. Said inspection to be in accordance with the City of Mohita standard construction engineering practices and certified by a Licensed Professional Engineer. No work shall be performed in dedicated easements or public right-of-way by the Contractor without such inspection nor shall any work be commenced without written authorization by the City Engineer.

Booked
CKB 6-1-93

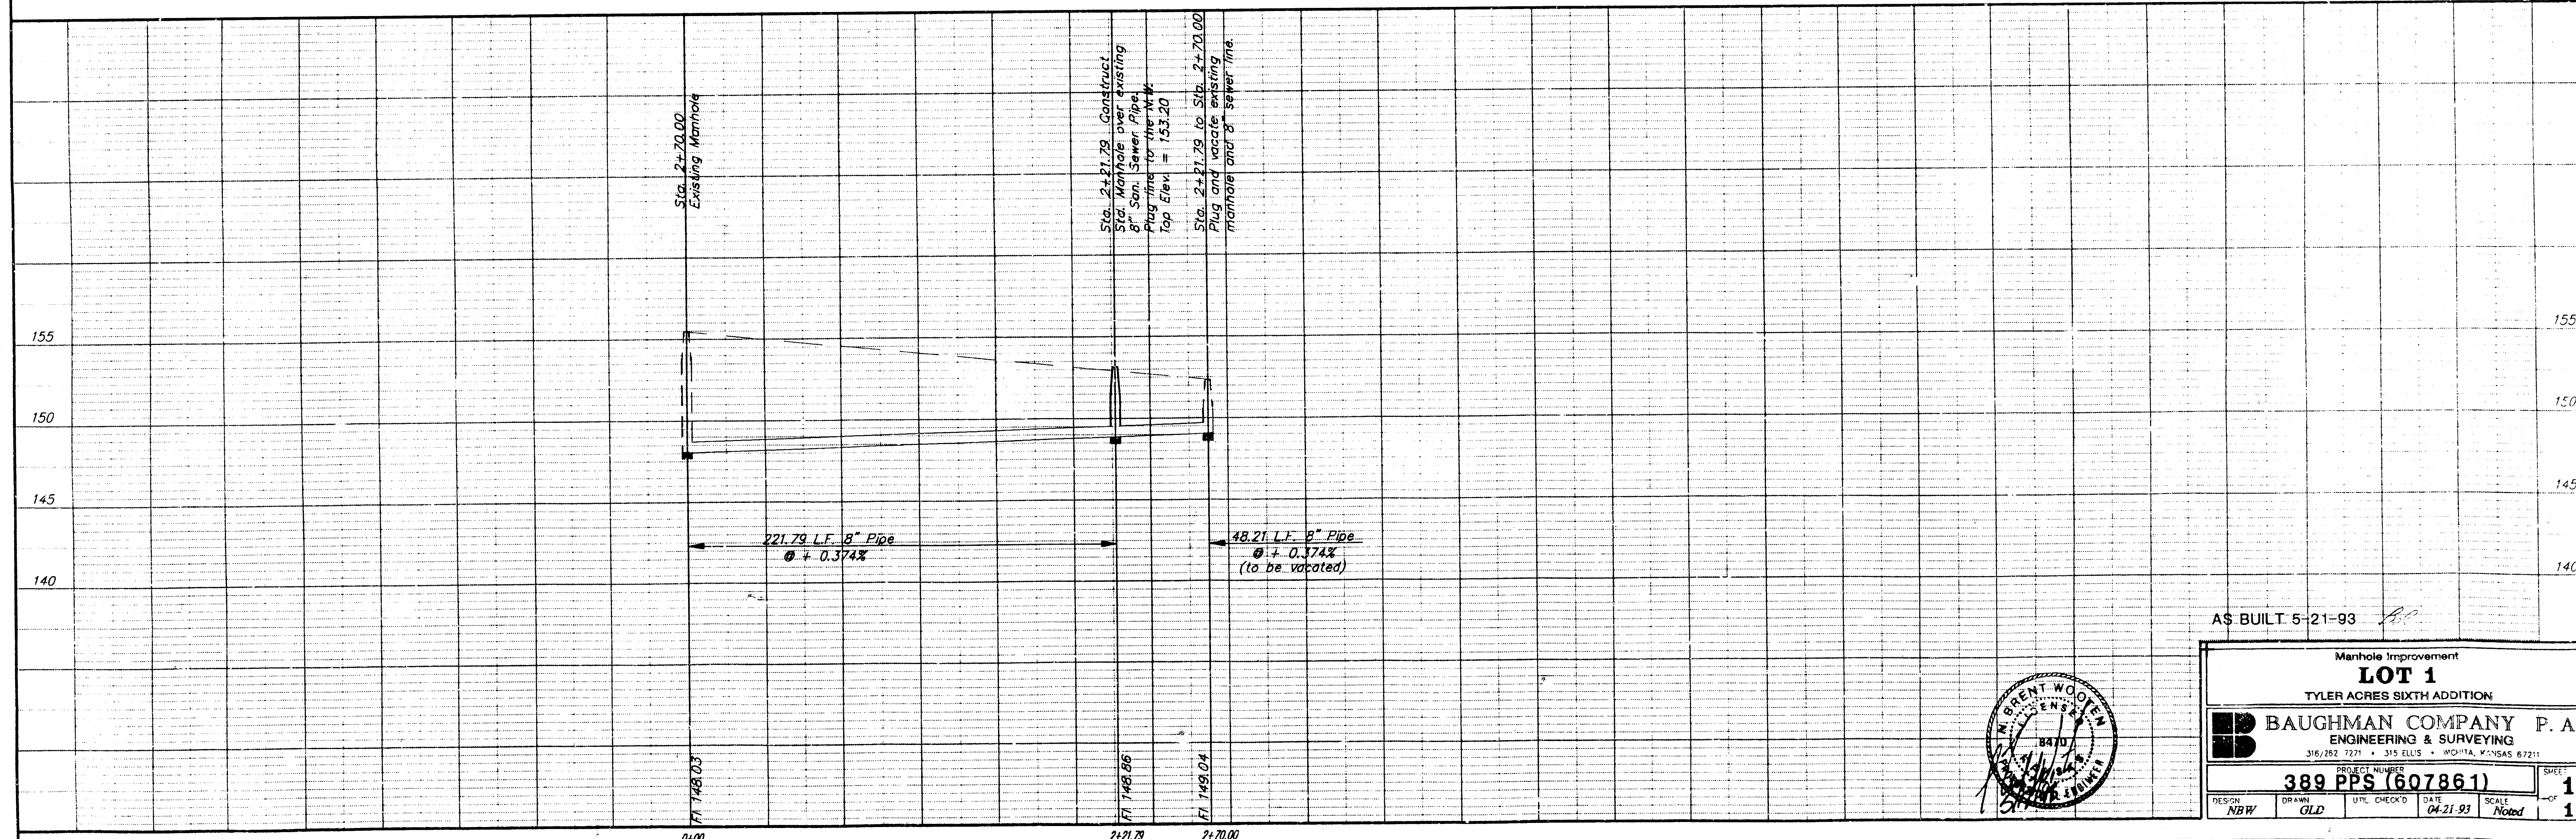

AS BUILT 5-21-93

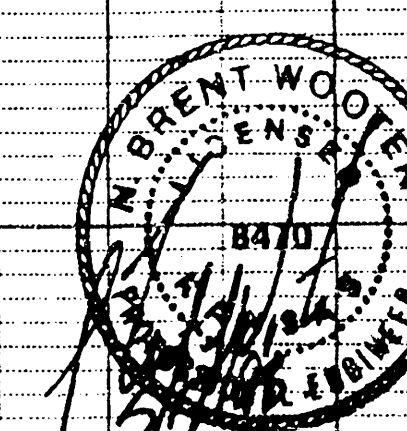

Manhole Improvement			
LOT 1			
TYLER ACRES SIXTH ADDITION			
BAUGHMAN COMPANY P. A.			
ENGINEERING & SURVEYING			
316/282 7271 • 315 ELLIS • MOHITA, MISSOURI 67211			
PROJECT NUMBER			
389 PPS (607861)			
DESIGN	DRAWN	DATE	SCALE
NBW	GLD	04-21-93	Noted
SHEET			1
OF			1