

B.M. - ELEV 141.15 - NORTH RIM OF EXISTING M.H. 0+00

3-28-75


APPROVED AS NOTED
CITY ENGINEER OF WICHITA

Sanitary Sewers: D.E.S.

Storm Sewers

Driveway Approaches

NOTE TO CONTRACTOR
This project will be constructed under the supervision of the CITY ENGINEER and conforming to the SPECIFICATIONS of the CITY OF WICHITA. The CONTRACTOR will reimburse the City of Wichita for all cost of engineering, inspection, and construction.

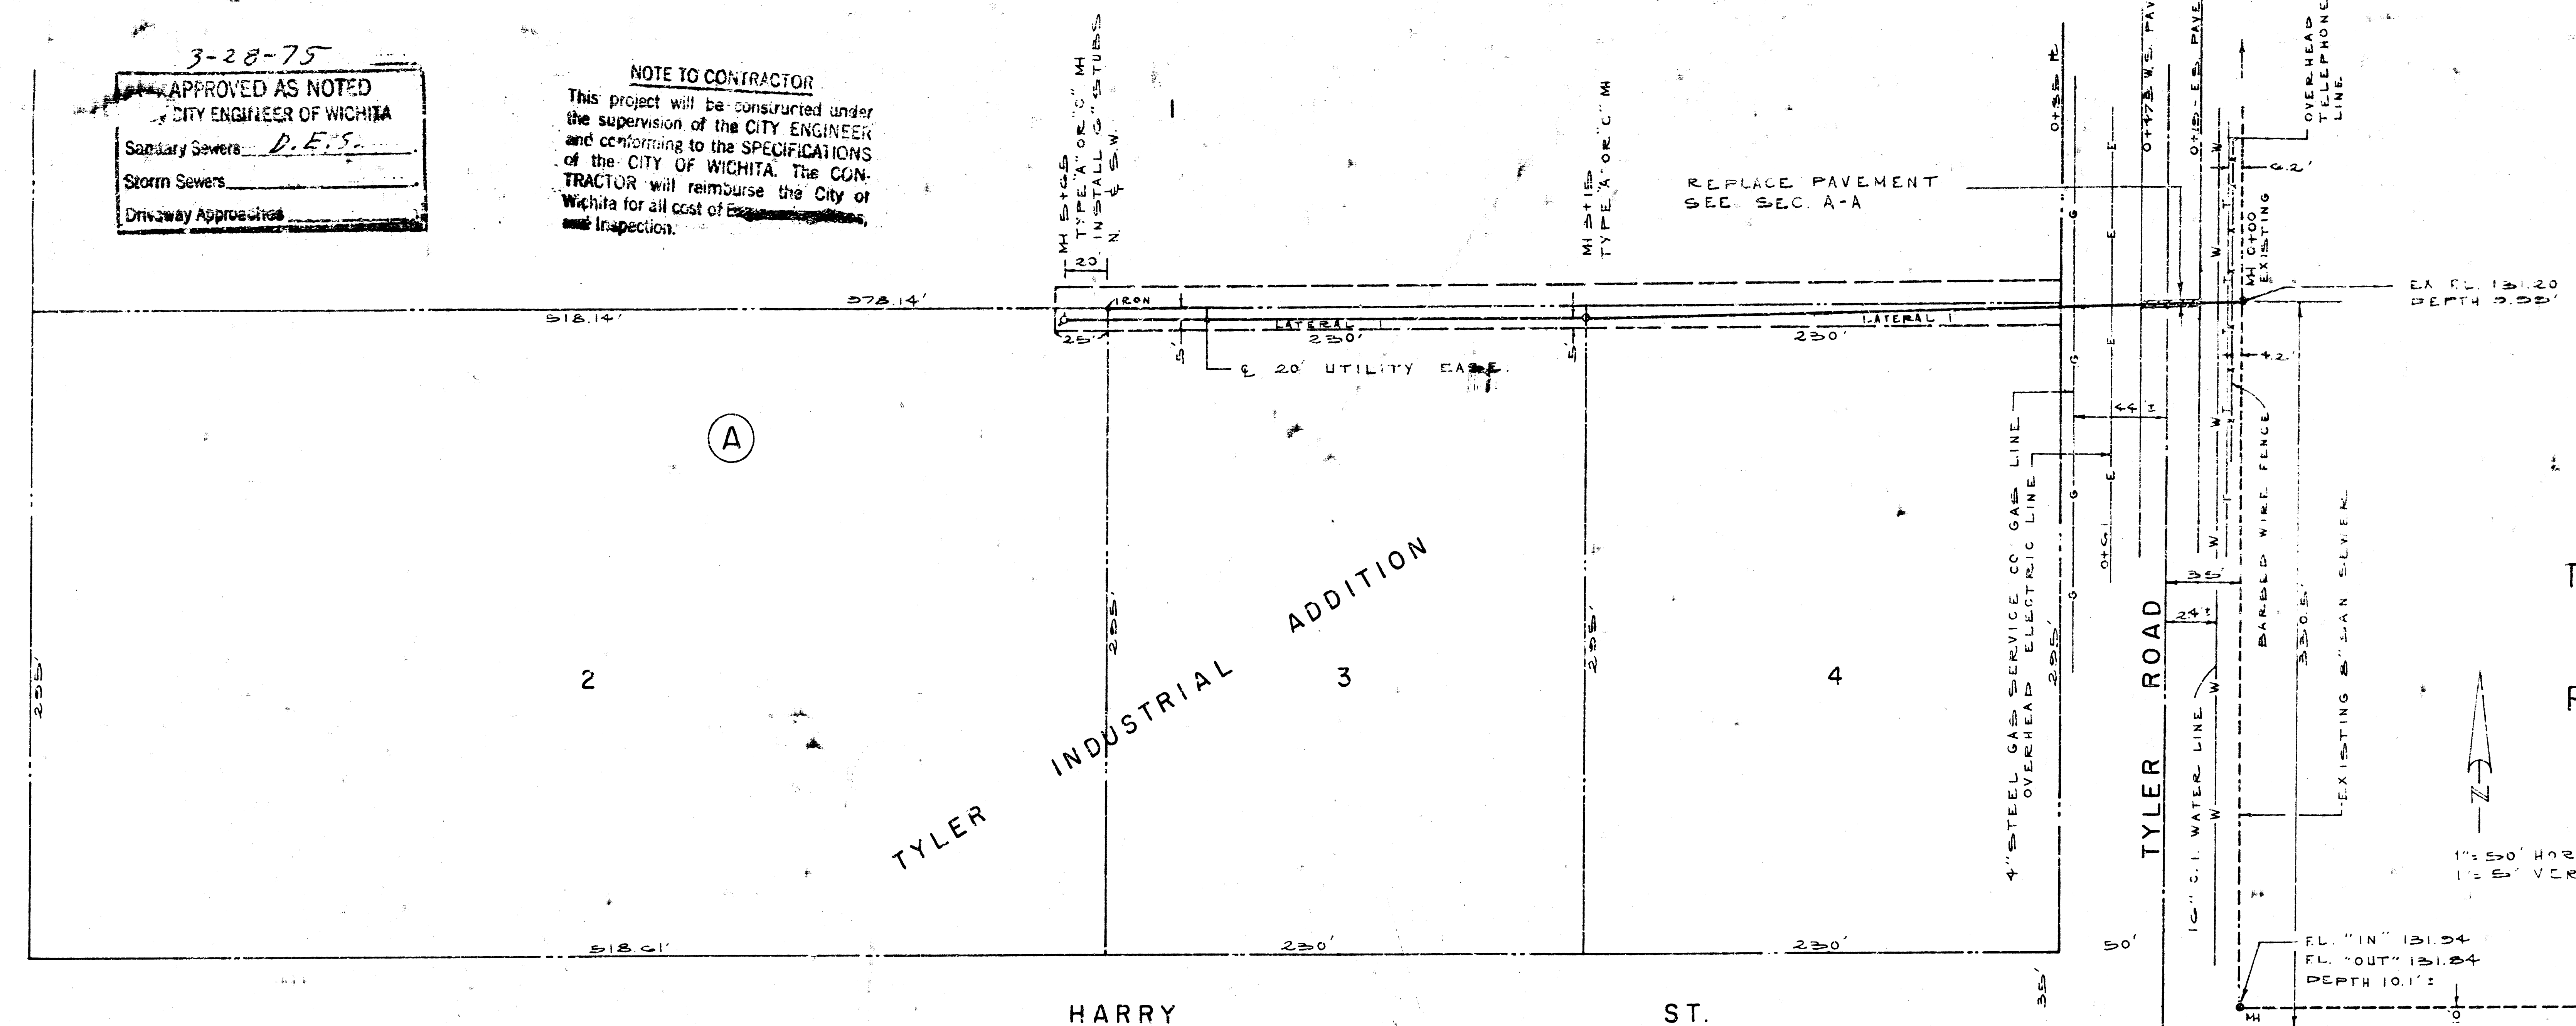

TYLER INDUSTRIAL ADDITION
SANITARY SEWER
PROJECT NO. DBKW 705007

K.O. TAYLOR, P.E.
MARCH 25, 1975

CONTRACTOR MUST NOTIFY THE
GAS SERVICE CO. AND THE
CITY OF WICHITA WATER DEPARTMENT
BEFORE COMMENCING WORK.

