

VETERANS ADMINISTRATION
WASHINGTON, D. C.

APPROVED *Frank D. Hines*
ADMINISTRATOR


James J. Davis
ASSISTANT ADMINISTRATOR

W. H. H.
DIRECTOR OF CONSTRUCTION

W. H. H.
CHIEF, TECHNICAL DIVISION

"AS BUILT"
STORM & SANITARY SEWERS
Scale 1"=50'-0"

PLOT PLAN		
VETERANS ADMINISTRATION HOSPITAL WICHITA, KANSAS.		
DESIGNED BY	REVISIONS	NUMBER
W. H. H.	1-21-45 C.W.W.	5
W. H. H.		
W. H. H.		
W. H. H.		
DATE: 1-21-45		SHEET 5 OF 10

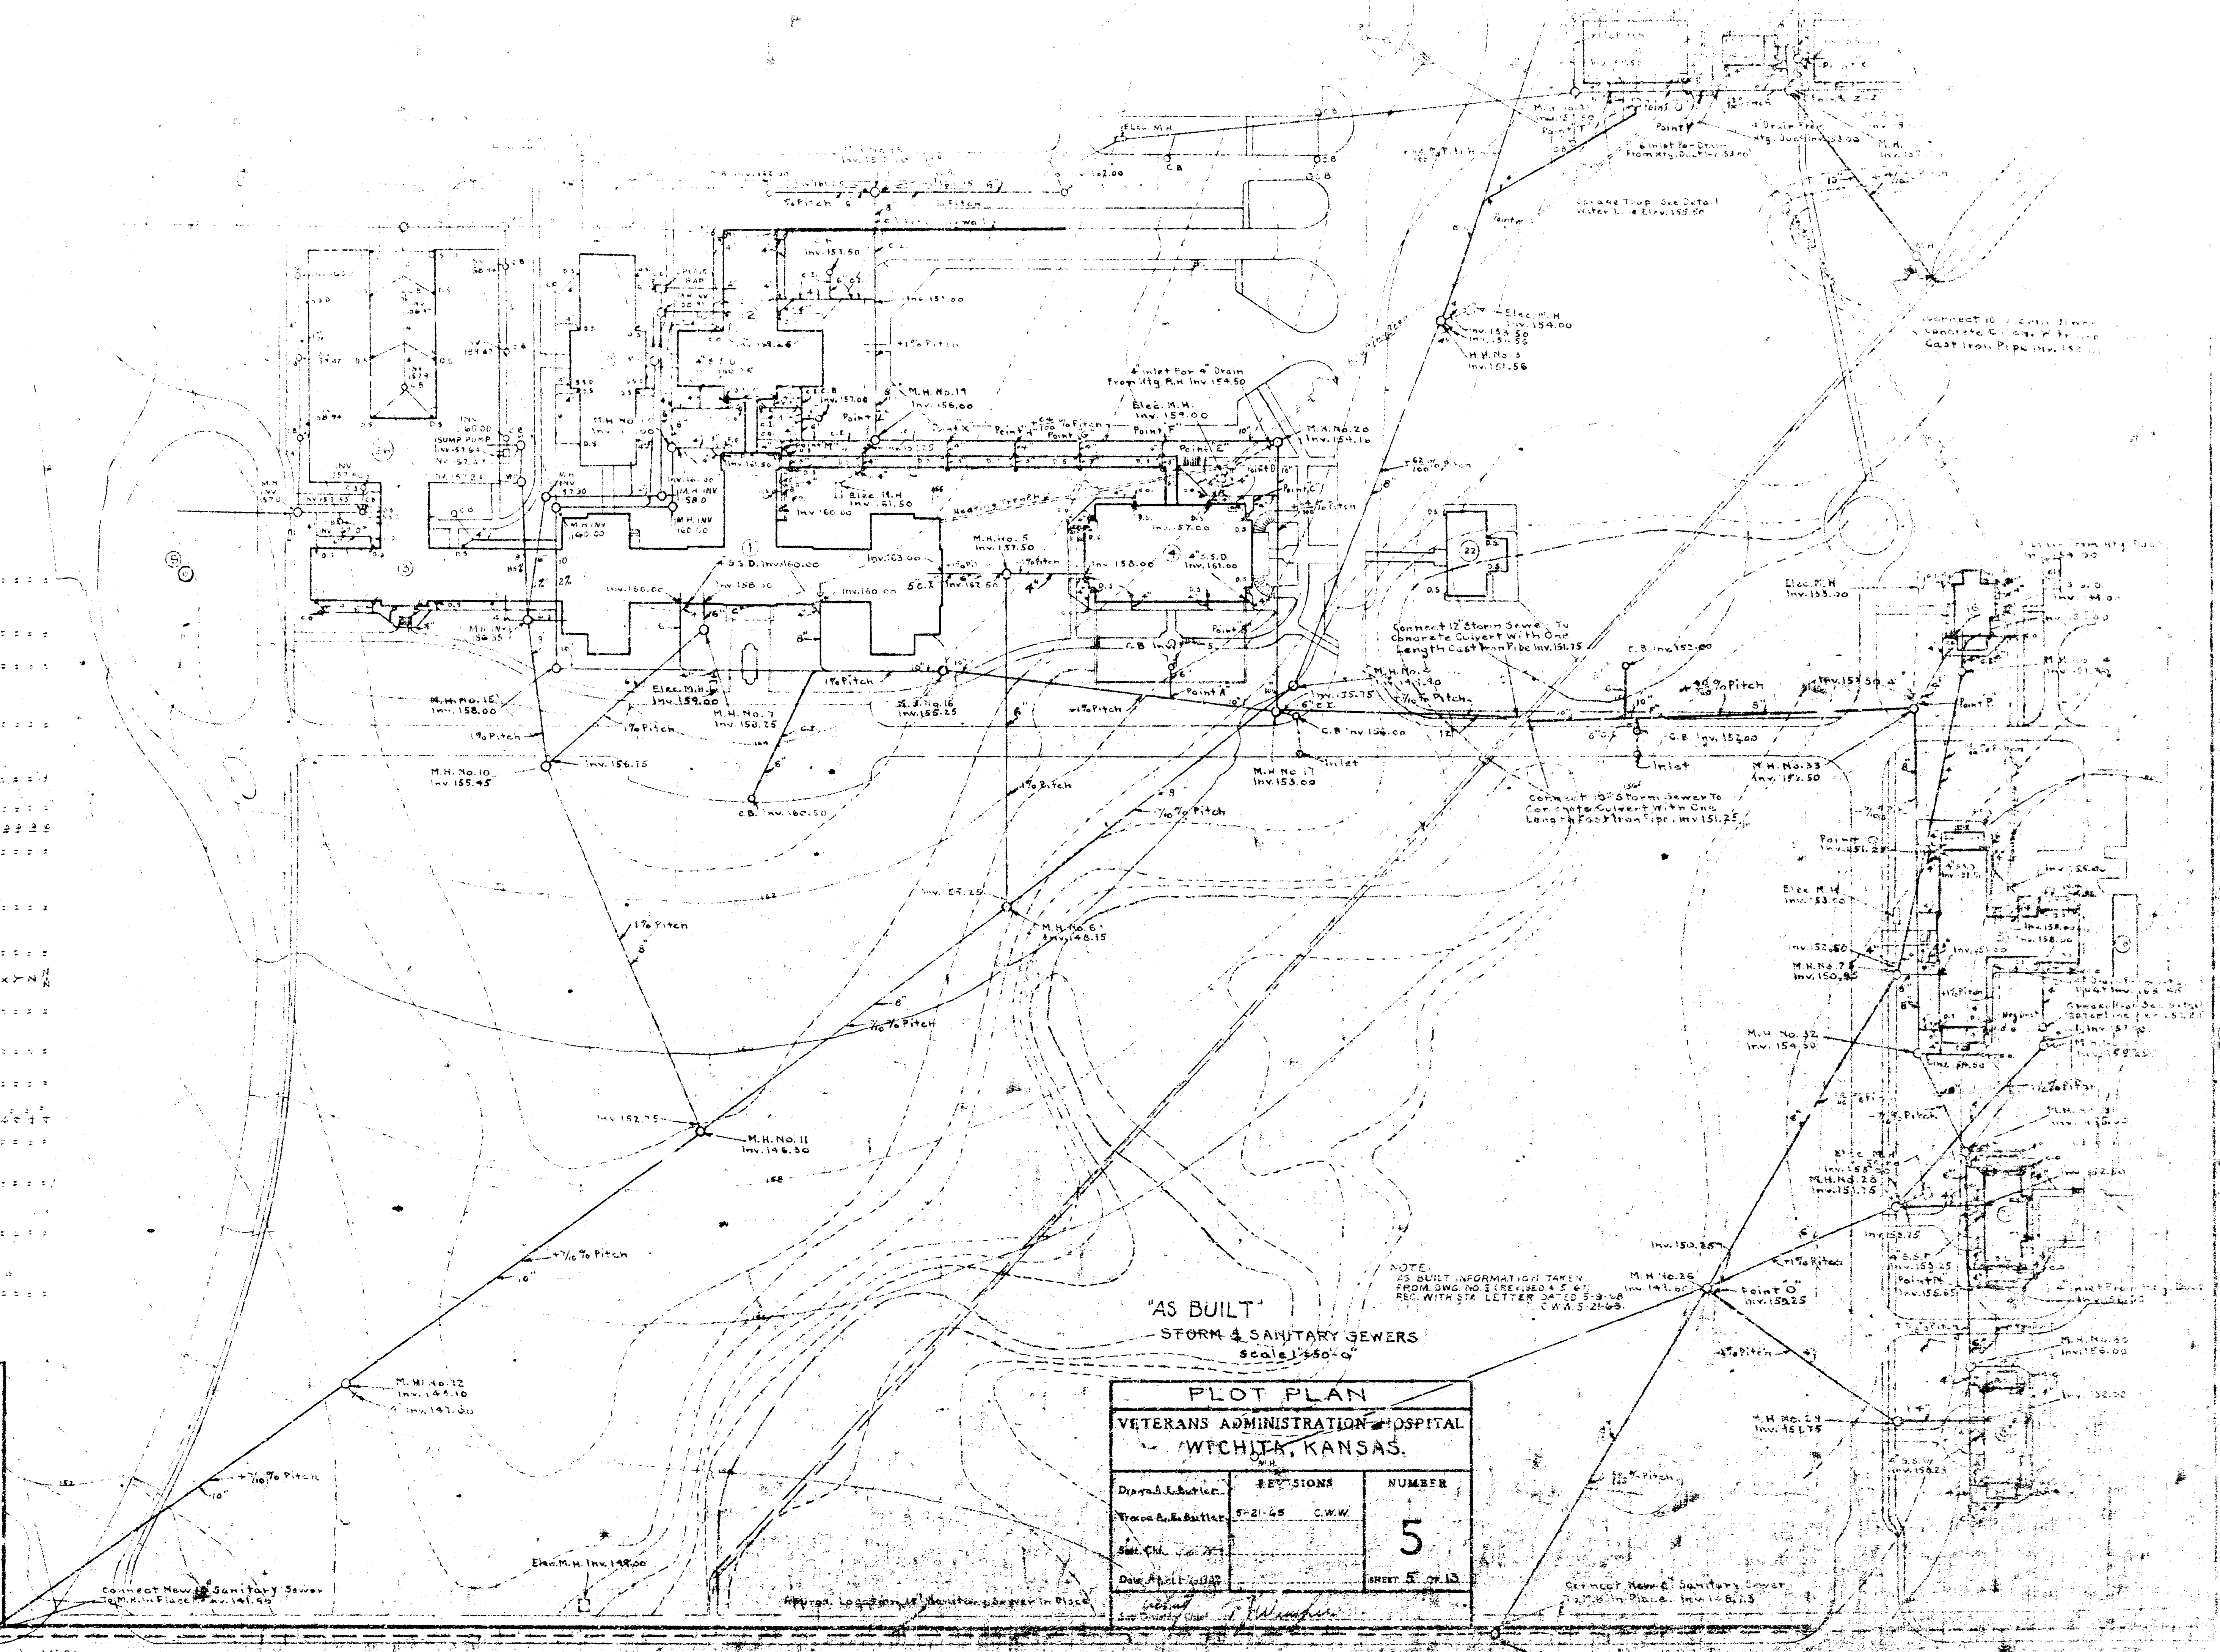

NOTE:
AS BUILT INFORMATION TAKEN
FROM DWG. NO. 1-21-45 & 1-22-45
REV. WITH LETTER C.W.W. 5-21-45.

Connect New Sanitary Sewer
to Main Line at Point A

Connect New Storm Sewer
to Main Line at Point B

VETERANS ADMINISTRATION
WASHINGTON, D. C.

APPROVED *Frank G. Hines*
ADMINISTRATOR
George E. Jones
ASSISTANT ADMINISTRATOR
W. H. Smith
DIRECTOR OF CONSTRUCTION
W. H. Smith
CHIEF, TECHNICAL DIVISION

ALTERNATE NOTE:
Provide 1" Capped Outlet With Valve At Point X if Building No. 10 Is Built Without

Water and Meter Pit Furnished
And Installed By Water Co.
Connect 8" Hard Water
To 6" City Water At Curb
8" Water Main Installed By Water Co.

NOTE:
AS BUILT INFORMATION TAKEN FROM
DWG. NO. 6 (REVISED 6-6-57) REC.
WITH STA. LETTER DATED 3-9-58
C.W.W. 6 3-58

"AS BUILT"
WATER & GAS

PLOT PLAN
VETERANS ADMINISTRATION HOSPITAL
WICHITA, KANSAS

Drawn By	REVISIONS	NUMBER
Tracy H. Smith		6
Sett. Chg. 1-1-57		
Date April 2, 1957		SHEET 6 OF 15
Sub-Division Chief <i>W. H. Smith</i>		

RETURN TO: WICHITA, KANSAS

FILE FOLDER NO.