


PROFILE	SURVEYED	B.V.	DATE
NOTE BOOK	PLOTTED		
NO.	GRADES CHECKED		
	B.M.'S NOTED		
	STRUCTURE NOTATIONS CH'CD		

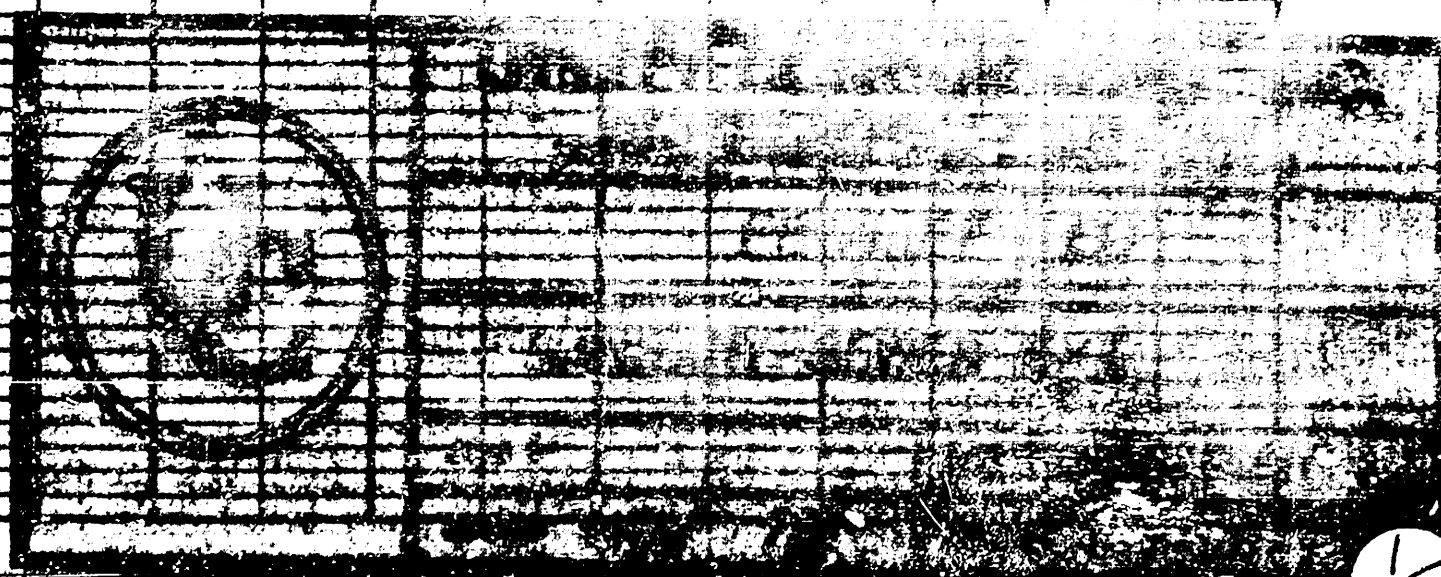

11-16-78

APPROVED AS NOTED
By CITY ENGINEER [Signature] VICHITA

Sanitary Sewers PCD

Storm Sewers _____

Driveway Approaches _____