

APPROVED AS NOTED
BY CITY ENGINEER OF WICHITA

Sanitary Sewers VRH 11/2/95

Storm Sewers _____


Driveway Approaches _____

Water Mains _____

Paving _____

NOTE TO CONTRACTORS

Inspection and testing for this project are to be provided by a Licensed Consulting Engineering Firm under contract with the Owner/Developer. Soil inspection to be in accordance with the City of Wichita standard construction engineering practices and performed by a Licensed Professional Engineer. No work shall be performed in discolored easements or public right-of-way by the Contractor without such inspection, nor shall any work be commenced without written authorization by the City Engineer.

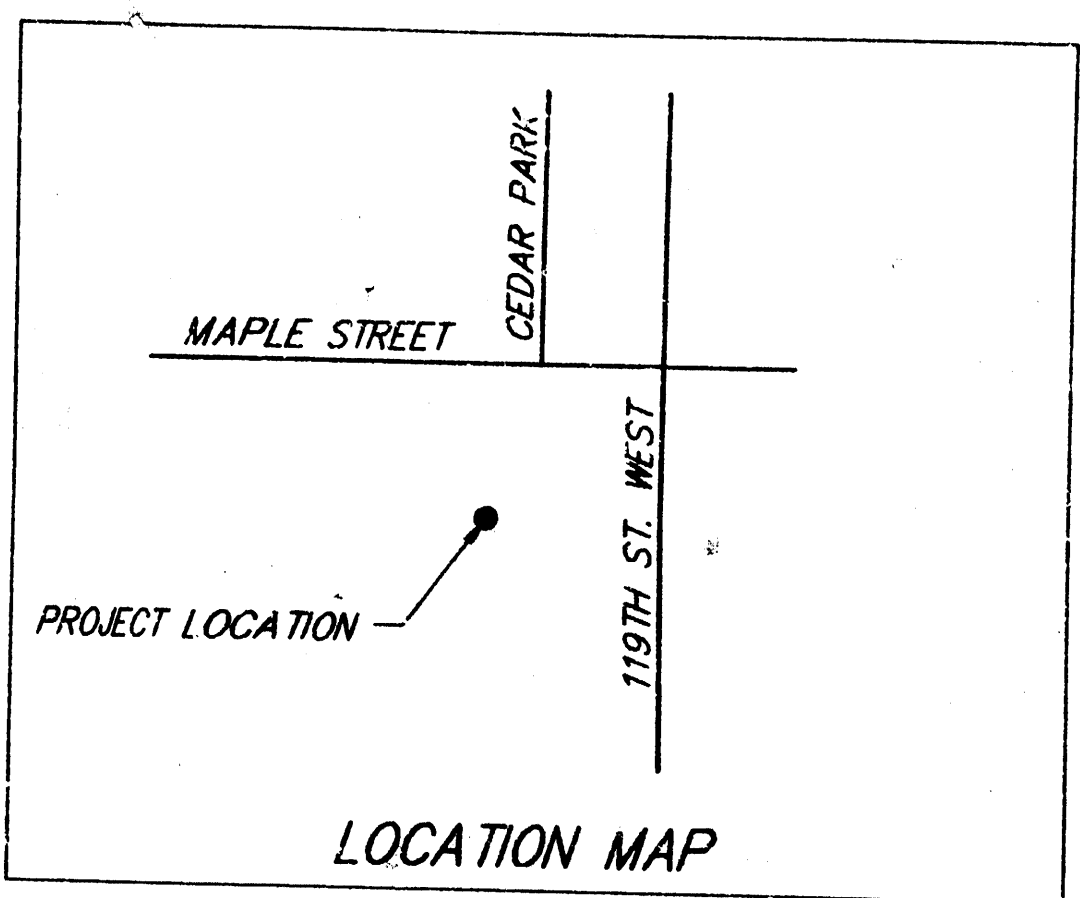

STATION 0+00 - CONNECT TO EXISTING MANHOLE. TOP ELEVATION = 129.47 CITY DATUM

EXISTING 18" SAN. SEWER

BENCH MARK: CITY DISK LOCATED AT THE S.W. CORNER OF THE INTERSECTION OF MAPLE AND 119TH STREET WEST ELEVATION = 141.97 CITY DATUM

Scale: 1" = 40' Plan
1" = 5' Profile (Vert.)
= Iron

GENERAL NOTES

Contractor will be required to provide a minimum advance notice of twenty-four (24) hours to utility companies prior to starting any excavation as follows:

Kansas One-Call 687-2470

The Contractor must notify the following in case of an emergency:



Cablevision 262-4270 or 263-2061
K.G.&E. Gas 383-8650
K.G.&E. Electric 383-8600
People's Natural Gas Company 942-8350 or 263-8161
Southwestern Bell Telephone Company 1-571-2611
City of Wichita Water Department 268-4908
City of Wichita Sewer Maintenance 268-4071

Underground utility service lines and overhead utility pole lines are to be adjusted as necessary by others prior to construction unless the plans specifically call for their adjustment by the Contractor or unless the plans specifically identify a utility to be adjusted by its owner during construction. Existing utilities and their location, as shown on the plans, represent the best information obtainable for design. Location information has been obtained from the various utility companies and is either from company record drawings or company-provided field locations. The Contractor will be required to work around existing utilities within the right-of-way which do not conflict with proposed construction.


The Contractor shall give all property owners and/or tenants of developed property directly abutting the construction of this project a minimum of ten (10) days advance notice prior to start of construction.

Pavement removal and/or replacement will be measured and paid for on the lineal foot basis as measured along the centerline of the water line regardless of width, pavement type and/or pavement thickness. Minimum limits of such pavement removal and replacement shall be one foot beyond the limits of the excavation made for the water line or the structure, except when such saw cuts are within three (3) feet of an existing joint the limits of removal shall be extended to the existing joint. Removal and replacement of existing pavement shall conform to the applicable sections of the City of Wichita Standard Specifications.

Contractor shall seed, fertilize and mulch all disturbed areas per City specifications.

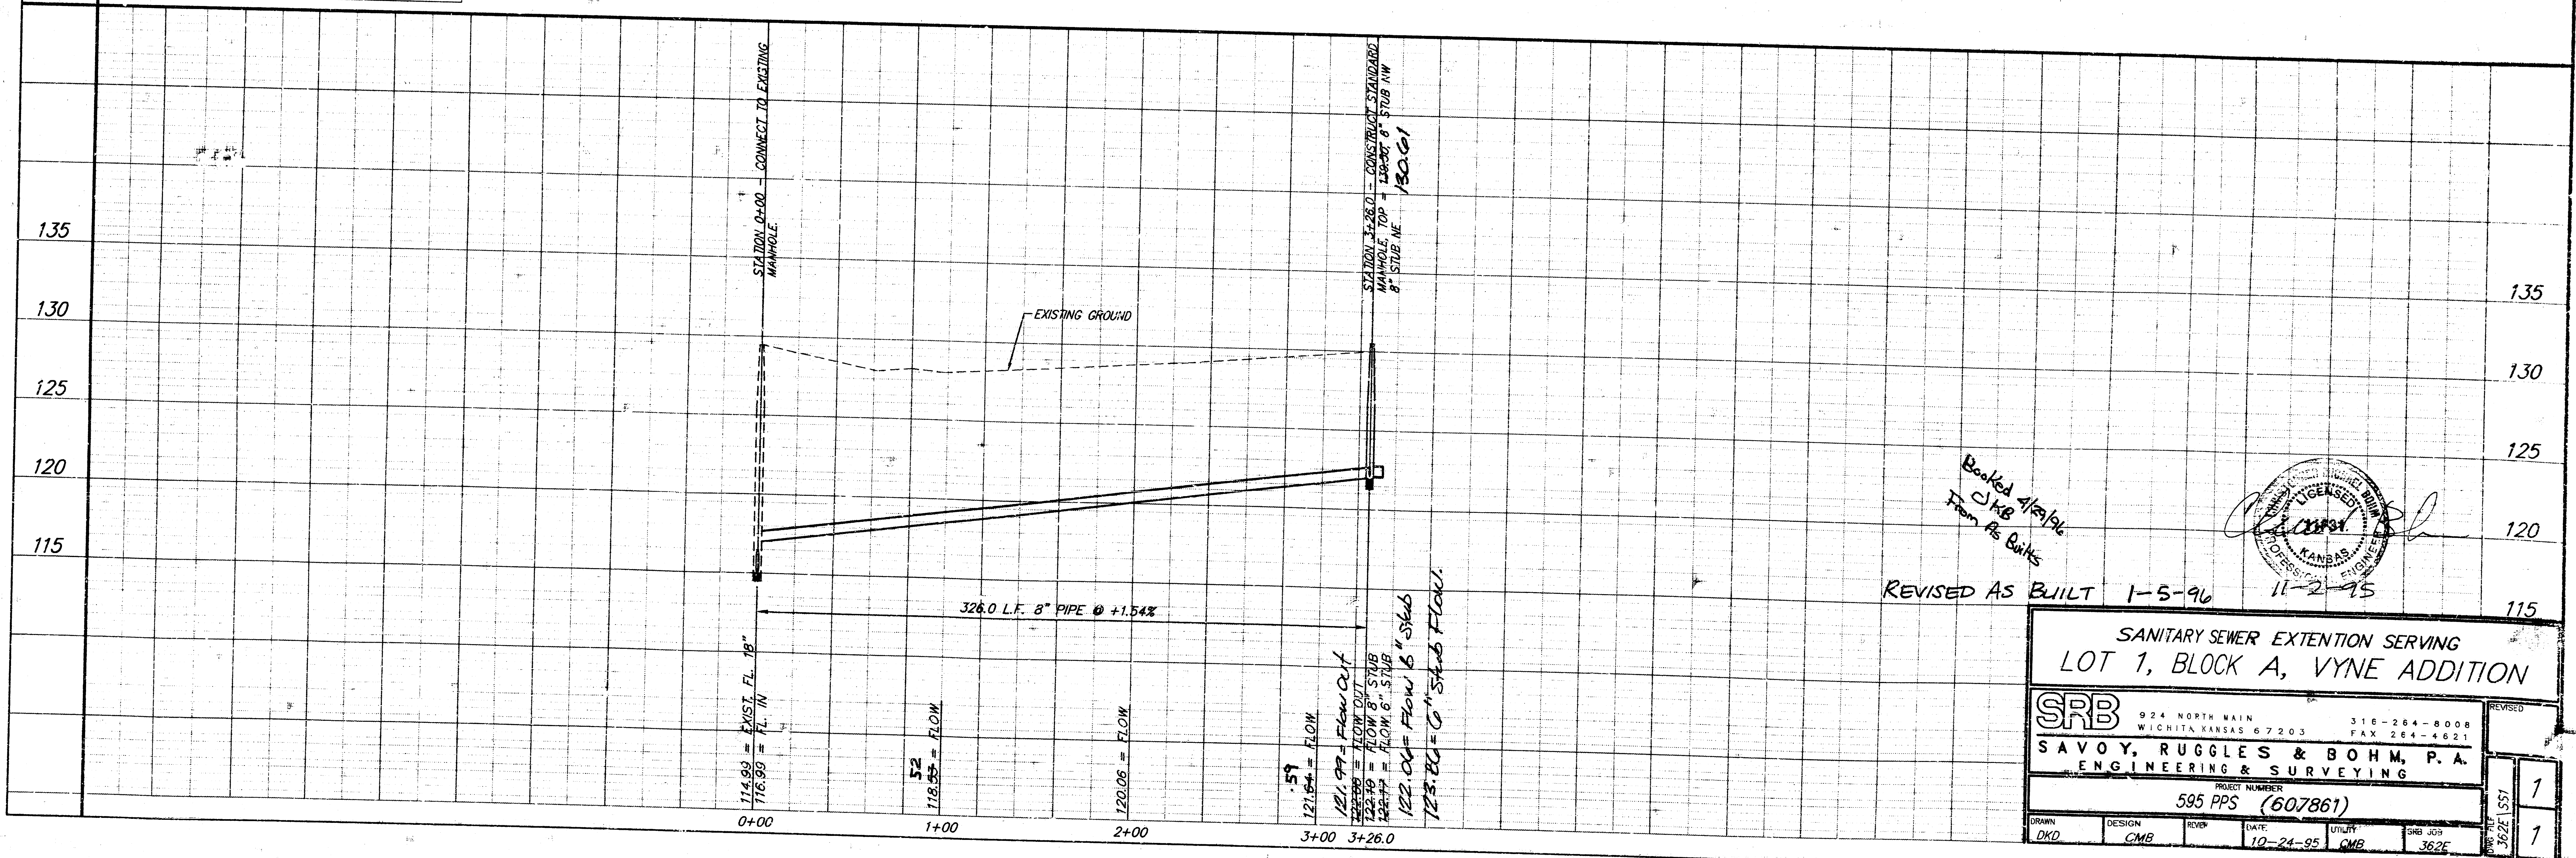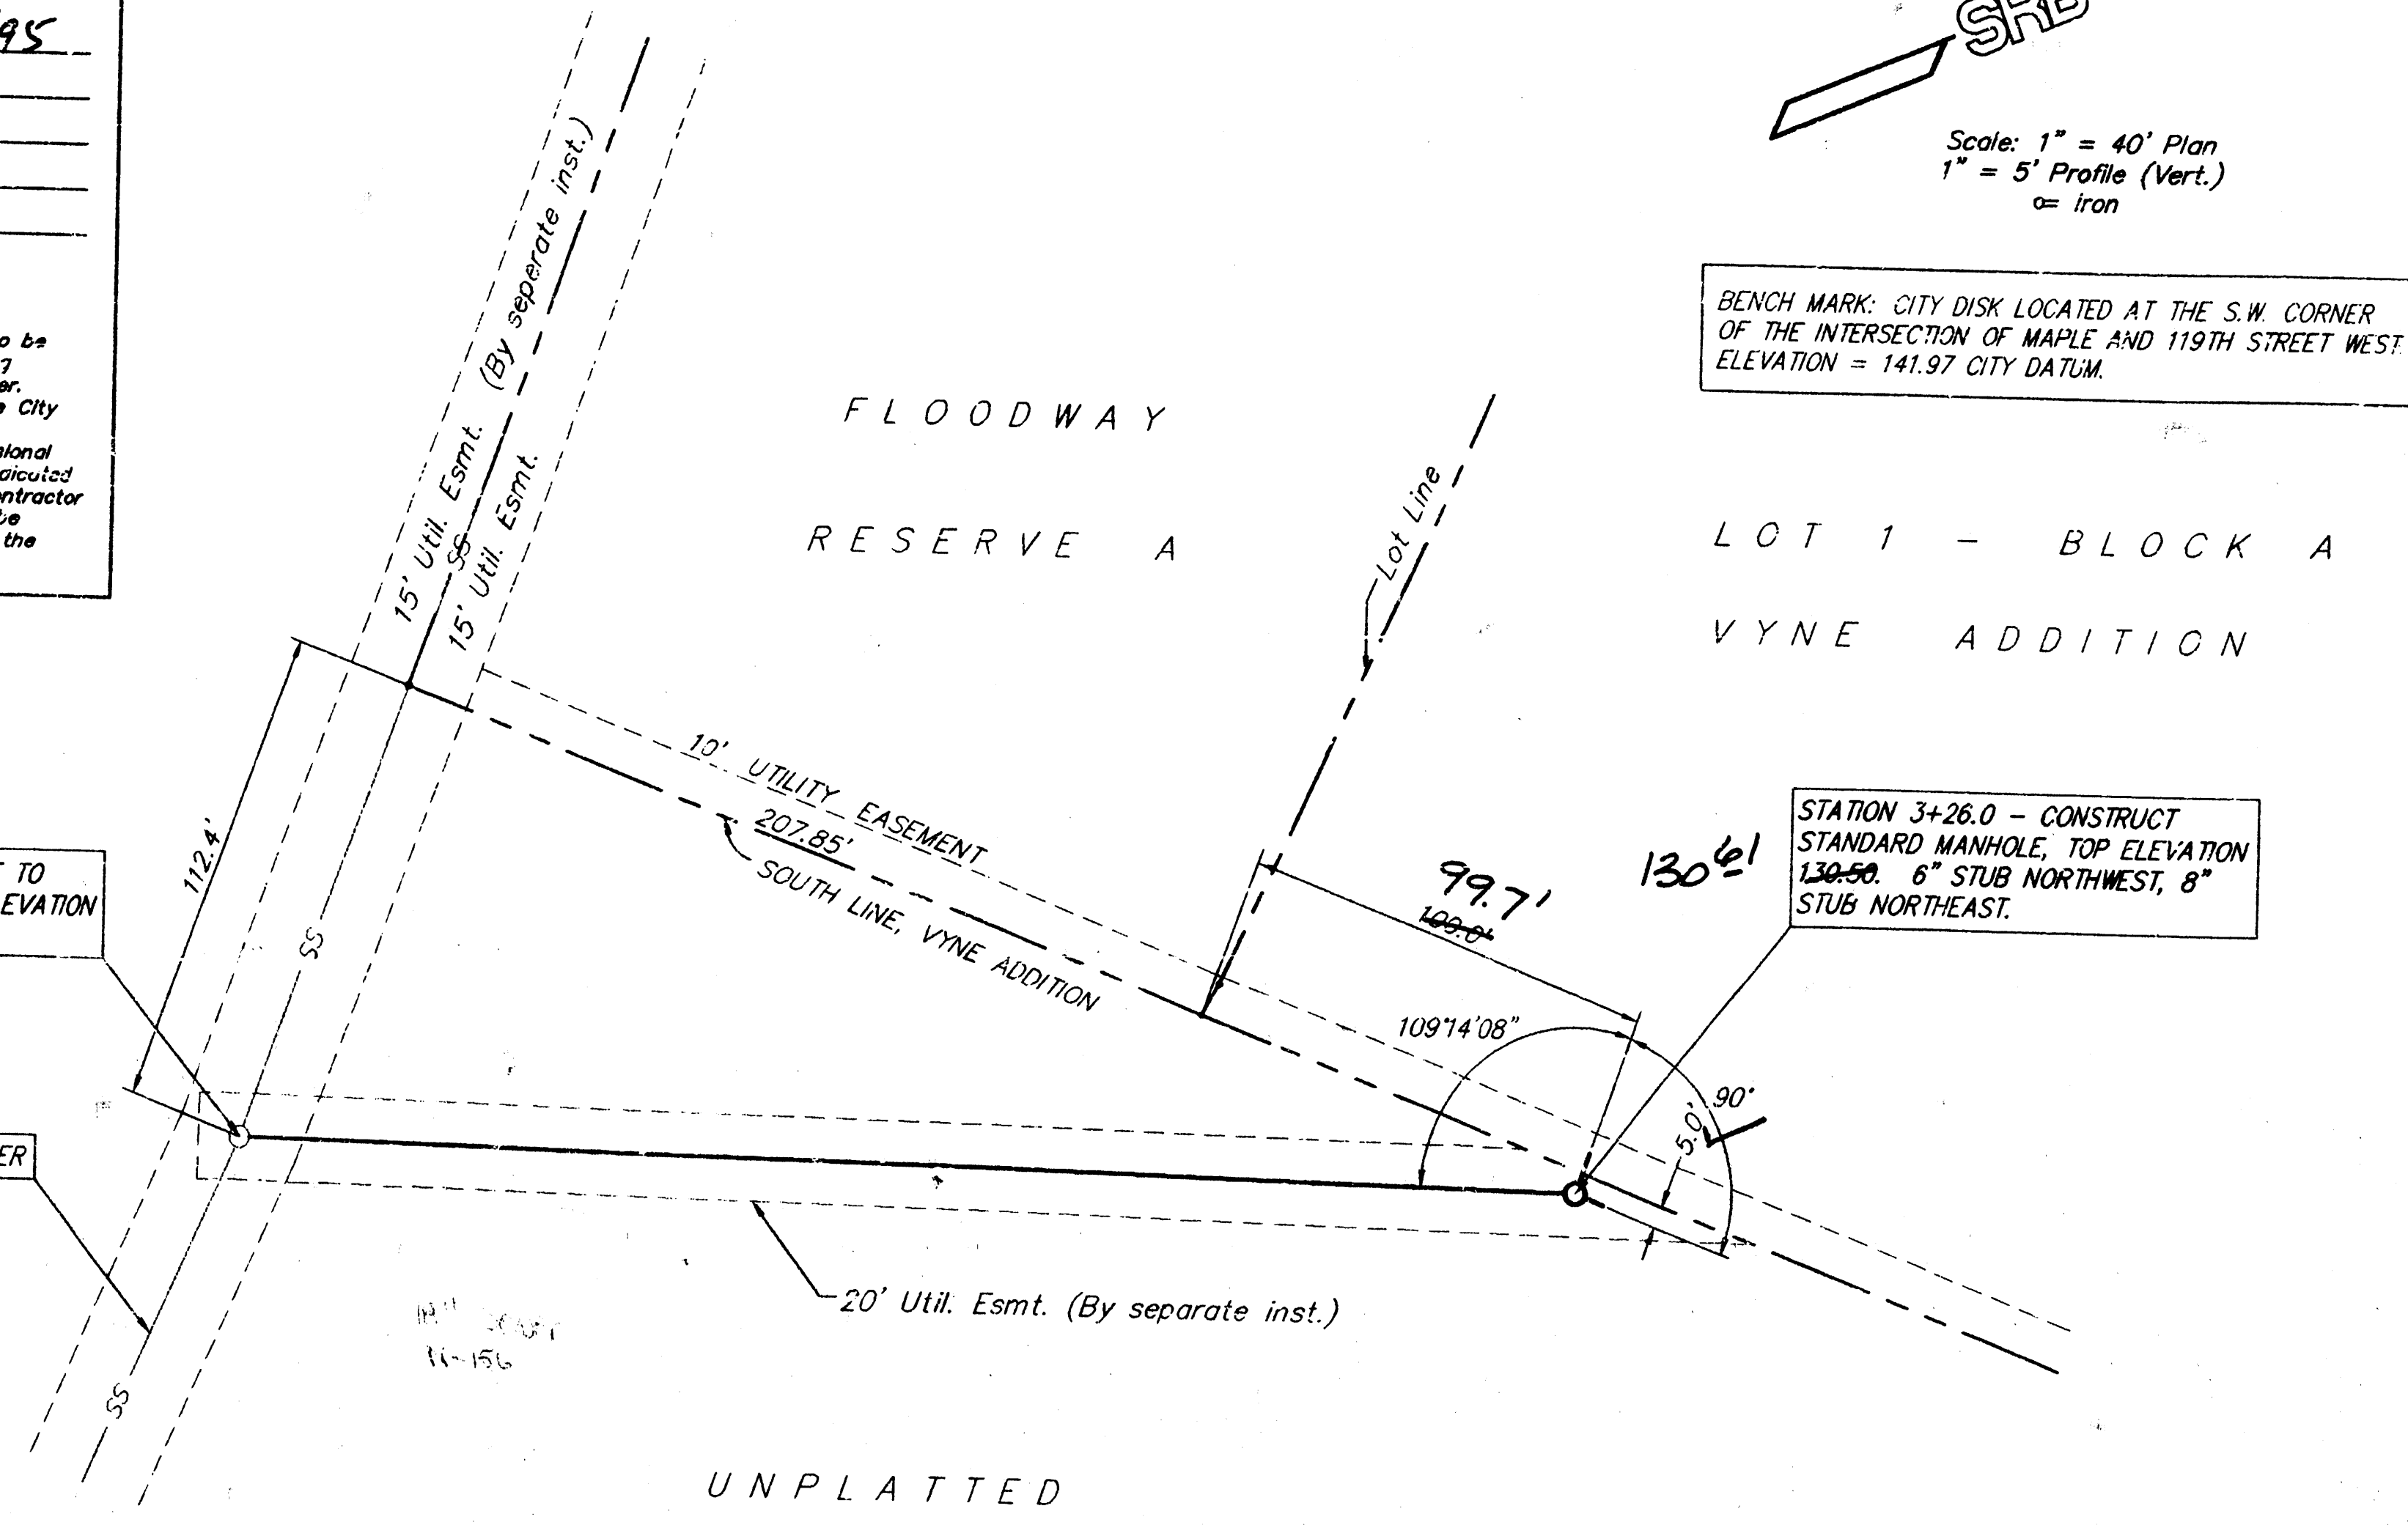

Revised As Built 1-5-96

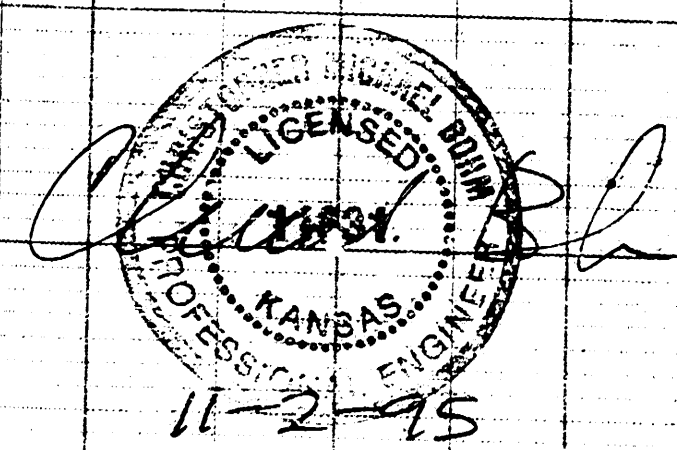

Booked 4/14/96
CMB
From R. Buick

REVISOR

1

1

362Z US7

362Z

SAVOY, RUGGLES & BOHM, P.A.
ENGINEERING & SURVEYING

PROJECT NUMBER
595 PPS (607861)

DRAWN: DKD
DESIGN: CMB
CHECK: CMB
DATE: 10-24-95
UTILITY: CMB
SHEET: 362Z