



PLAN	SURVEYED	DATE	1
NOTE BOOK	PLOTTED	BY	2
No.	ALIGNMENT CHECKED	BY	3
	BY WAY CHECK	BY	4

1. Contractor shall contact the Sewer Maintenance Division of the Dept. of Public Works to arrange for the taps on the existing 8" VCP (Lines 1 and 3). Any costs or fees for such taps shall be included in the Contractors bid.
2. Contractor to verify locations of underground utilities prior to any excavation.
3. Contractor shall preserve property corner irons. Any such irons disturbed by the Contractors operations shall be re-established at the Contractor's expense, by a licensed surveyor in accordance with state law.
4. Trees and fences to be removed as necessary for construction.

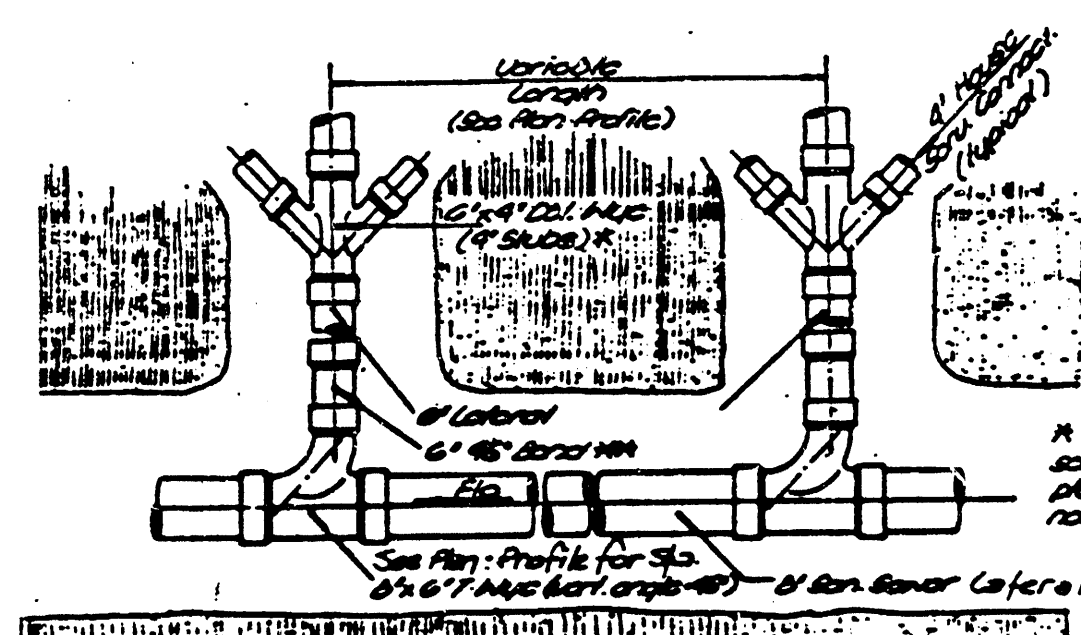


PLAN VIEW

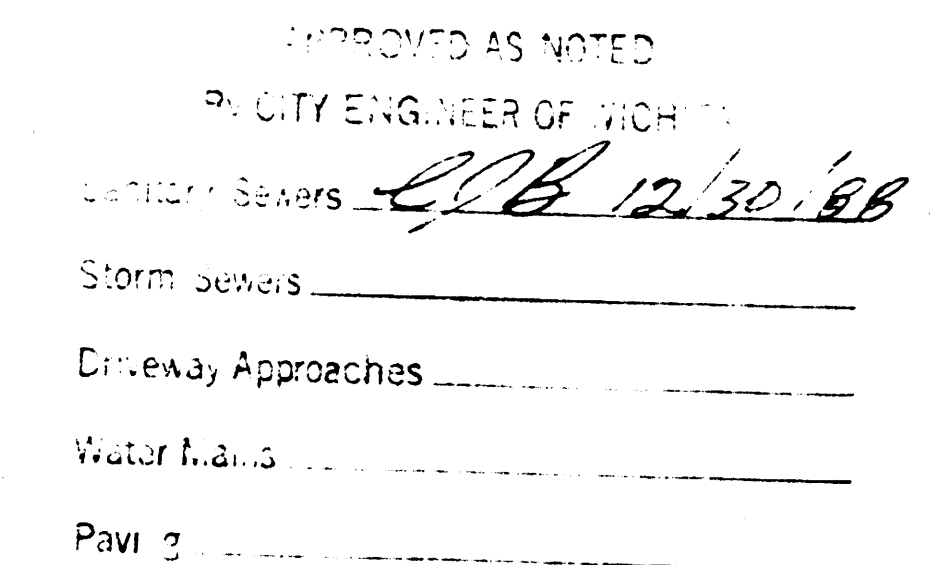

NOTE TO CONTRACTOR

INSPECTION AND TEST LOG FOR THIS PROJECT IS TO BE PROVIDED BY A LICENSED CONSULTING ENGINEERING FIRM UNDER CONTRACT WITH THE OWNER/DEVELOPER. SAID INSPECTION TO BE IN ACCORDANCE WITH THE CITY OF WICHITA STANDARD CONSTRUCTION METHODS AND PRACTICES AND CERTIFIED BY A LICENSED PROFESSIONAL ENGINEER. NO WORK SHALL BE PERFORMED UNTIL THE INSPECTION REPORTS AND THE PAYMENT OF WAVEY'S CONTRACTOR'S RETAINAGE CHARGEMENT OR SHALL ANY OTHER CITY OF WICHITA REQUIREMENTS BE MET AND FULFILLED BY WITHOUT WRITTEN AUTHORIZATION BY THE CITY ENGINEER.

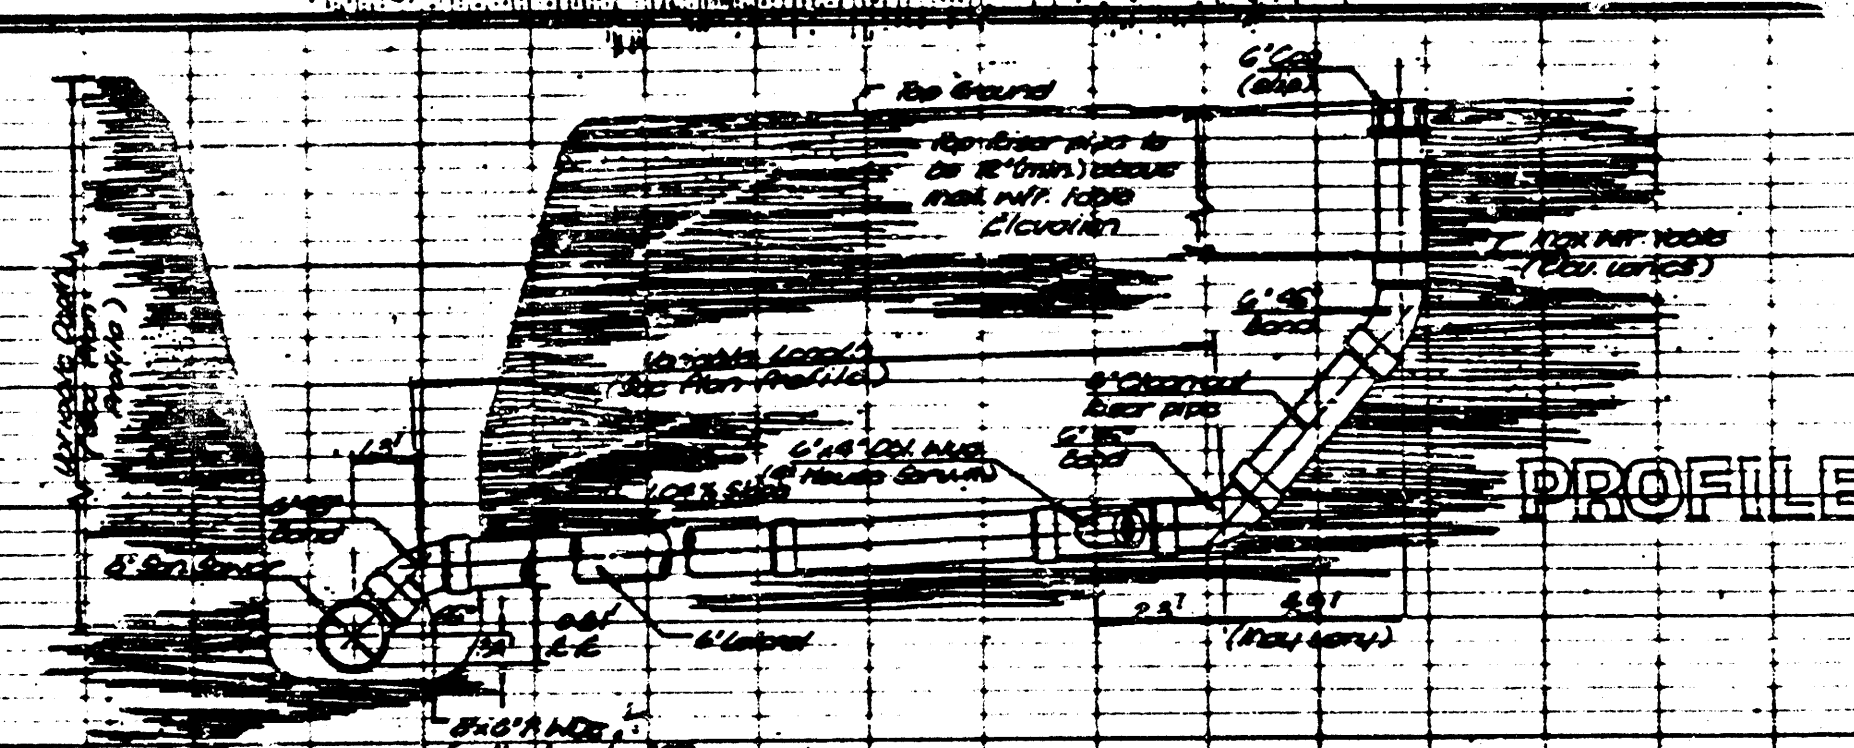[illegible]

Revised as-built 3-10-89

PROJ. NO. 468-16-2A7-00001-000-000-17  BAUGHMAN COMPANY, P.A. SURVEYING & ENGINEERING 316/262-7271 • 315 ELLIS • WICHITA, KANSAS 67211					Sheet 1 of 1
Design: TCR	Drawn: TCR	Approved:	Date: 20 DEC 88	Scale: 1" = 40'	1

**FILMED FROM THE BEST
AVAILABLE COPY.....**