

SANITARY SEWER IMPROVEMENTS

to serve Washington Elementary School

1600 E. 3rd Street
CITY OF WICHITA, KANSAS

Michael E. Lindorff, P.E. City Engineer

Private Project Number

1168 PPS (607861)

GENERAL NOTES:

- Contractor will be required to provide notice to utility companies a minimum of twenty-four (24) hours prior to any excavation, as follows:

Kansas One-Call 687-2470

The Contractor must notify the following in case of an emergency:

Cox Communications 262-0661
Kansas Gas Service 383-8600
Kansas Gas & Electric Company 383-8600
Peoples Gas Company 942-6350
Southwestern Bell Telephone Company 1-800-344-7233
City of Wichita Water Dept. 268-4908
City of Wichita Traffic Engineering 269-4446

- Underground utility service lines and overhead utility pole lines are to be adjusted as necessary by others prior to construction unless the plans specifically call for their adjustment by the Contractor or unless the plans specifically identify a utility to be adjusted by its owner during construction. Existing utilities and their location, as shown on the plans, represent the best information obtainable for design. The Contractor will be required to work around existing utilities within the right-of-way which do not conflict with proposed construction.

- Contractor shall not start work on the project until the project inspector is assigned to the project and is present on the site. Any work done without inspection will be required to be uncovered for inspection.

- The Contractor shall be responsible for preserving property irons. The Contractor will be required to re-establish any property irons which are damaged or destroyed by his construction operations. Such irons shall be re-established by a licensed land surveyor in accordance with state laws.

- Rubble from the removal of miscellaneous structures and excess excavation which is to be wasted shall be disposed of on sites to be provided by the Contractor. These sites shall be approved by the Engineer as to suitability, appearance and site location. Locations that, in the opinion of the Engineer, will leave an unsightly appearance will not be approved. All disposal sites must be approved by the Kansas Department of Health and Environment. Material either stockpiled or disposed of in a flood plain would require a Kansas State Board of Agriculture permit. Any material dumped in waters of the United States or wetlands is subject to U.S. Corps of Engineers permitting regulations. Any material buried or stockpiled beyond approved construction limits would require additional archaeological investigations unless buried in a previously approved borrow location.

- When connecting to existing manhole or stub, the contractor shall reshape manhole bottom or adjust the existing stub's alignment or elevation as necessary.

- The Contractor shall be responsible for maintaining continuous flow of sewage through construction. Contractor's proposed method for maintaining sewage flow shall be approved by the Engineer.

- The Contractor shall be responsible for the connection between the proposed manhole and city main. The existing 10" sewer line has an existing trap in the general location of the proposed manhole. The Contractor shall contact the General Contractor of the proposed Washington School if the trap is removed. It is the proposed school's plumbing contractor's responsibility to replace the trap between the proposed school and proposed manhole.

AS-BUILT

8/13/02

MLL

LEGAL DESCRIPTION:

A tract in the NE 1/4 of Section 21, Township 27 South, Range 1 East of the 6th P.M., Sedgewick County, Kansas, described as beginning at a point 40 feet south and 30 feet west of the NE corner of said NE 1/4; thence west 270.7 feet, thence south 600 feet, thence east 270.6 feet, thence north 600 feet to the point of beginning.


BENCHMARK:

City of Wichita Benchmark Northeast corner of intersection of Hydraulic and Central located on the traffic signal. Elevation=111.70 (city datum).

SHEET INDEX:

Title Sheet 1
Manhole Detail 2
Copy of Survey 3

LOCATION MAP:

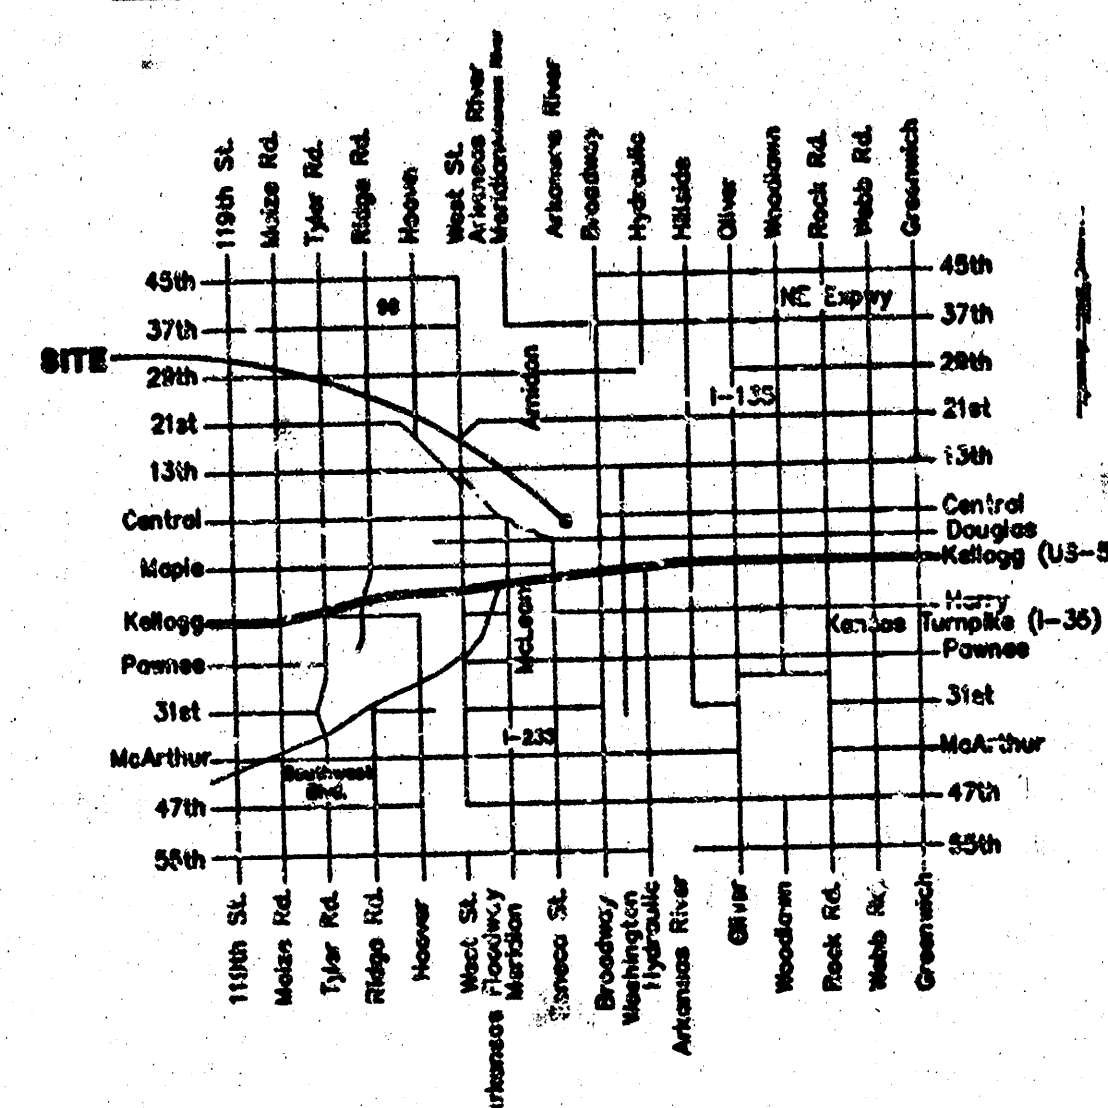


APPROVED AS NOTED
BY CITY ENGINEER OF WICHITA

Sanitary Sewer VRH 11/6/01

NOTE TO CONTRACTORS

Inspection and testing for this project is to be provided by a Licensed Consulting Engineering Firm under contract with the Owner/Developer. Said inspection to be in accordance with the City of Wichita standard construction engineering practices and certified by a Licensed Professional Engineer. No work shall be performed in dedicated easements or public right-of-way by the Contractor without such inspection nor shall any work be commenced without written authorization by the City Engineer. All construction and materials shall comply with the City of Wichita Specifications and Standards (on file and available in the City Engineer's Office).


9/14/02
RDL

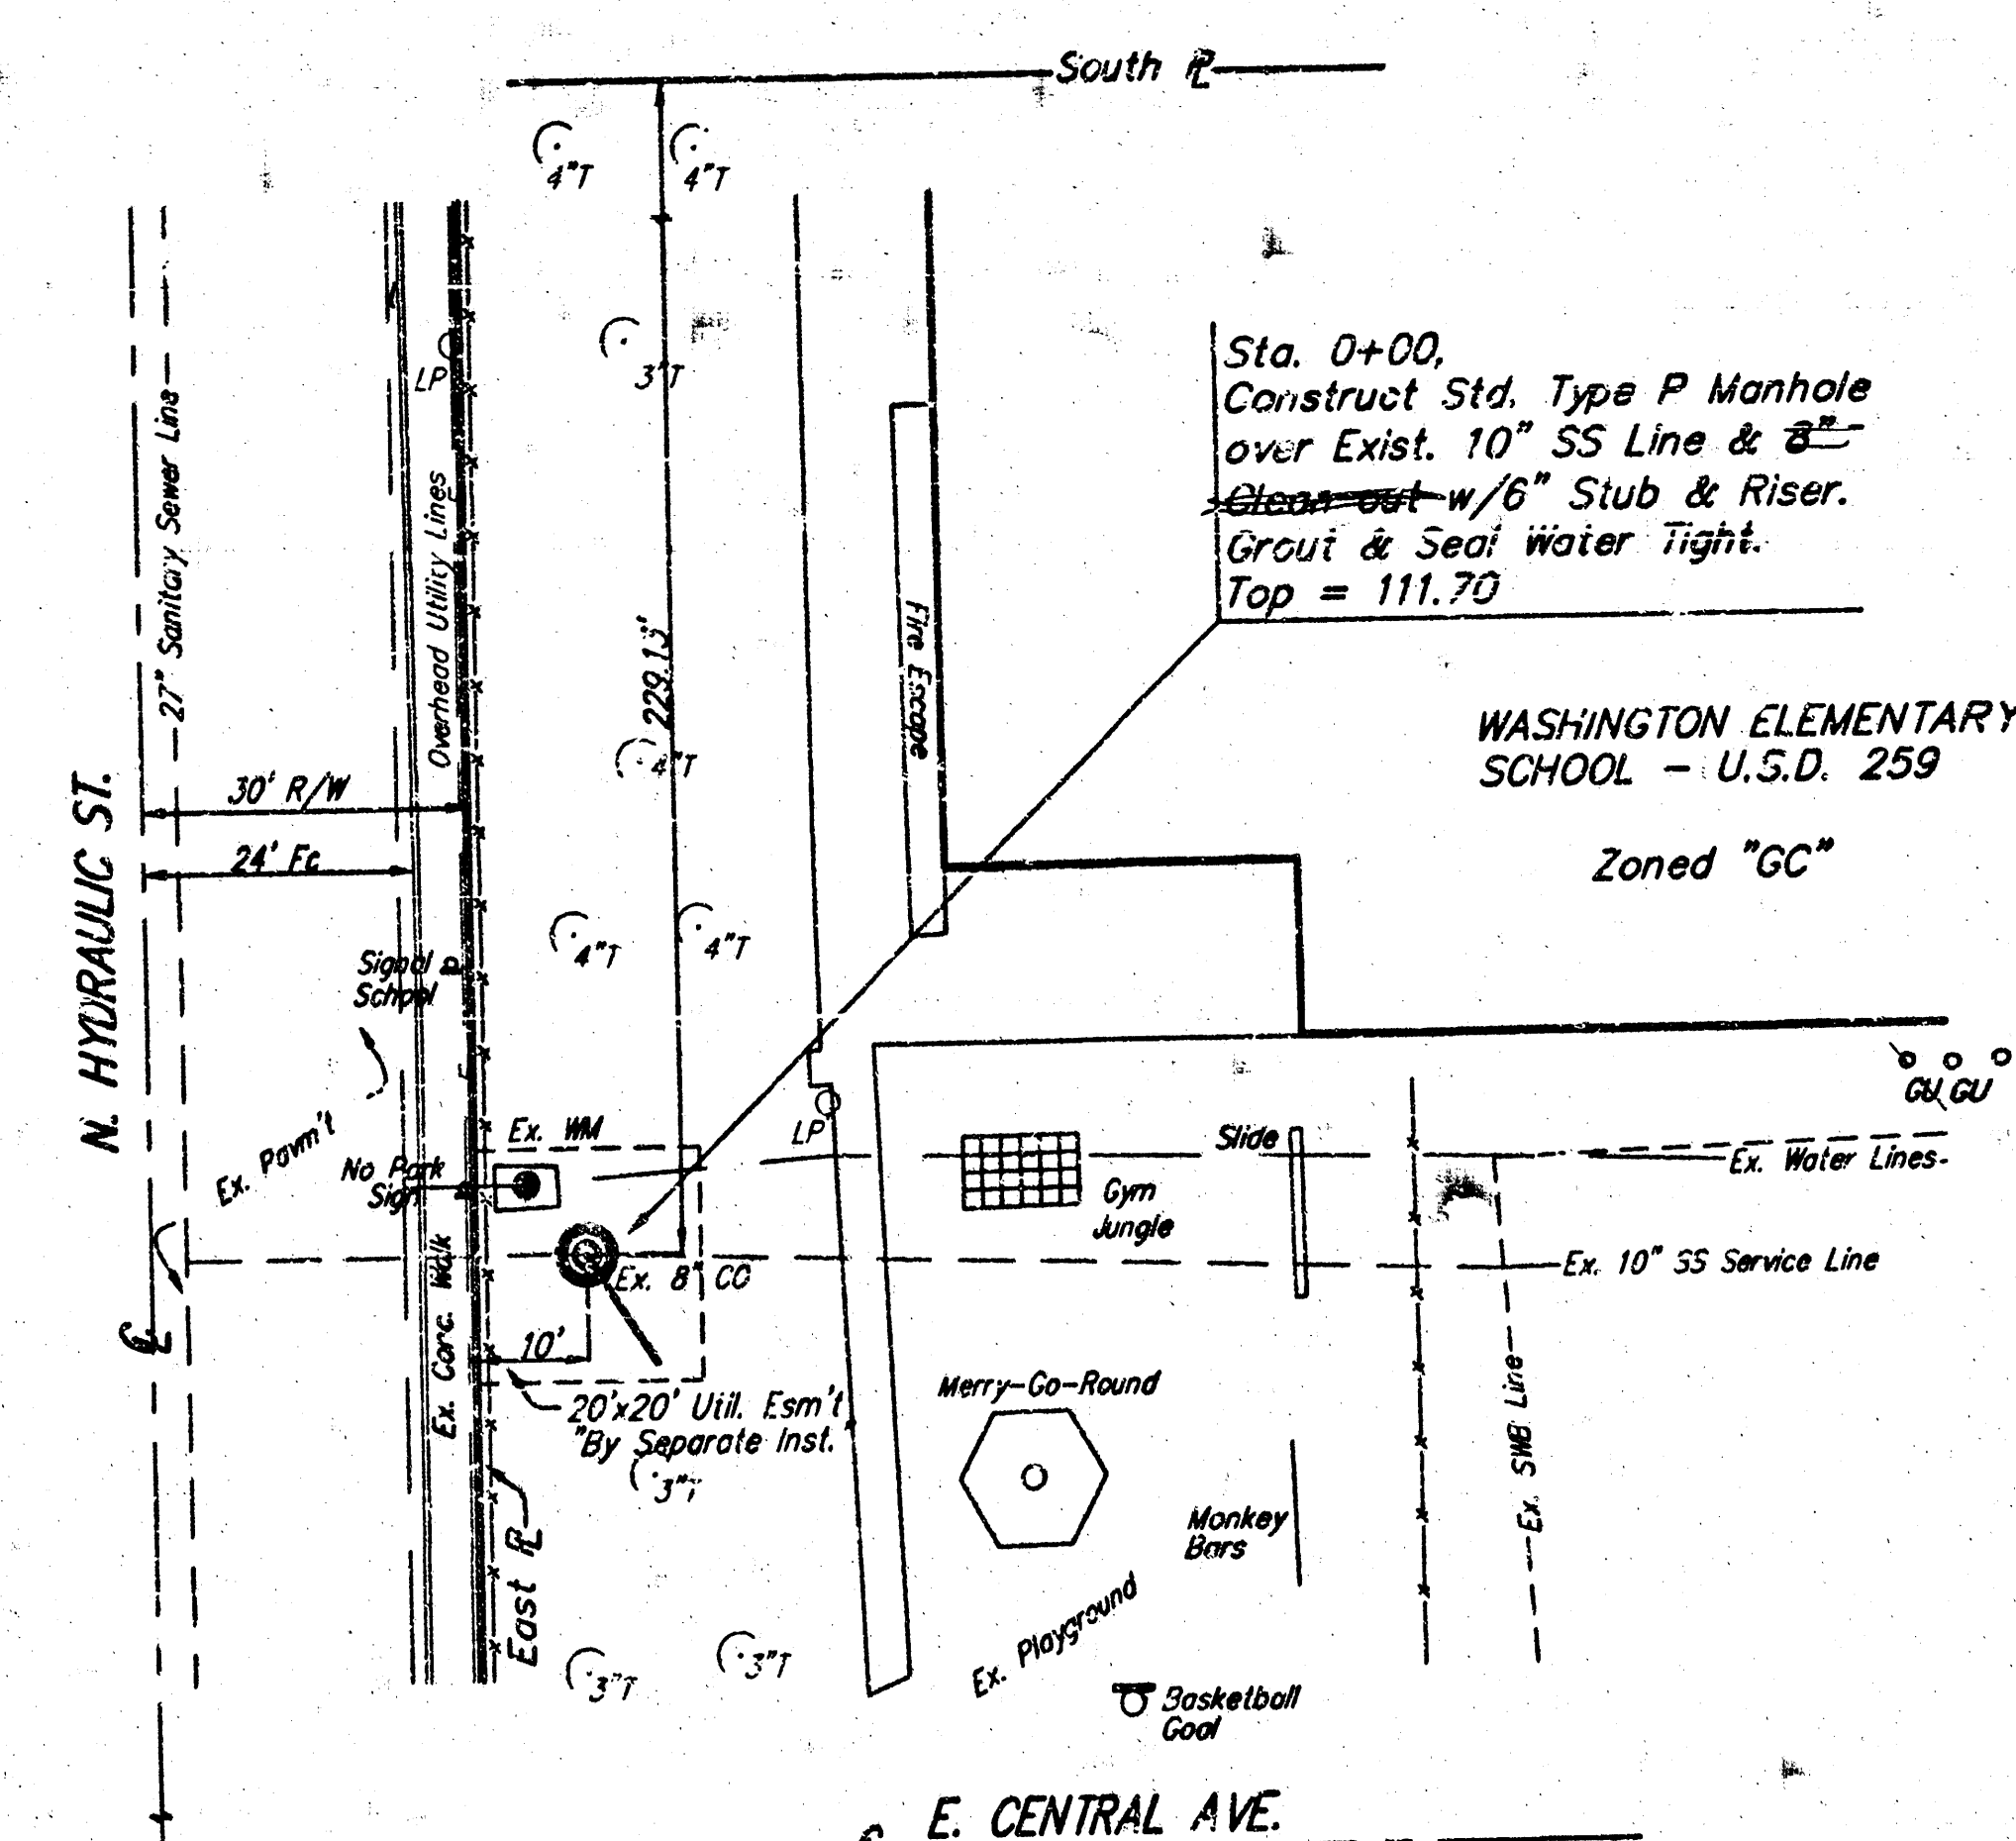

SCALE:
1" = 20' HORIZONTAL
1" = 5' VERTICAL
• = IRON

SEWER SERVICE TABLE

NUMBER	TYPE	FOR INFORMATION ONLY APPROXIMATE LENGTH 6" PIPE	
		VERTICAL	HORIZONTAL
1	6" Stub	2.5'	10'

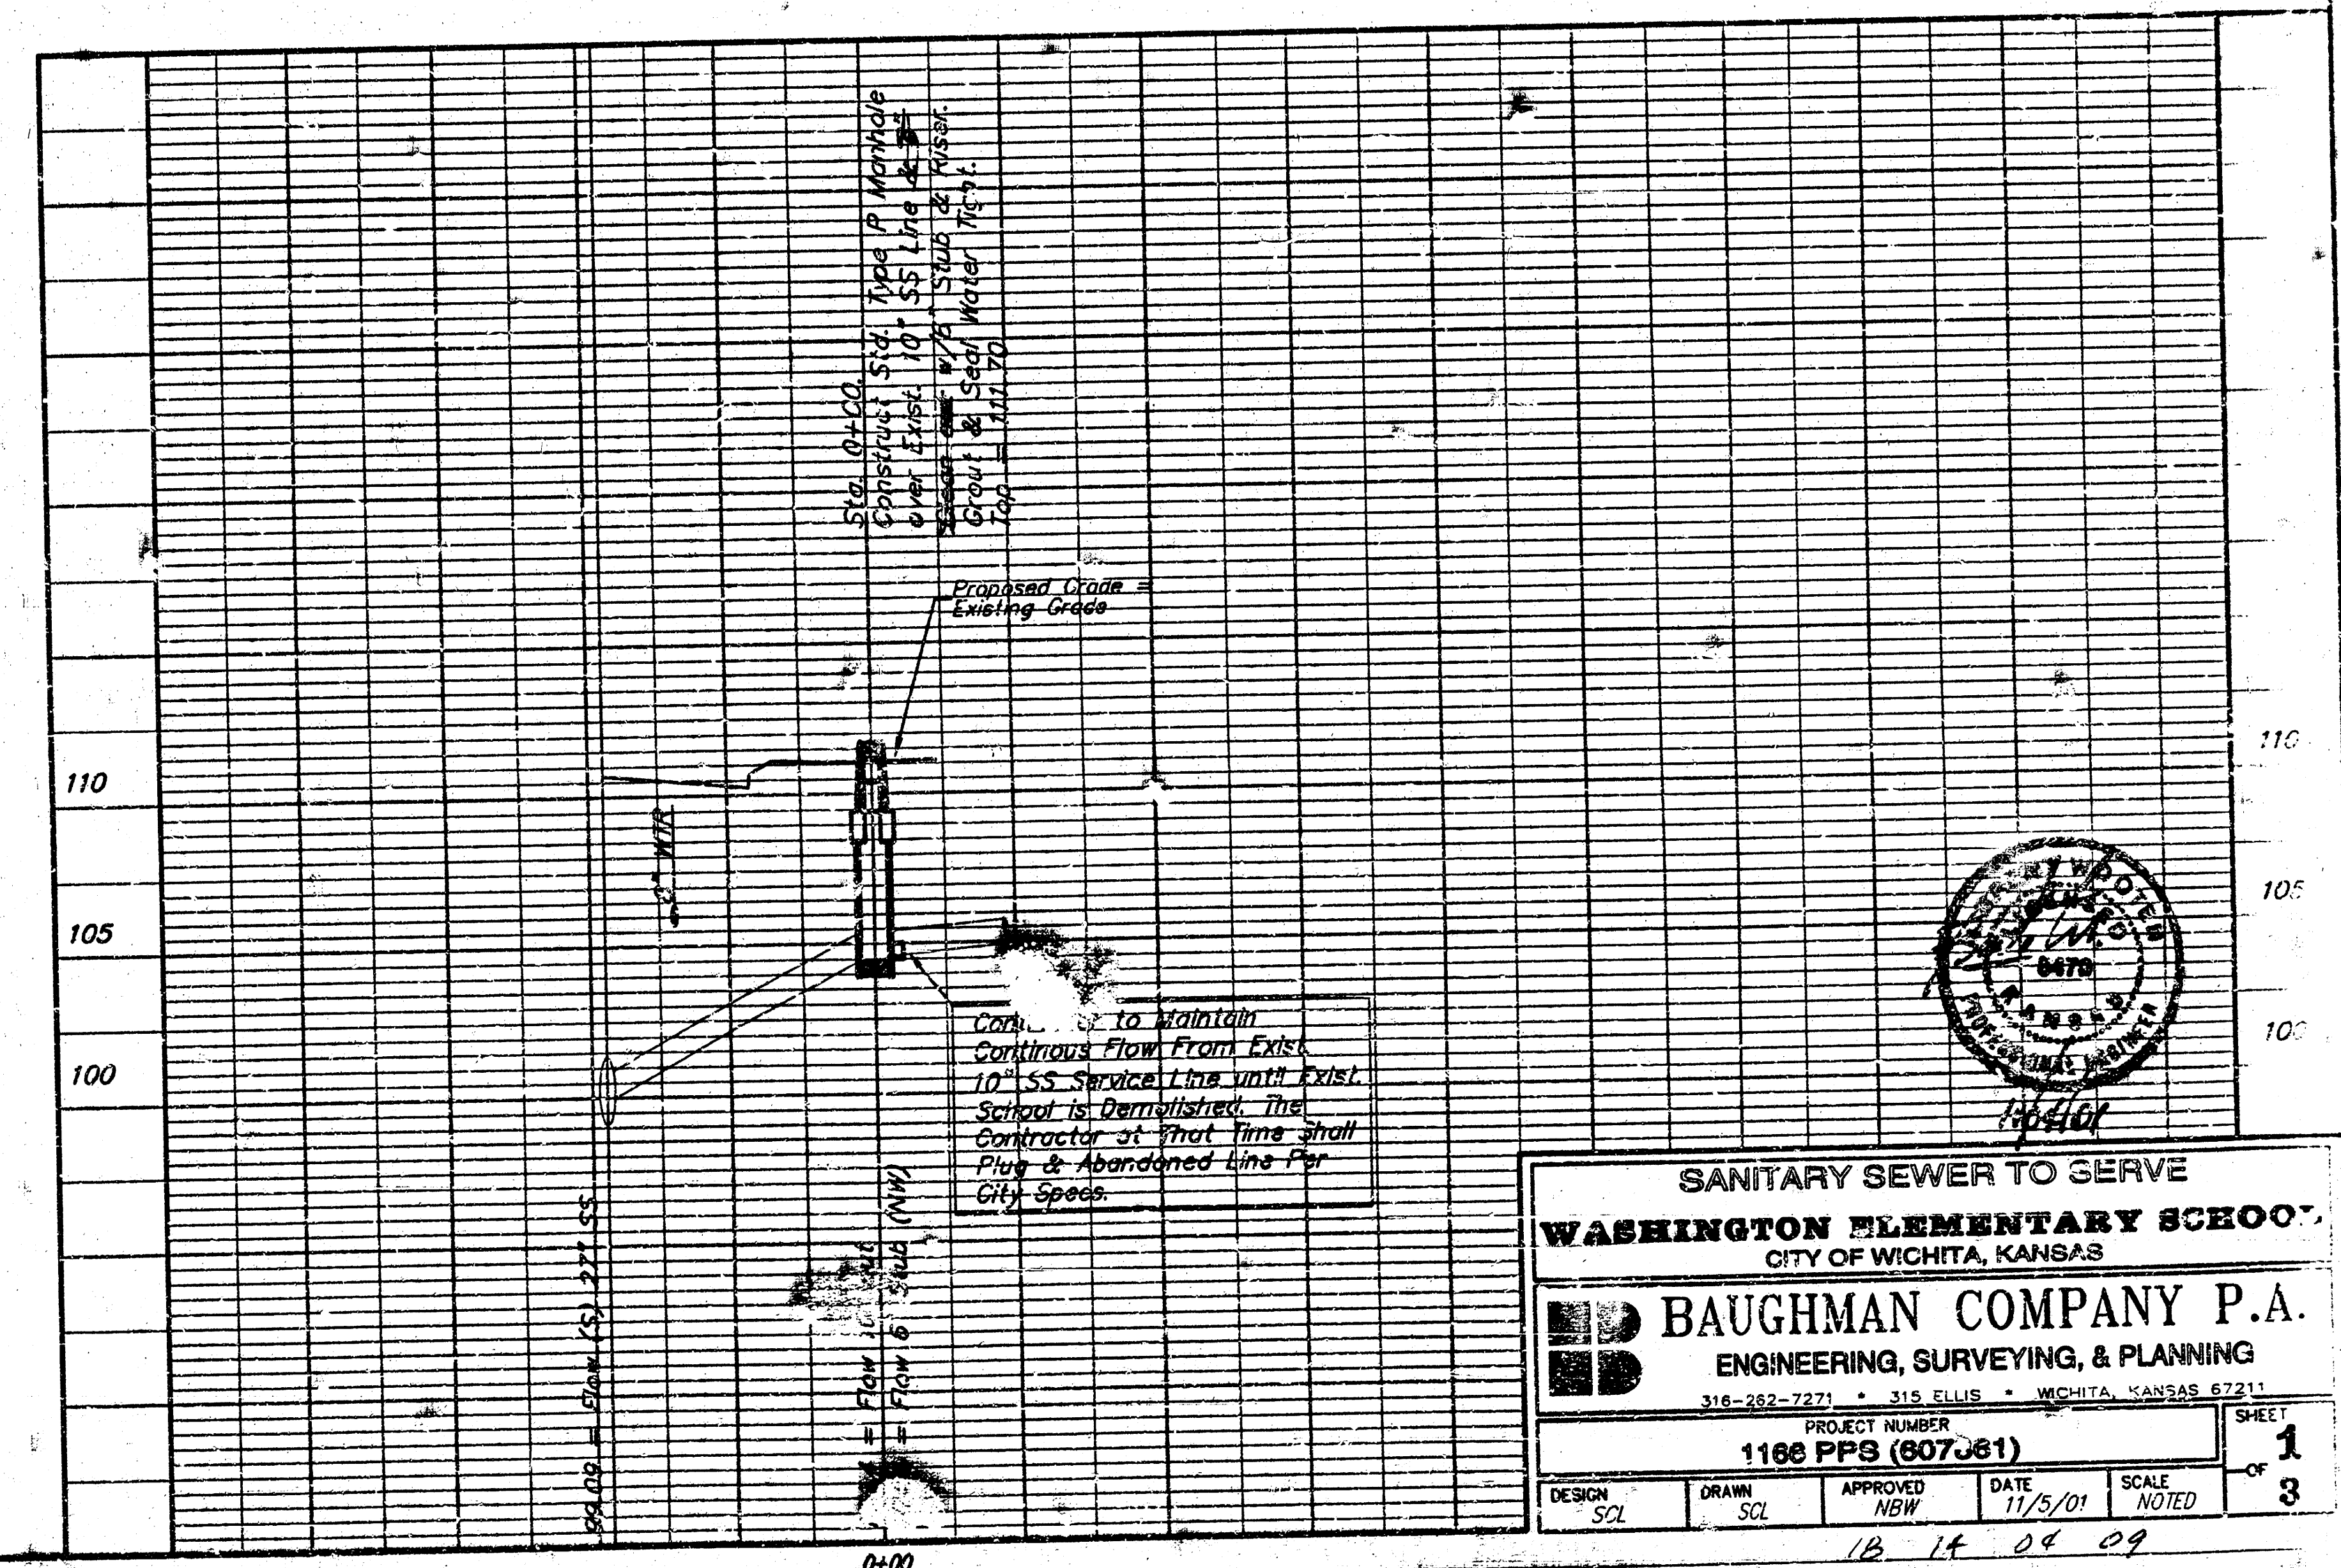

SANITARY SEWER TO SERVE

WASHINGTON ELEMENTARY SCHOOL
CITY OF WICHITA, KANSAS

BAUGHMAN COMPANY P.A.
ENGINEERING, SURVEYING, & PLANNING






316-262-7271 • 315 ELLIS • WICHITA, KANSAS 67211

PROJECT NUMBER
1168 PPS (607861)

DESIGN SZL DRAWN SZL APPROVED NEW DATE 11/3/01 SCALE NOTED

12 14 04 09

SEWER APPURTENANCES DETAILS

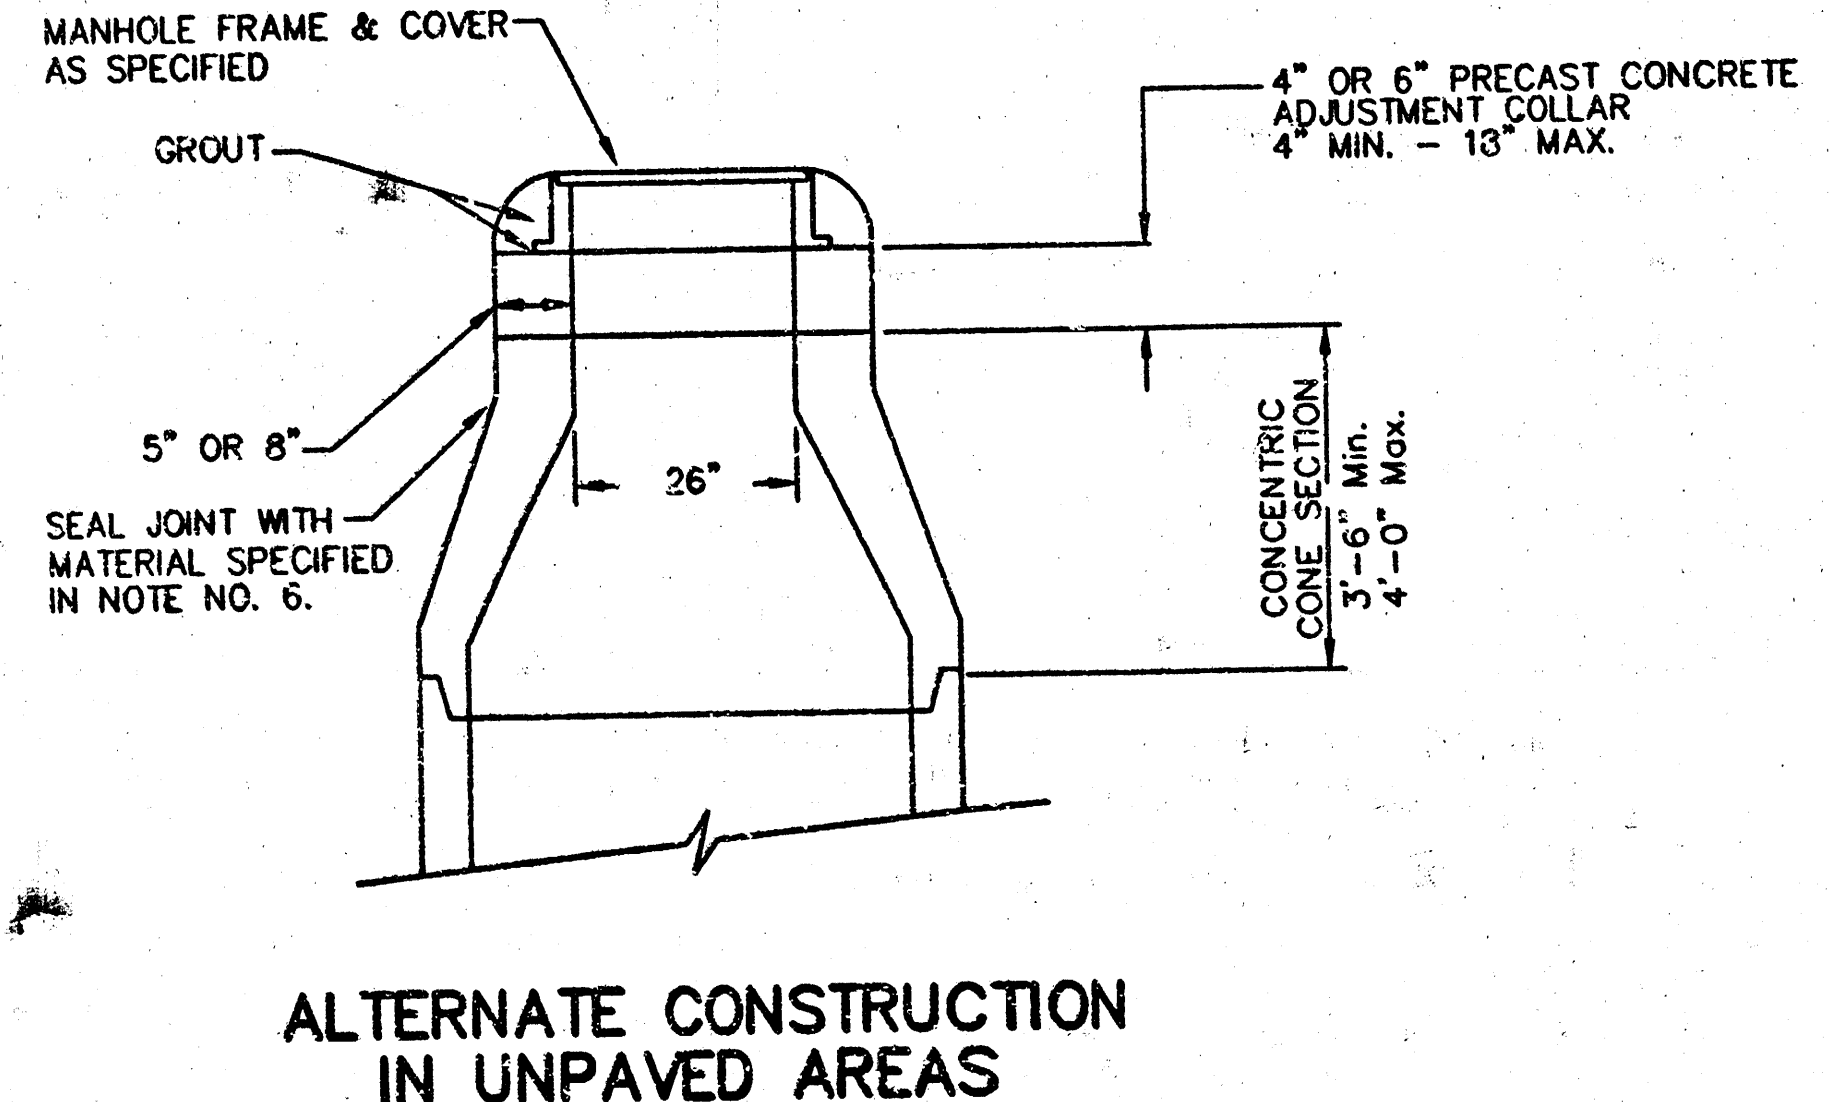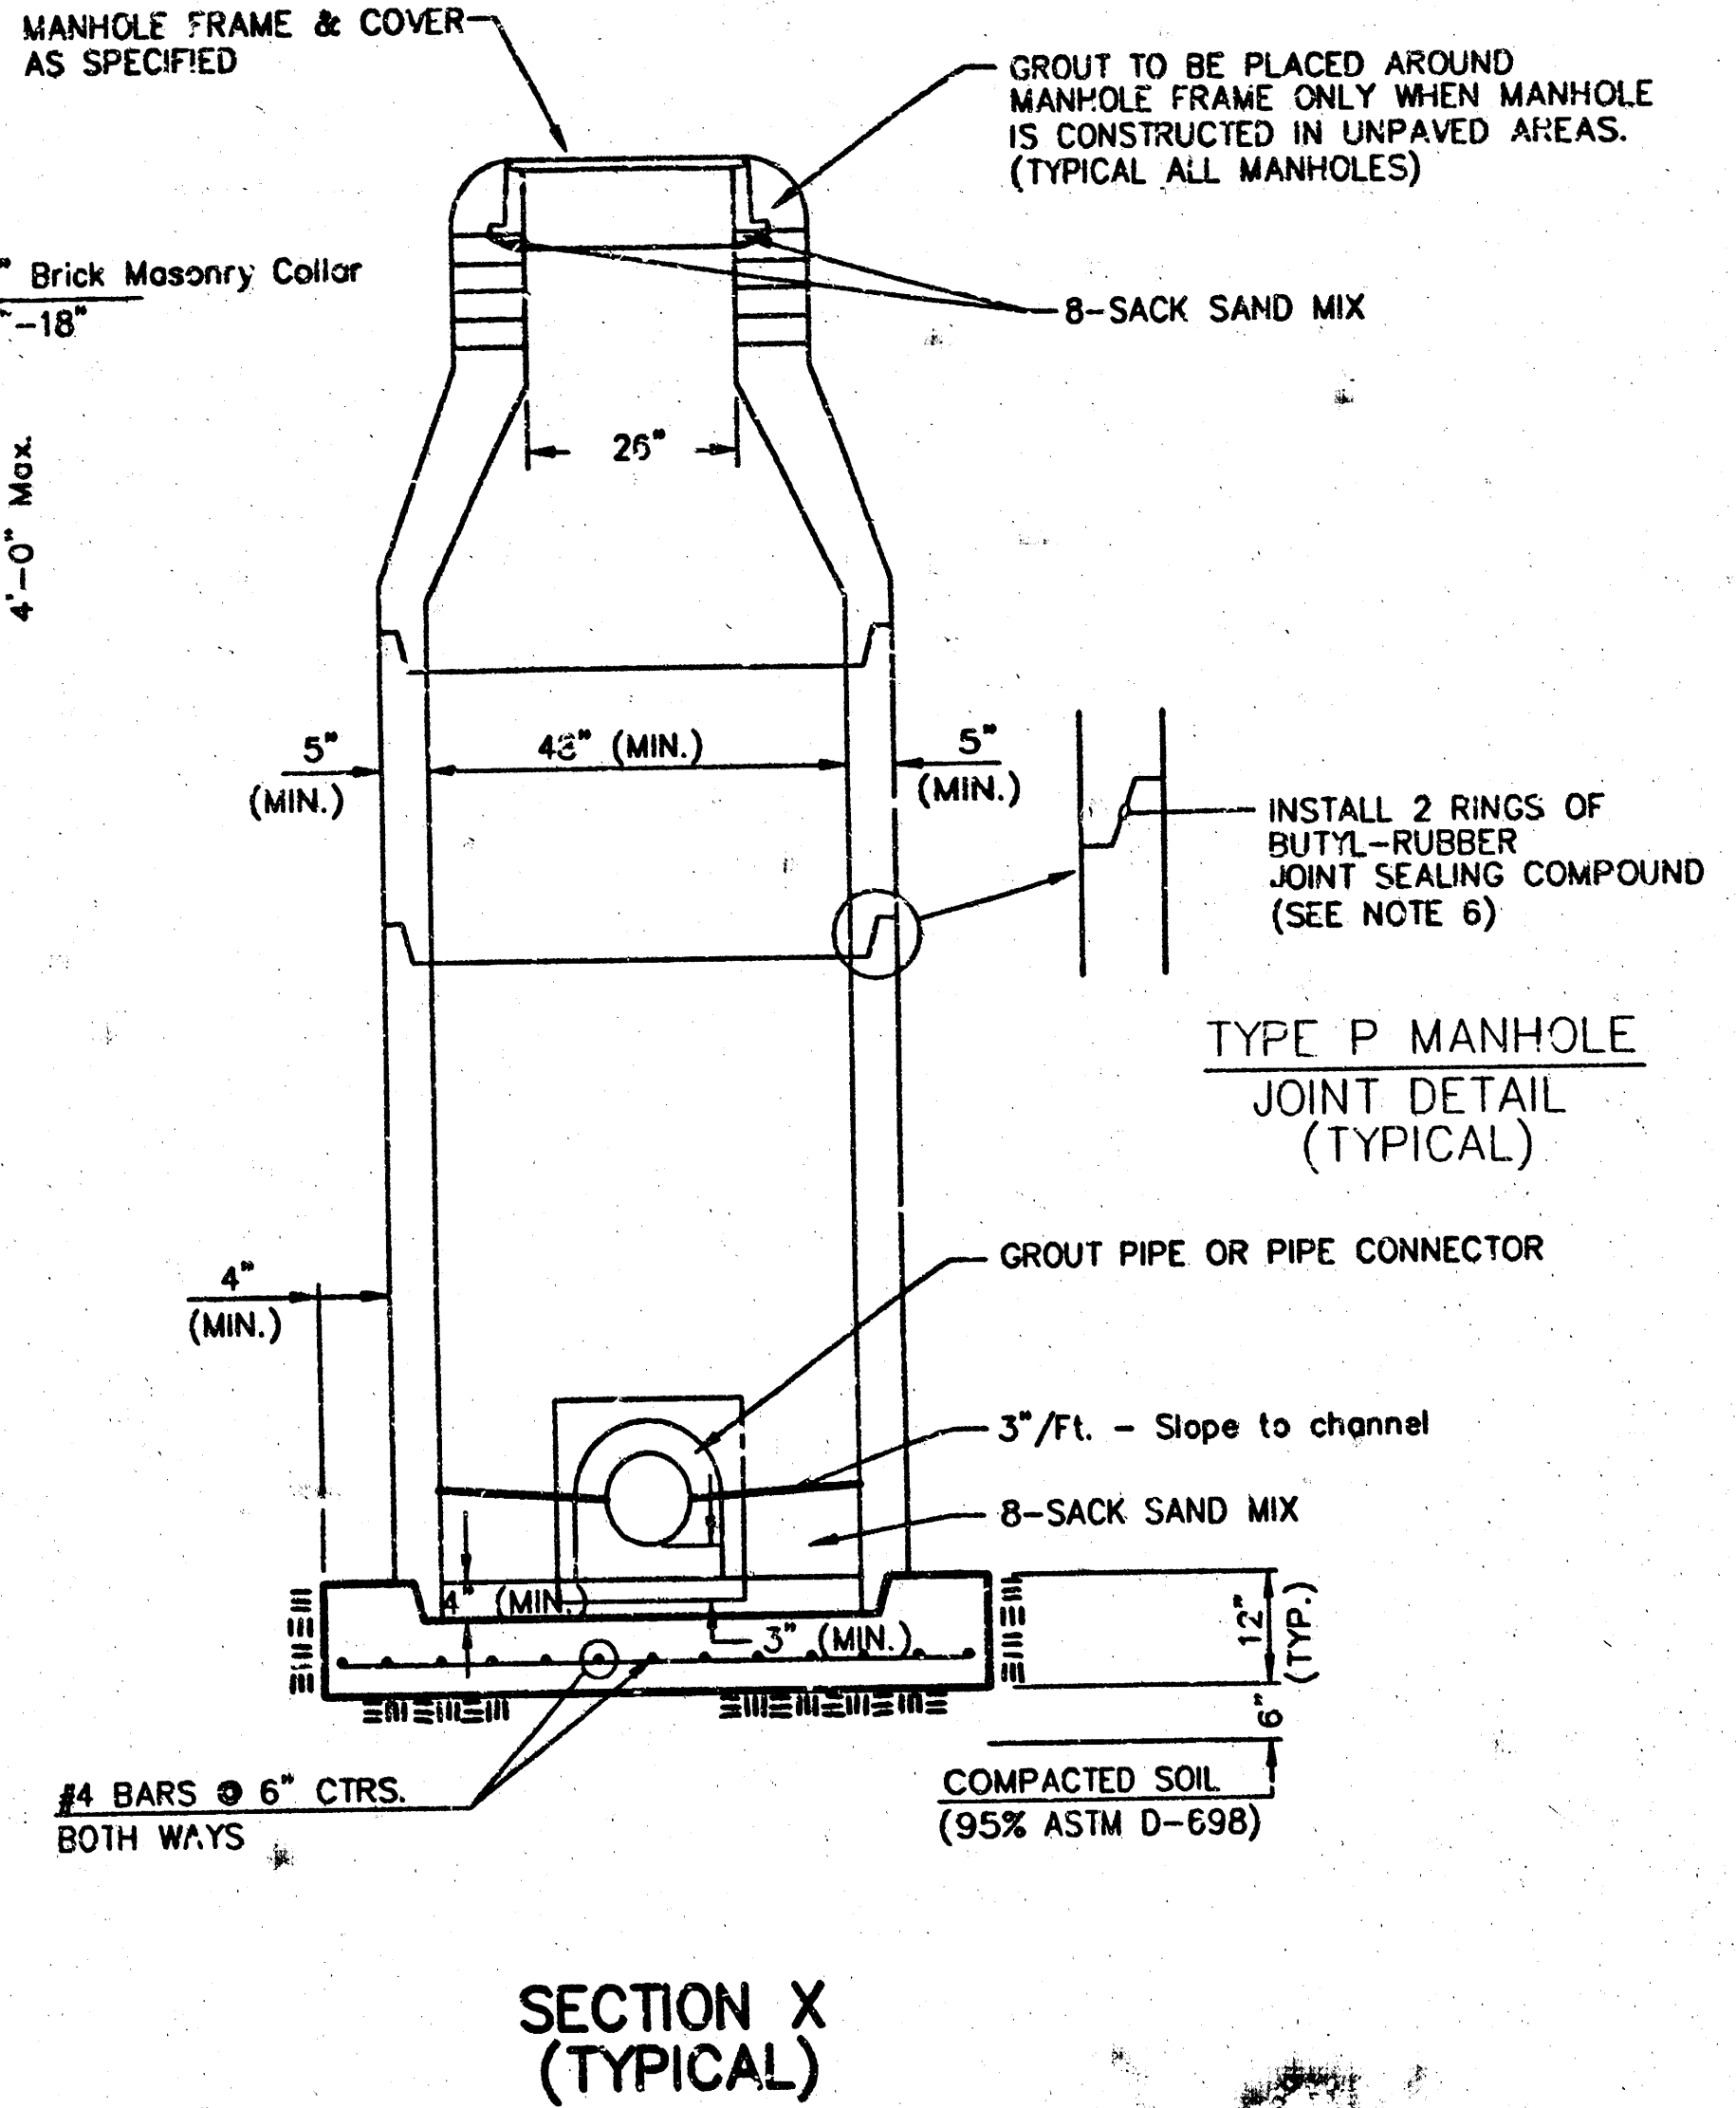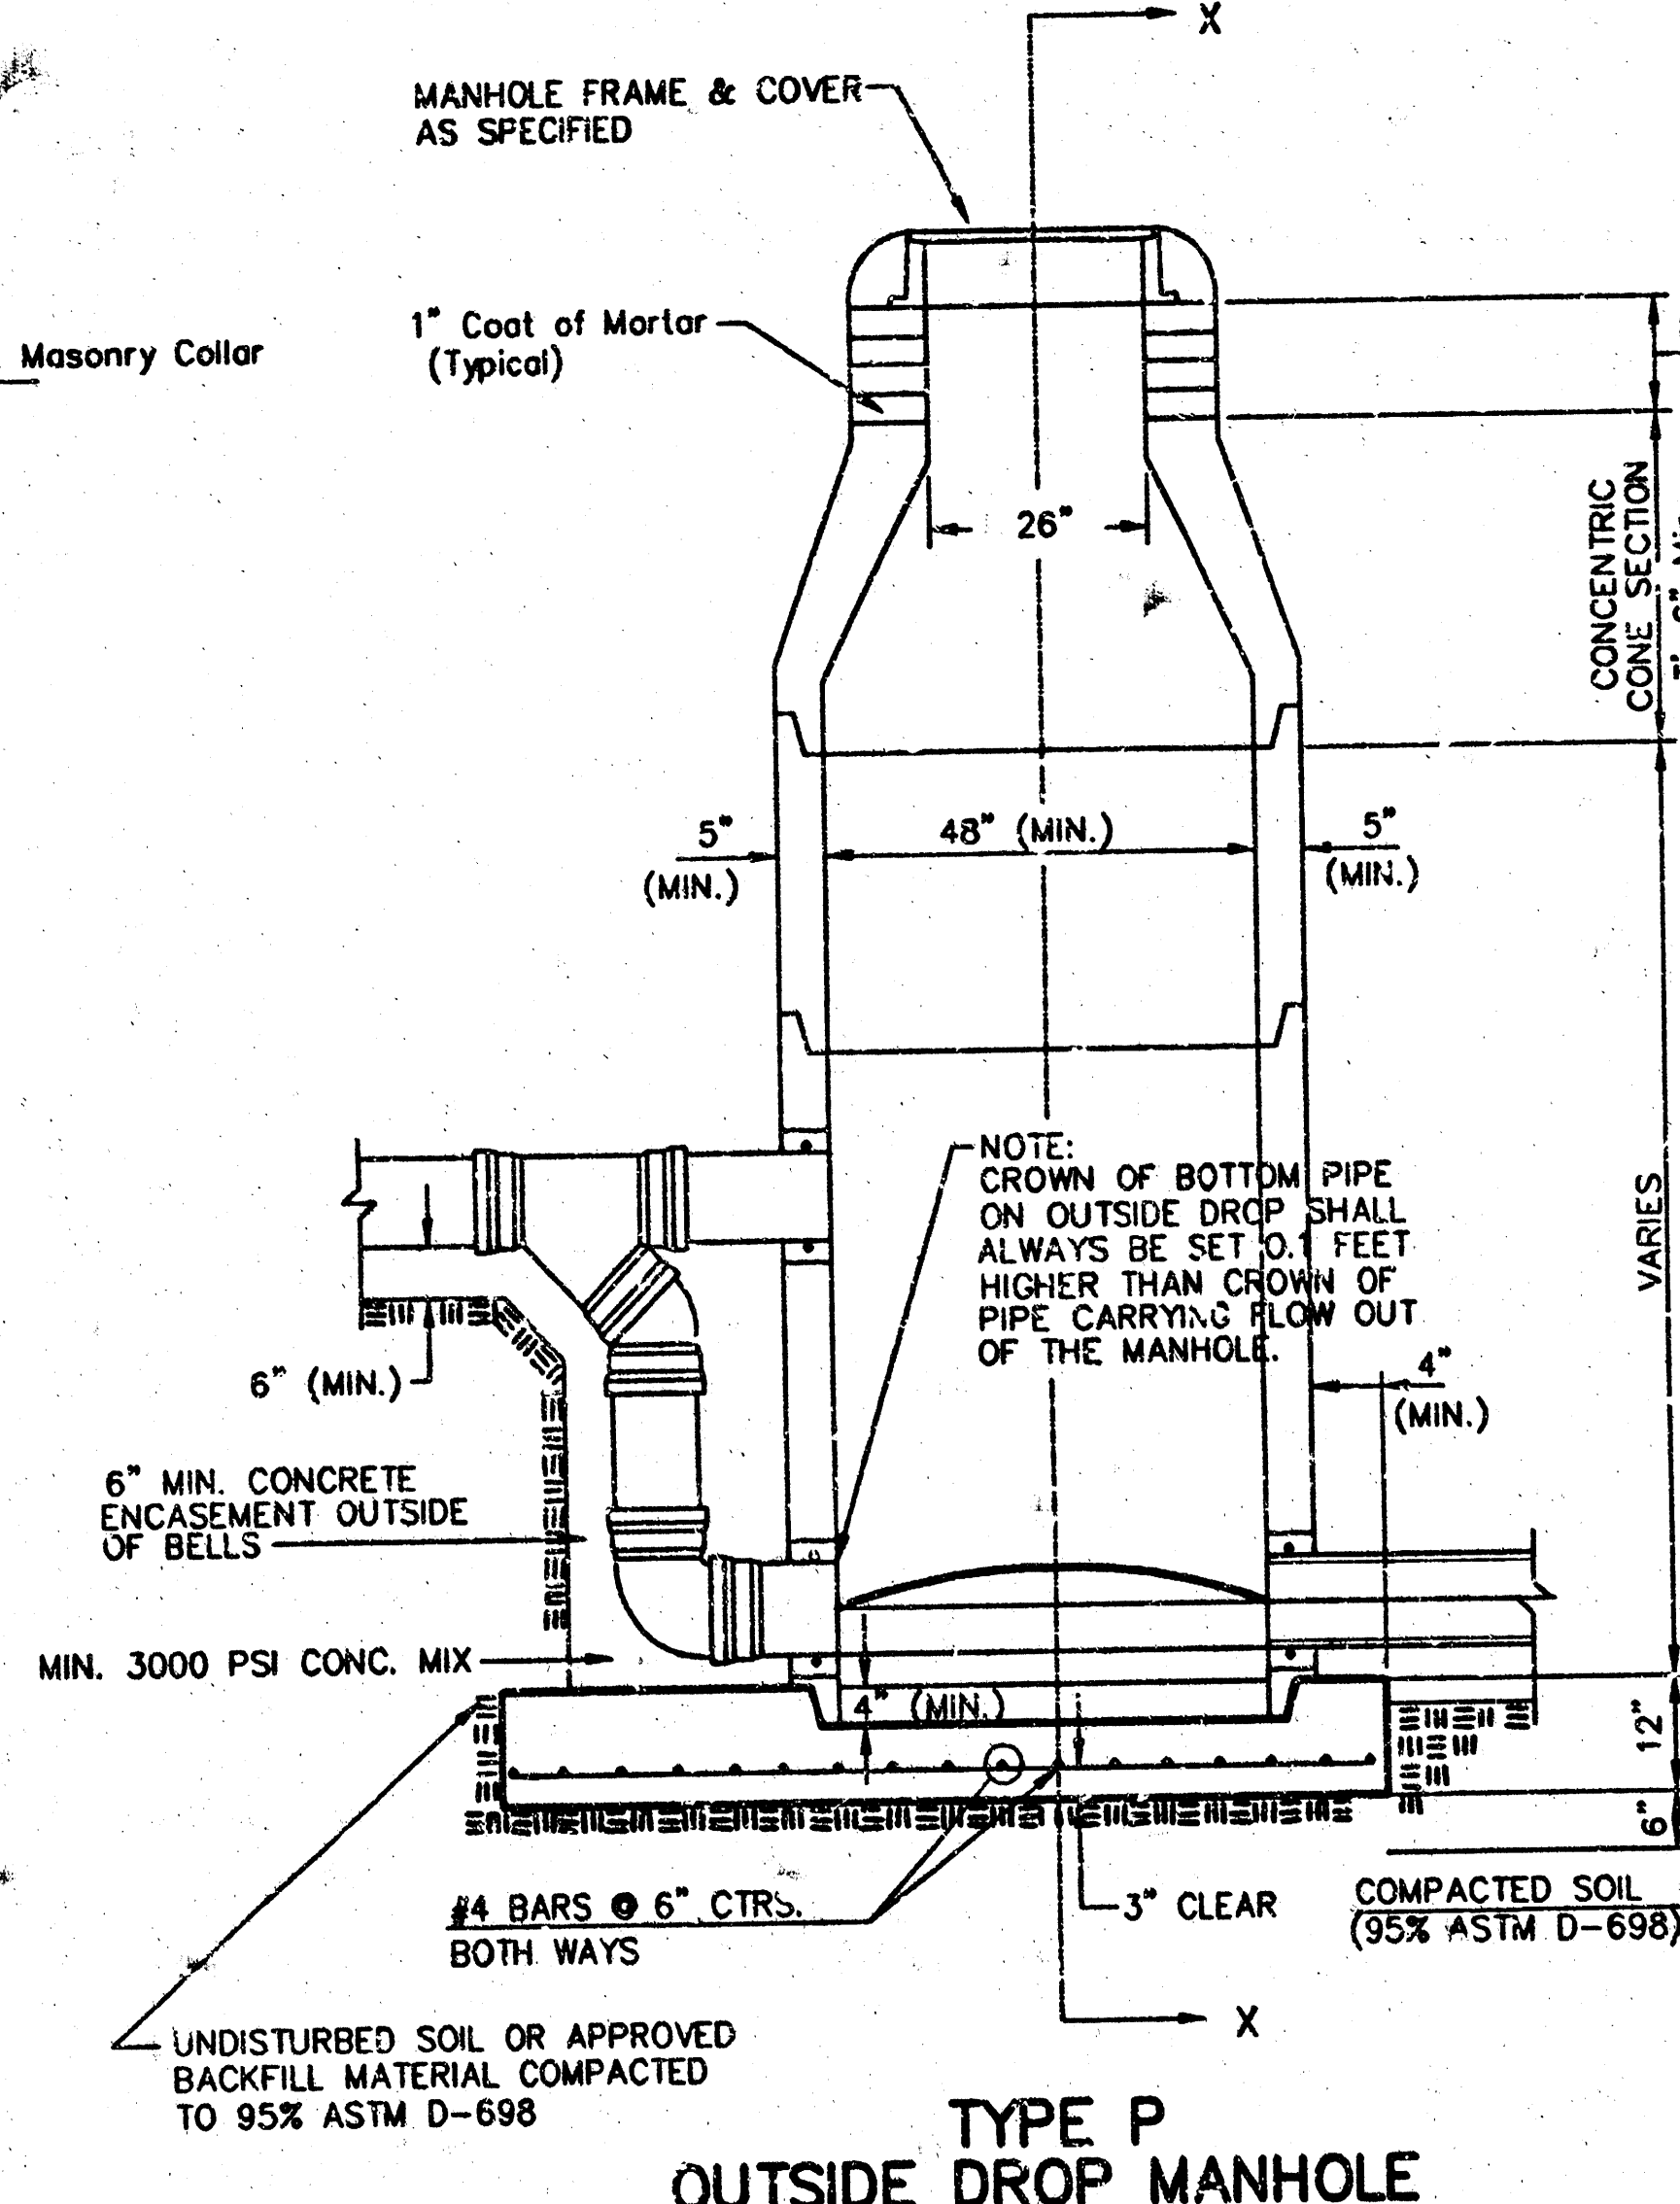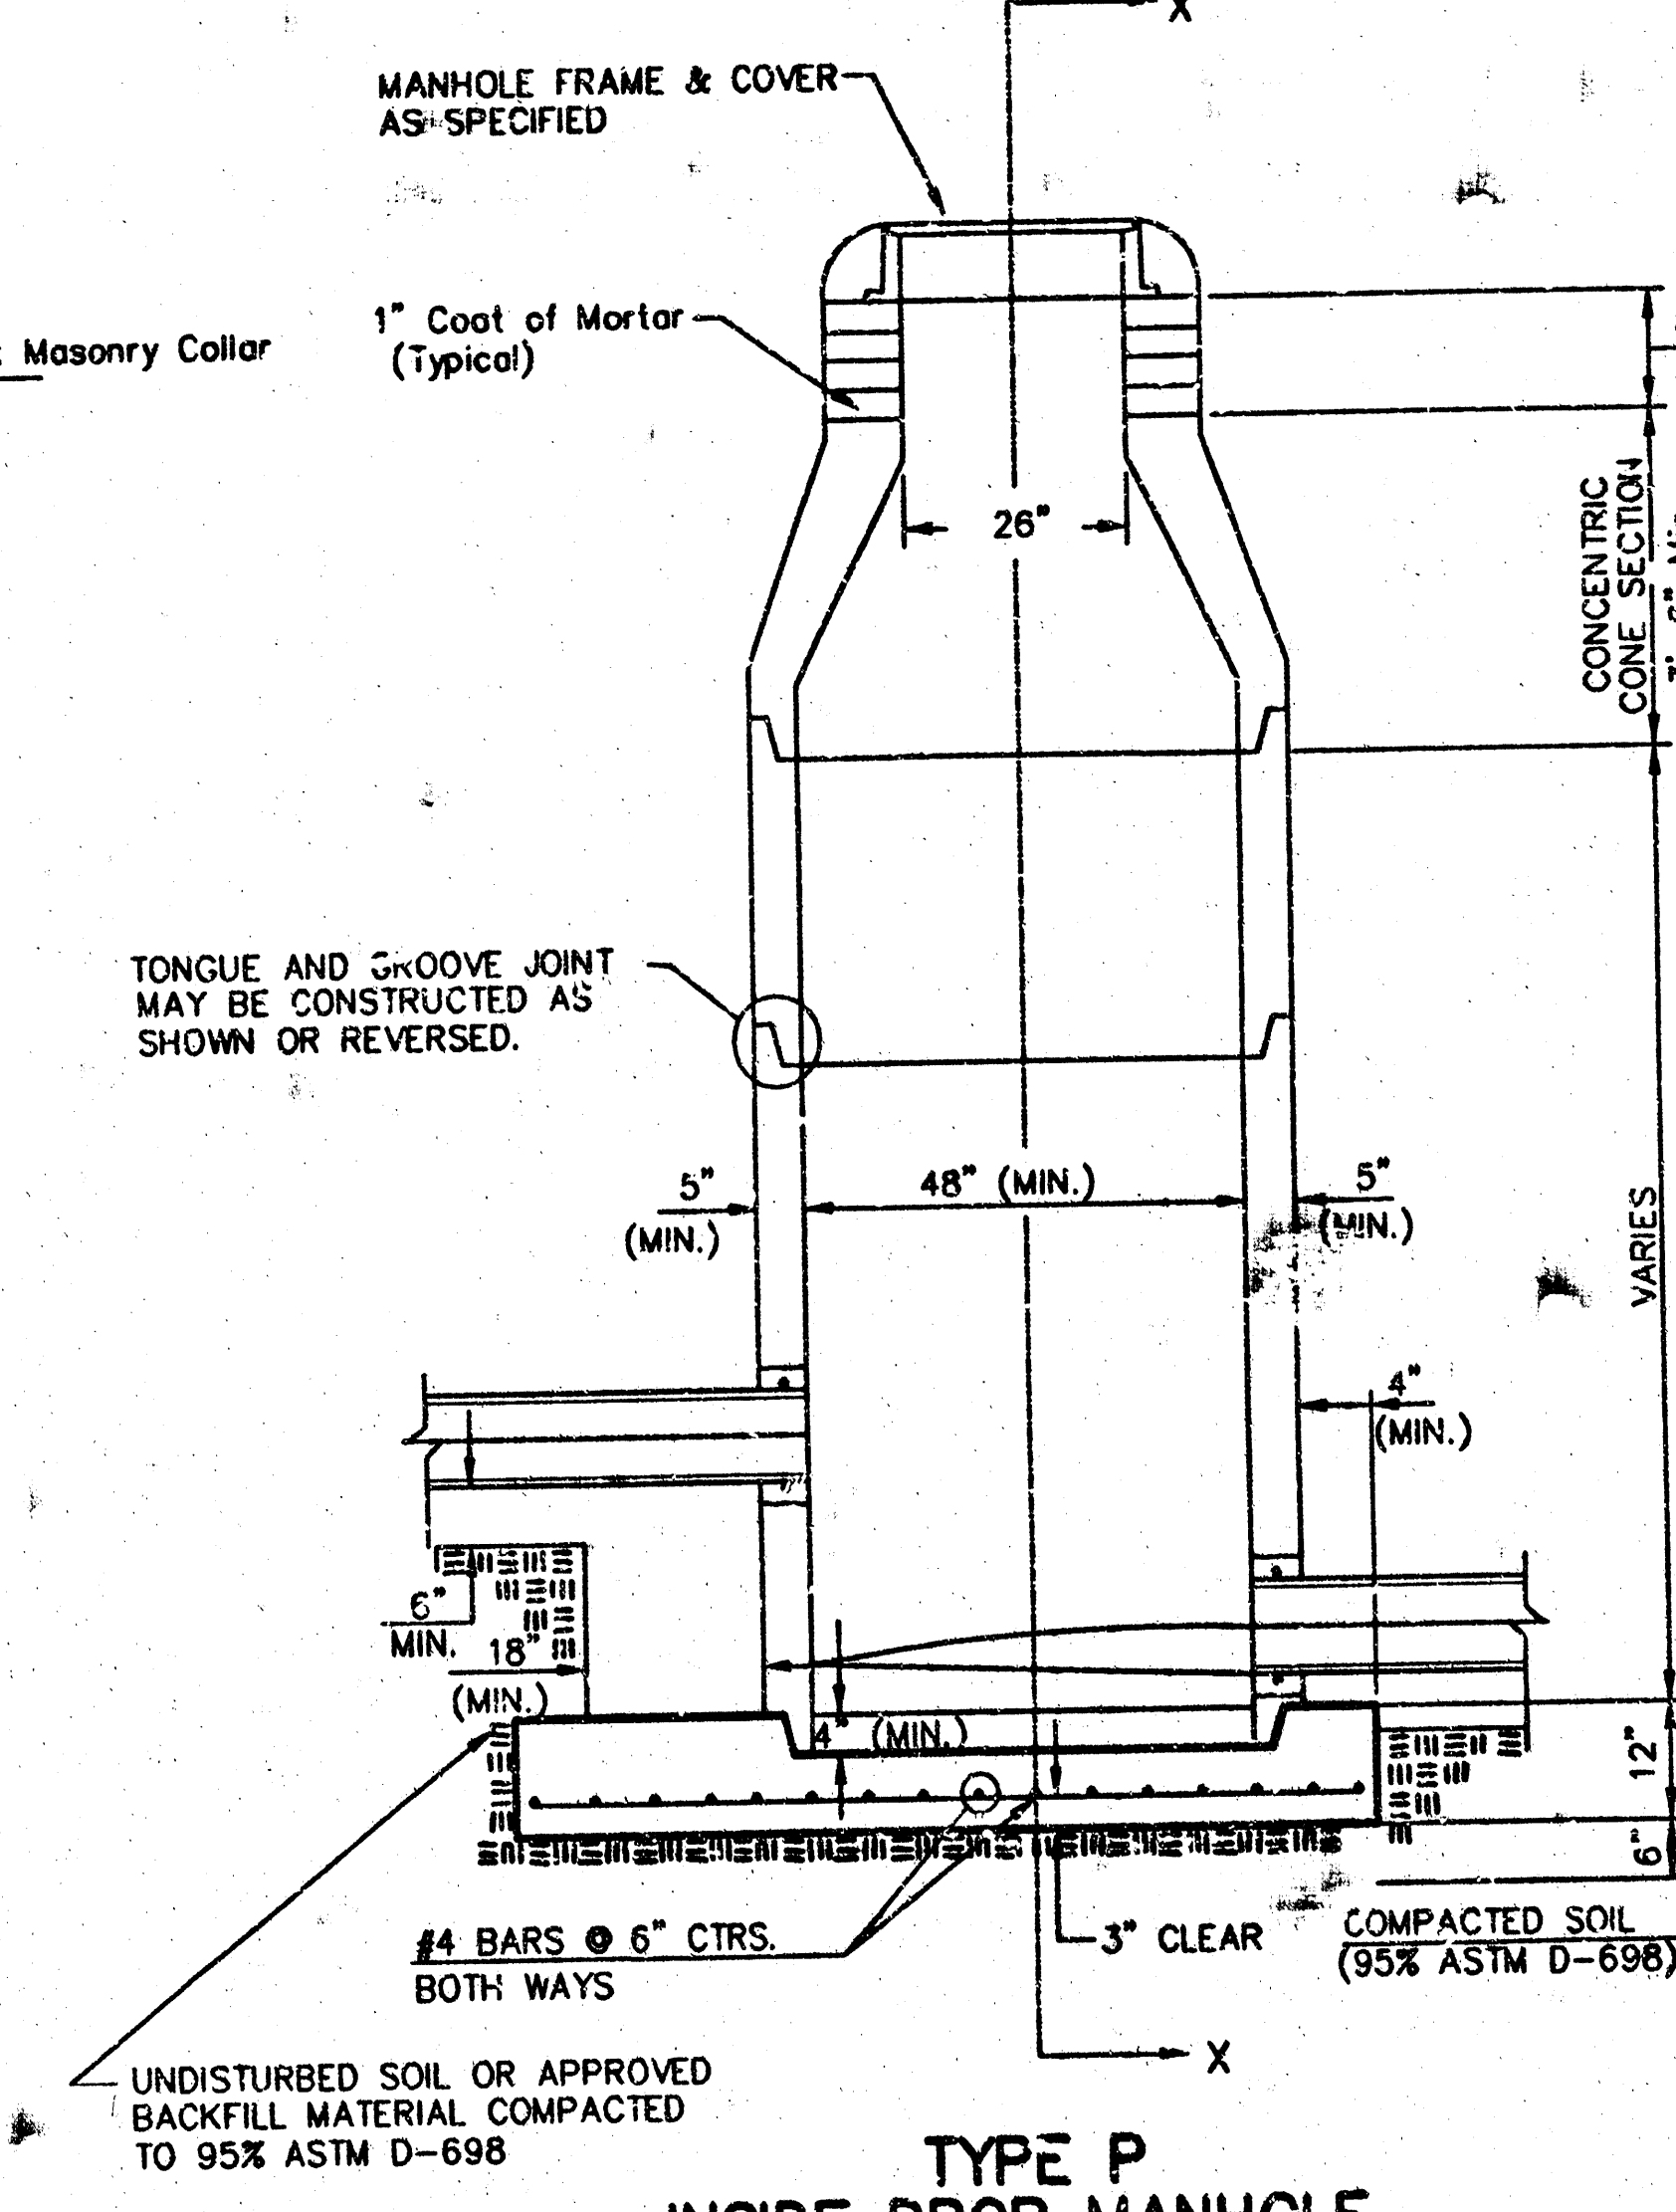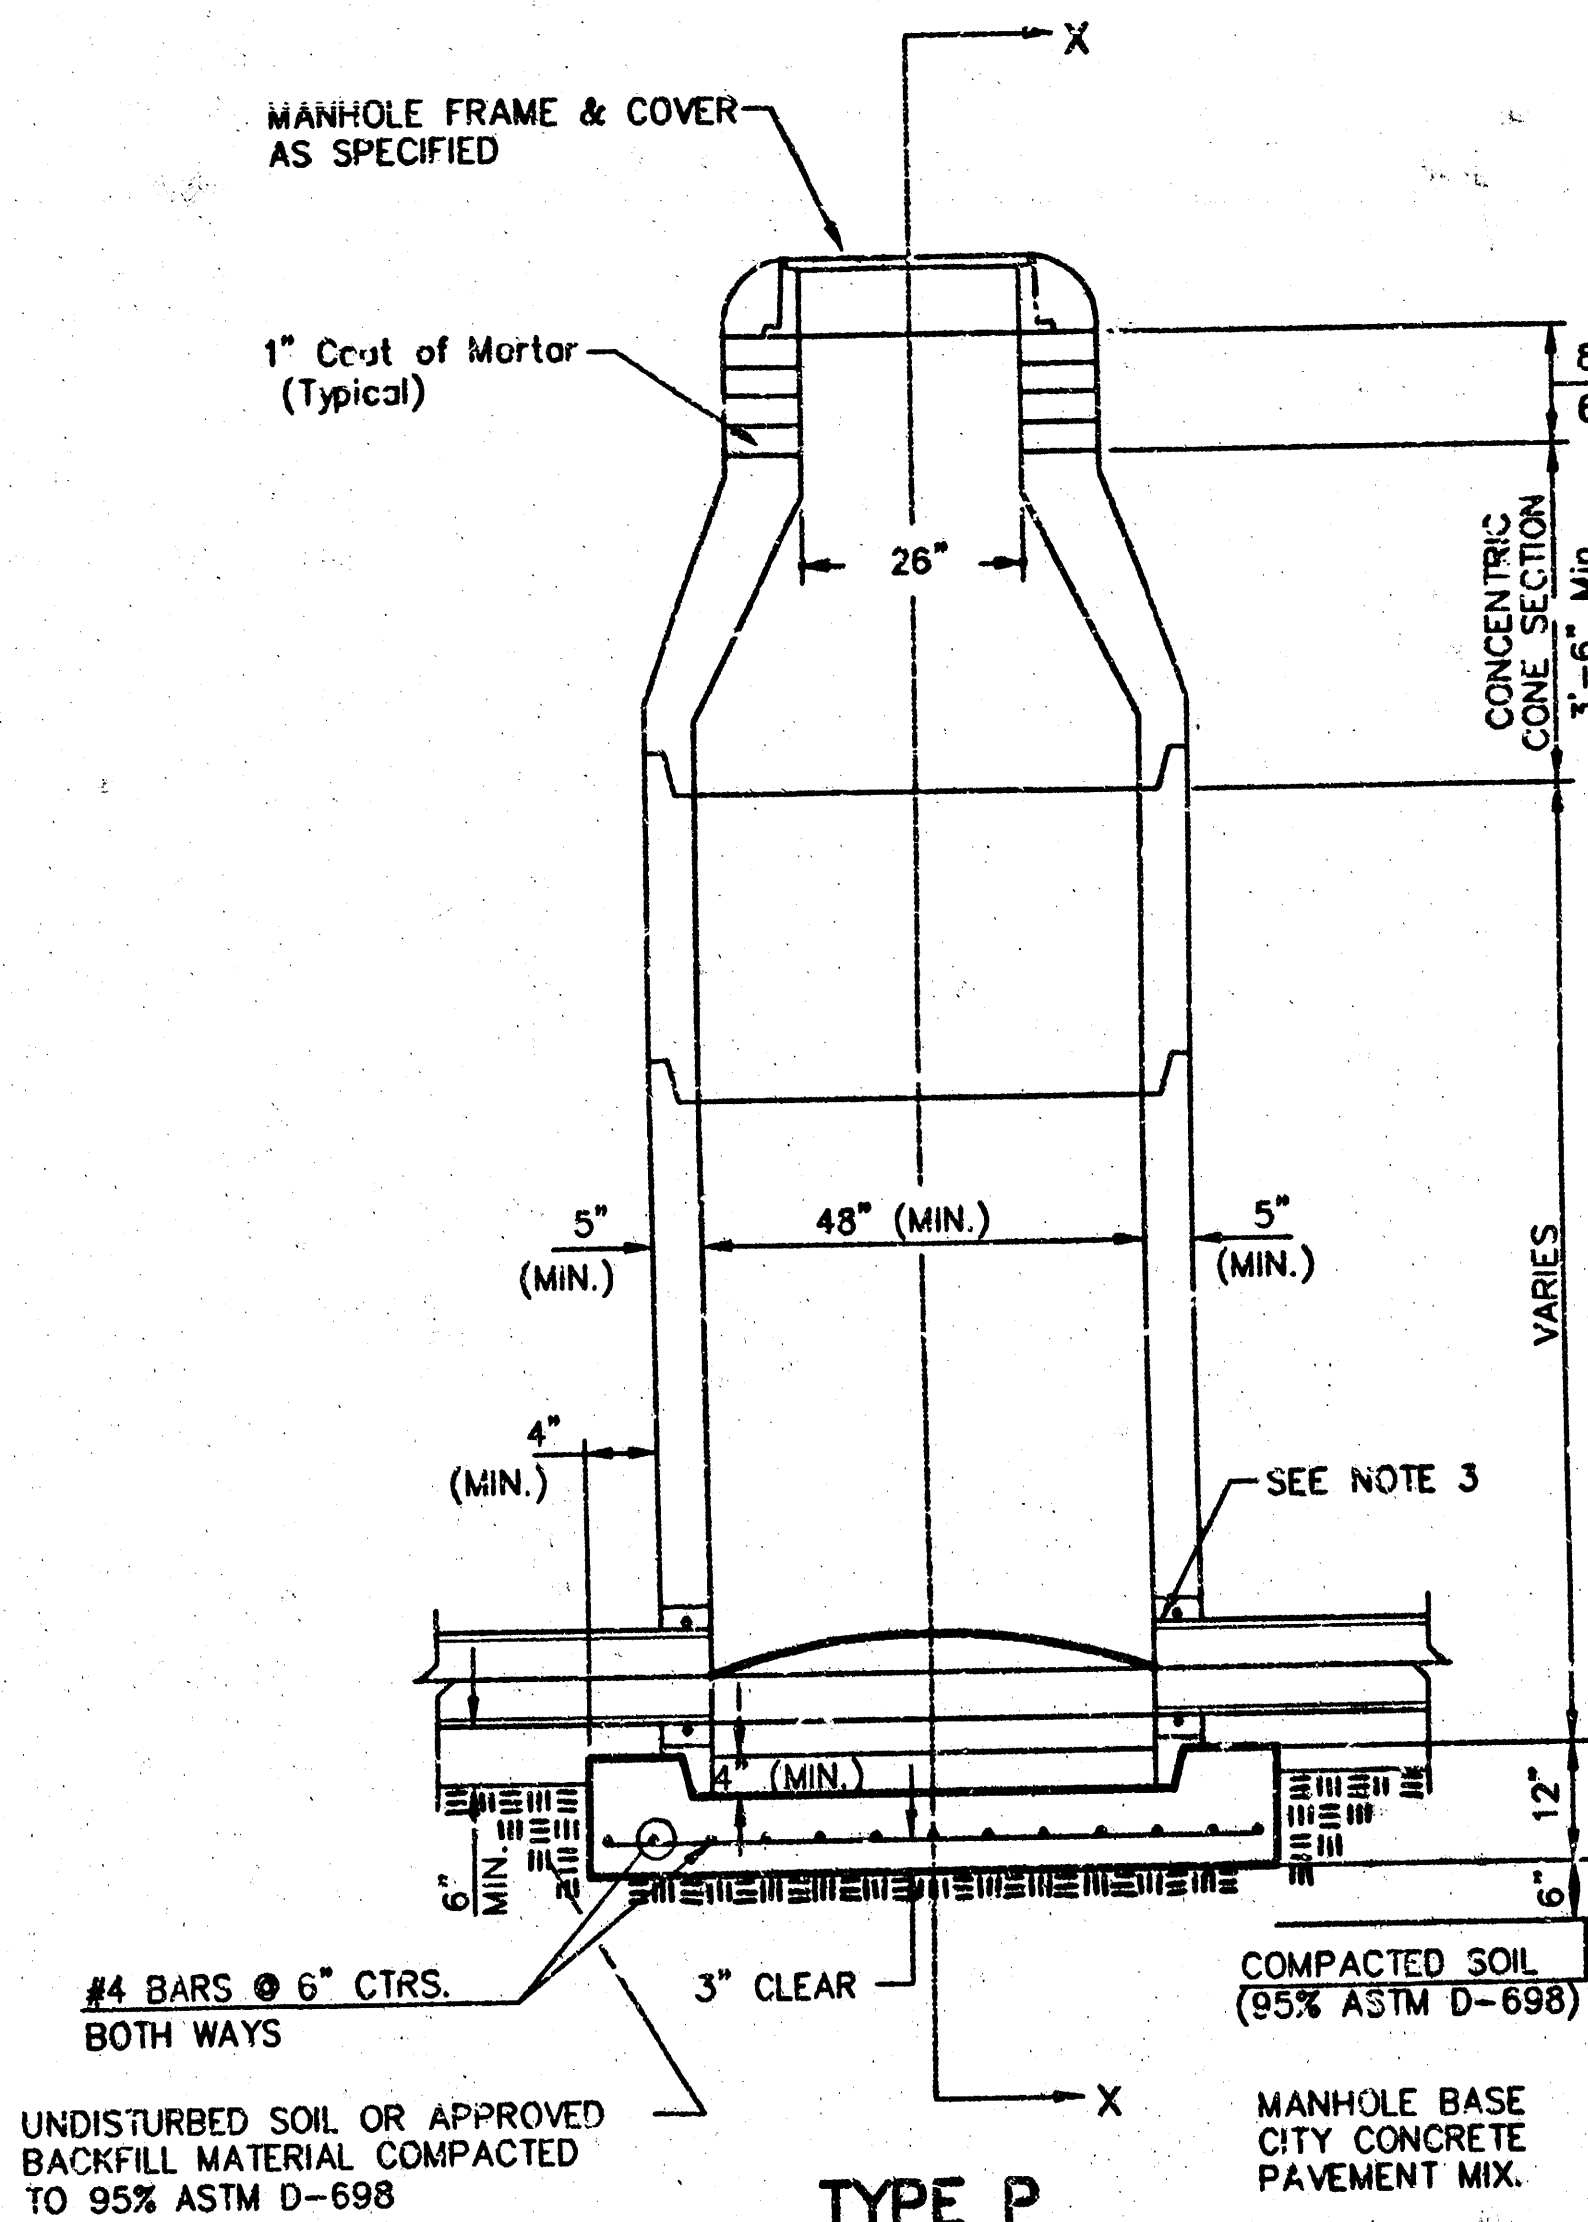

1. ALL PRECAST CONCRETE MANHOLE SECTIONS SHALL CONFORM TO THE LATEST REVISIONS OF A.S.T.M. C478 AS MODIFIED BY THE SPECIFICATIONS.
2. NON-SHRINK GROUT SHALL BE NON-METALLIC TYPE.
3. APPROVED FLEXIBLE WATERSTOP GASKETS SHALL BE INSTALLED TO JOIN THE SEWER TO THE MANHOLE WALL WHEN A.B.S. COMPOSITE PIPE AND V.C.P. PIPE IS USED. FOR OTHER TYPES OF PIPE THE SEWER SHALL BE GROUTED IN PLACE WITH NON-SHRINK GROUT. THE SEWER PIPE SHALL BE SUPPORTED WITH CONCRETE ENCASEMENT. THE MINIMUM ENCASEMENT SHALL BE 3 FEET FROM THE MANHOLE WALL AND TO THE FIRST JOINT FOR V.C.P. SUCH THAT THE JOINT REMAINS FLEXIBLE.
4. ALL INSIDE SURFACES OF THE CONCRETE MANHOLE WHICH WOULD BE EXPOSED TO SEWER GAS SHALL BE COATED WITH 2 COATS TNECMC SERIES 66 HI-BUILD EPOXOLINE, DRY THICKNESS OF 8 MILS. (MIN.)
5. EXTERIOR MANHOLE WALLS SHALL BE COATED WITH 1 COAT MOBILARMA 633 BITUMINOUS COATING.
6. JOINT SEALING COMPOUND SHALL BE KENT SEAL NO. 2 OR APPROVED EQUAL.
7. PRECAST MANHOLES SHALL BE SET AT LEAST 4 INCHES INTO THE MANHOLE BASE.
8. TOP OF MANHOLE FLOOR SLAB SHALL BE AT LEAST 3 INCHES BELOW THE FLOW LINE OF THE OUTLET PIPE TO INSURE SUFFICIENT MINIMUM THICKNESS OF SHAPED INVERT.
9. LIFTING MOLDS SHALL BE FILLED WITH NON-SHRINK GROUT AND THE INTERIOR SURFACE COATED AS SPECIFIED.
10. MORTAR USED IN MASONRY CONSTRUCTION SHALL CONTAIN 8 BAGS OF CEMENT PER CUBIC YARD. CONCRETE USED IN MANHOLE BASE SHALL CONFORM TO THE REQUIREMENTS OF CONCRETE FOR CONCRETE PAVEMENT AS SPECIFIED IN THE CITY STANDARD PAVING SPECIFICATIONS USING CITY CONCRETE PAVEMENT MIX WITHOUT AIR ENTRAINING ADMIXTURE. MORTAR SHALL BE LAYED AROUND THE MANHOLE IN UNPAVED AREAS. MANHOLS CONSTRUCTED WHERE PIPE SIZES ARE SMALLER THAN 24" SHALL HAVE AN INSIDE DIAMETER OF 24". MANHOLES CONSTRUCTED WHERE PIPE SIZES ARE 24" OR LARGER SHALL HAVE AN INSIDE DIAMETER OF 5". COMPLETED MANHOLE SHALL BE WITHOUT LEAKS AND WATER TIGHT.

11. REINFORCING STEEL SHALL BE INSTALLED IN THE MANHOLE BASES AND SHALL CONSIST OF NO. 4 BARS PLACED ON 6" CENTERS IN BOTH DIRECTIONS. THE MANHOLE BASE REINFORCEMENT SHALL BE PLACED AT LEAST 3" ABOVE THE BOTTOM OF THE BASE. THE BARS MUST BE FOR FULL LENGTH AND MUST BE REINFORCING STEEL. SHALL BE INCLUDED IN THE UNIT PRICE BID FOR THE MANHOLE.
12. EXISTING SHALL BE CUT INTO THE MANHOLE WALL WHEN OUTSIDE DROPS ARE CONSIDERED ON EXISTING MANHOLES. SUCH OPENINGS CUT INTO EXISTING MANHOLES SHALL BE AS SMALL AS PRACTICAL TO FACILITATE INSTALLING AND GROUTING THE NEW PIPE IN PLACE. WATERSTOP GASKETS SHALL BE USED TO PREVENT A.B.S. COMPOSITE PIPE FROM SINKING INTO EXISTING MANHOLE. GROUTING SHALL BE USED TO PREVENT SINKING GROUT FOR THE FULL MANHOLE WALL THICKNESS. THE EXTERIOR OF THE COMPLETED CONNECTION SHALL BE SEALED WITH AN APPROVED BITUMINOUS COATING. THE CONNECTION SHALL BE MADE TO THE EXISTING MAIN FLOOR MANHOLE. THE MAIN FLOOR SHALL BE MODIFIED TO FORM NEW FLOW CHANNEL FOR THE NEW CONNECTION AS INDICATED BY THE DRAWING. THIS WORK, INCLUDING MODIFICATION OF MANHOLE FLOOR, SHALL BE PAID FOR AT THE UNIT PRICE BID FOR OUTSIDE DROP STACK CONSTRUCTED ON EXISTING MANHOLE.
13. THE FLOORS OF ALL MANHOLES SHALL BE SHAPED WITH FLOW CHANNELS SUCH THAT THE MANHOLES SHALL BE SELF-CLEANING AND FREE OF AREAS WHERE SOLIDS COULD BE DEPOSITED AS SEWAGE FLOWS THROUGH THE MANHOLE. FROM ALL INLET PIPES TO THE OUTLET PIPE, FLOW CHANNELS SHALL BE FORMED TO MATCH THE BOTTOM HALVES OF THE INLET AND OUTLET PIPES AND THE OUTLET FLOW CHANNELS. THE DRAINING EXCEPT PIPES AND THE OUTLET FLOW CHANNELS. FLOW CHANNELS FOR OUTSIDE DROPS SHALL BE CONSTRUCTED AS INDICATED BY THE DRAWING. MANHOLE FLOORS SHALL HAVE SLOPES OF 3 INCHES PER FOOT IN THE AREAS OUTSIDE OF THE DROPS. THE SLOPE TOWARD THE FLOW CHANNELS. PIPES LAID THROUGH MANHOLES SHALL HAVE THE TOP HALF REMOVED TO LEAN LINES FOR THE FULL INSIDE DIAMETER OF THE MANHOLE. MANHOLE FLOORS SHALL BE SHAPED AROUND THE BOTTOM HALF OF THE PIPE WHICH FORMS THE FLOW CHANNEL.
14. PIPES INSTALLED WITHIN THE EXCAVATION MADE FOR THE MANHOLE SHALL BE GRADED WITH CONCRETE TO THE MANHOLE WALL. THE CRADLE SHALL BE GRADED WITH CONCRETE TO BE USED. THE CRADLE SHALL EXTEND TO THE FIRST JOINT OUTSIDE THE MANHOLE. THE CRADLE SHALL BE TERMINATED AT THE CLAY PIPE JOINT IN A MANNER WHICH WILL MAINTAIN THE FLEXIBILITY OF THE JOINT. THE CRADLE SHALL BE WITHIN THE EXCAVATION MADE FOR THE MANHOLE. THE CRADLE SHALL BE INCLUDED IN THE UNIT PRICE BID FOR THE MANHOLE.

15. MANHOLE COVER CASTINGS AND MANHOLE FRAME CASTINGS SHALL CONFORM TO THE REQUIREMENTS AS INDICATED IN THE STANDARD SPECIFICATIONS AND AS SHOWN IN THE STANDARD DETAIL DRAWING.
16. THE VERTICAL DROP IN INSIDE DROP MANHOLES SHALL NOT EXCEED 2' FOR INFLOWING PIPES SIZED 12" OR SMALLER AND 2' FOR INFLOWING PIPES LARGER THAN 12". THE CROWNS OF INFLOWING PIPES SHALL NEVER BE SET LOWER THAN THE CROWN OF THE OUTFLOWING PIPE.
17. STANDARD MANHOLES AND STANDARD INSIDE DROP MANHOLES SHALL BE BID AS STANDARD MANHOLES FOR THE TYPE AND DIAMETER INDICATED. INSIDE DROP MANHOLES SHALL BE BID AS STANDARD OUTSIDE DROP MANHOLES FOR THE TYPE AND DIAMETER INDICATED. ALL MANHOLE DIAMETERS WILL BE 4' UNLESS INDICATED OTHERWISE.
18. A BRICK MASONRY COLLAR SHALL BE INSTALLED BETWEEN THE CAST IRON FRAME AND THE CONCENTRIC COLE. THE COLLAR WILL BE 8" WALLS AND A VERTICAL HEIGHT OF 6" MINIMUM AND 18" MAXIMUM. A 1" COAT OF MORTAR WILL BE PLASTERED ON THE INSIDE SURFACE OF THE COLLAR. THE USE OF PRE-CAST CONCRETE SPACERS FOR MANHOLE TOP ADJUSTMENT IS ALSO ALLOWED.

ALTERNATE CONSTRUCTION IN UNPAVED AREAS

STD. MANHOLE DETAILS
SEWER APPURTENANCES



BAUGHMAN COMPANY P.A.
ENGINEERING, SURVEYING, & PLANNING

316-262-7271 • 315 FLUS • WICHITA, KANSAS 67211

PROJECT NUMBER
1166 PPS (07861)

DESIGN DATE: 11/6/88
DRAWN BY: [signature]
CHECKED BY: [signature]
APPROVED: [signature]
DATE: 11/6/88
SCALE: NONE

SHEET 2 OF 3

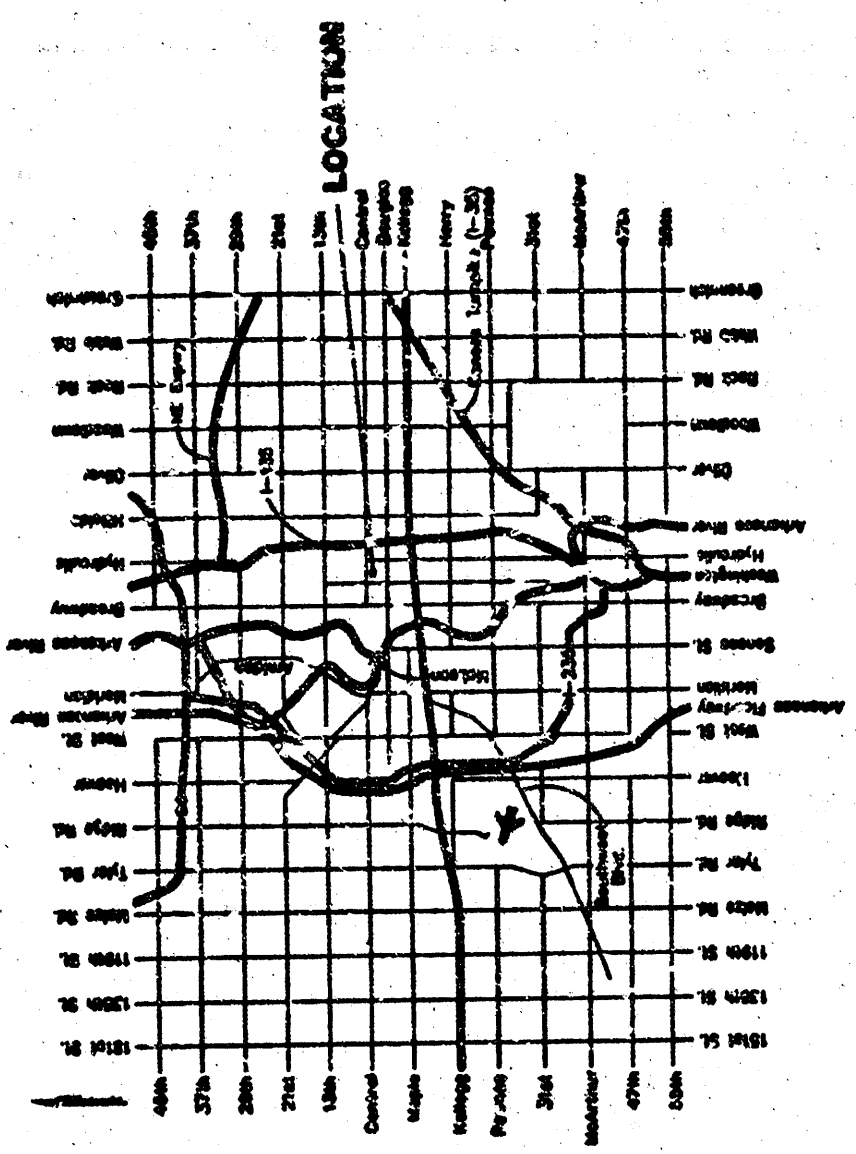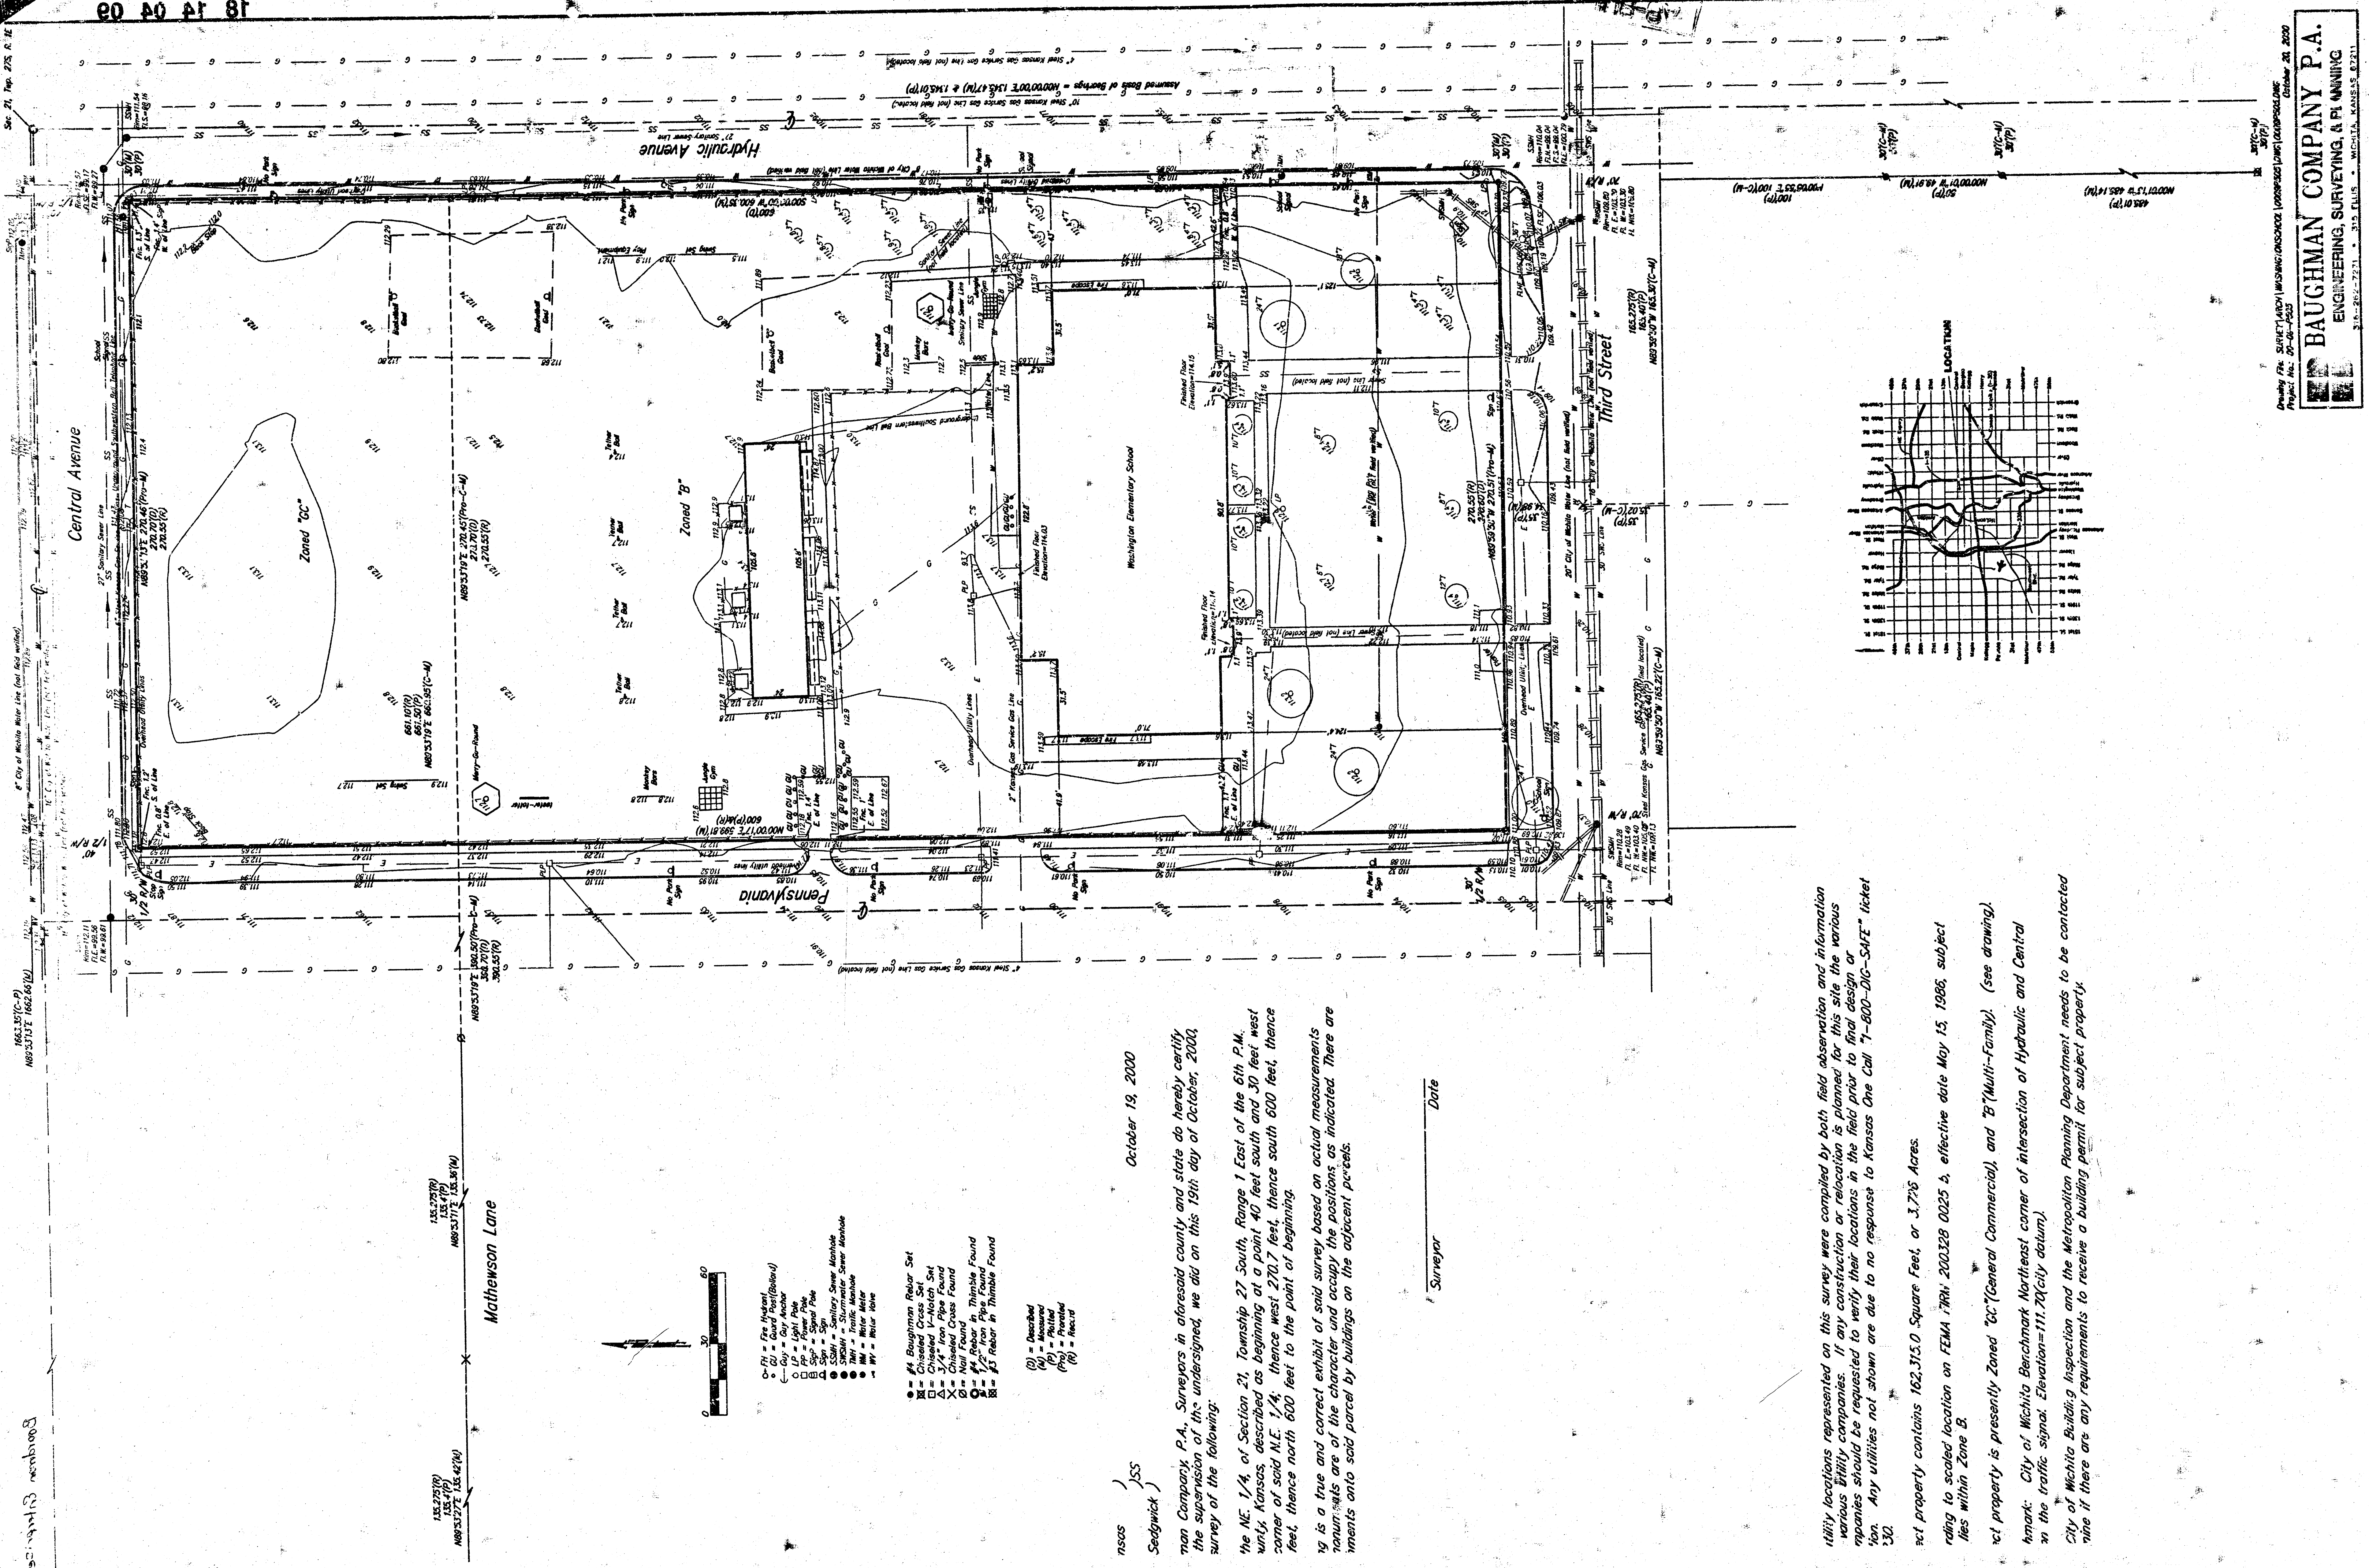

October 19, 2000

non Company, P.A., Surveyors in addressad county and state do hereby certify the supervision of the undersigned, we did on this 19th day of October, 2000, survey of the following:

the NE 1/4 of Section 21, Township 27 South, Range 1 East of the 6th P.M., county, Kansas, described as beginning at a point 40 feet south and 30 feet west corner of said NE 1/4, thence west 270.7 feet, thence south 600 feet, thence east 600 feet to the point of beginning.

ing is a true and correct exhibit of said survey based on actual measurements taken on the character and occupy the positions as indicated. There are invariants onto said parcel by buildings on the adjacent parcels.

Surveyor _____ Date _____

utility locations represented on this survey were compiled by both field observation and information from various utility companies. If any construction or relocation is planned for this site, the various companies should be requested to verify their locations in the field prior to final design or construction. Any utilities not shown are due to no response to Kansas One Call 1-800-DIG-SAFE ticket 130.

rect property contains 162,315.0 Square Feet, or 3.726 Acres.

rding to scaled location on FEMA 174N 200228 0025 4, effective date May 15, 1986, subject lies within Zone B.

rect property is presently Zoned "cc" (General Commercial), and "B" (Multi-Family). (see drawing).

mark: City of Wichita Benchmark Northeast corner of intersection of Hydraulic and Central in the traffic signal. Elevation=111.70 (city datum).

City of Wichita Building Inspection and the Metropolitan Planning Department needs to be contacted prior if there are any requirements to receive a building permit for subject property.