

B.M. #6:
Chisled Square on NW
Corner Traffic Signal
Pole Base at SW Corner,
Hillside & Murdock.
Elev. = 150.04


F=20'

Note: Cleanout &
Bldg. connection to be
Construct & Inspected
by others.


Note: 10 LF exist.
San. Sewer pipe east
of M.H. 0+00 removed.
Remaining San. Sewer
pipe east of M.H. 0+00
to be abandoned in place.

Murdock


Hillside

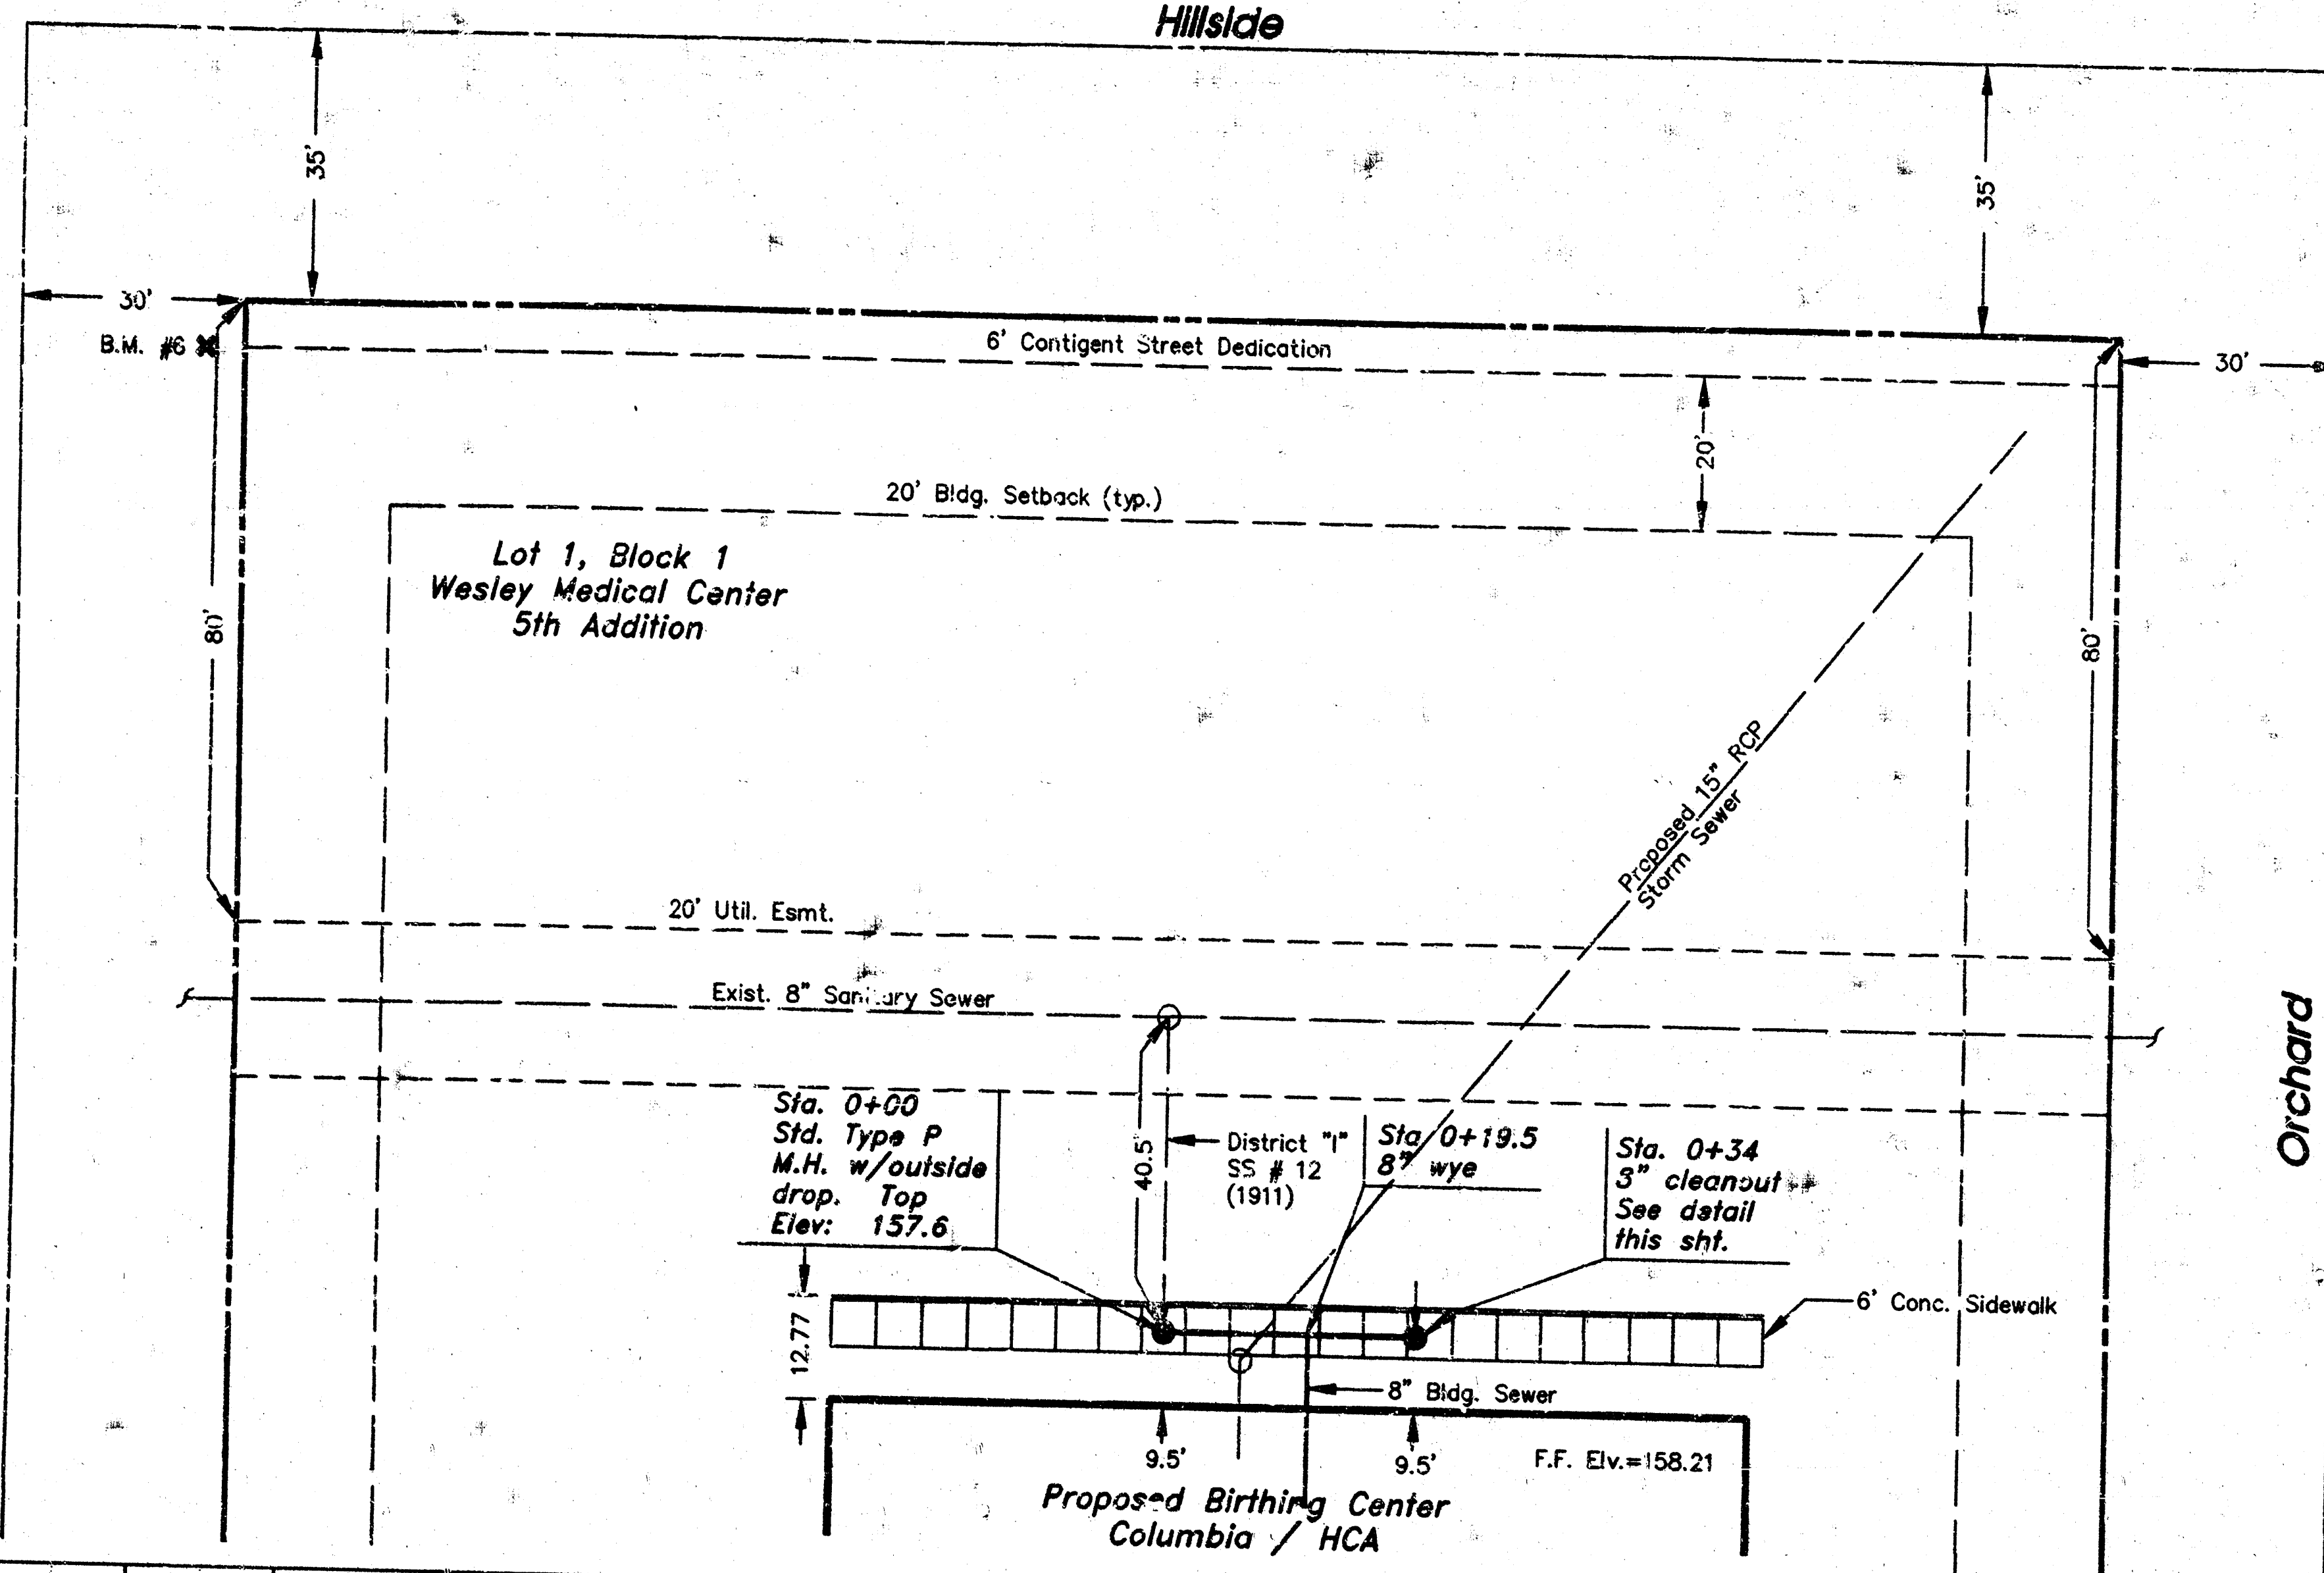

Orchard

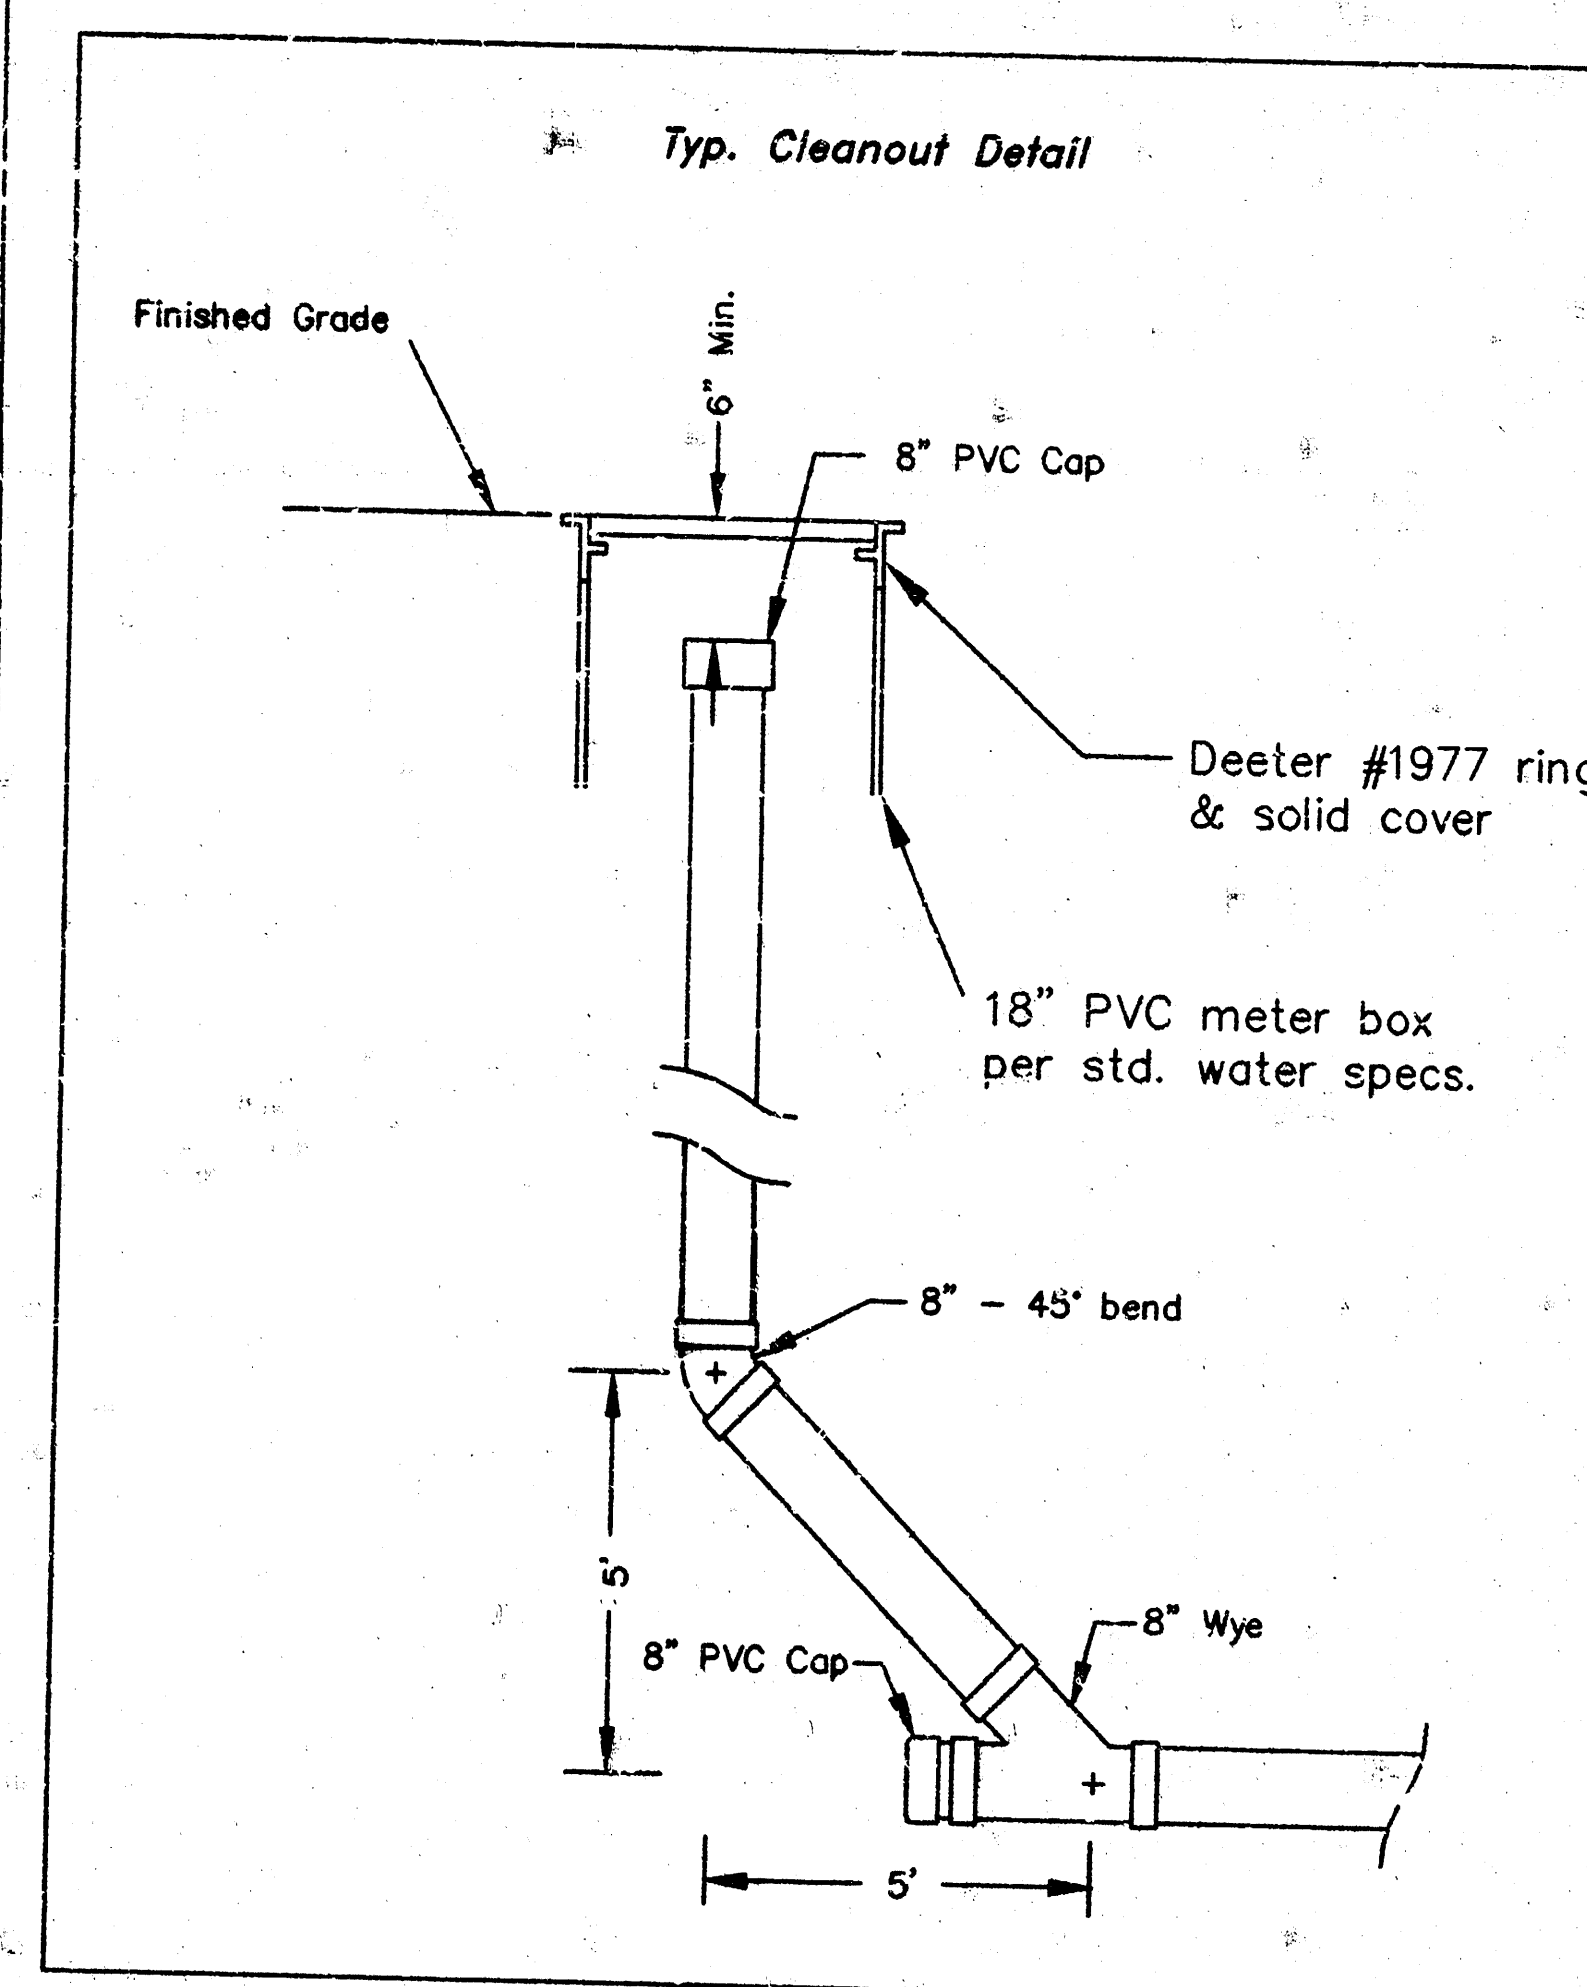


Private 8" Sanitary Sewer Extension
to serve
Proposed Birthing Center
Columbia/HCA Healthcare Corp.
Lot 1, Block 1
Wesley Medical Center 5th Addition
Wichita, Ks
February, 1996



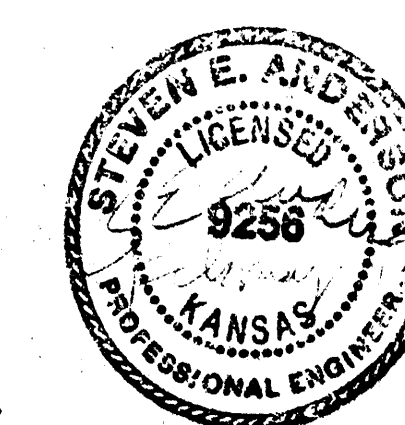


Booked
4-26-96
From As Bldgs


AS BUILT PLAN

598 PPS (607861)
S.E. Anderson PE/LS
Consulting Engineer
Whitewater, Ks

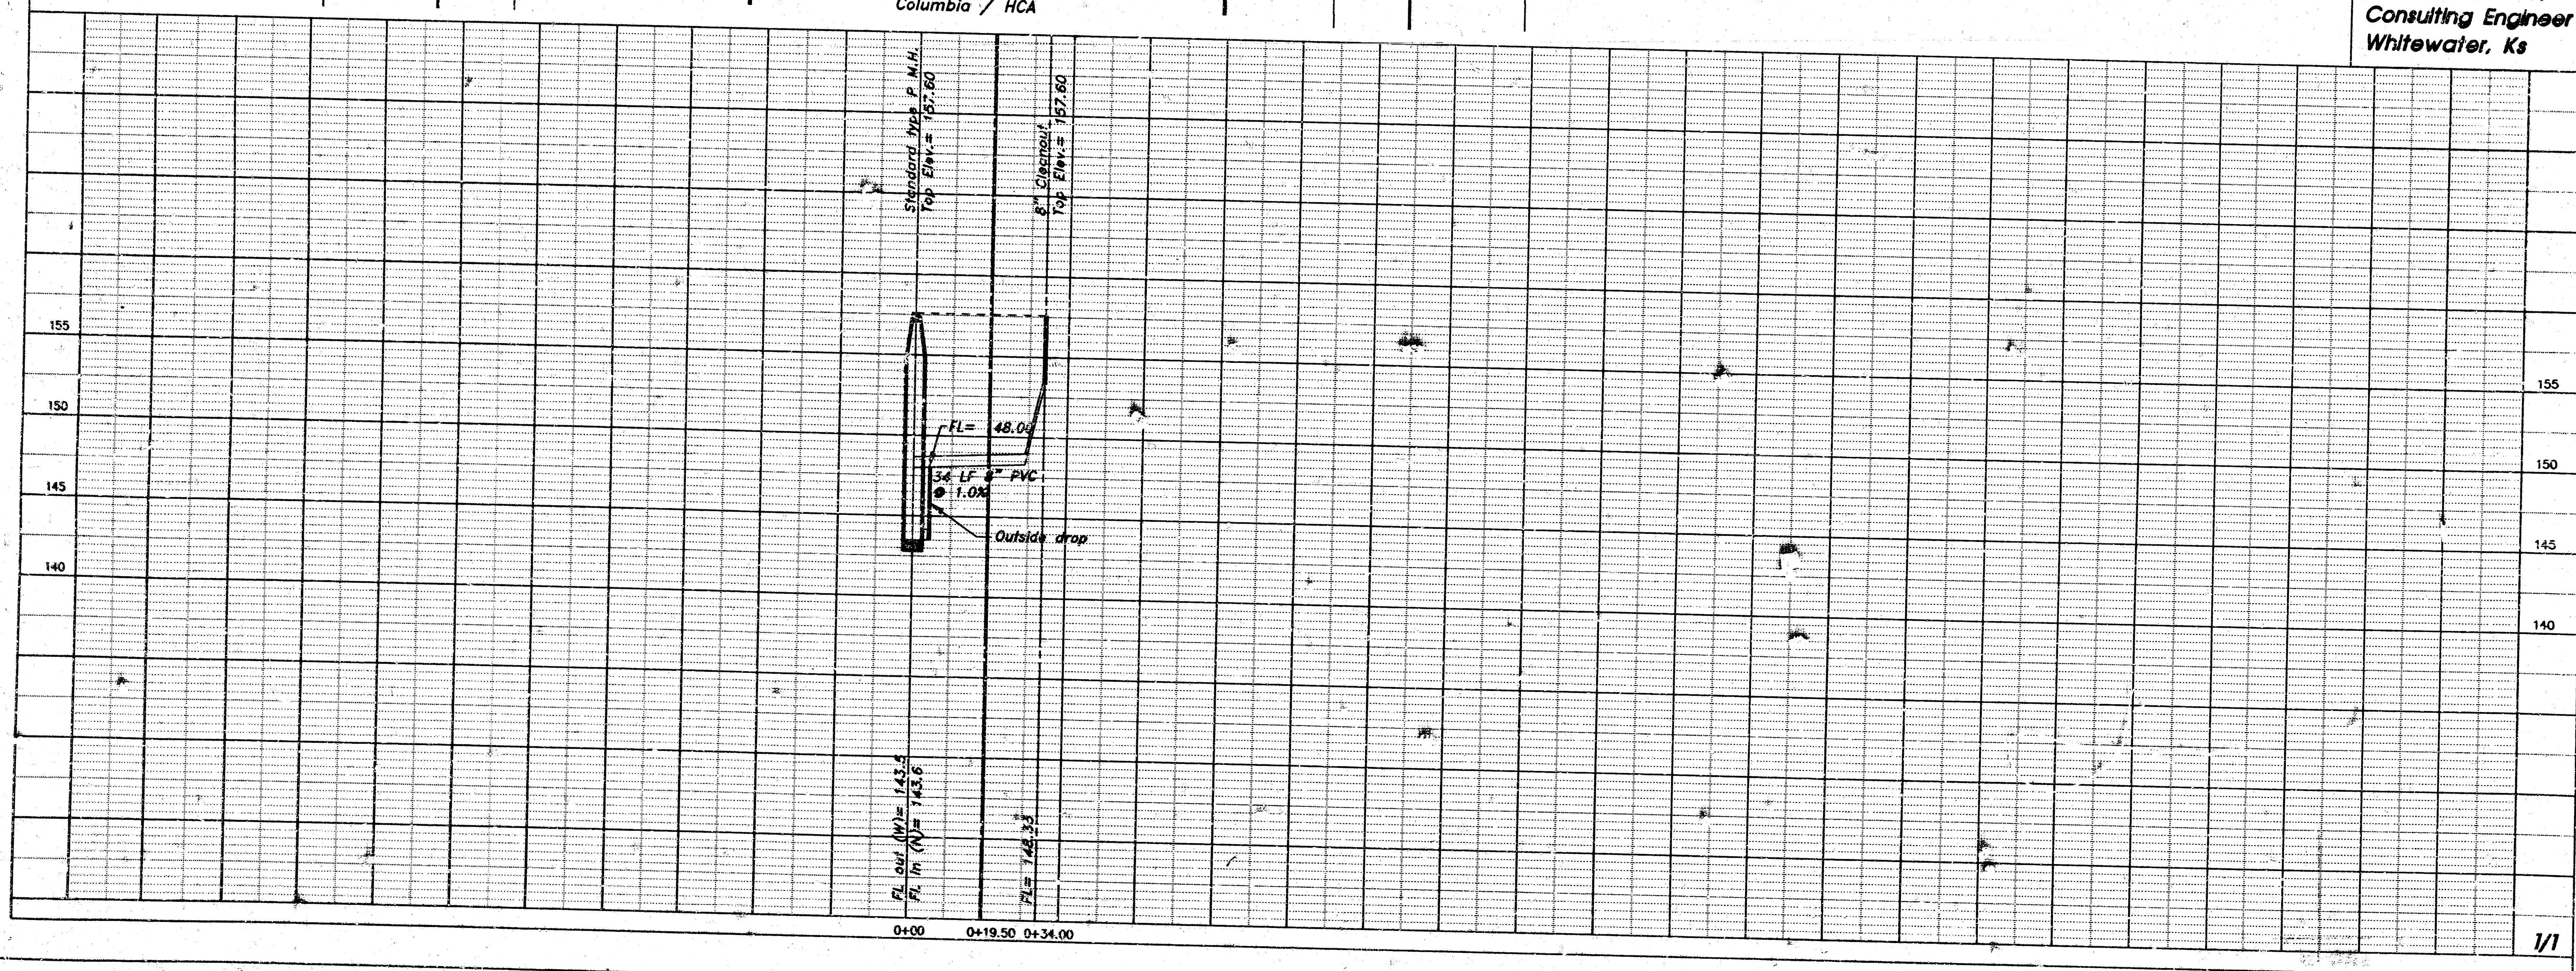

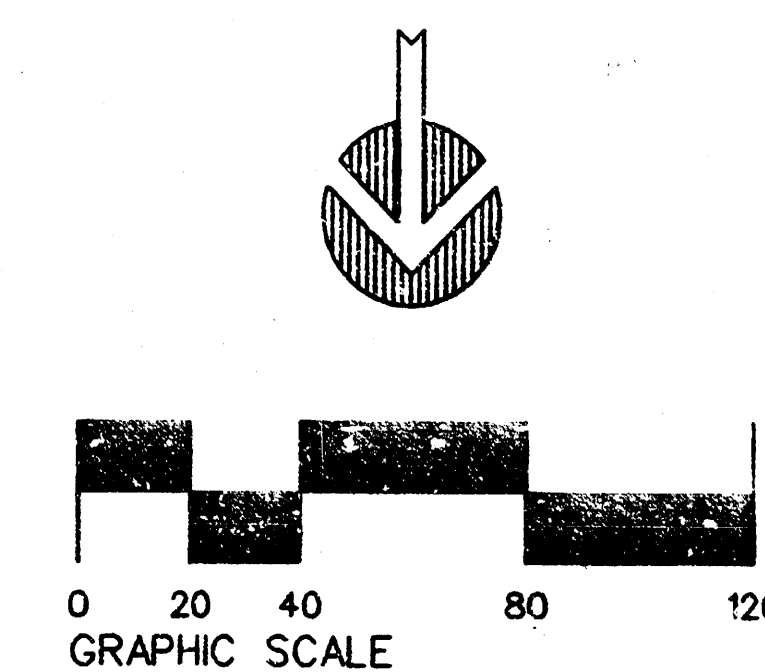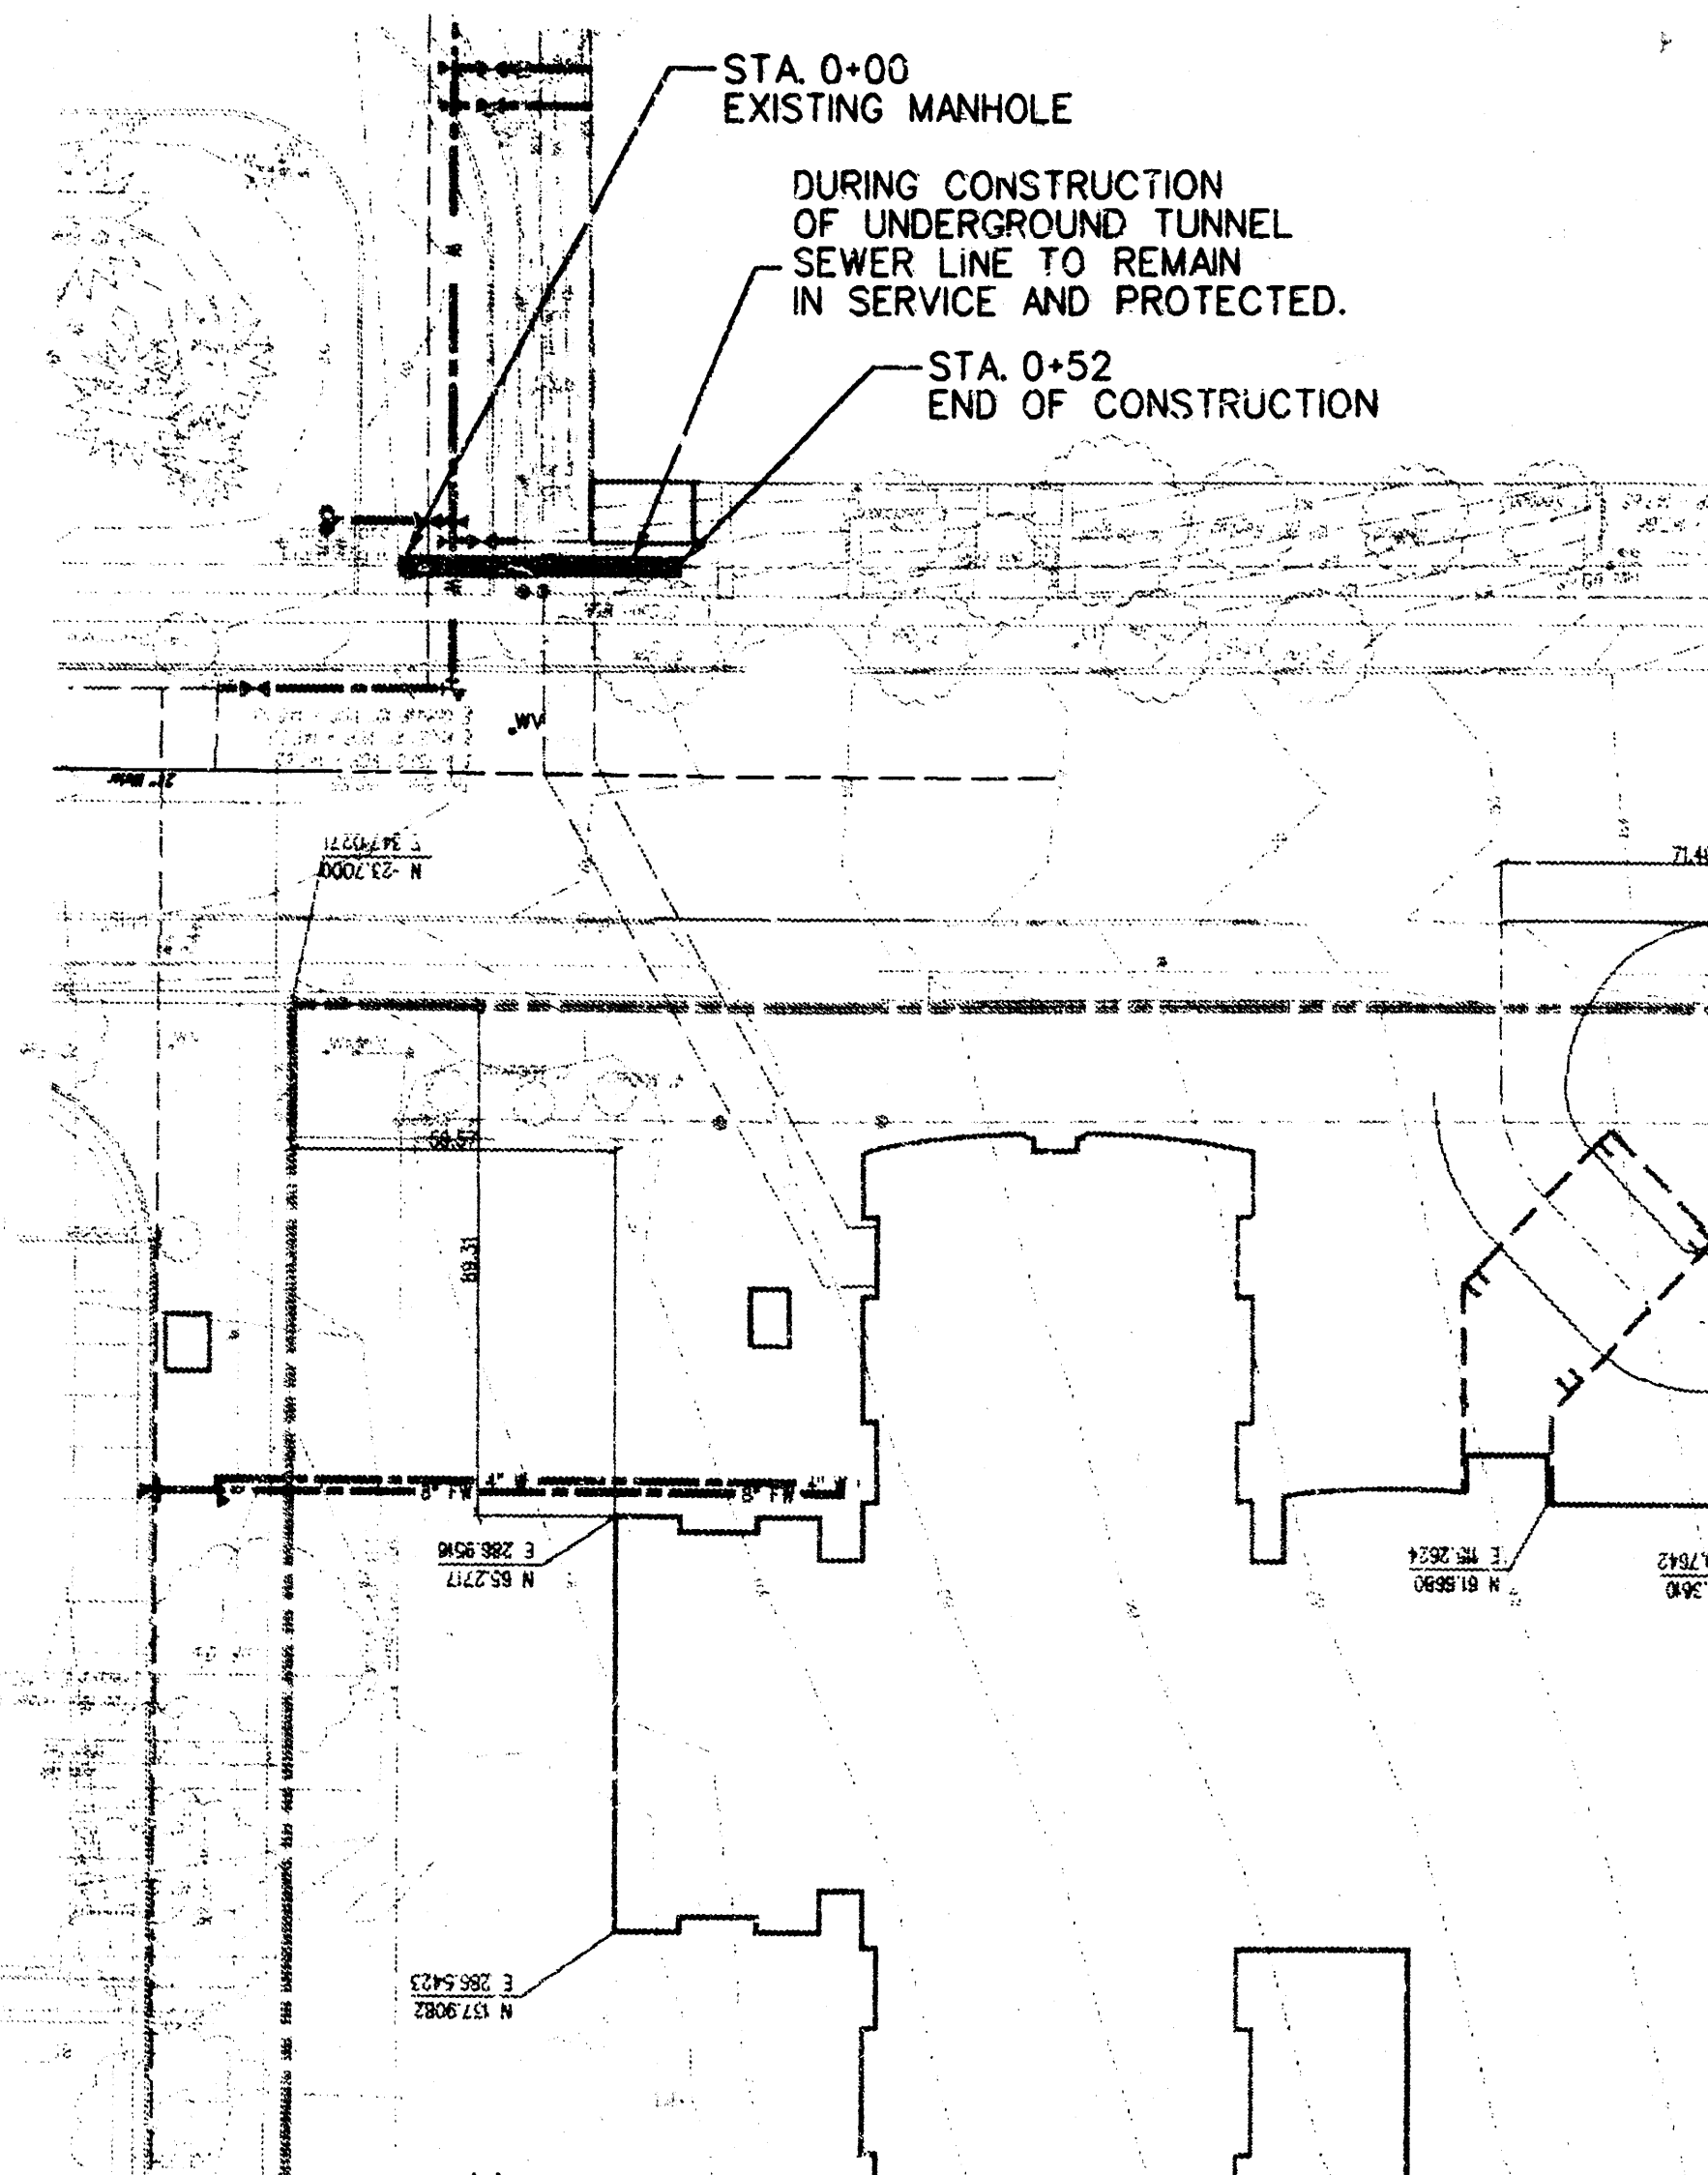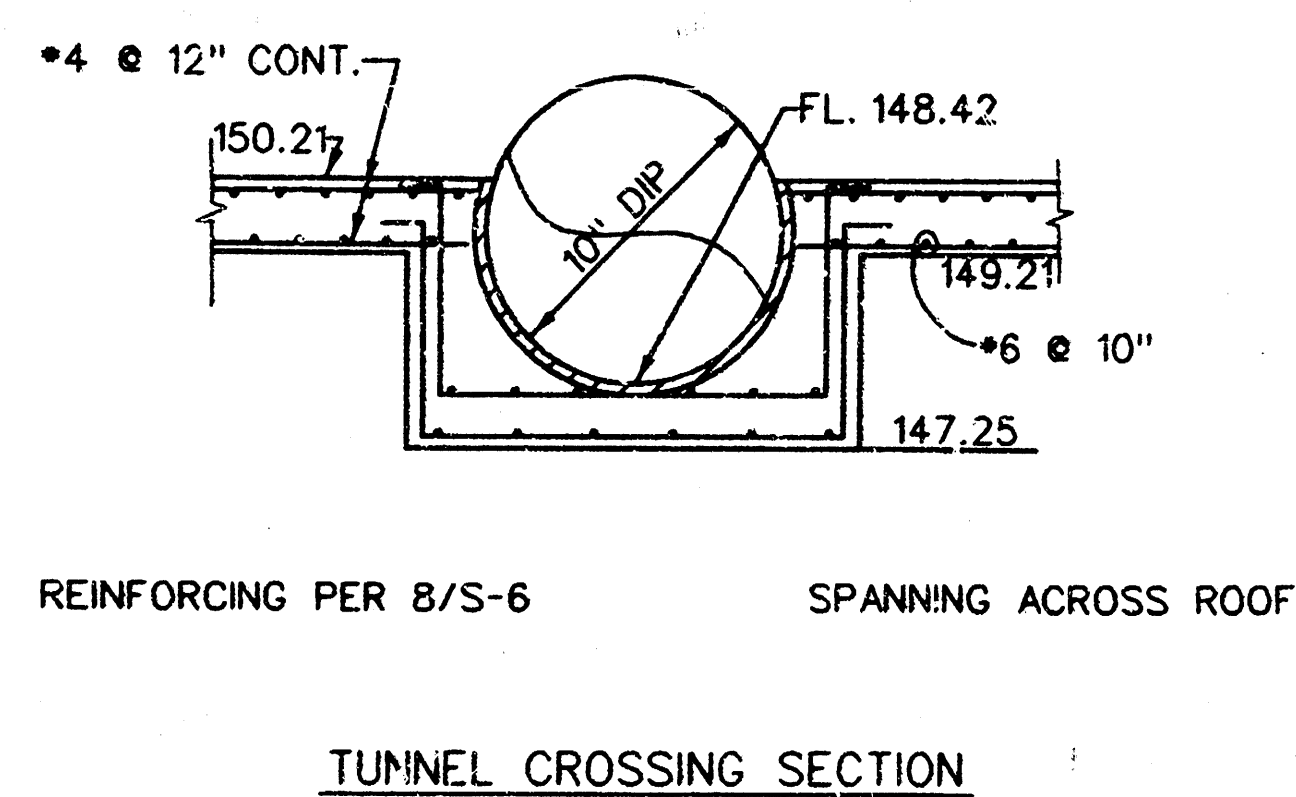

PROFILE: VERT. = 1"=5'
HORIZ. = 1"=40'

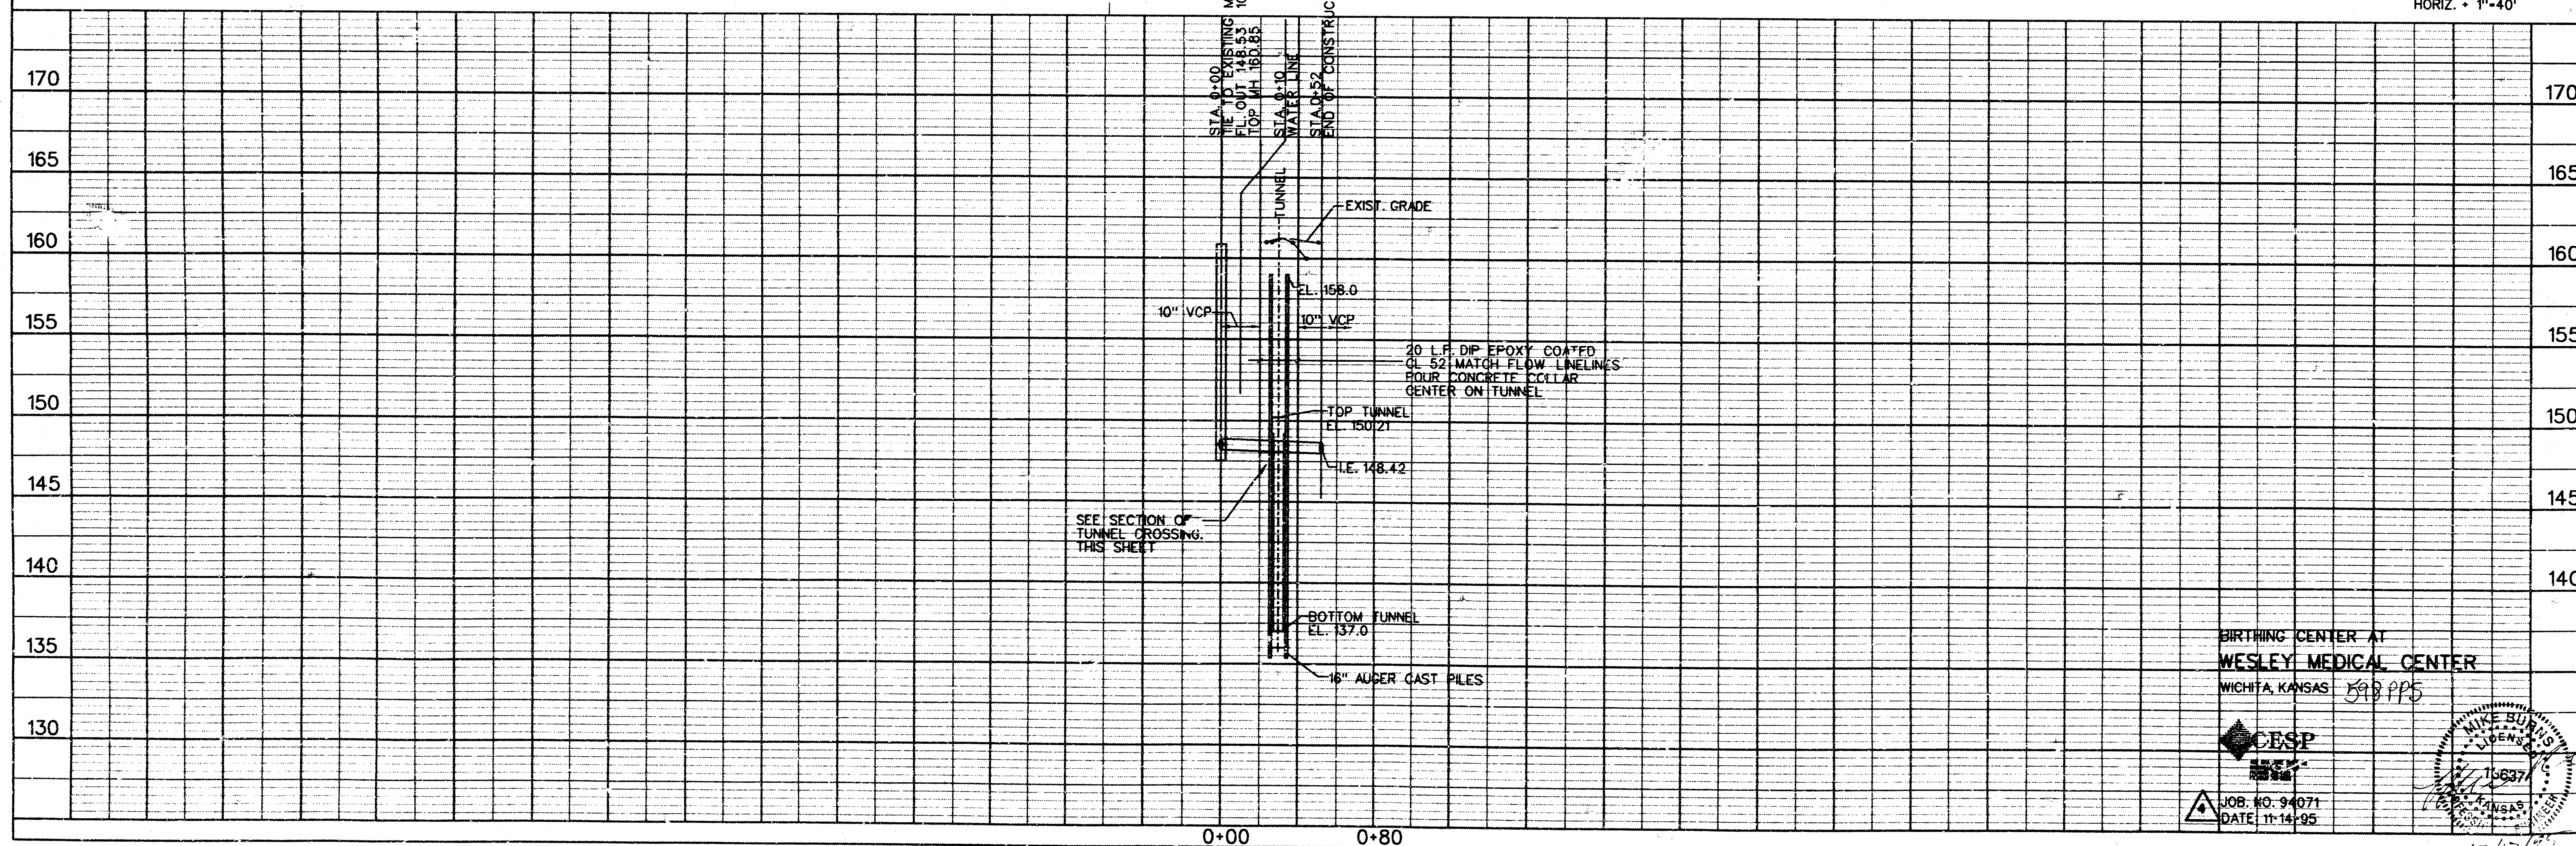


△ SANITARY SEWER PLAN AND PROFILE

△ C5.09


- BM * 2 CHISELED SQUARE ON TOP OF RETAINING WALL NE CORNER OF VASSAR & MURDOCK ELEV. = 163.70
- BM * 3 CHISELED SQUARE ON TOP OF CURB SW FLUME AT HOLYOKE & MURDOCK ELEV. = 160.84
- BM * 4 CHISELED SQUARE ON TOP OF CURB SW CORNER WHEEL CHAIR RAMP AT NE CORNER OF ORCARD & HILLSIDE ELEV. = 151.12
- BM * 5 CHISELED SQUARE ON TOP OF CURB NE CORNER WHEEL CHAIR RAMP AT SW CORNER OF HOLYOKE & ORCARD ELEV. = 163.00
- BM * 6 CHISELED SQUARE ON NW CORNER TRAFFIC SIGNAL POLE BASE AT SW CORNER OF HILLSIDE & MURDOCK ELEV. = 150.04

* NOTE:
SEE STANDARD DROP INLET DETAIL
FURNISHED BY THE CITY ENGINEER
OF WICHITA, KANSAS.

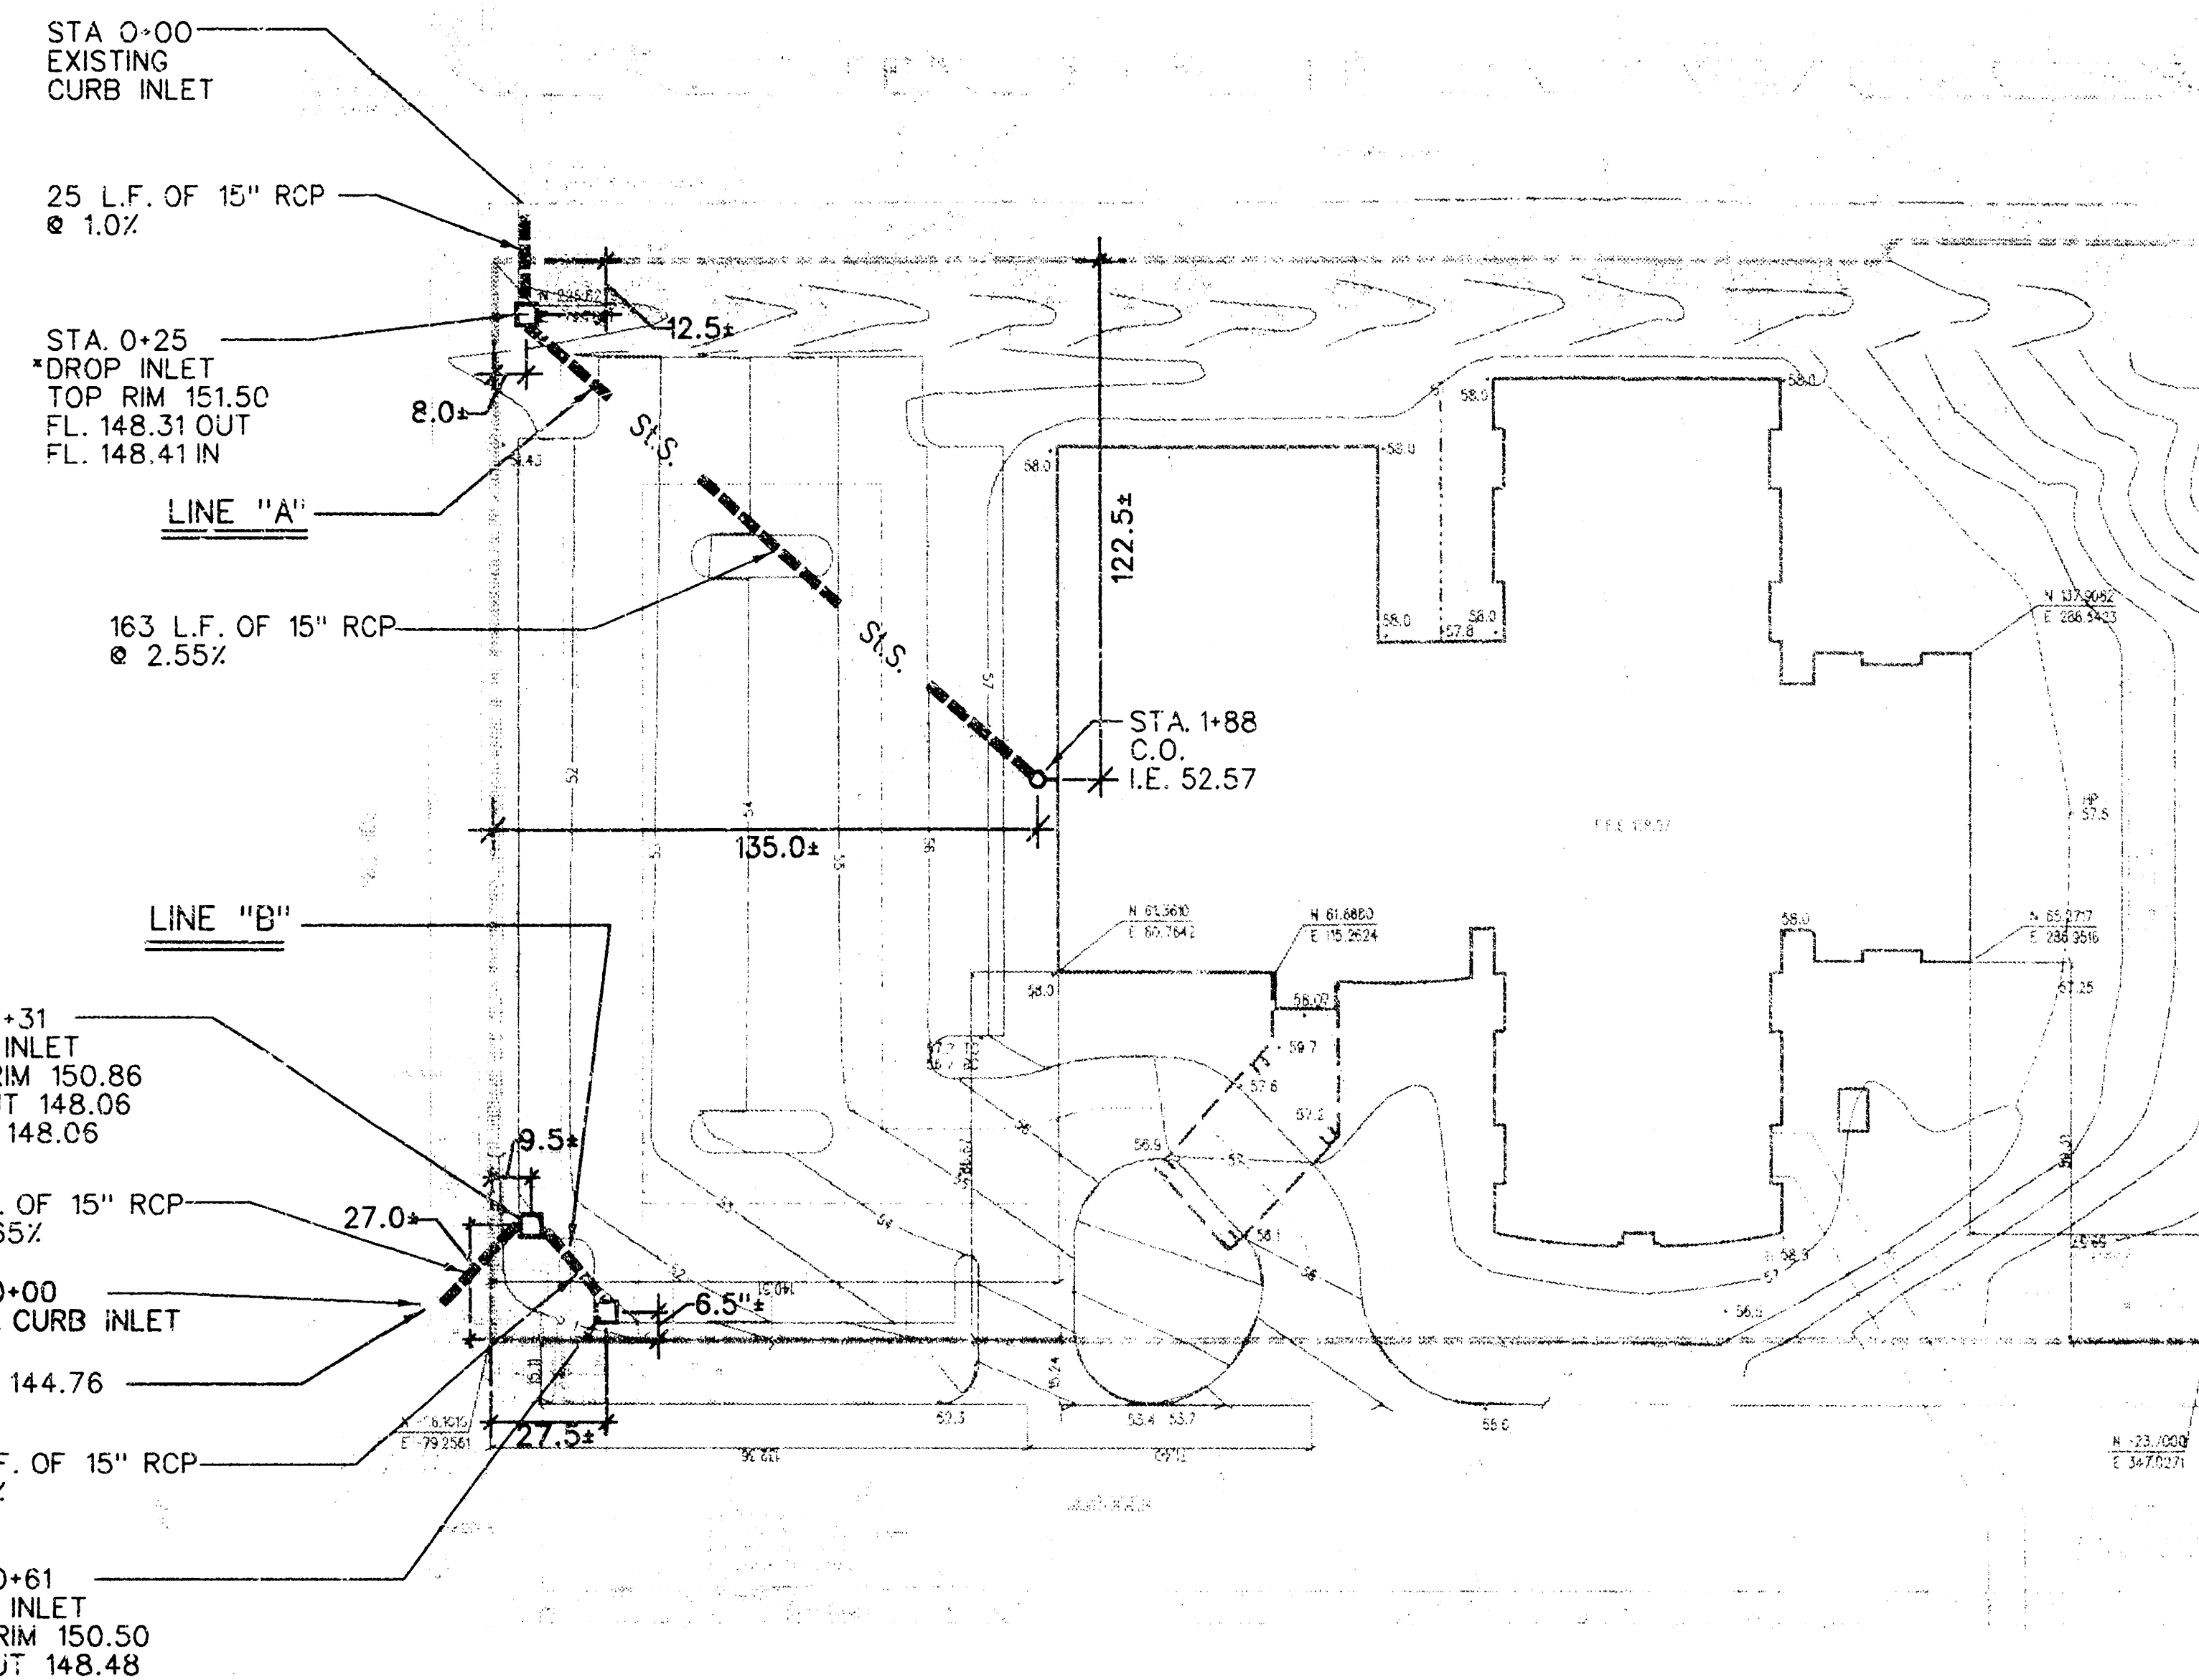


NOTE TO CONTRACTOR
 INSPECTION AND TESTING FOR THIS PROJECT IS TO BE PROVIDED BY A LICENSED CONSULTING ENGINEERING FIRM UNDER CONTRACT WITH THE OWNER/DEVELOPER. SAID INSPECTION TO BE IN ACCORDANCE WITH THE CITY OF WICHITA STANDARD CONSTRUCTION ENGINEERING PRACTICES AND CERTIFIED BY A LICENSED PROFESSIONAL ENGINEER. NO WORK SHALL BE PERFORMED IN DEDICATED EASEMENTS OR THE PUBLIC RIGHT-OF-WAY BY THE CONTRACTOR WITHOUT SUCH INSPECTION NOR SHALL ANY WORK BE COMMENCED IN DEDICATED EASEMENTS OR PUBLIC RIGHT-OF-WAY WITHOUT WRITTEN AUTHORIZATION BY THE CITY ENGINEER.

APPROVED AS NOTED
 By CITY ENGINEER OF WICHITA
 Sanitary Sewers VRH 12/13/95
 Storm Sewers VRH 12/13/95
 Driveway Approaches _____
 Water Mains _____
 Paving _____

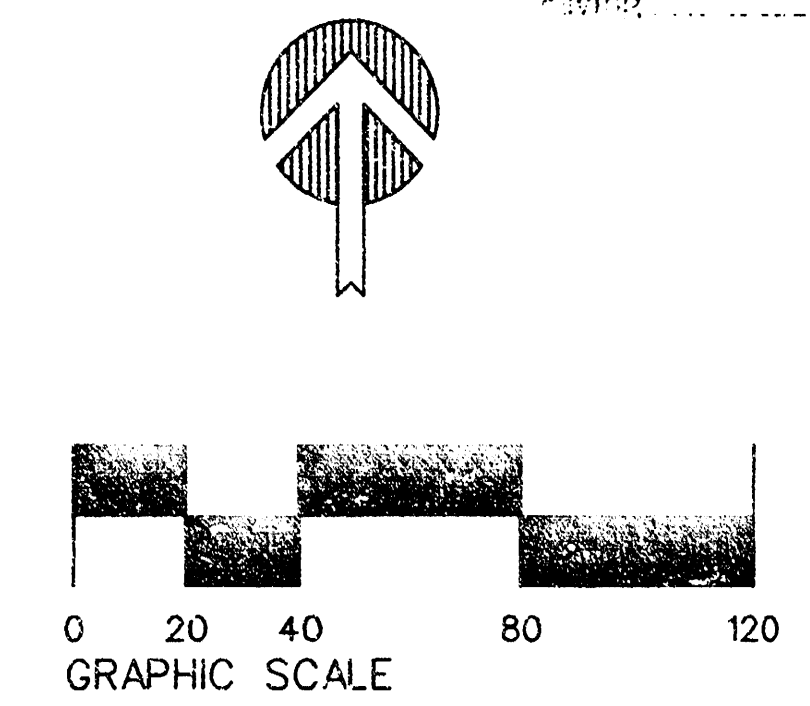


PROFILE: VERT. 1"=5'
 HORIZ. 1"=40'

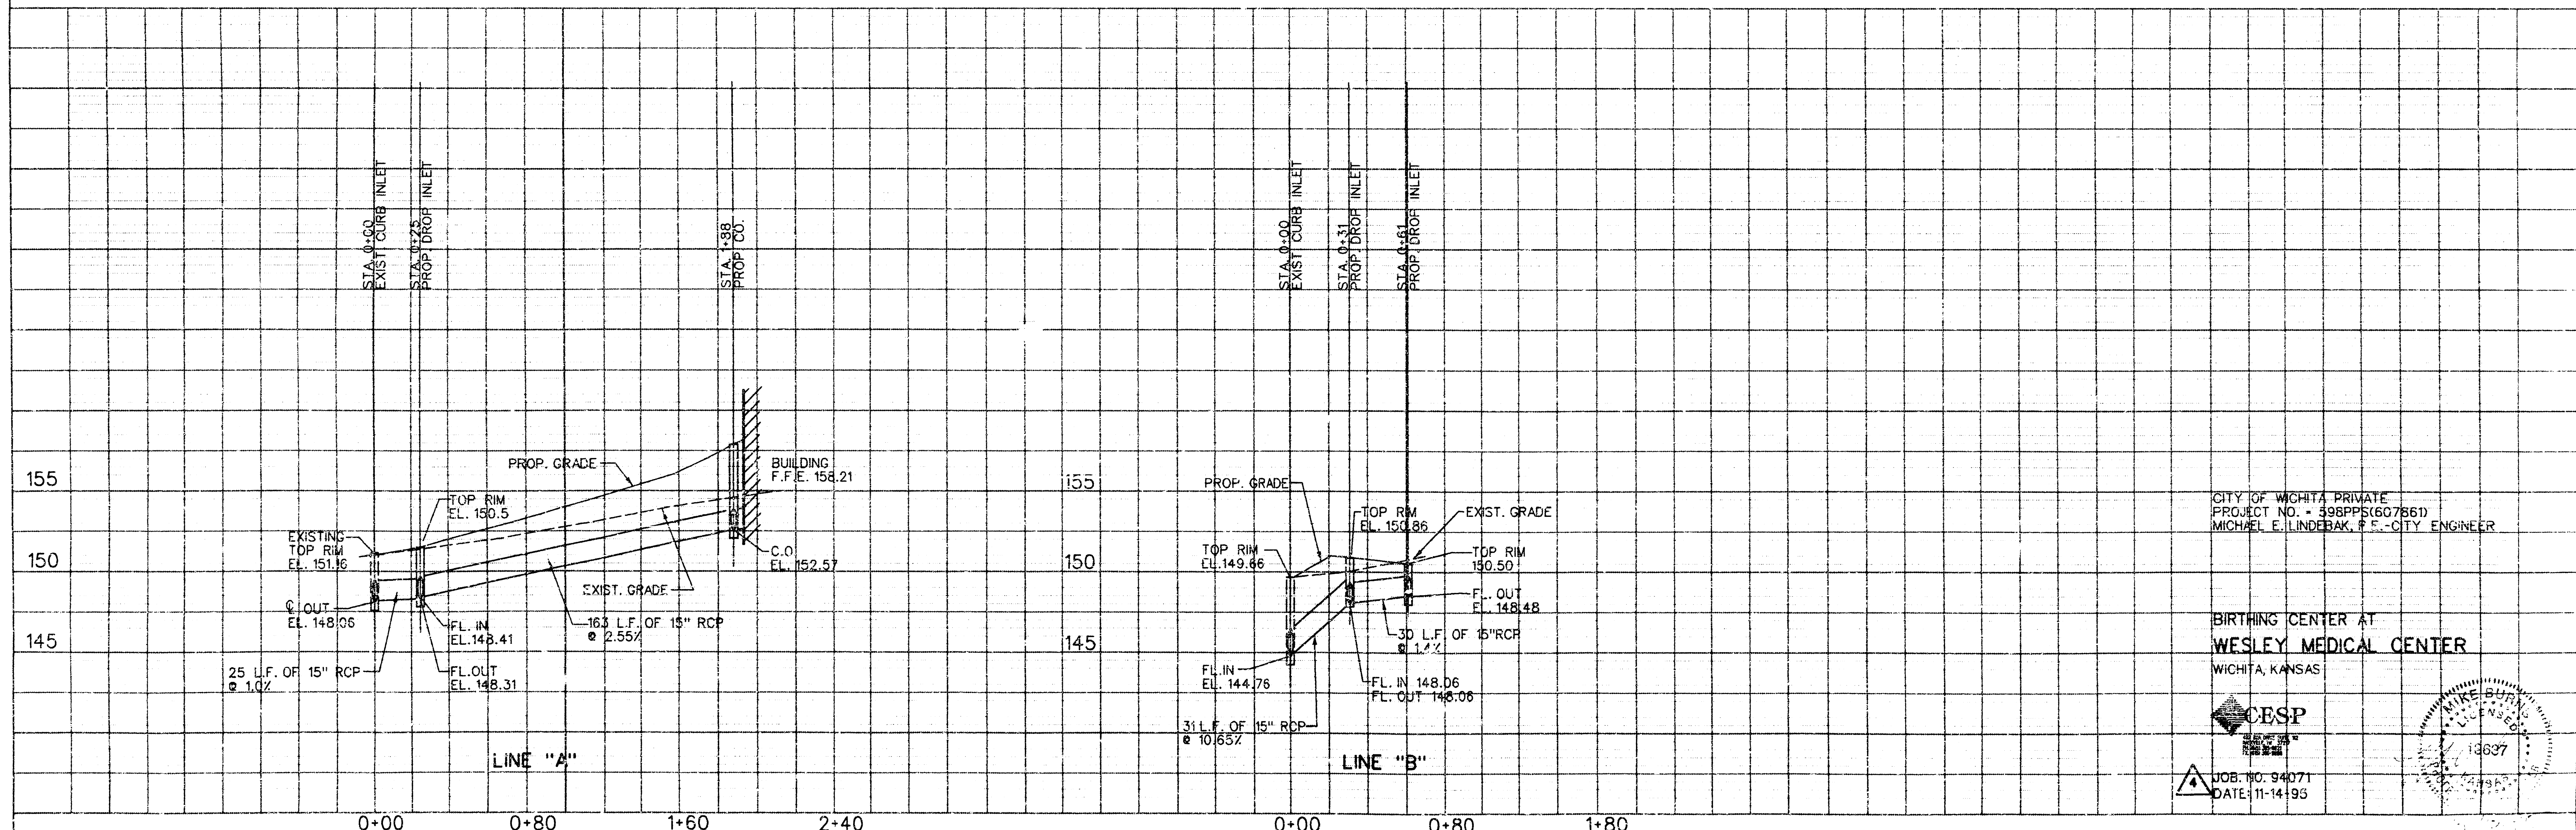

CITY OF WICHITA PRIVATE
 PROJECT NO. = 498PPS(607861)
 MICHAEL E. LINDERAK, P.E. - CITY ENGINEER

BIRTHING CENTER AT
 WESLEY MEDICAL CENTER
 WICHITA, KANSAS

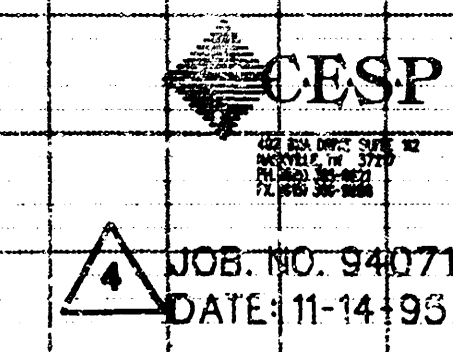

JOB NO. 94071
 DATE: 11-14-93

△ STORM DRAINAGE PLAN AND PROFILE 598 PPS △ C5.10