


1-24-77
APPROVED AS NOTED
By CITY ENGINEER OF WICHITA
Sanitary Sewers D.F.S.
Storm Sewer _____
Driveway Approaches _____

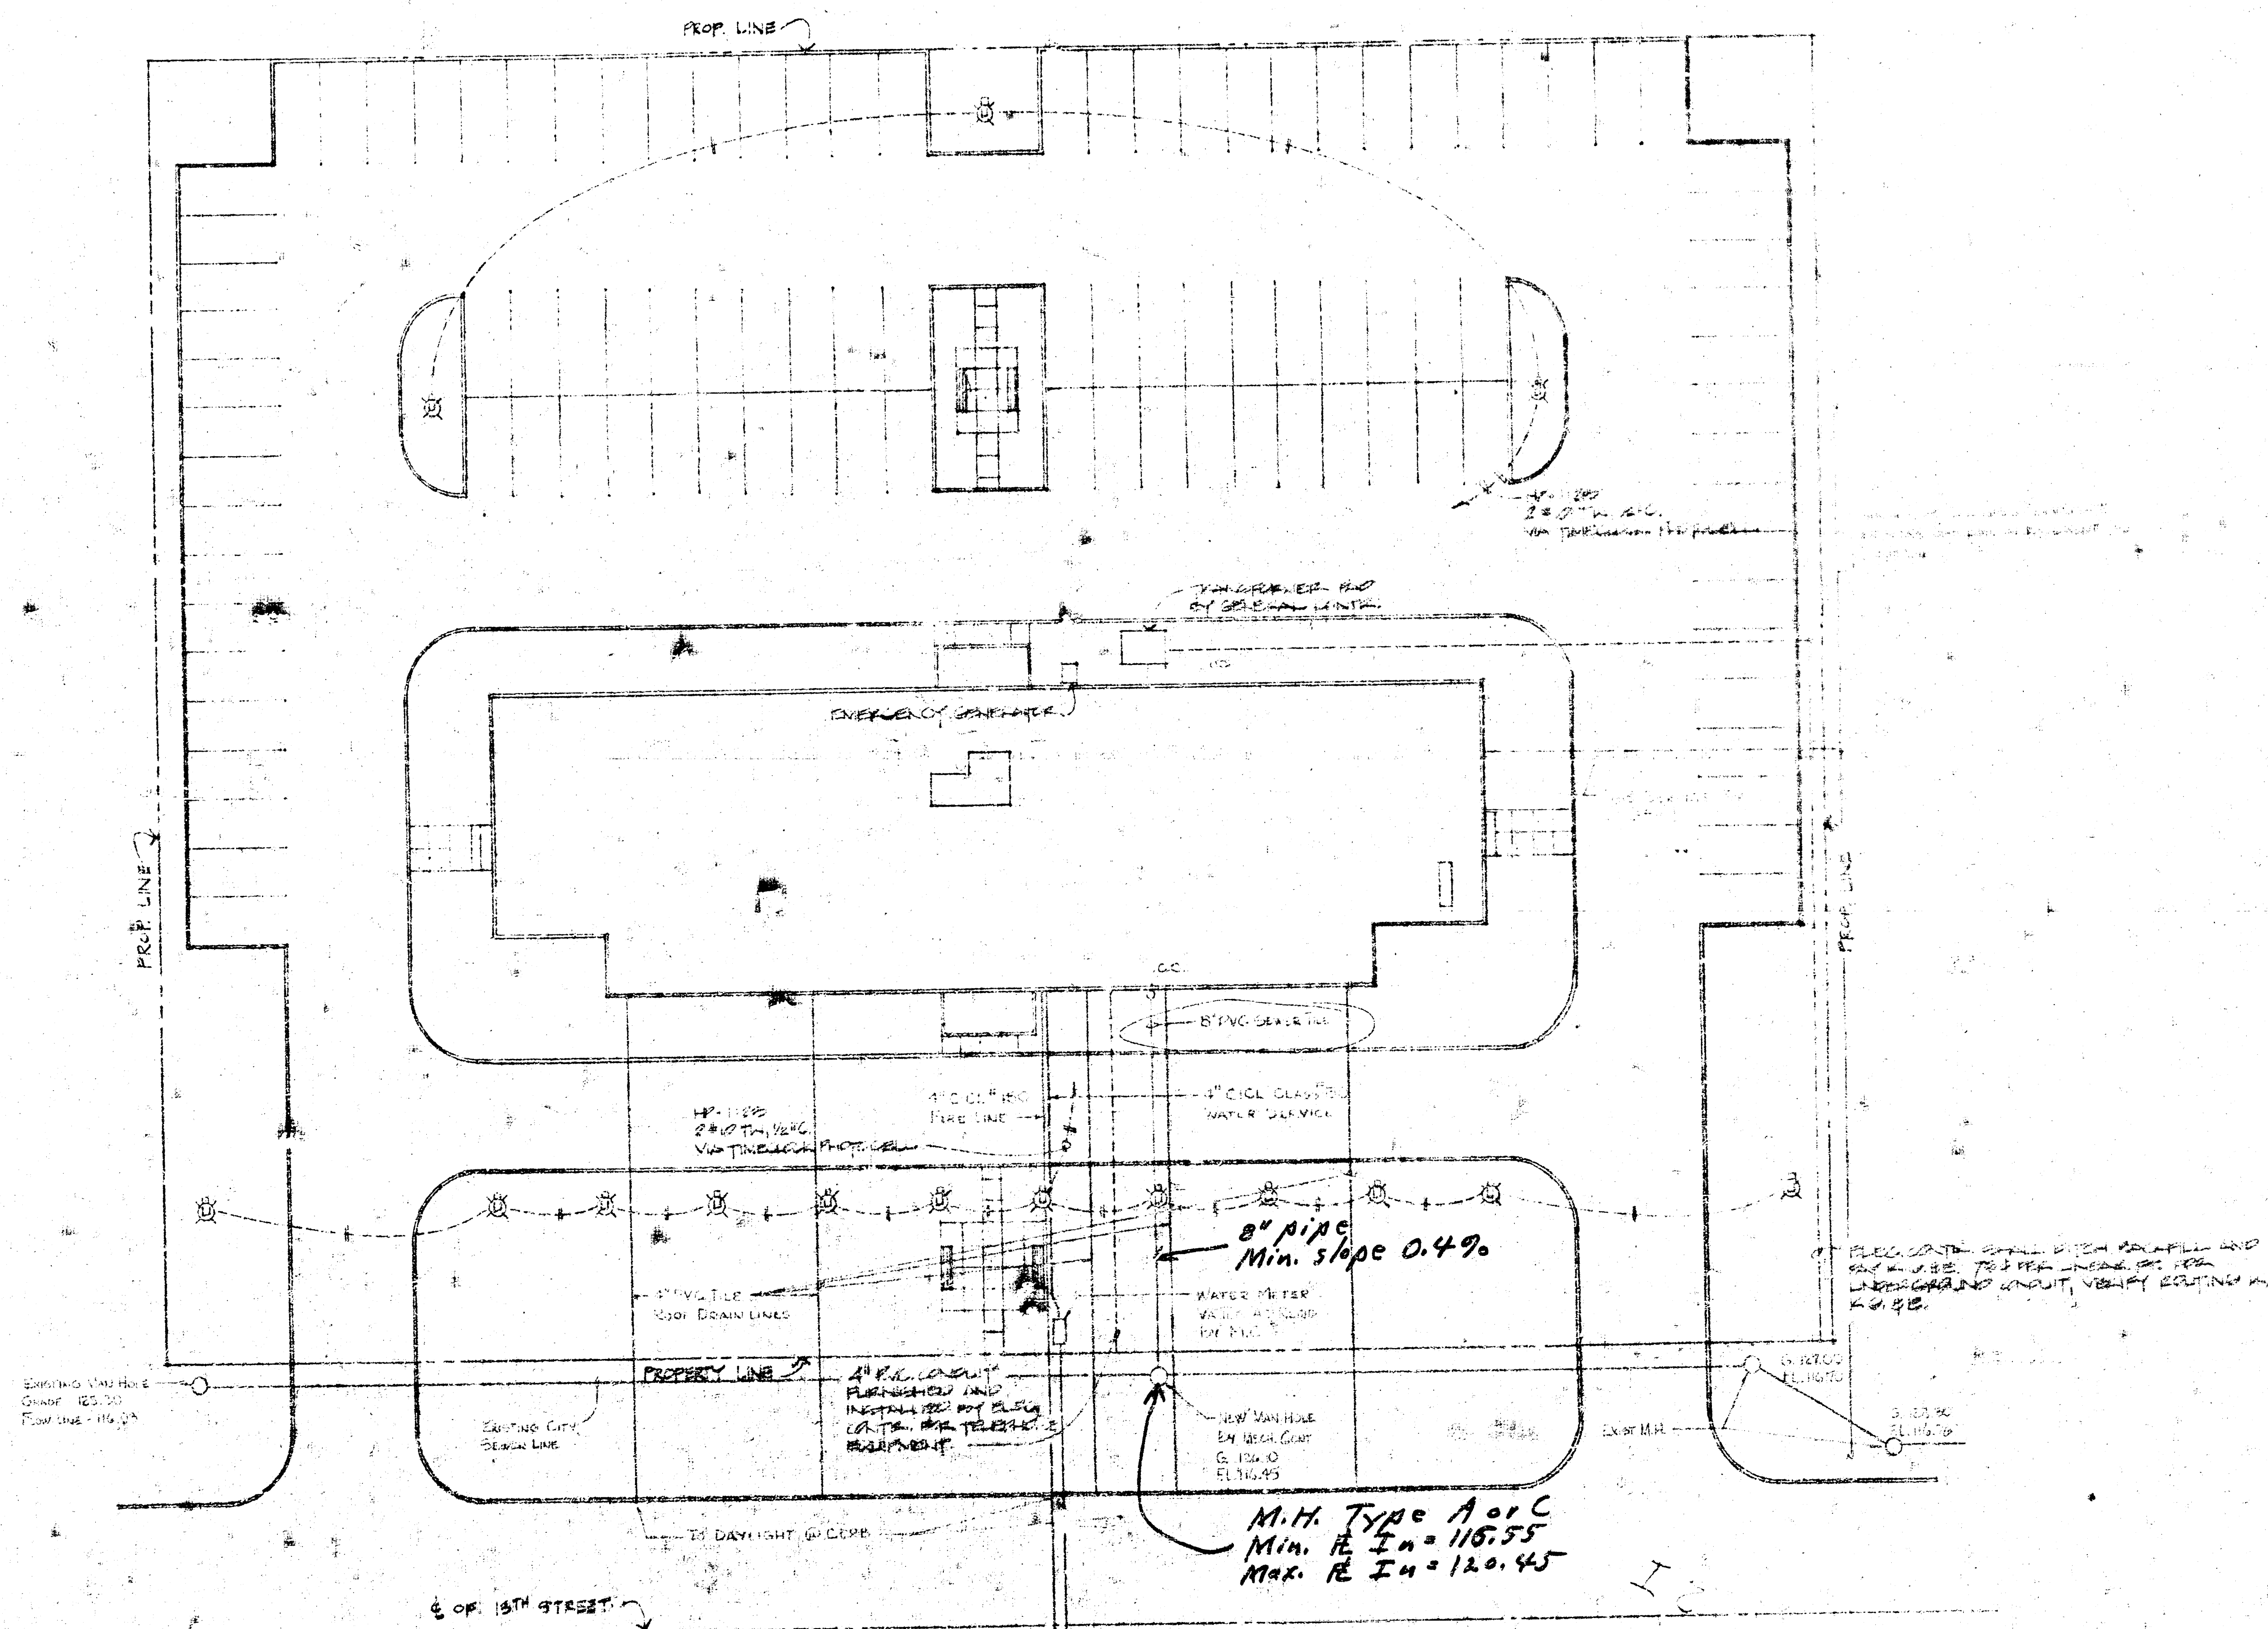

WEST PARK TOWER
WEST 31ST STREET
KANSAS CITY, MO.

sheet title
GATEWAY

sheet number