


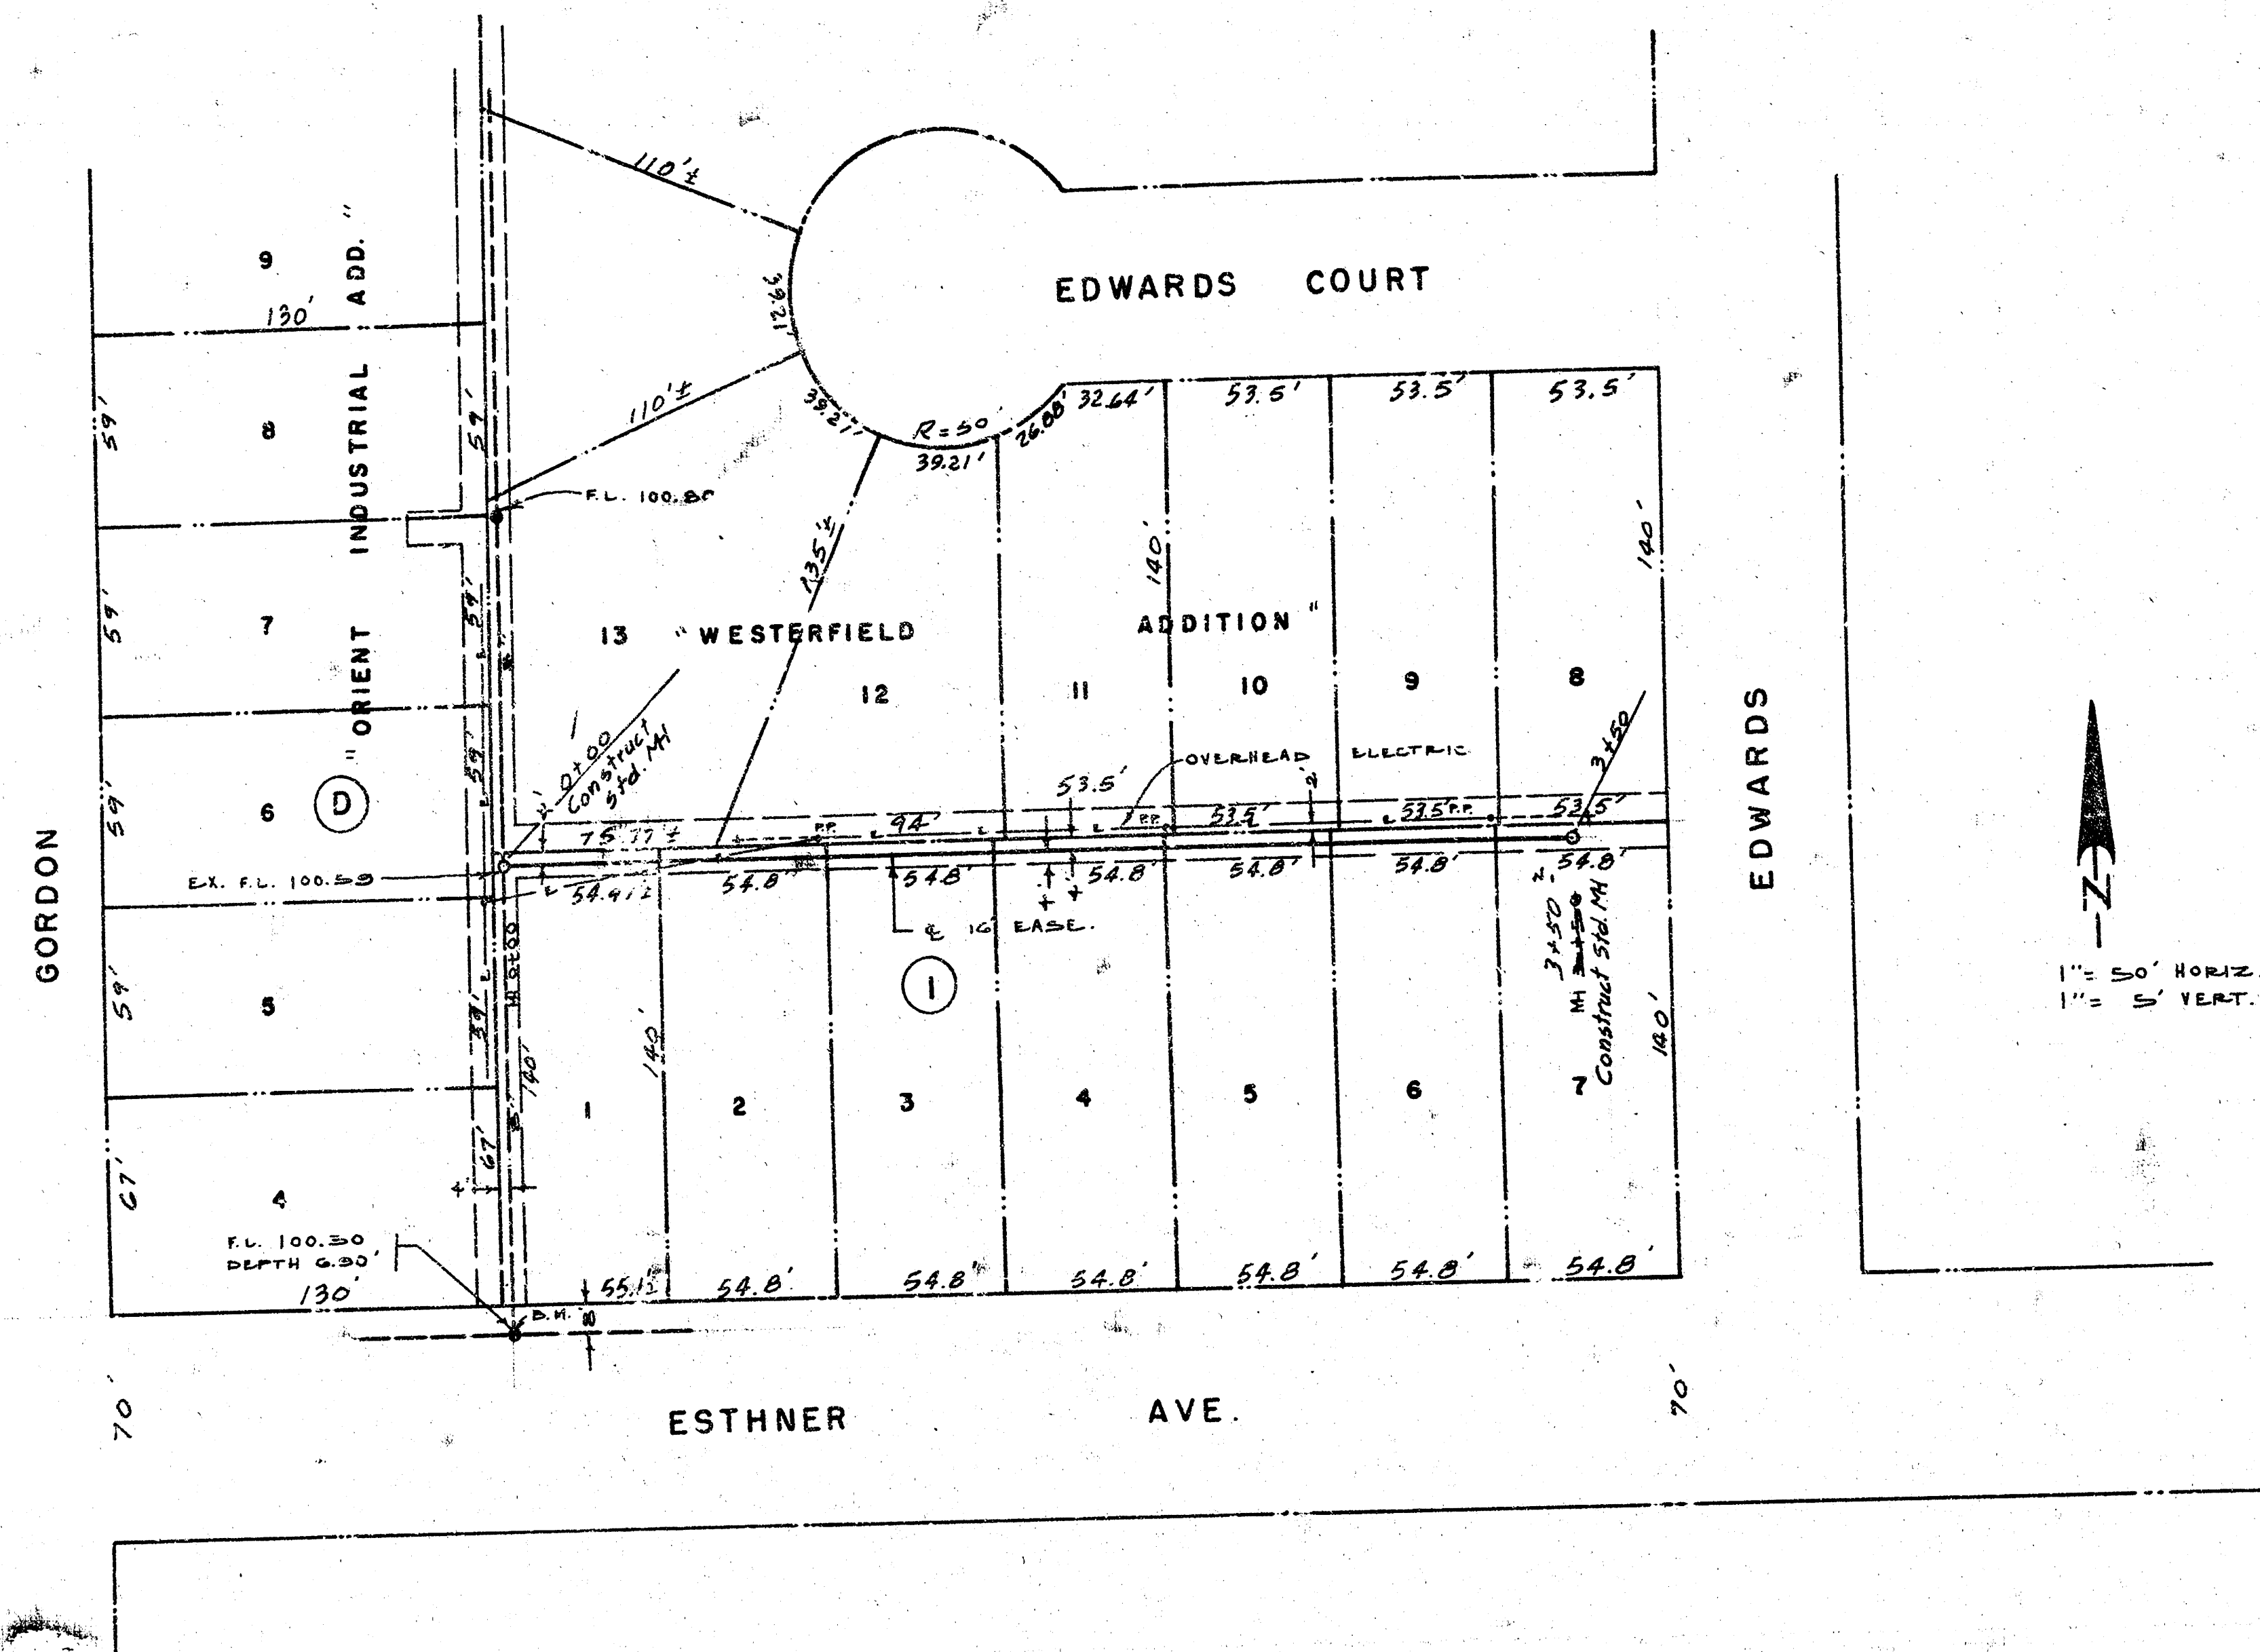

NOTE TO CONTRACTOR
 This project will be constructed under the supervision of the CITY ENGINEER and conforming to the SPECIFICATIONS of the CITY OF WICHITA. The CONTRACTOR will reimburse the City of Wichita for all cost of engineering, plans, and inspection.


10-19-79
APPROVED AS NOTED
 By CITY ENGINEER OF WICHITA
 Sanitary Sewers *Red*
 Storm Sewers _____
 Driveway Approaches _____

SANITARY SEWER EXTENSION TO SERVE
 LOTS 1 THRU 13, BLOCK 1, WESTERFIELD
 ADDITION.

KENNETH O. TAYLOR, P.E.
 OCT. 15, 1979



BM - ELEV. 107.20 : NORTH RIM OF MH 2' SOUTH AND 4' EAST
 OF THE SW CORNER OF LOT 1, BLOCK 1,
 WESTERFIELD ADDITION.

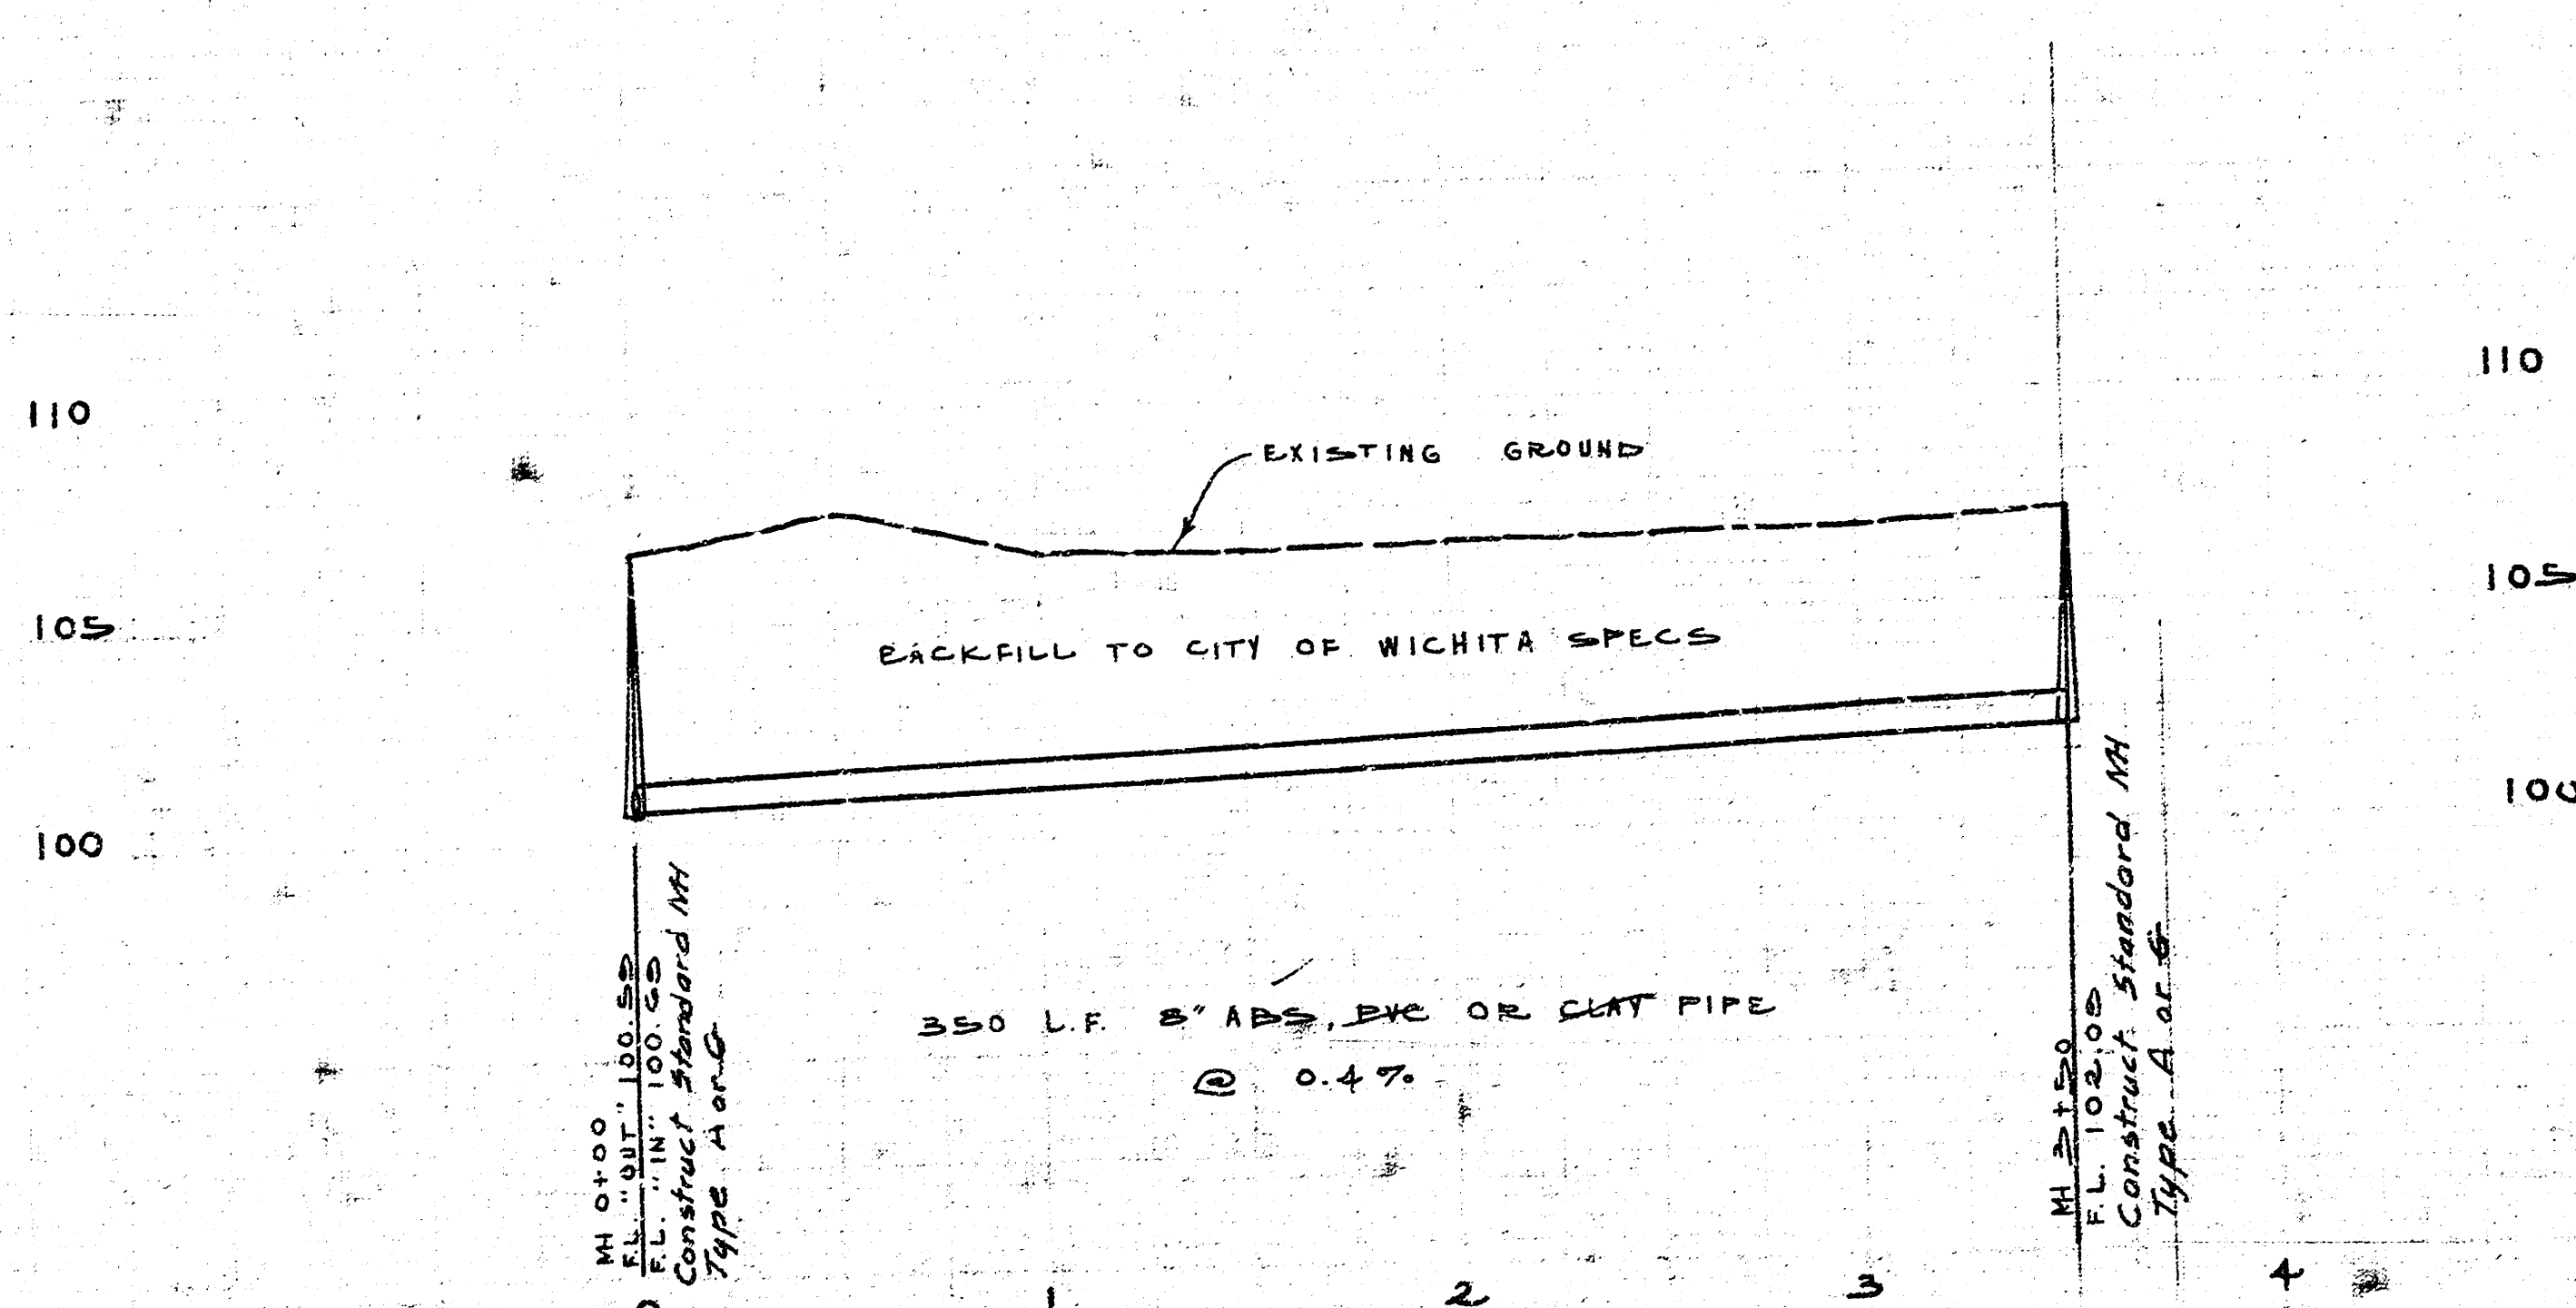

As Built *QPS*
 3/5/80

PROJECT NO. 468-76-245-80865-000-000-008