



BENCH MARKS:
 City Disc @ Pawnee and Sheridan,
 Elev. = 103.29 City Datum
 "X" Cut on High Edge West Side of Sheridan
 107" South Line of Lot 1, Blk 1, Westport
 Industrial Park First Addition.
 Elev. = 102.68 City Datum

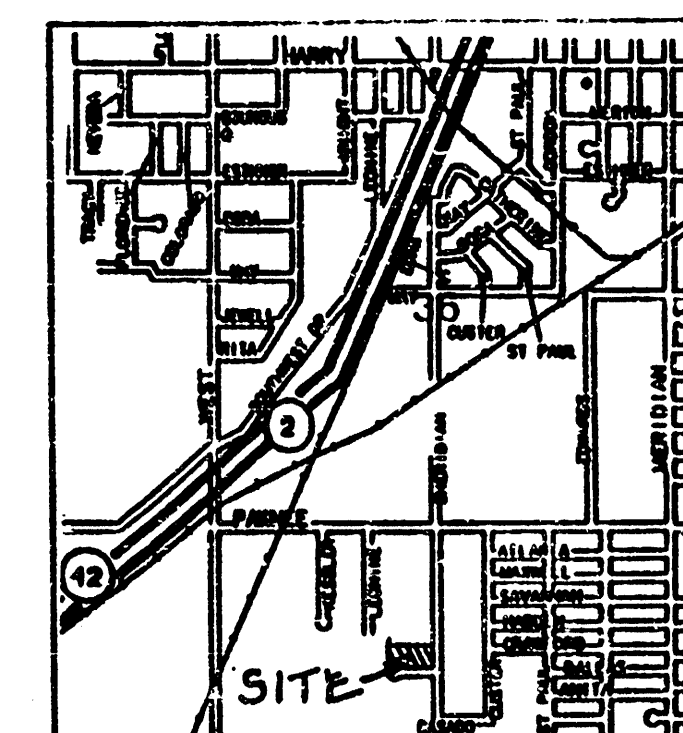



LOCATION MAP

Plan: 1" = 20'-0"
 Profile: 1" = 5'-0"
 ● = Iron

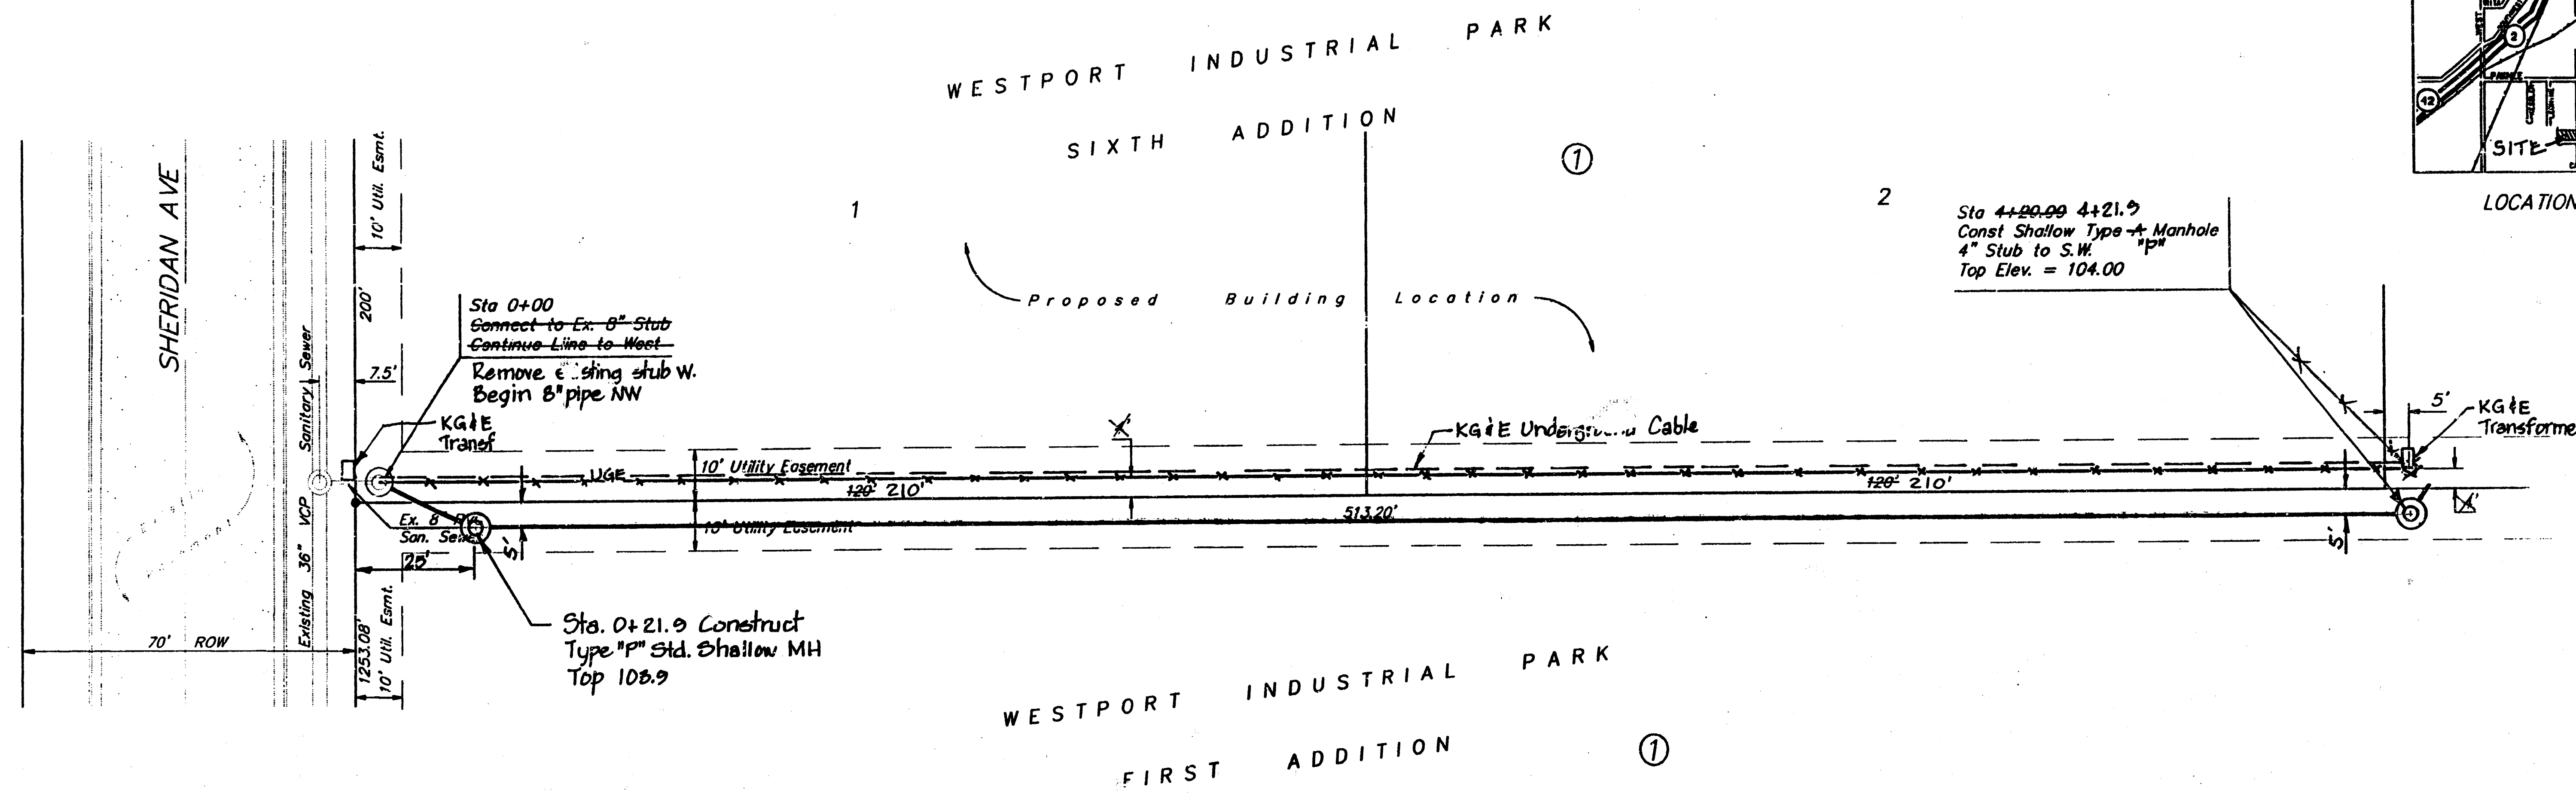

APPROVED AS NOTED
 BY CITY ENGINEER OF WICHITA
 Sanitary Sewers PH 9/19/91
 Storm Sewers _____
 Driveway Approaches _____
 Water Mains _____
 Paving _____

NOTE TO CONTRACTORS
 Inspection and testing for this project is to be provided by a Licensed Consulting Engineering Firm under contract with the Owner/Developer. Soil inspection to be in accordance with the City of Wichita standard construction engineering practices and certified by a Licensed Professional Engineer. No work shall be performed in dedicated easements or public right-of-way by the Contractor without such inspection nor shall any work be commenced without written authorization by the City Engineer.

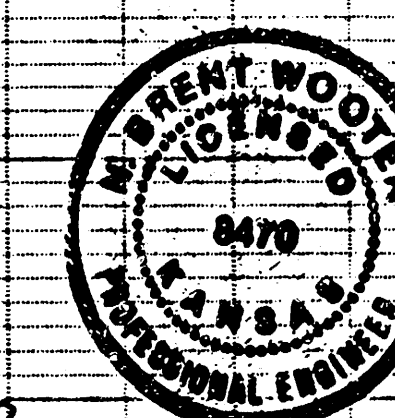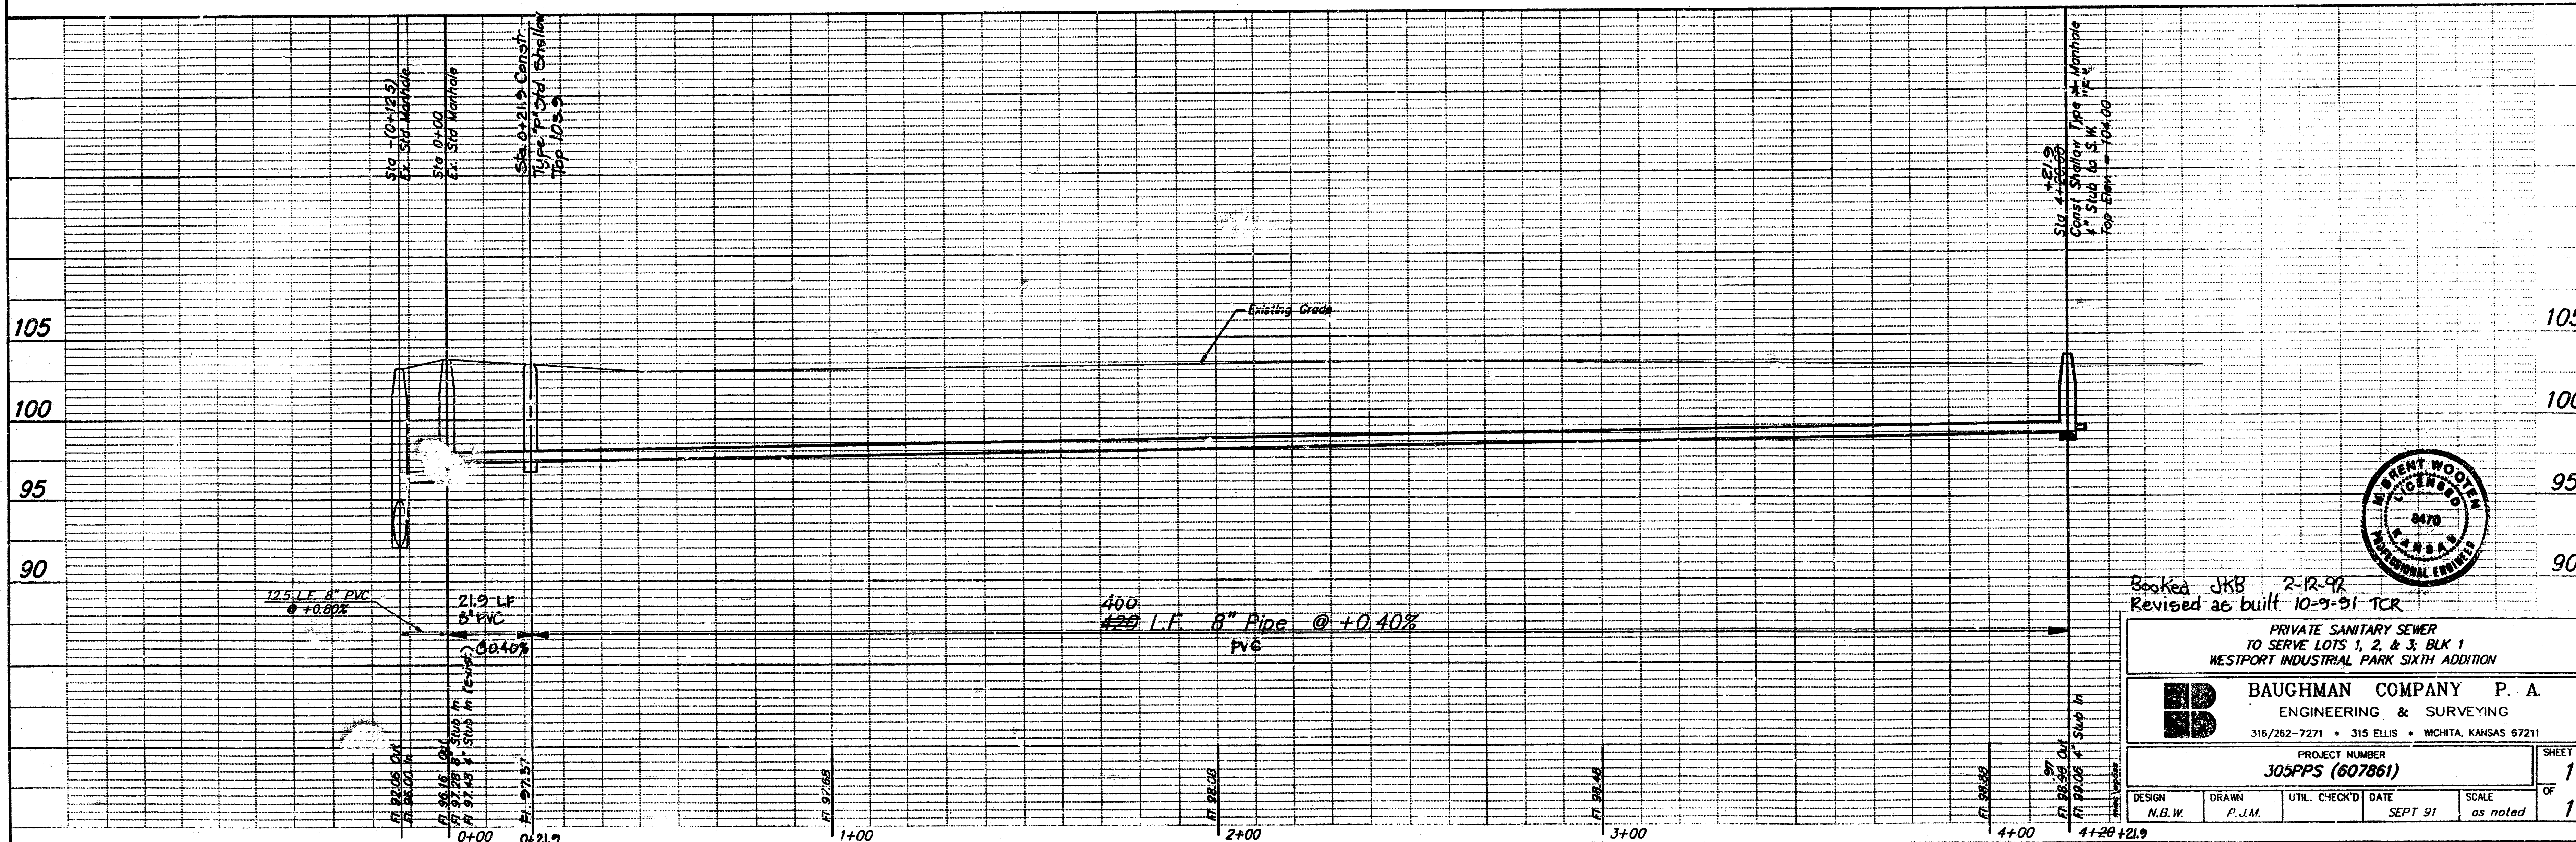

Booked JKB 2-12-92
 Revised as built 10-9-91 TCR

PRIVATE SANITARY SEWER TO SERVE LOTS 1, 2 & 3, BLK 1 WESTPORT INDUSTRIAL PARK SIXTH ADDITION			
BAUGHMAN COMPANY P. A. ENGINEERING & SURVEYING 316/262-7271 • 315 ELLIS • WICHITA, KANSAS 67211			
PROJECT NUMBER 305PPS (607861)			SHEET 1 OF 1
DESIGN N.B.W.	DRAWN P.J.M.	UTIL. CHECKED DATE SEPT 91	SCALE as noted

FILMED FROM THE BEST AVAILABLE COPY