
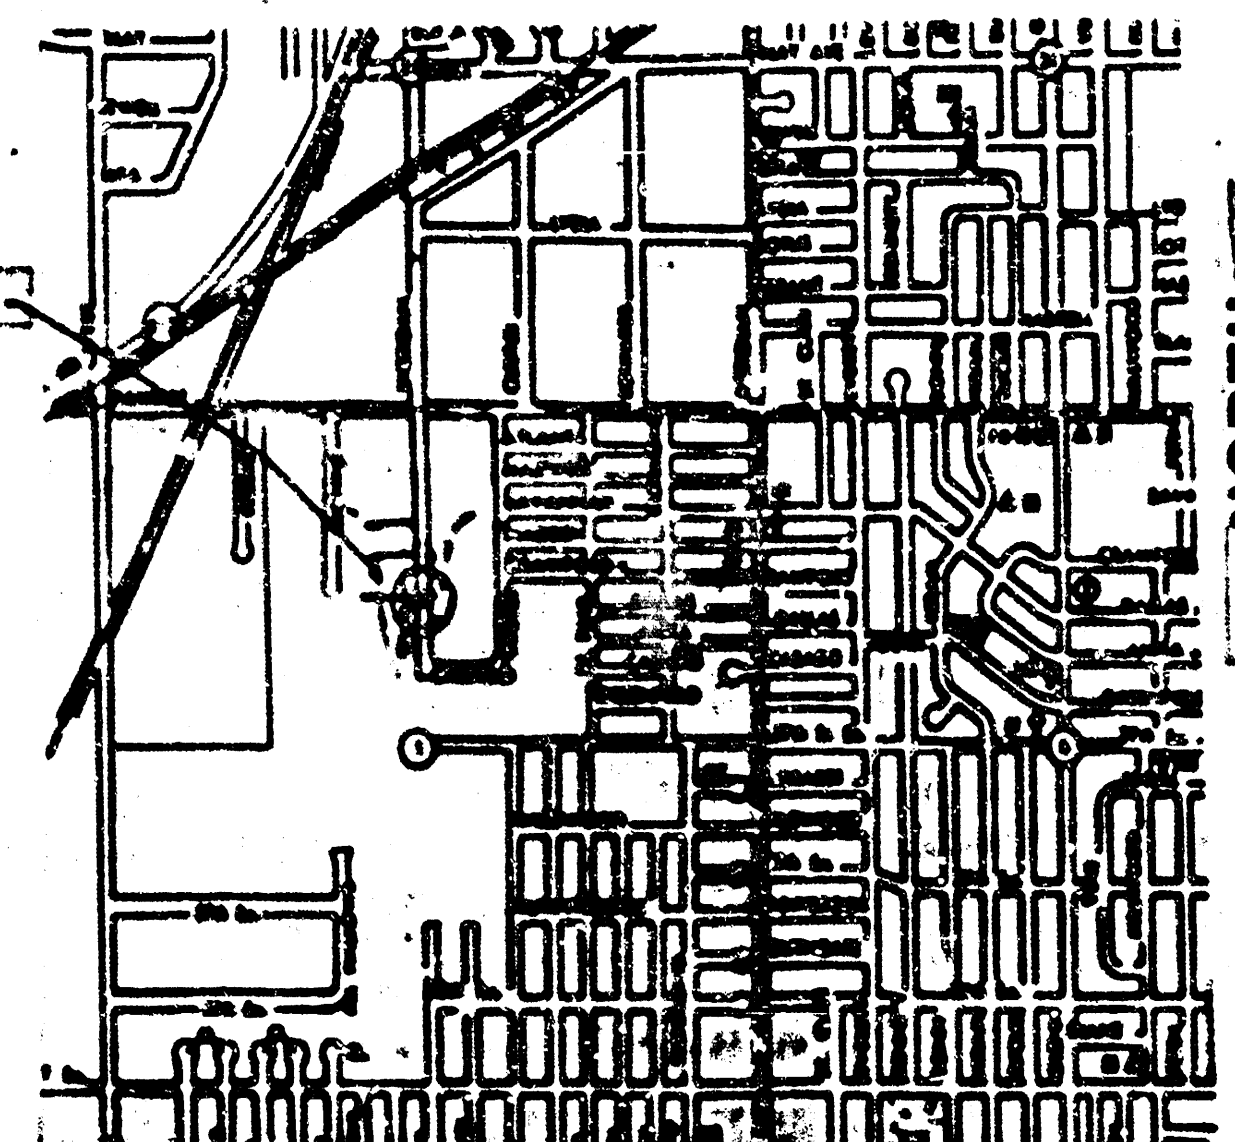


BENCH MARK: City 0130 @ Pawnee
and Sheridan, Elev = 103.29 City Datum
X" Cur on High Edge West Side of Sheridan 107
South Line of Lot 1, Block 1, Westport
Industrial Park First Addition = 102.68

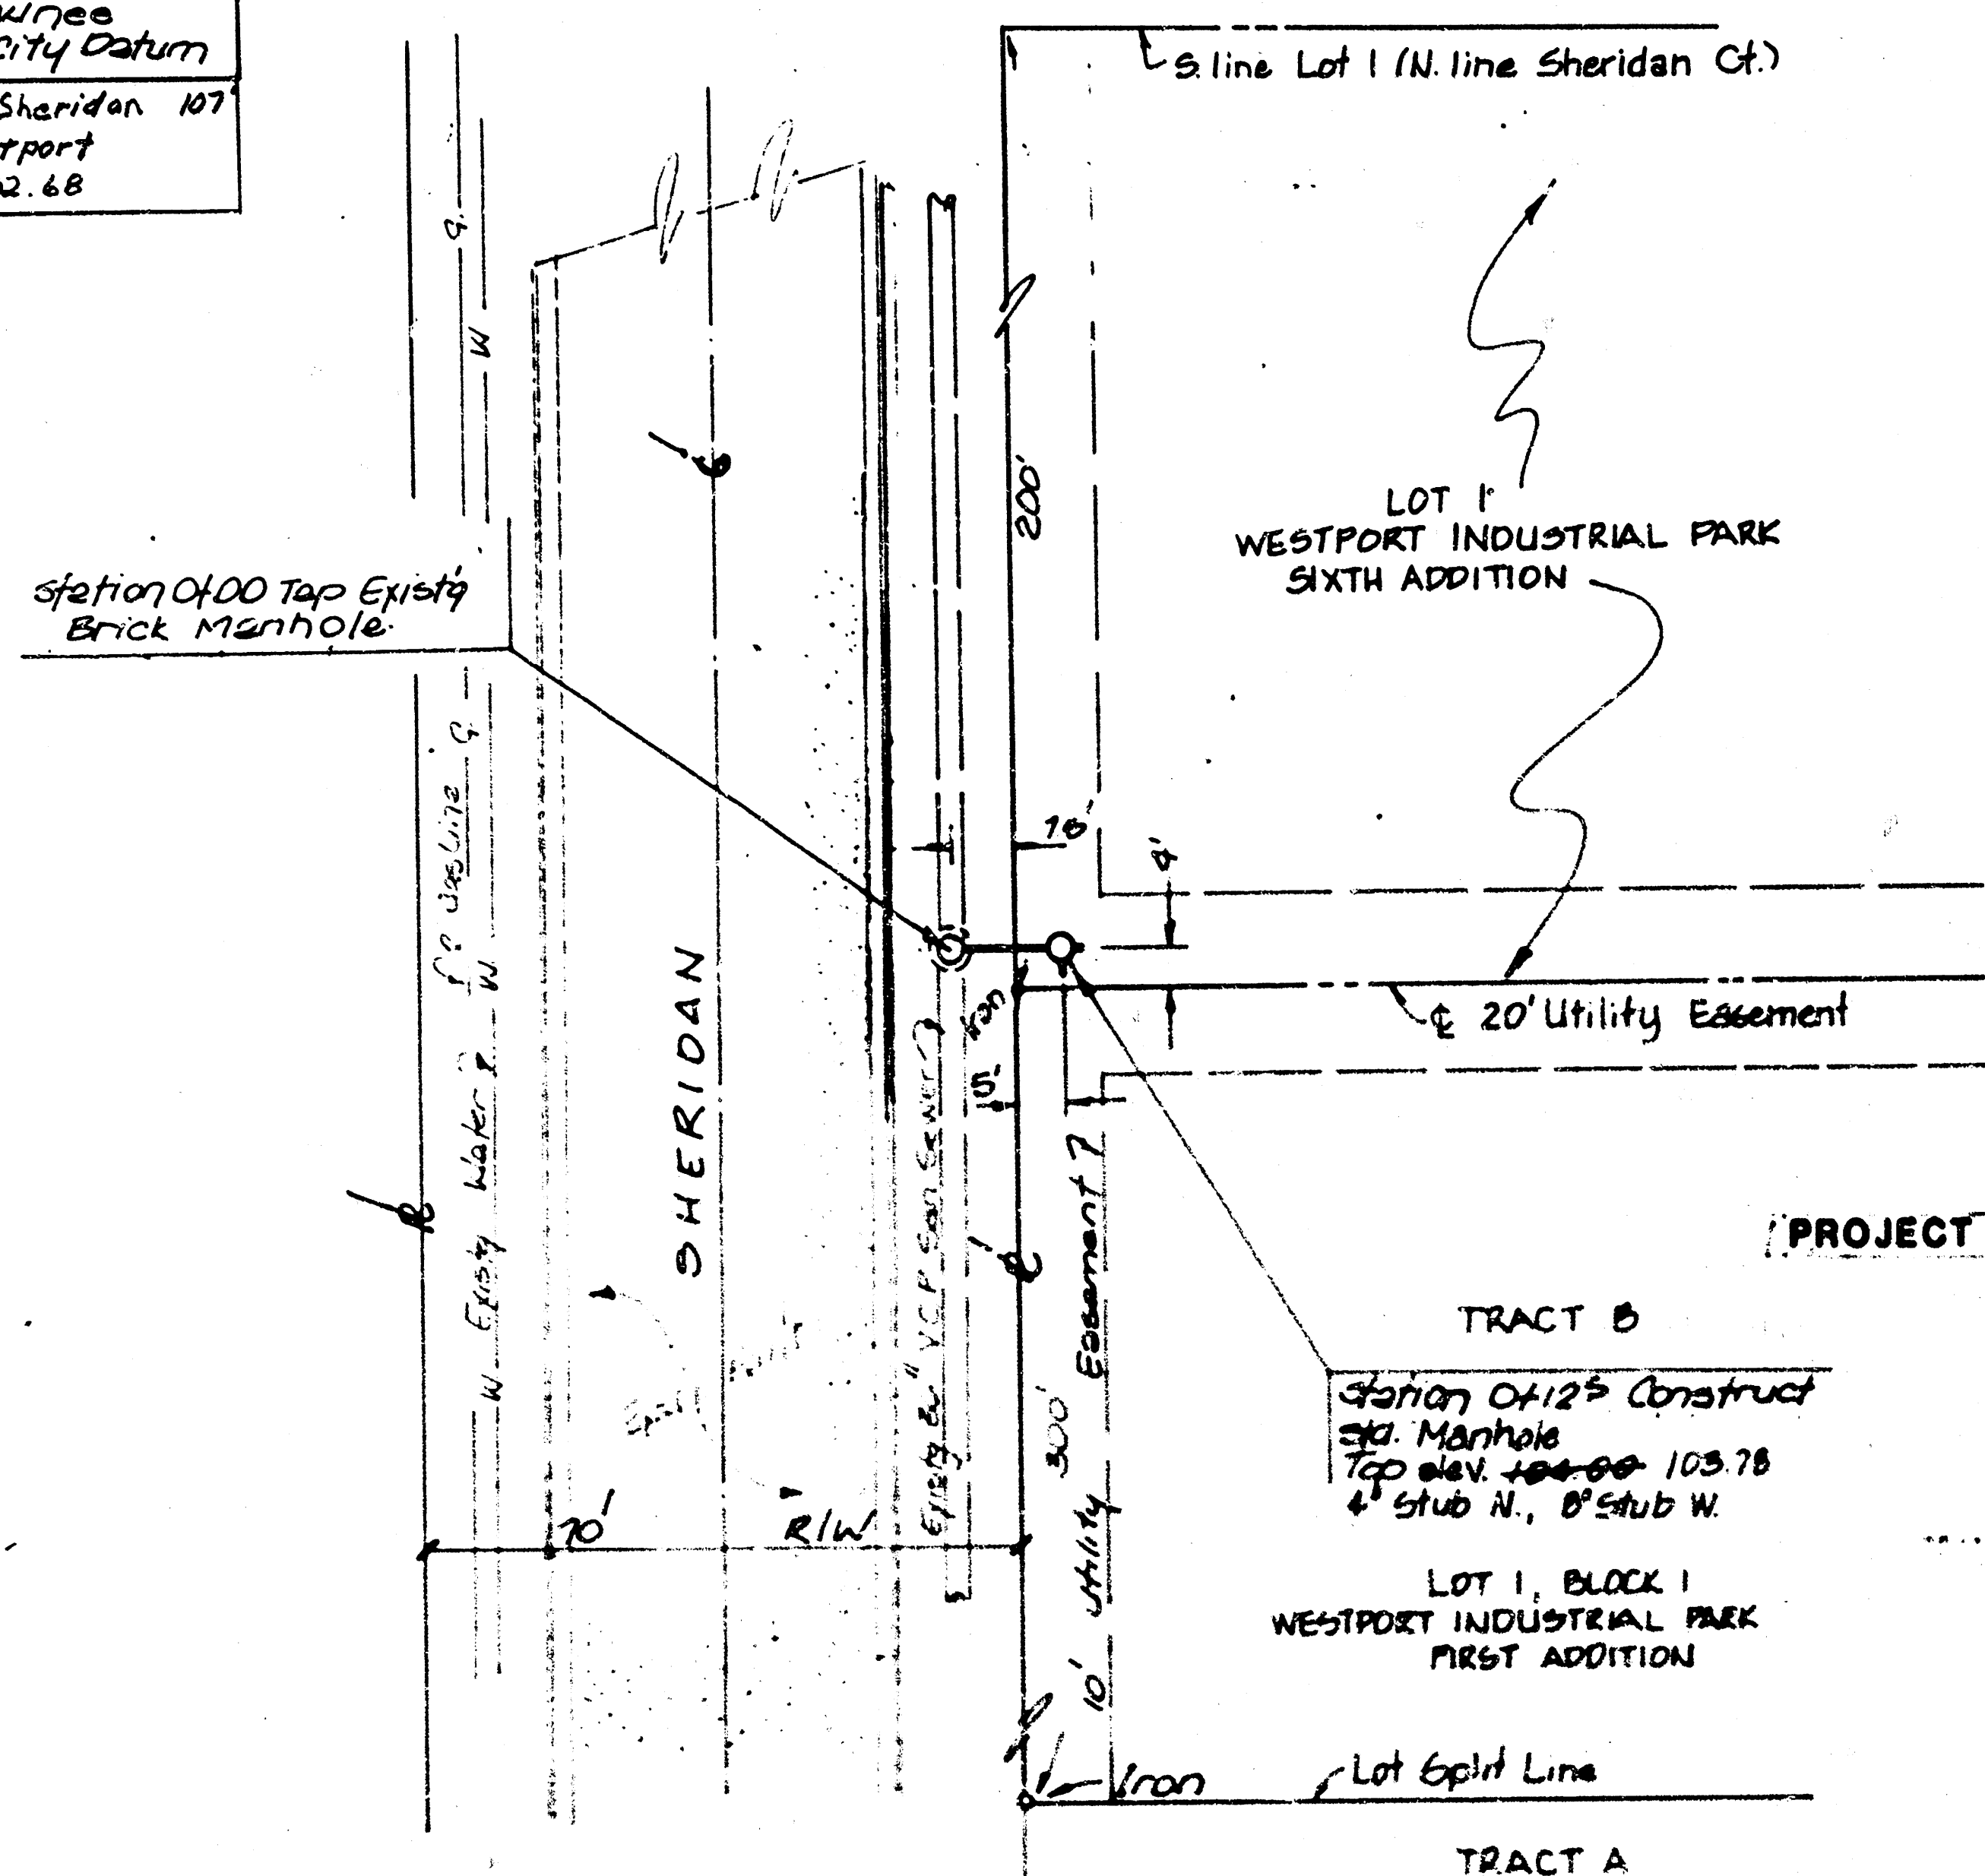

GENERAL NOTES

1. Contractor will be required to provide a minimum advance notice of twenty-four (24) hours to utility companies prior to starting any excavation as follows:

Kansas One-Call 1-800-344-7233

The Contractor must notify the following in case of an emergency:

Cable vision	262-4270 or 263-2061
K.P. & L. Gas Service Company	263-7511
Kansas Gas & Electric	264-1141
Arkla Gas Company	942-8350 or 263-8161
Southwest Bell Telephone Company	1-571-2611
City of Wichita Water Department	268-4908
City of Wichita Sewer Maintenance	268-4071

2. Underground utility service lines and overhead utility pole lines are to be adjusted as necessary by others prior to construction unless the plans specifically call for their adjustment by the Contractor. Existing utilities and their location, as shown on the plans, represent the best information obtainable for design. The Contractor will be required to work around existing utilities within the right-of-way which do not conflict with proposed construction.

3. The Contractor shall be responsible for maintaining continuous flow of sewage through construction. Contractor's proposed method for maintaining sewage flow shall be approved by the Engineer. Cost of maintaining flow of sewage through construction will not be paid for directly and this cost shall be considered as subsidiary to the other pay items of work.

4. The Contractor shall be responsible for preserving property irons. The Contractor will be required to re-establish any property irons which are damaged or destroyed by his construction operations. Such irons shall be re-established by a licensed land surveyor or a licensed professional engineer in accordance with state laws.

5. Contractor to verify the top of manhole elevation and the need for service line stubs prior to construction. Contact Dan Lies at 942-9592.

APPROVED AS NOTED

By CITY ENGINEER OF WICHITA

Sanitary Sewers *[Signature]* 5/1/10
Storm Sewers
Driveway Approaches
Water Mains
Paving

NOTE TO CONTRACTOR

INSPECTION AND TESTING FOR THIS PROJECT IS TO BE PROVIDED BY A LICENSED CONSULTING ENGINEERING FIRM UNDER CONTRACT WITH THE OWNER/DEVELOPER. SAID INSPECTION TO BE IN ACCORDANCE WITH THE CITY OF WICHITA STANDARD CONSTRUCTION ENGINEERING PRACTICES AND CERTIFIED BY A LICENSED PROFESSIONAL ENGINEER. NO WORK SHALL BE PERFORMED IN DEDICATED EASEMENTS OR PUBLIC RIGHT-OF-WAY BY THE CONTRACTOR WITHOUT SUCH INSPECTION NOR SHALL ANY WORK BE COMMENCED WITHOUT WRITTEN AUTHORIZATION BY THE CITY ENGINEER.


Revised as built 10-8-90 TCR

**PRIVATE SANITARY SEWER
EXTENSION TO SERVE S. 300' OF LOT 1,
BLK. 1, WESTPORT INDUSTRIAL PARK
FIRST ADDN.
CITY OF WICHITA, KS**

PROJECT NO. 4-259 PPS 607861

BAUGHMAN COMPANY, P.A.
SURVEYING & ENGINEERING
318/262-7271 • 315 ELLIS • WICHITA, KANSAS 67211



Aug. 1990

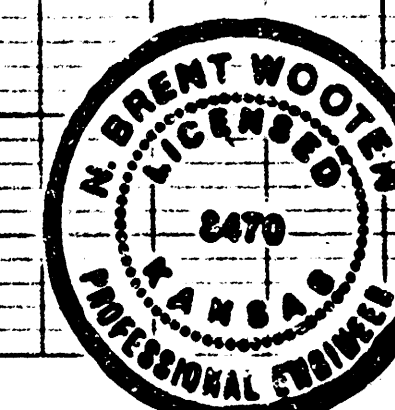

HIGHWAY FEDERAL AID SHEET
PLATE 1-SINGLE PLAN AND PROFILE-FULL LINE
TYPELINE
PRINTED IN U.S.A.

FILMED FROM THE BEST
AVAILABLE COPY

BENCH MARK: City D.300 @ Pawnee and Sheridan, Elev. = 103.29 City Datum
 X' Cut on High Edge West Side of Sheridan 107
 South Line of Lot 1, Block 1, Westport Industrial Park First Addition = 102.68

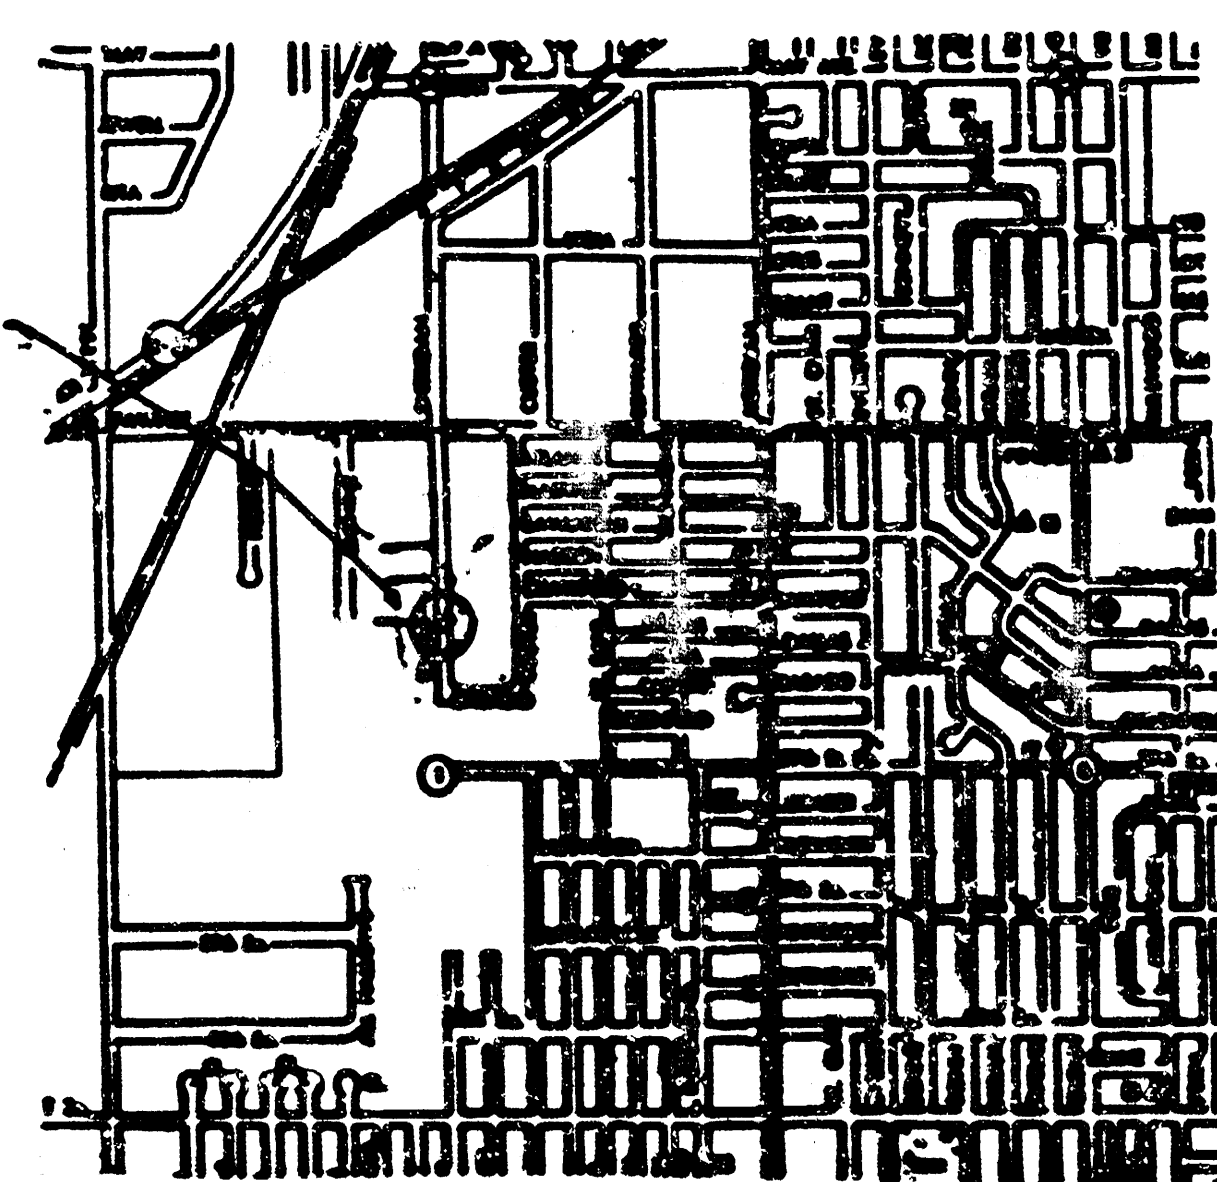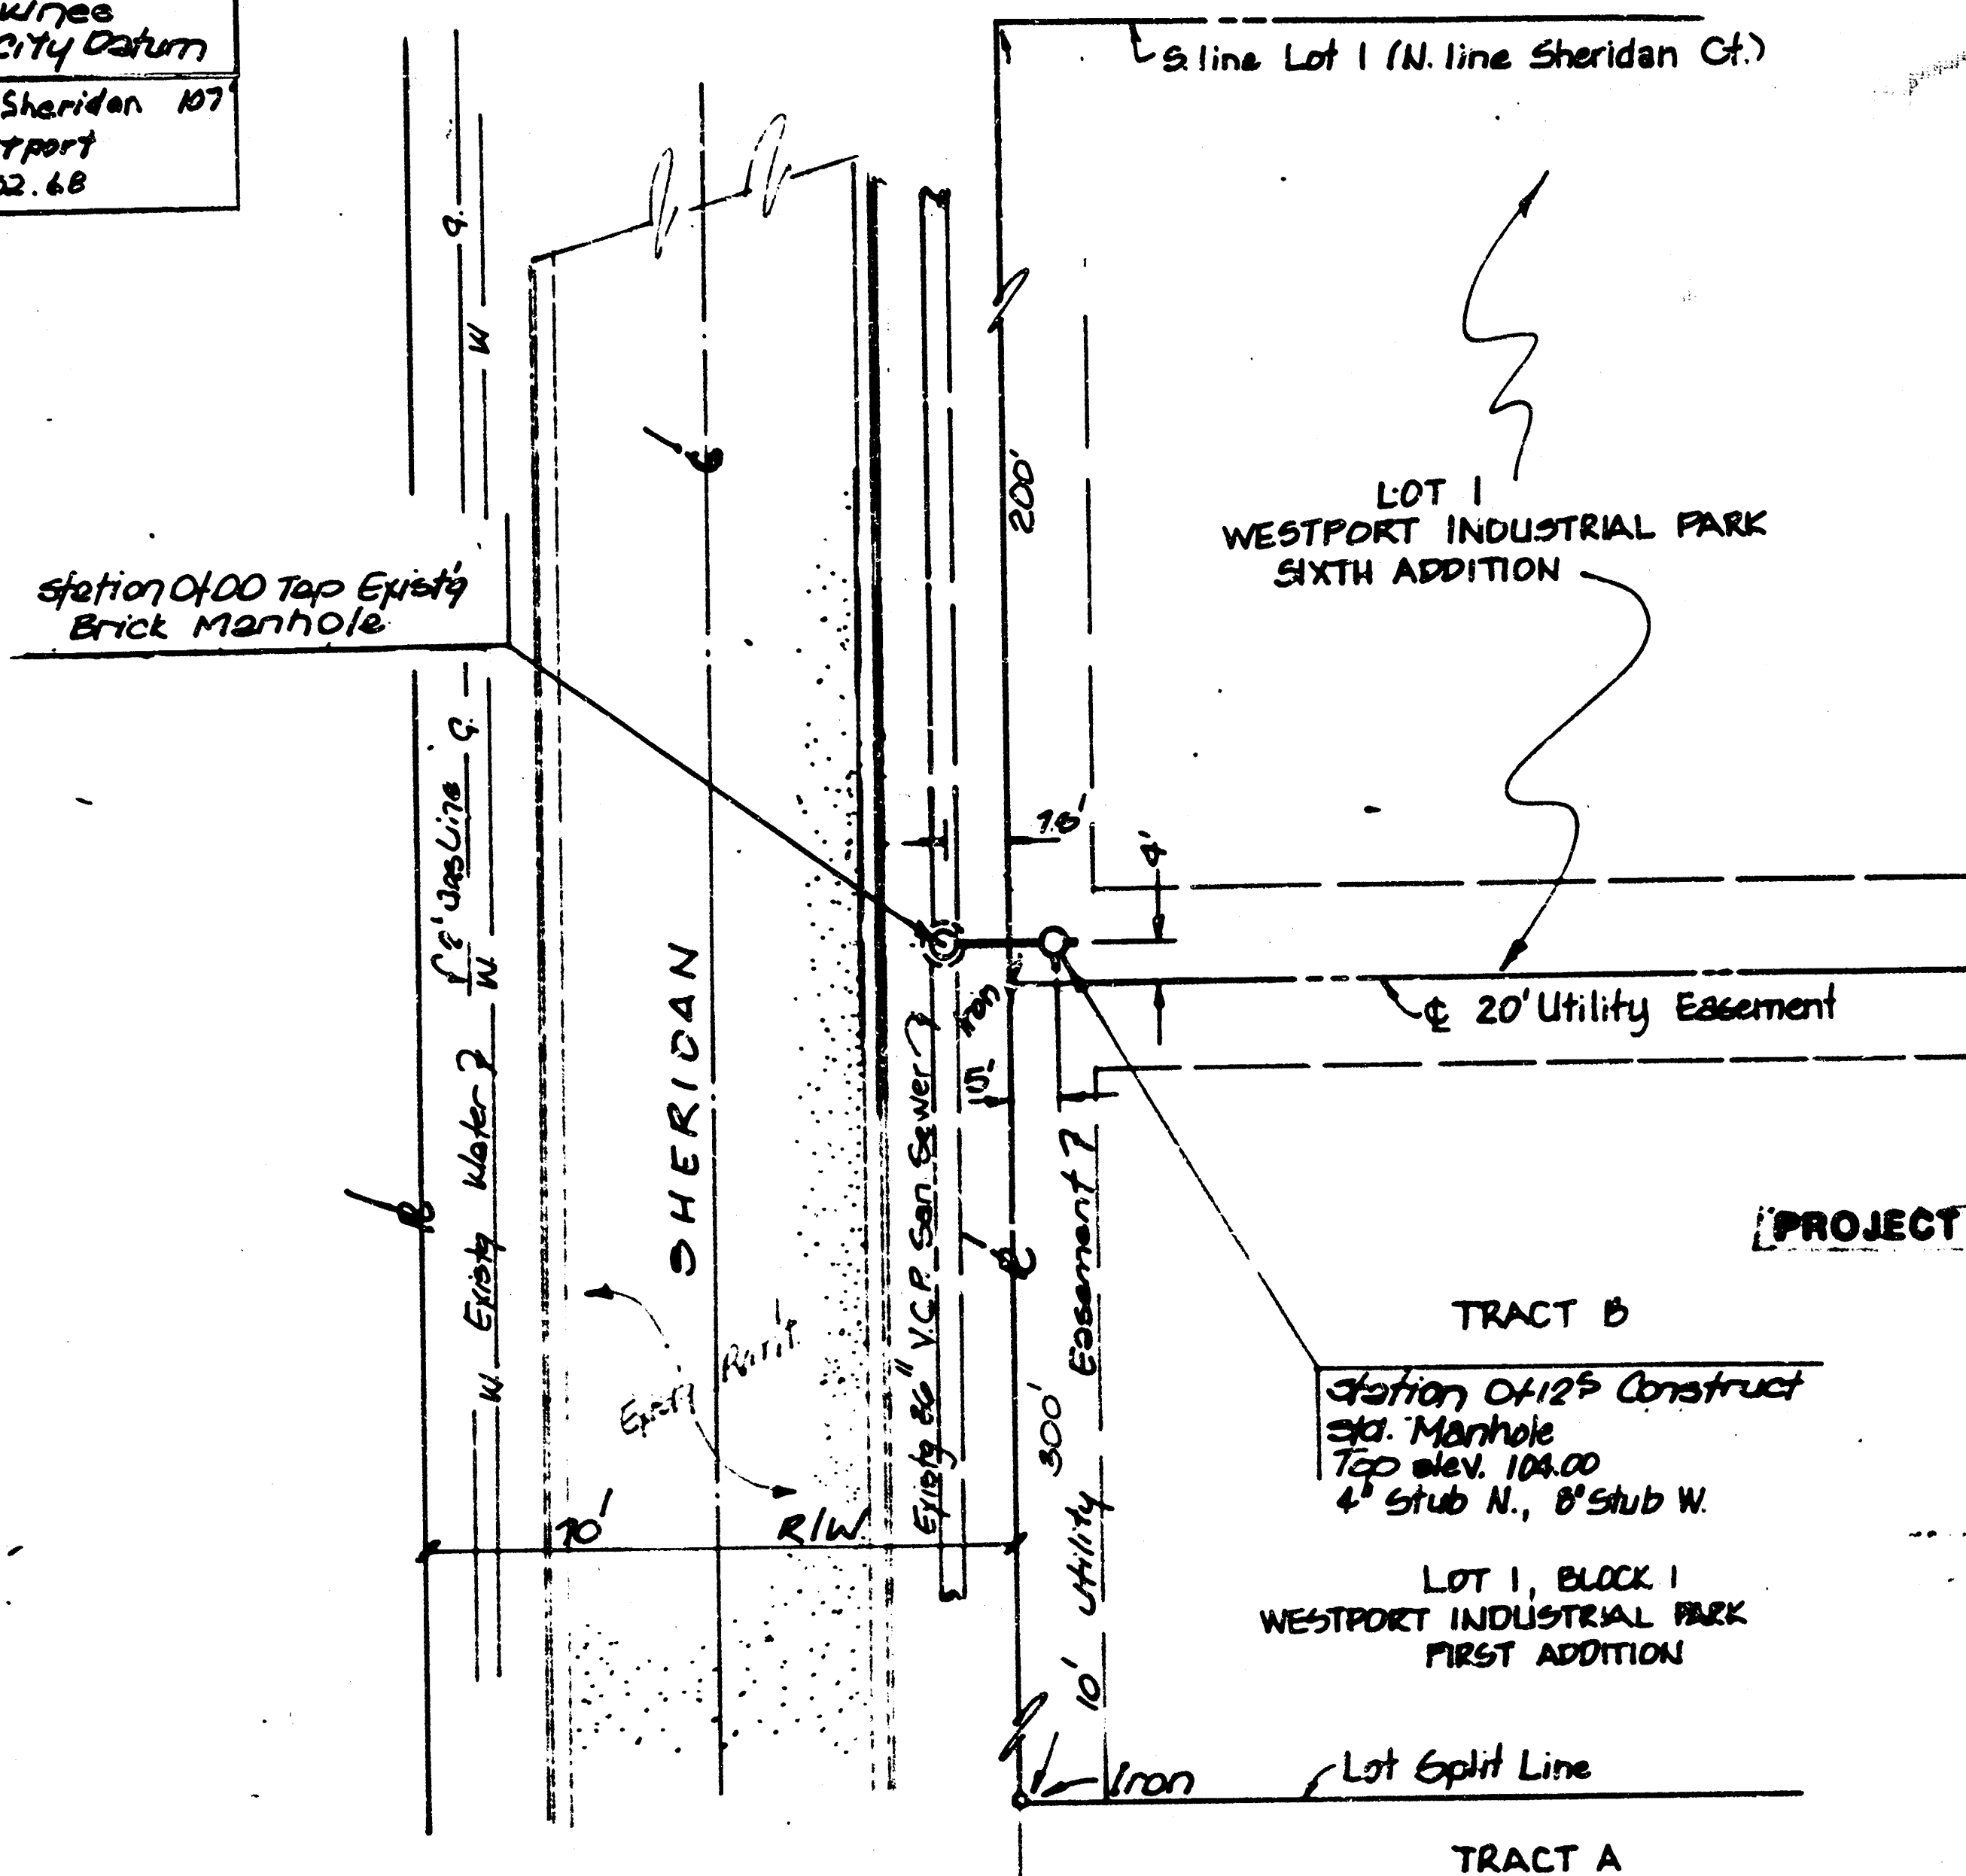

GENERAL NOTES

1. Contractor will be required to provide a minimum advance notice of twenty-four (24) hours to utility companies prior to starting any excavation as follows:

Kansas One-Call	1-800-344-7233
The Contractor must notify the following in case of an emergency:	
Cable vision	262-4270 or 263-2061
K.P. & L. Gas Service Company	263-7811
Kansas Gas & Electric	264-1141
Arkia Gas Company	942-8350 or 263-8181
Southwest Bell Telephone Company	1-877-2611
City of Wichita Water Department	268-4908
City of Wichita Sewer Maintenance	268-4071

2. Underground utility service lines and overhead utility pole lines are to be adjusted as necessary by others prior to construction unless the plans specifically call for their adjustment by the Contractor. Existing utilities and their location, as shown on the plans, represent the best information obtainable for design. The Contractor will be required to work around existing utilities within the right-of-way which do not conflict with proposed construction.

3. The Contractor shall be responsible for maintaining continuous flow of sewage through construction. Contractor's proposed method for maintaining sewage flow shall be approved by the Engineer. Cost of maintaining flow of sewage through construction will not be paid for directly and this cost shall be considered as subsidiary to the other pay items of work.

4. The Contractor shall be responsible for preserving property irons. The Contractor will be required to re-establish any property irons which are damaged or destroyed by his construction operations. Such irons shall be re-established by a licensed land surveyor or a licensed professional engineer in accordance with state laws.

5. Contractor to verify the top of manhole elevation and the need for service line stubs prior to construction. Contact Dan Lee at 242-3322.

APPROVED AND SUBMITTED
 By City Engineer of Wichita
 Signature: *[Signature]*
 Date: _____
 Title: _____
 City: _____

NOTES TO CONTRACTOR
 INSPECTION AND TESTING FOR THIS PROJECT IS TO BE PROVIDED BY A LICENSED PROFESSIONAL ENGINEERING FIRM UNDER CONTRACT WITH THE OWNER/DEVELOPER. SAID INSPECTION FIRM IS TO COORDINATE WITH THE CITY OF WICHITA OFFICIALS CONCERNING INSPECTION SERVICES AND IS REQUIRED BY A LICENSED PROFESSIONAL ENGINEER, REGISTERED IN THE STATE OF KANSAS, TO SIGN AND SUBMIT SUCH INSPECTION WORK SHALL ANY WORK BE CONSIDERED WITHOUT OFFICIAL AUTHORIZATION BY THE CITY ENGINEER.

PRIVATE SANITARY SEWER
 EXTENSION TO SERVE S. 300' OF LOT 1,
 BLK. 1, WESTPORT INDUSTRIAL PARK
 FIRST ADDITION
 CITY OF WICHITA, KS

PROJECT NO. 1 259PPS 807861
 BAUGHMAN COMPANY, P.A.
 SURVEYING & ENGINEERING
 2100 S. W. 10TH ST. - WICHITA, KANSAS 67211



FILMED FROM THE BEST
 AVAILABLE COPY