

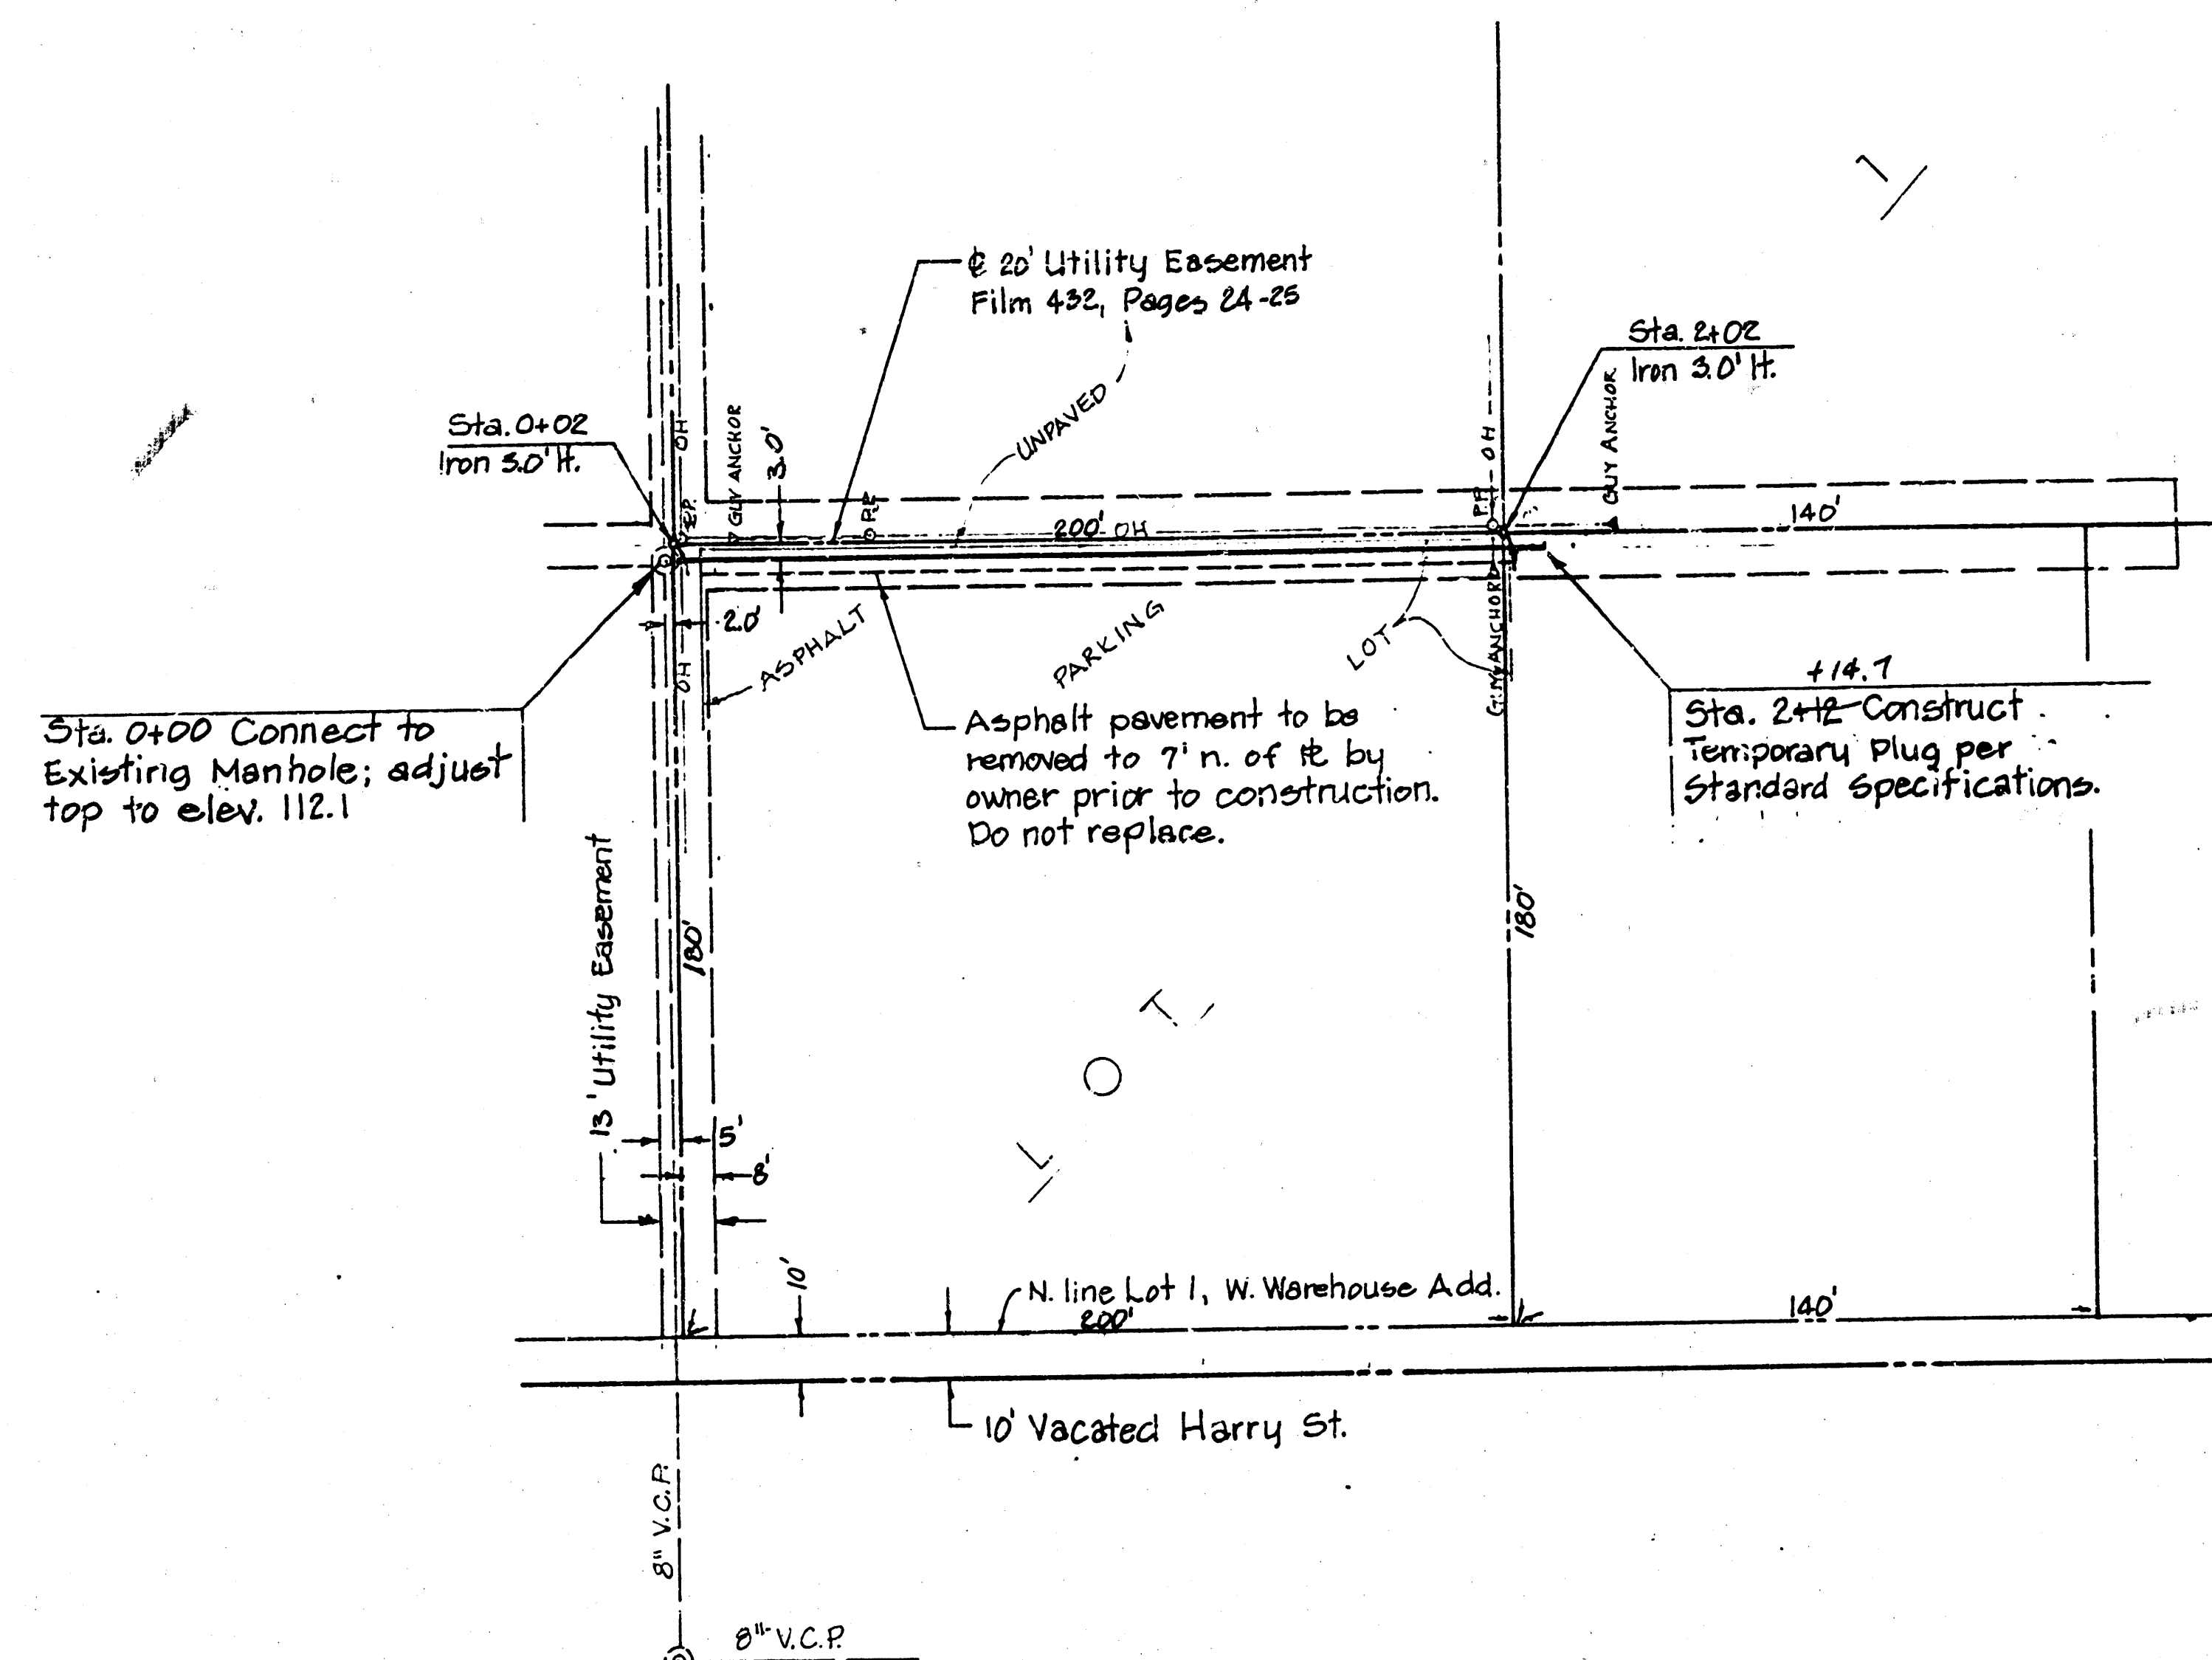


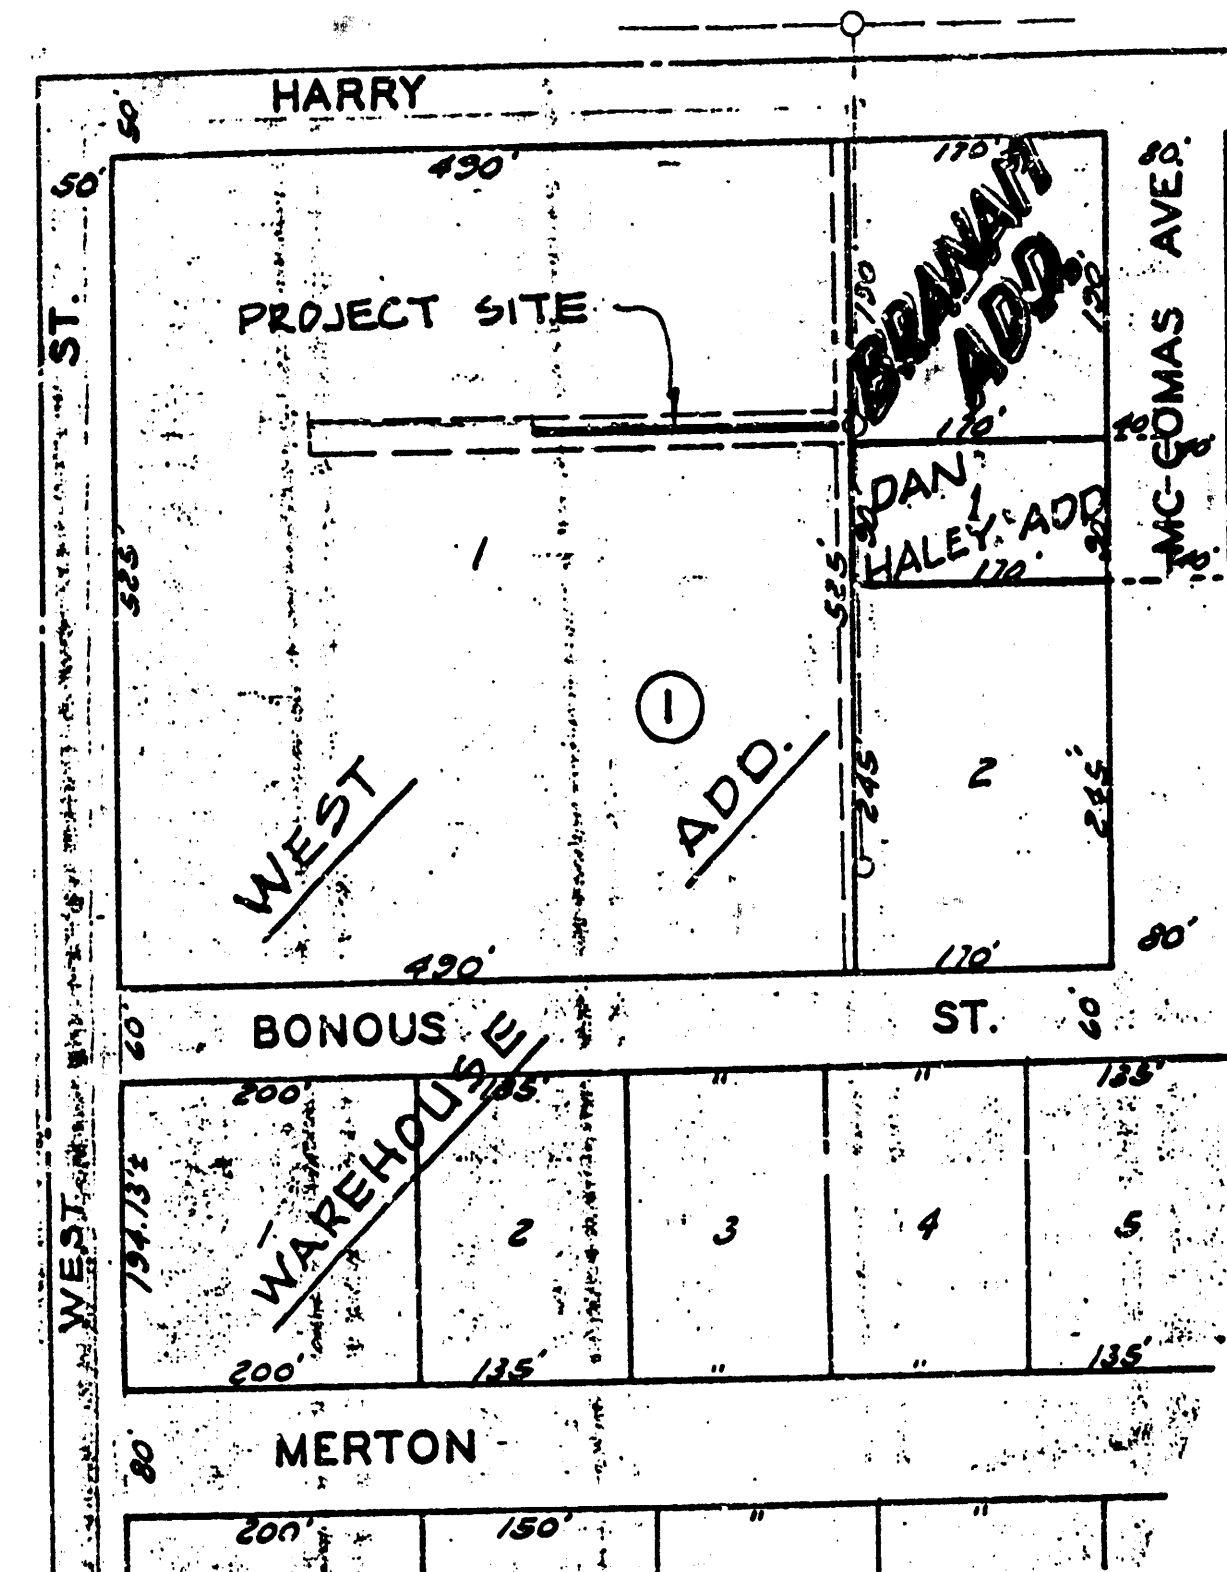


APPROVED AS NOTED
By CITY ENGINEER OF WICHITA
Sanitary Sewers *2/16/08*
Storm Sewers _____
Driveway Approaches _____
Water Mains _____
Paving _____

BENCH MARKS:
City Std. Dwg. 55' W. of 45's.
& Harry & West; elev. 111.77
SW. Cor. of retaining wall on W. side
of bldg., sta. 1469, 110' ft.; elev. 113.32

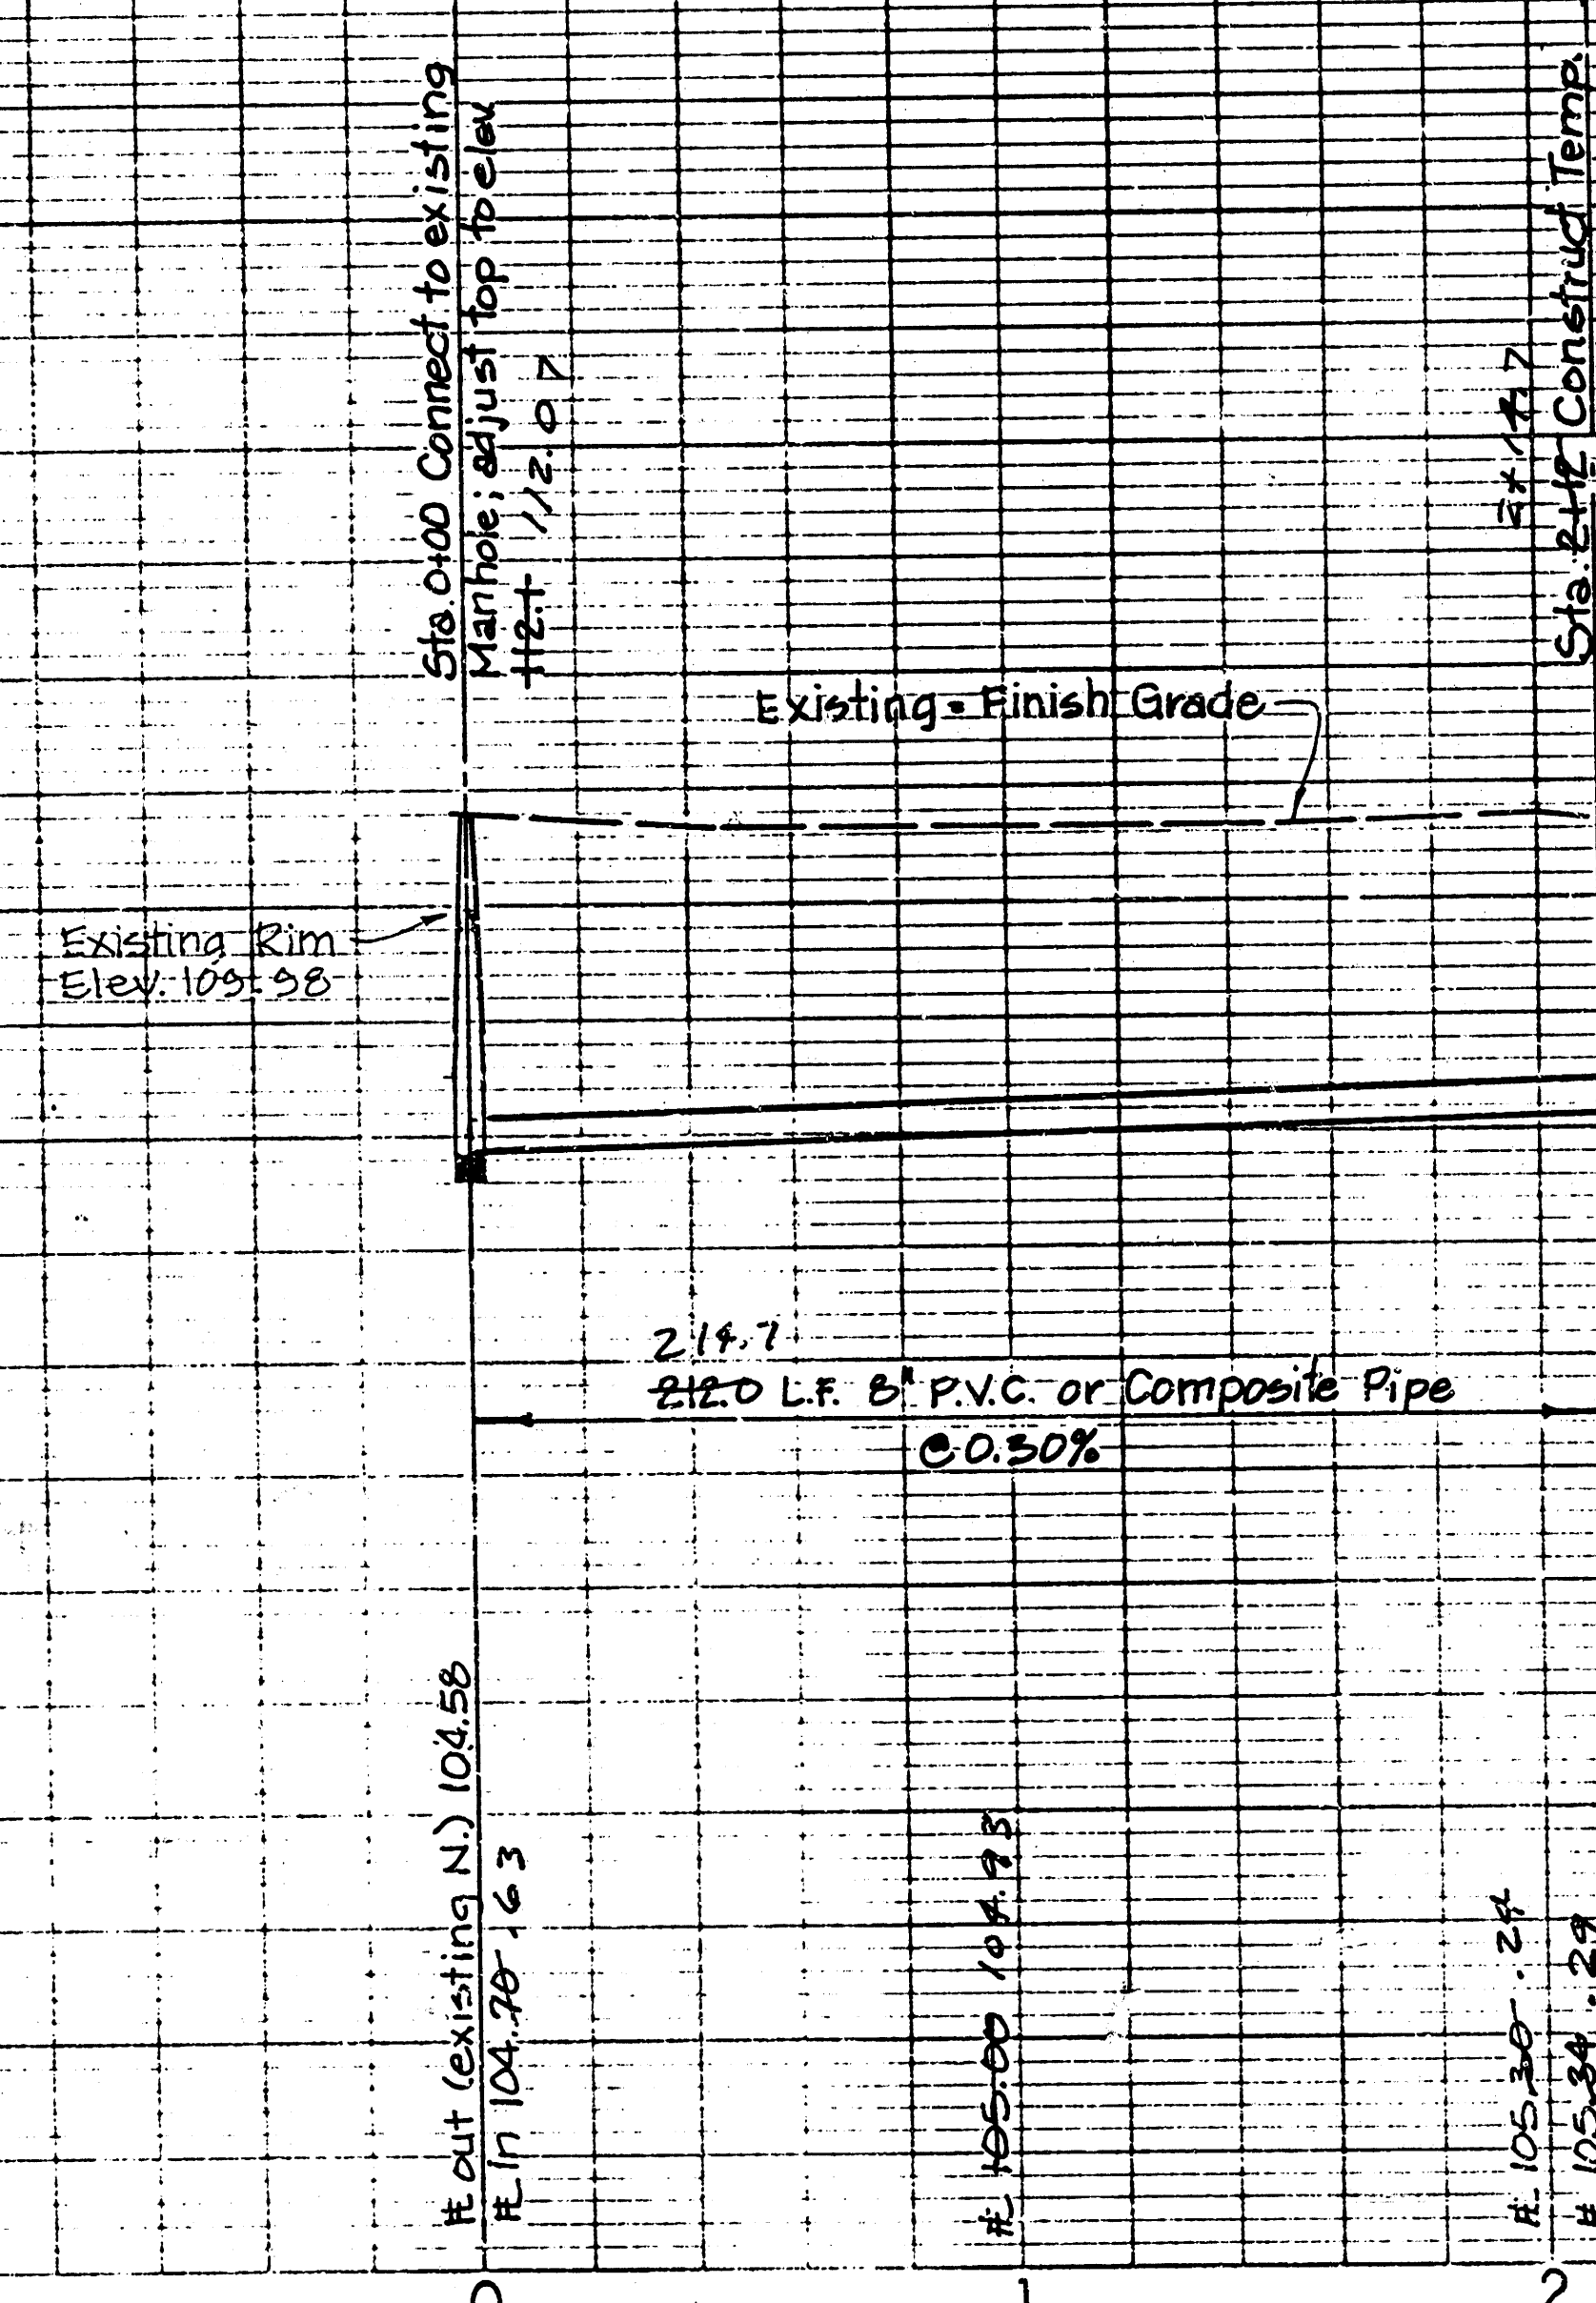

Profile Scale
1" = 40' Horizontal
1" = 5' Vertical

NOTE TO CONTRACTOR
INSPECTION AND TESTING FOR THIS PROJECT IS TO BE PROVIDED BY A LICENSED CONSULTING ENGINEERING FIRM UNDER CONTRACT WITH THE OWNER/DEVELOPER. SAID INSPECTION TO BE IN ACCORDANCE WITH THE CITY OF WICHITA STANDARD CONSTRUCTION ENGINEERING PRACTICES AND CERTIFIED BY A LICENSED PROFESSIONAL ENGINEER. NO WORK SHALL BE PERFORMED IN DEDICATED EASEMENTS OF THE PUBLIC RIGHT-OF-WAY BY THE CONTRACTOR WITHOUT SUCH INSPECTION AND SHALL ANY WORK BE COMMENCED IN DEDICATED EASEMENTS OR PUBLIC RIGHT-OF-WAY WITHOUT WRITTEN AUTHORIZATION BY THE CITY ENGINEER.

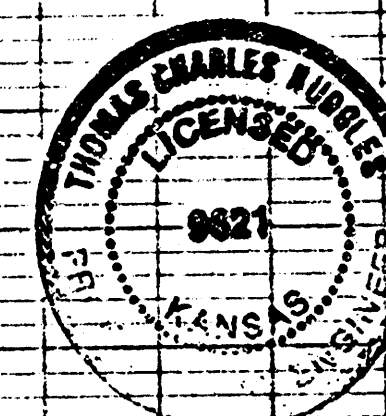

PRIVATE SANITARY SEWER
LOT 1, WEST WAREHOUSE ADDITION
PROJ. NO. 468 76 245 80001 000 000 180

BAUGHMAN COMPANY, P.A.
SURVEYING & ENGINEERING
315/262-7271 • 315 ELLIS • WICHITA, KANSAS 67211

Design: Ruggles Drawn: TCR Approved: Date: 8-31-88 Scale: Noted

AS BUILT 9-16-88

FILMED FROM THE BEST
AVAILABLE COPY

