



PLAN
 NORTH ARROW
 1" = 100'


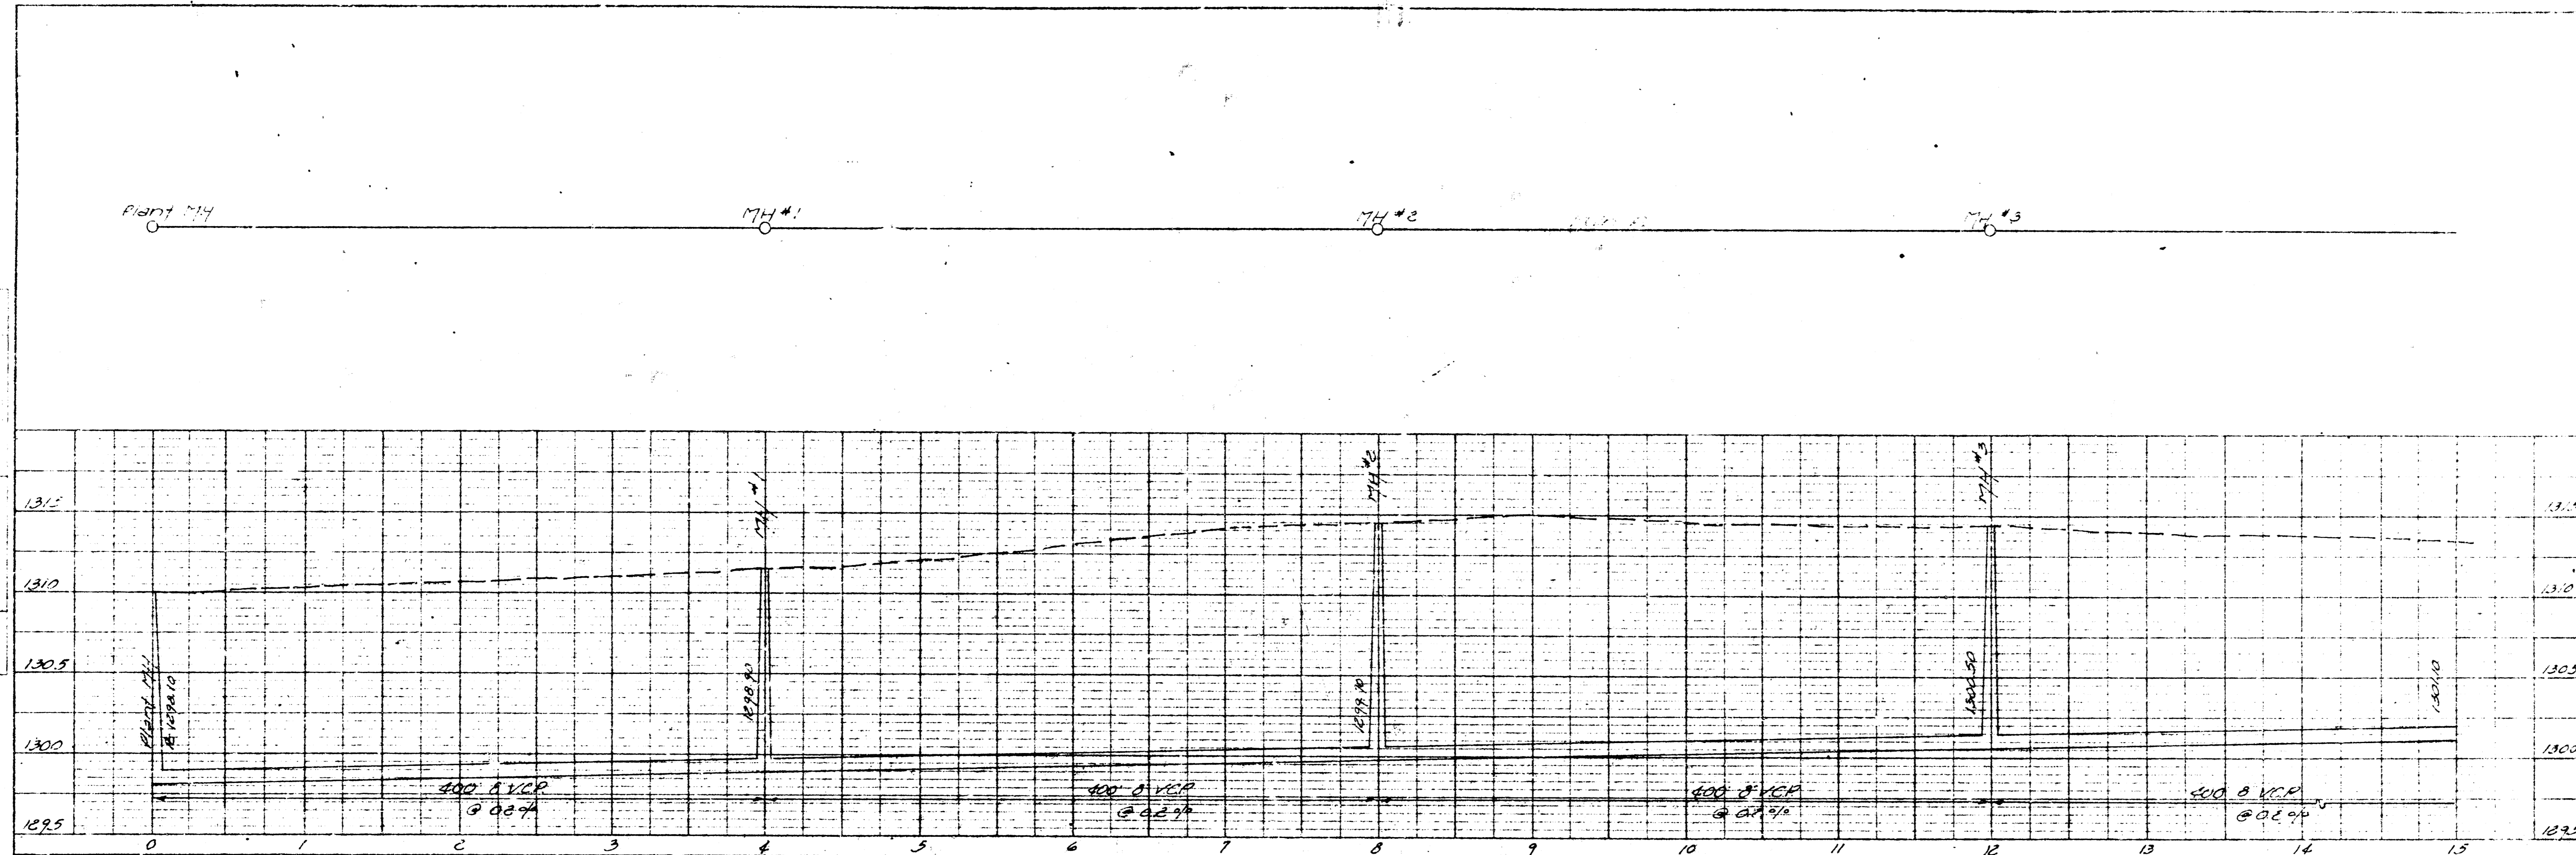


PROFILE
 NORTH ARROW
 1" = 100'

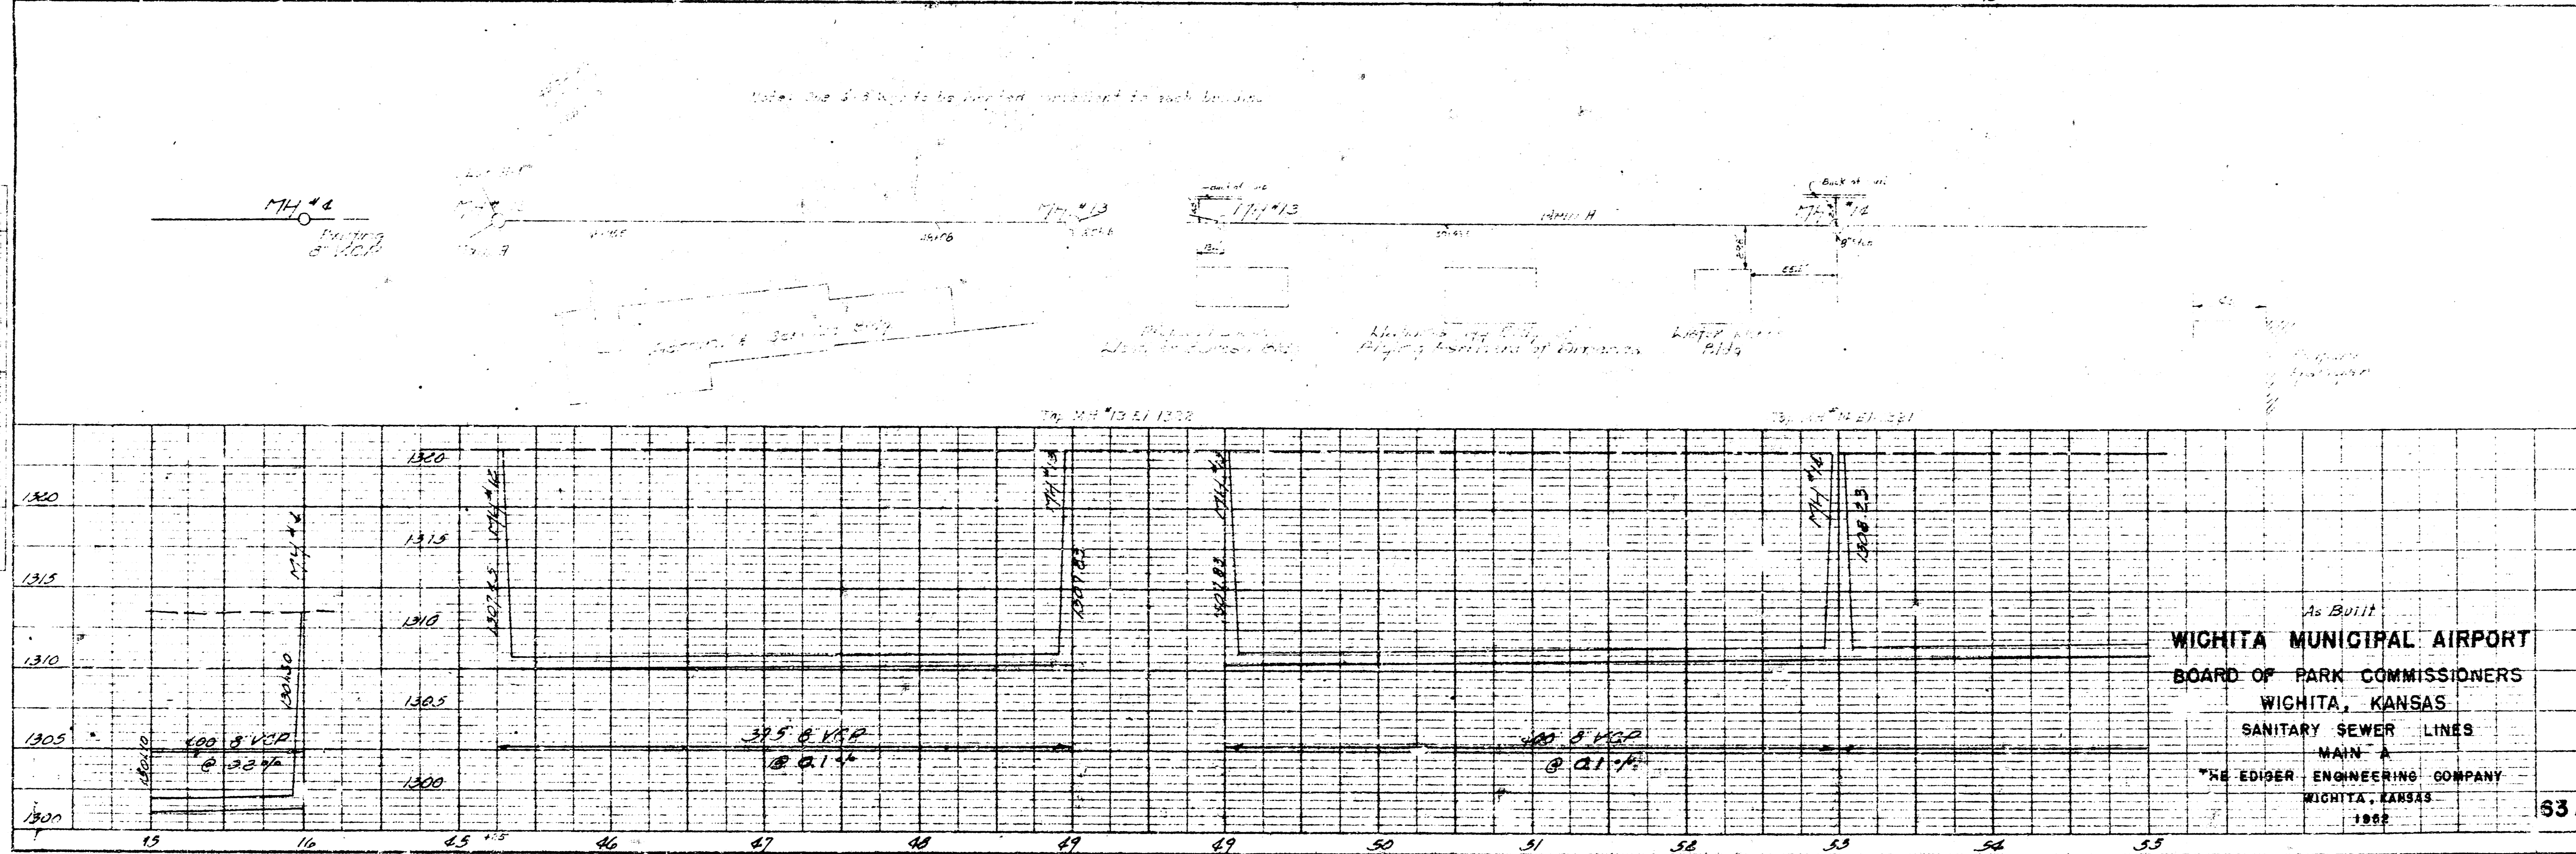

As Built
WICHITA MUNICIPAL AIRPORT
 BOARD OF PARK COMMISSIDNERS
 WICHITA, KANSAS
 SANITARY SEWER LINES
 MAIN "A"
 THE EDIPER ENGINEERING COMPANY
 WICHITA, KANSAS
 1982


53 A

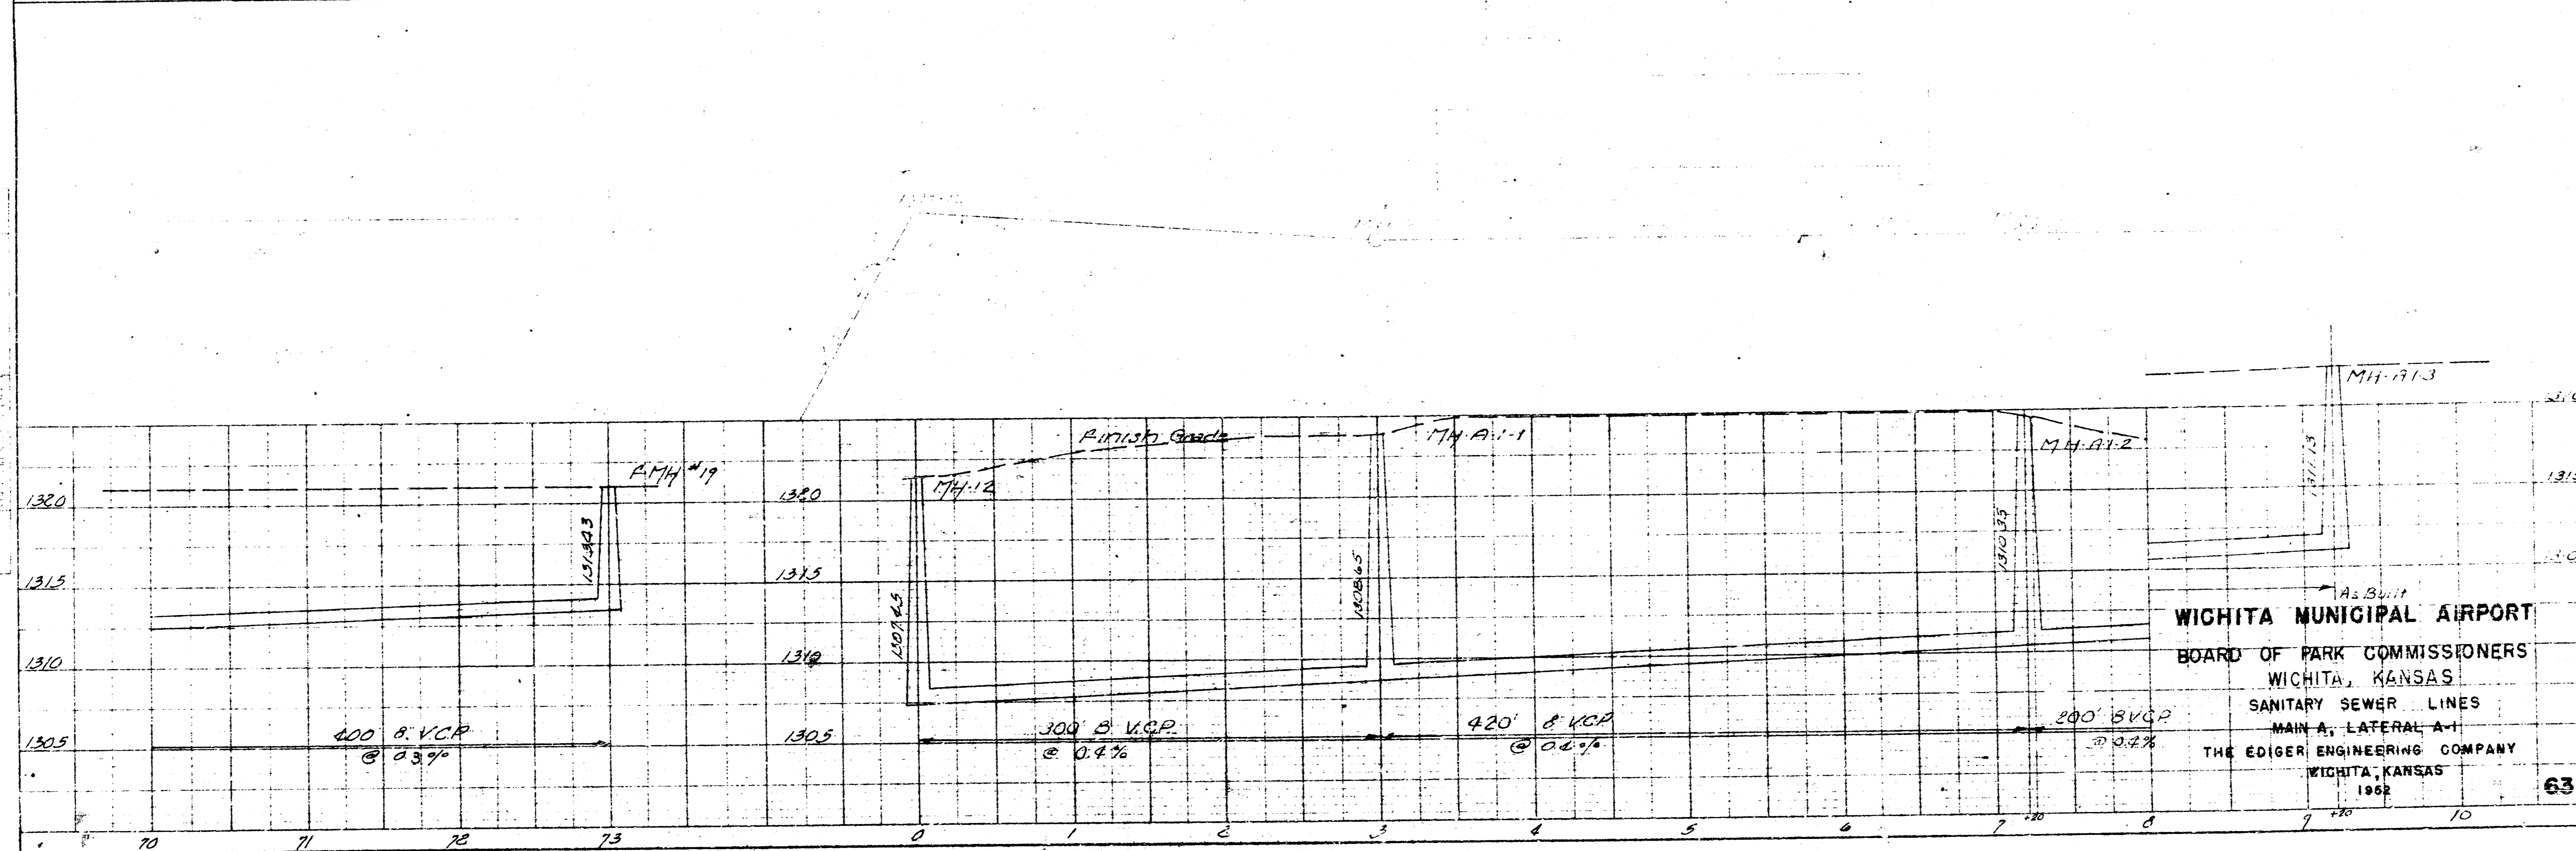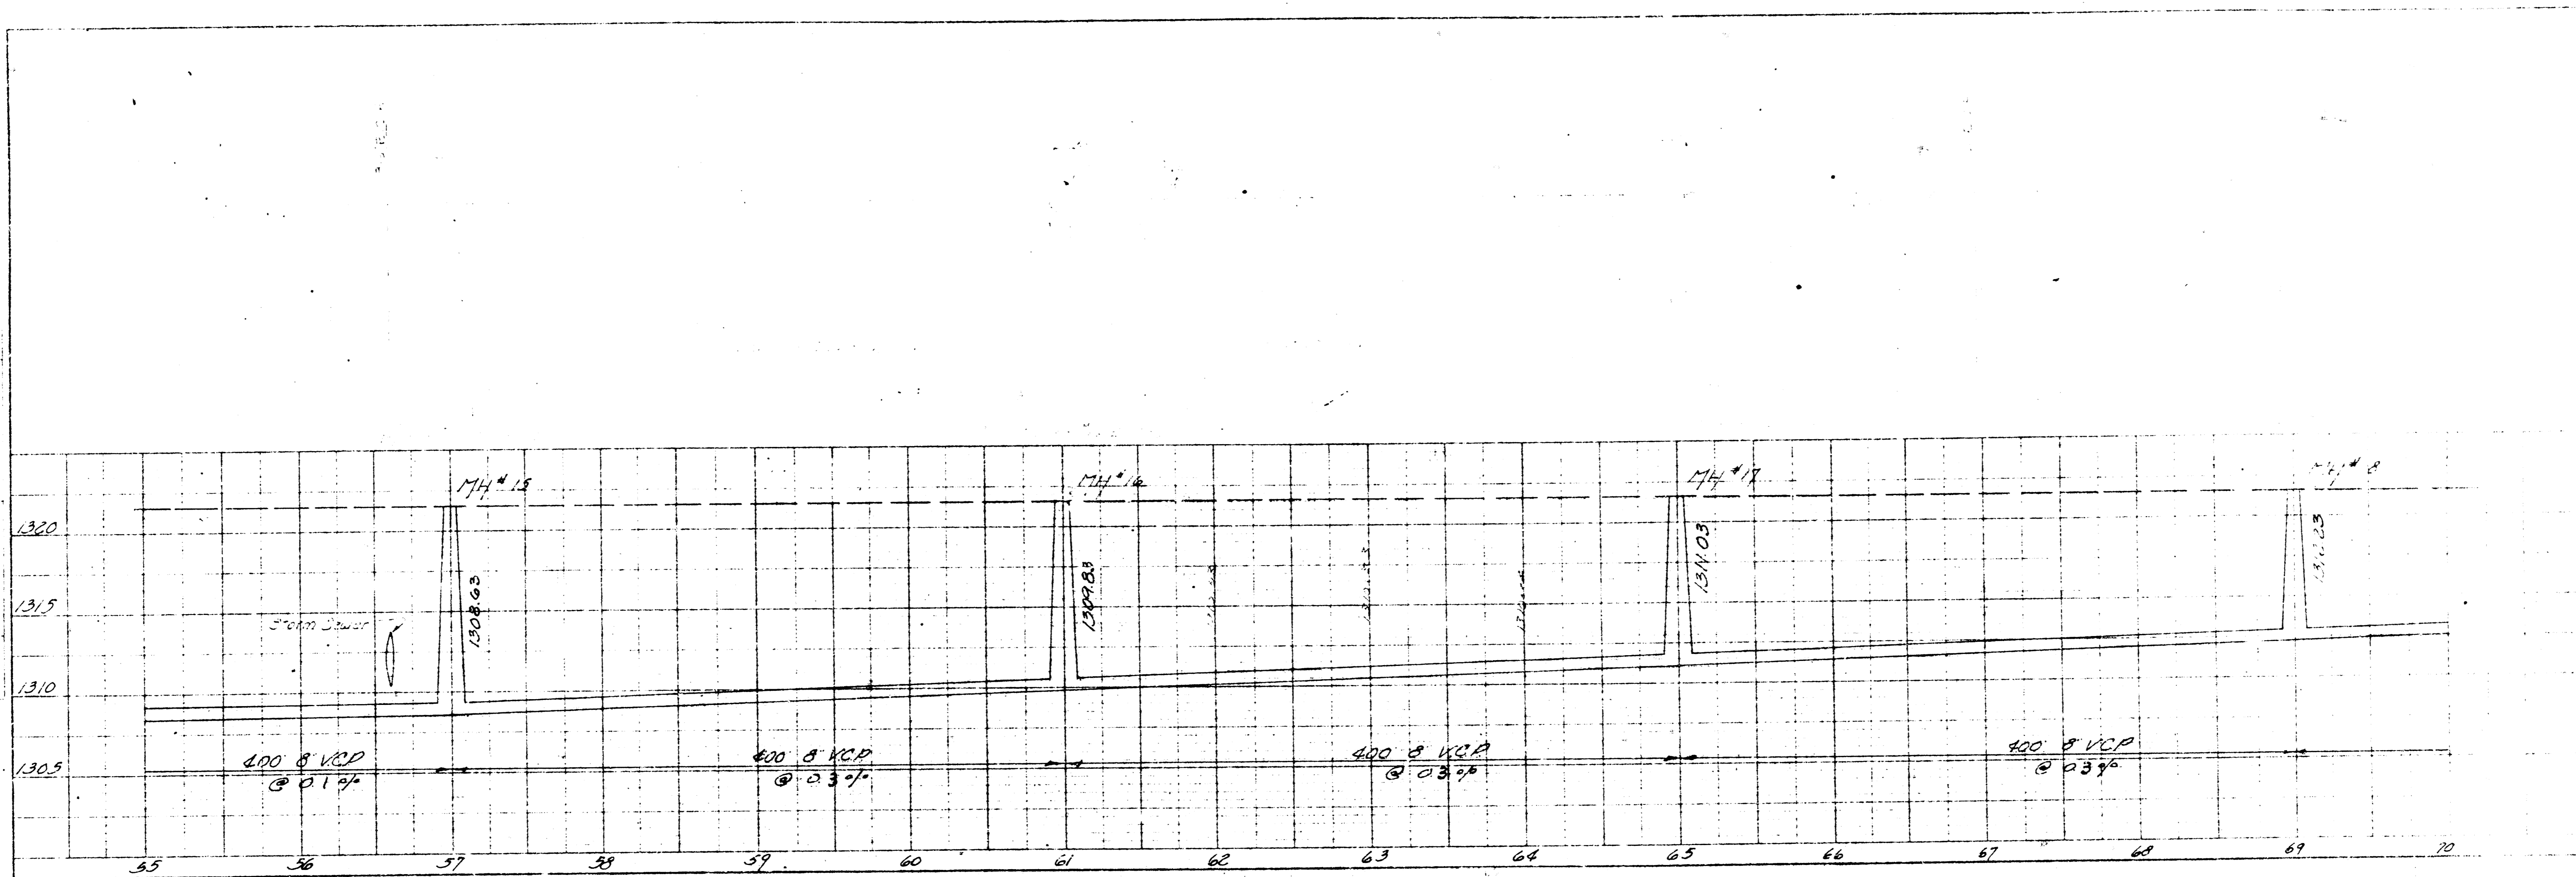



PLAN
SHEET NO. 63 B

PROFILE
SHEET NO. 63 B

63 B

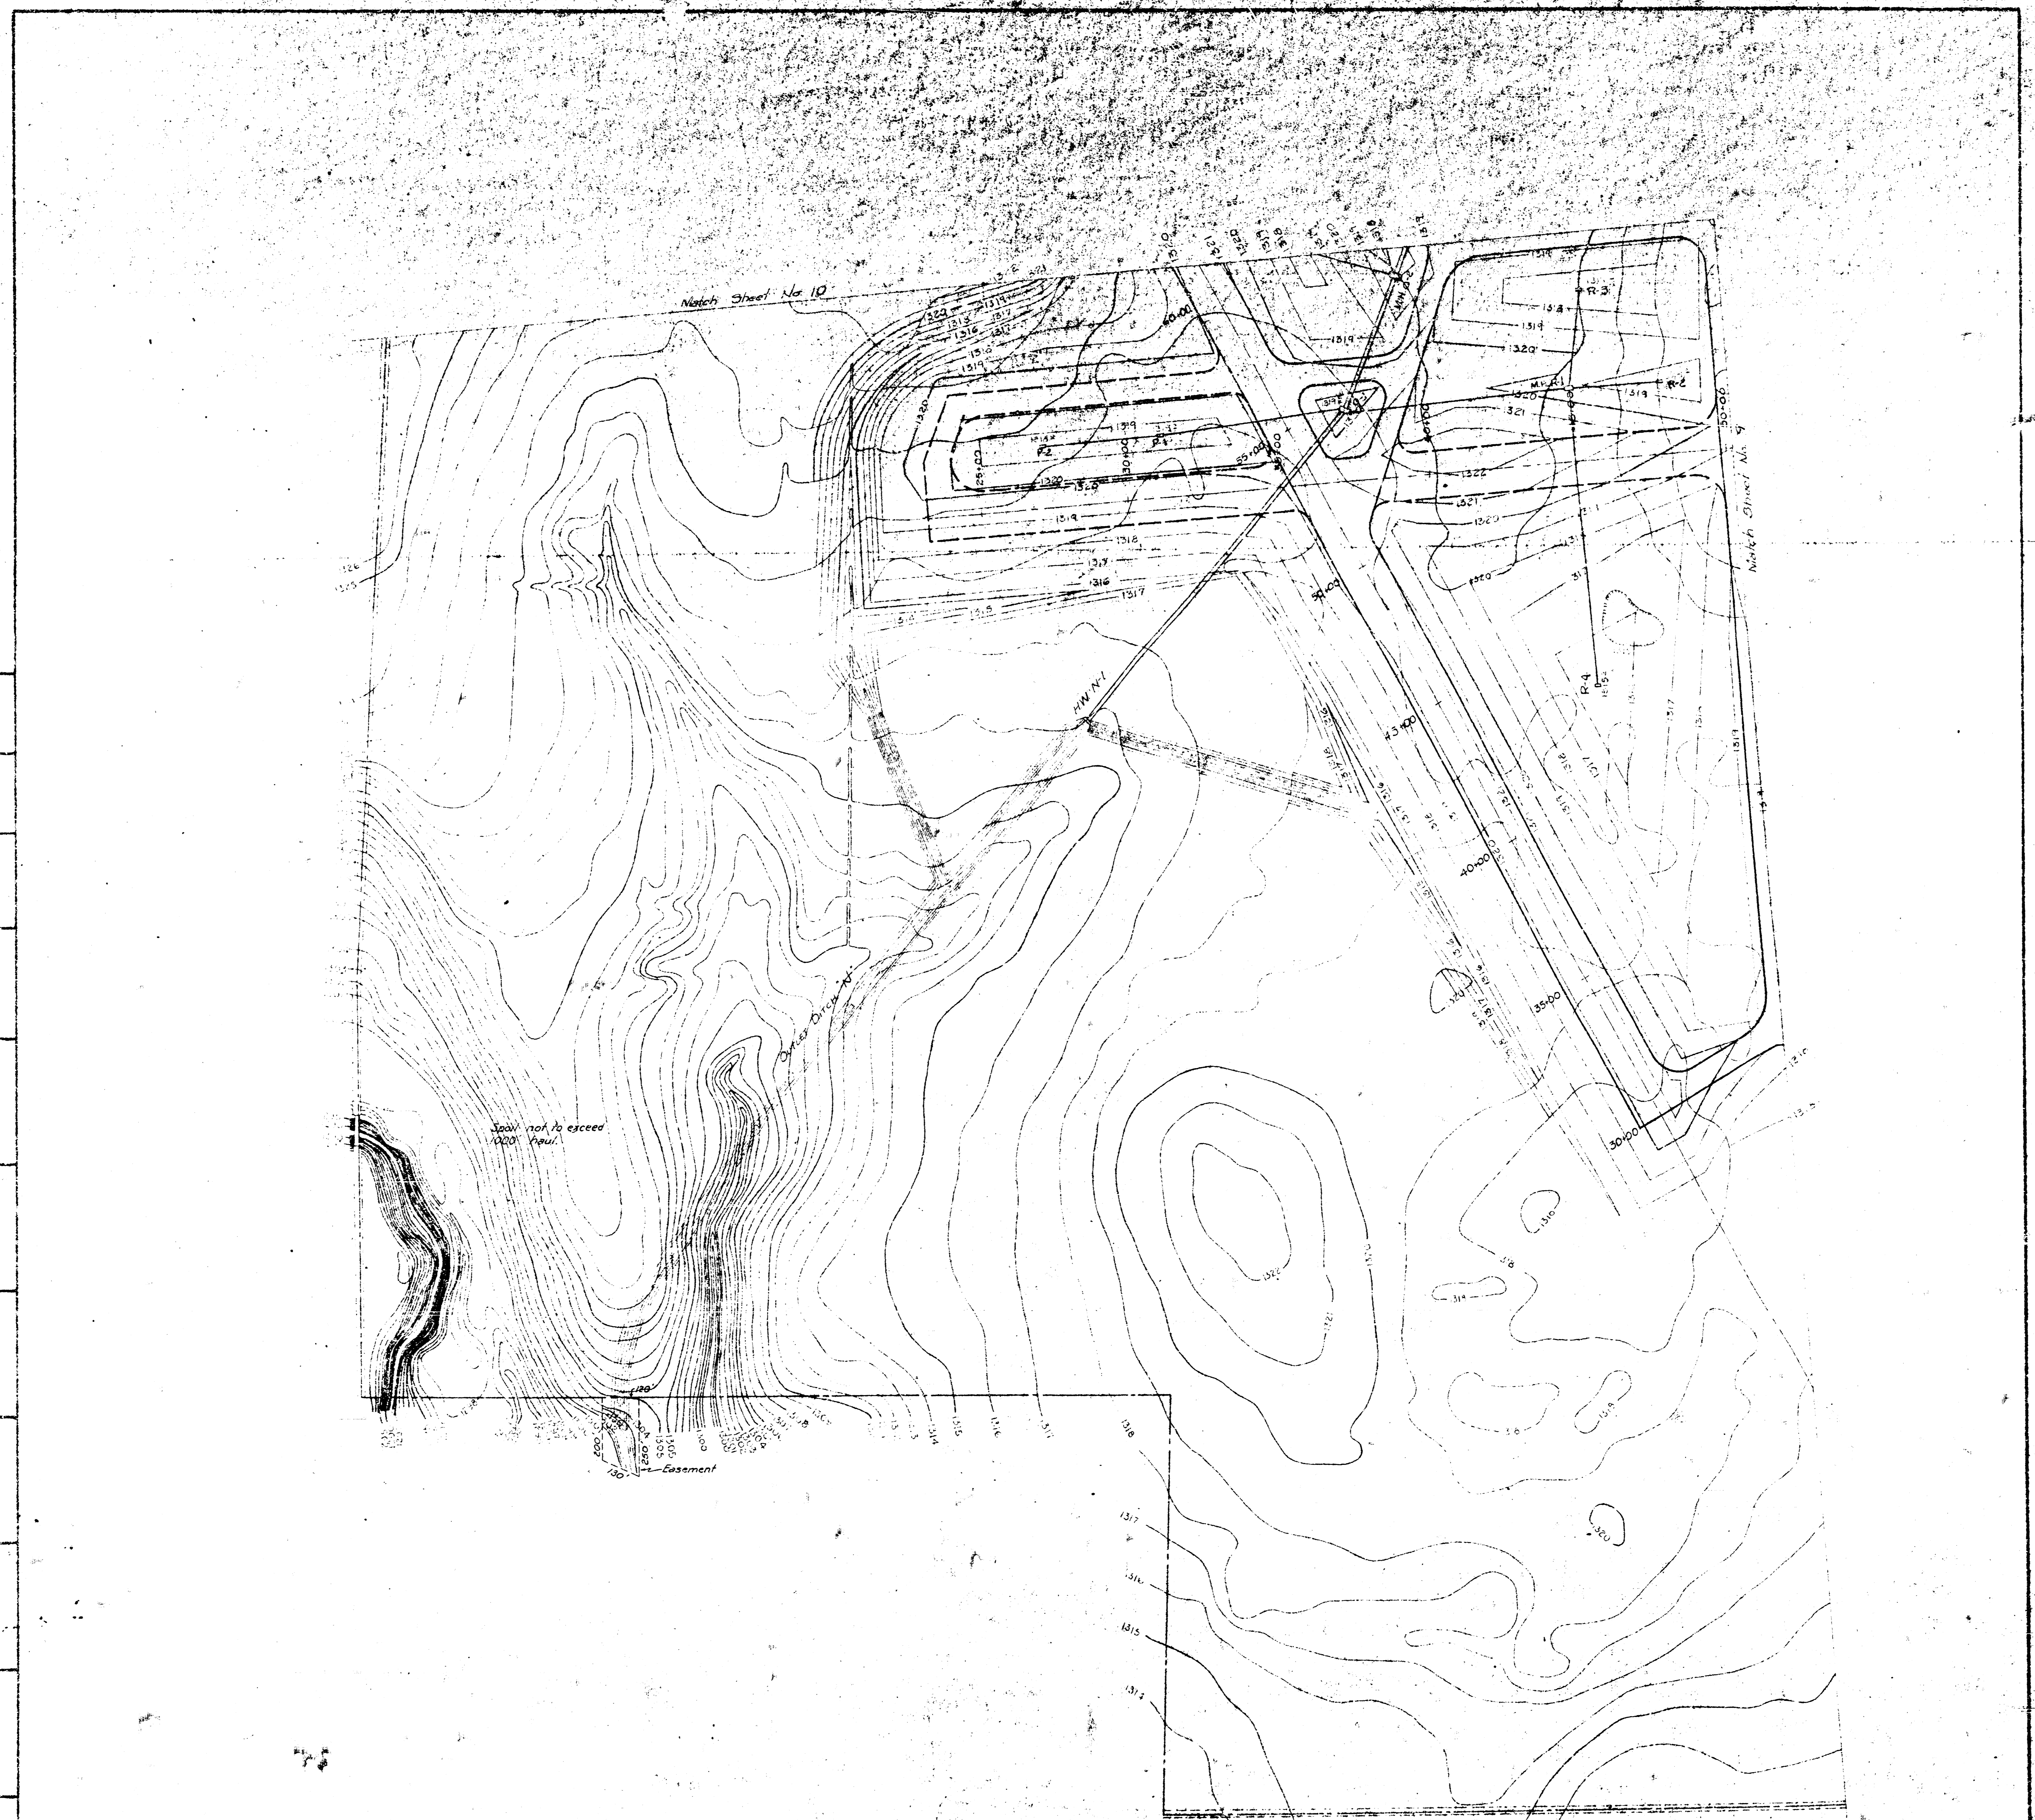

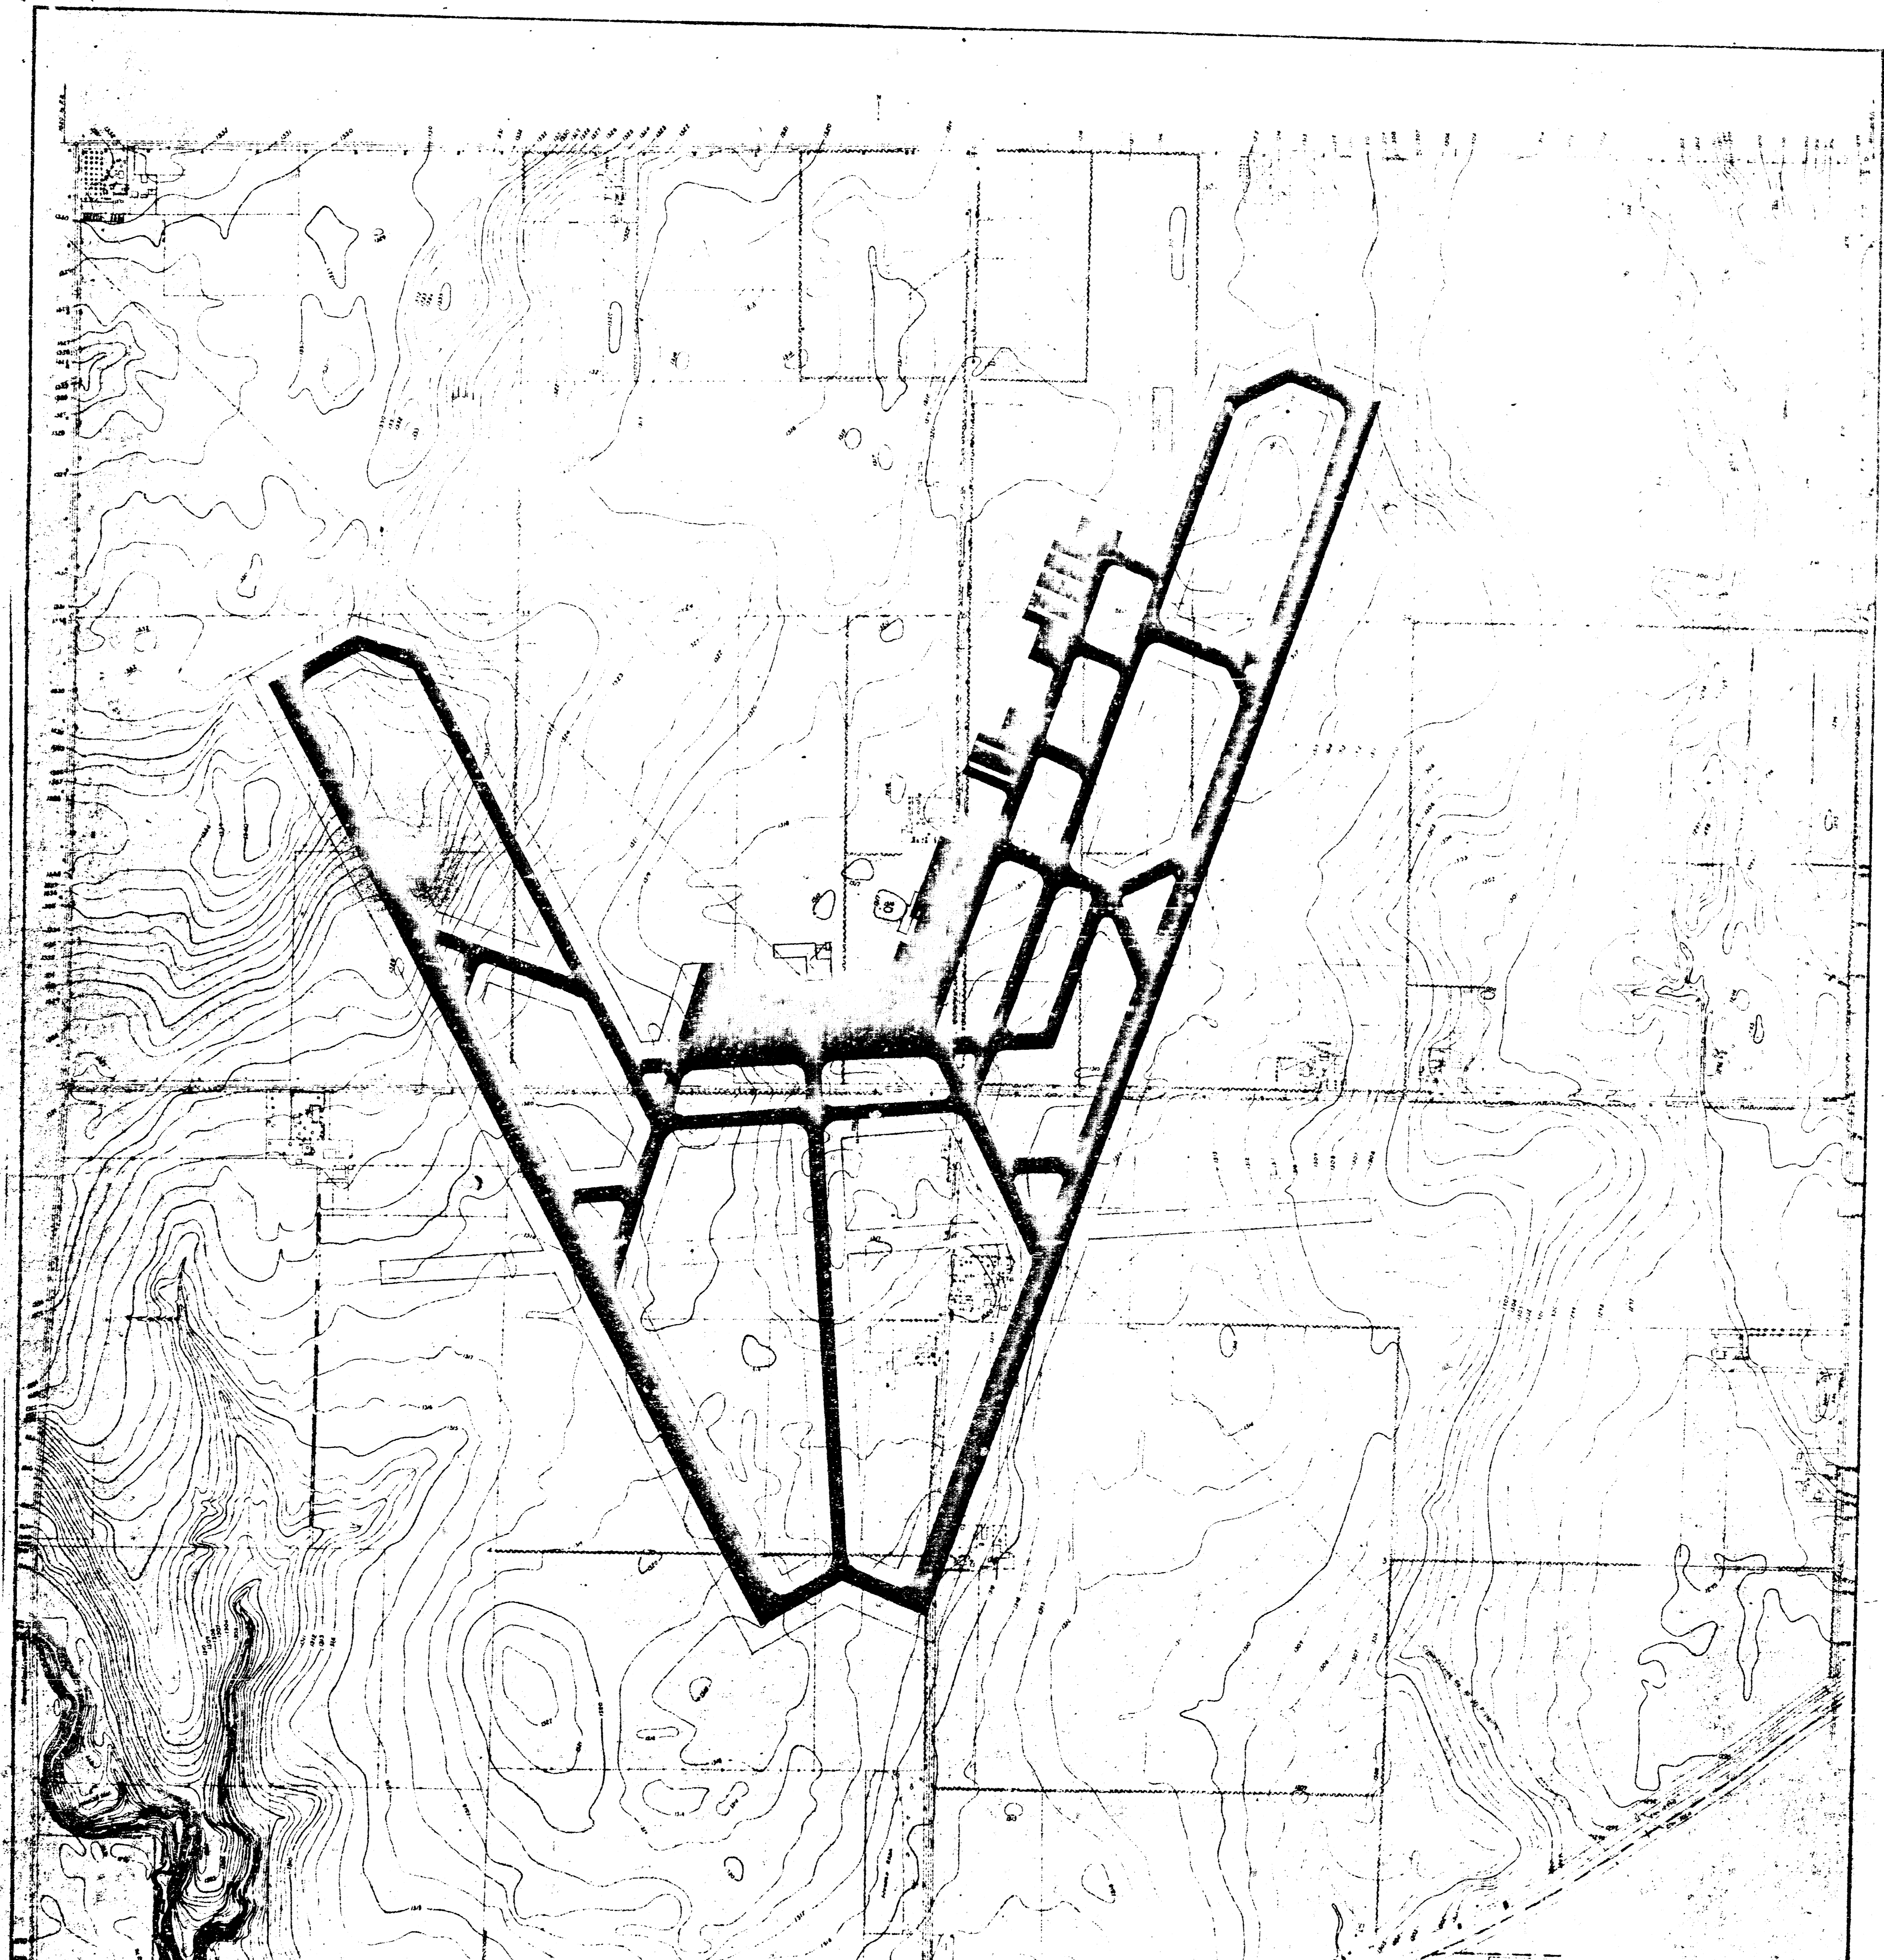


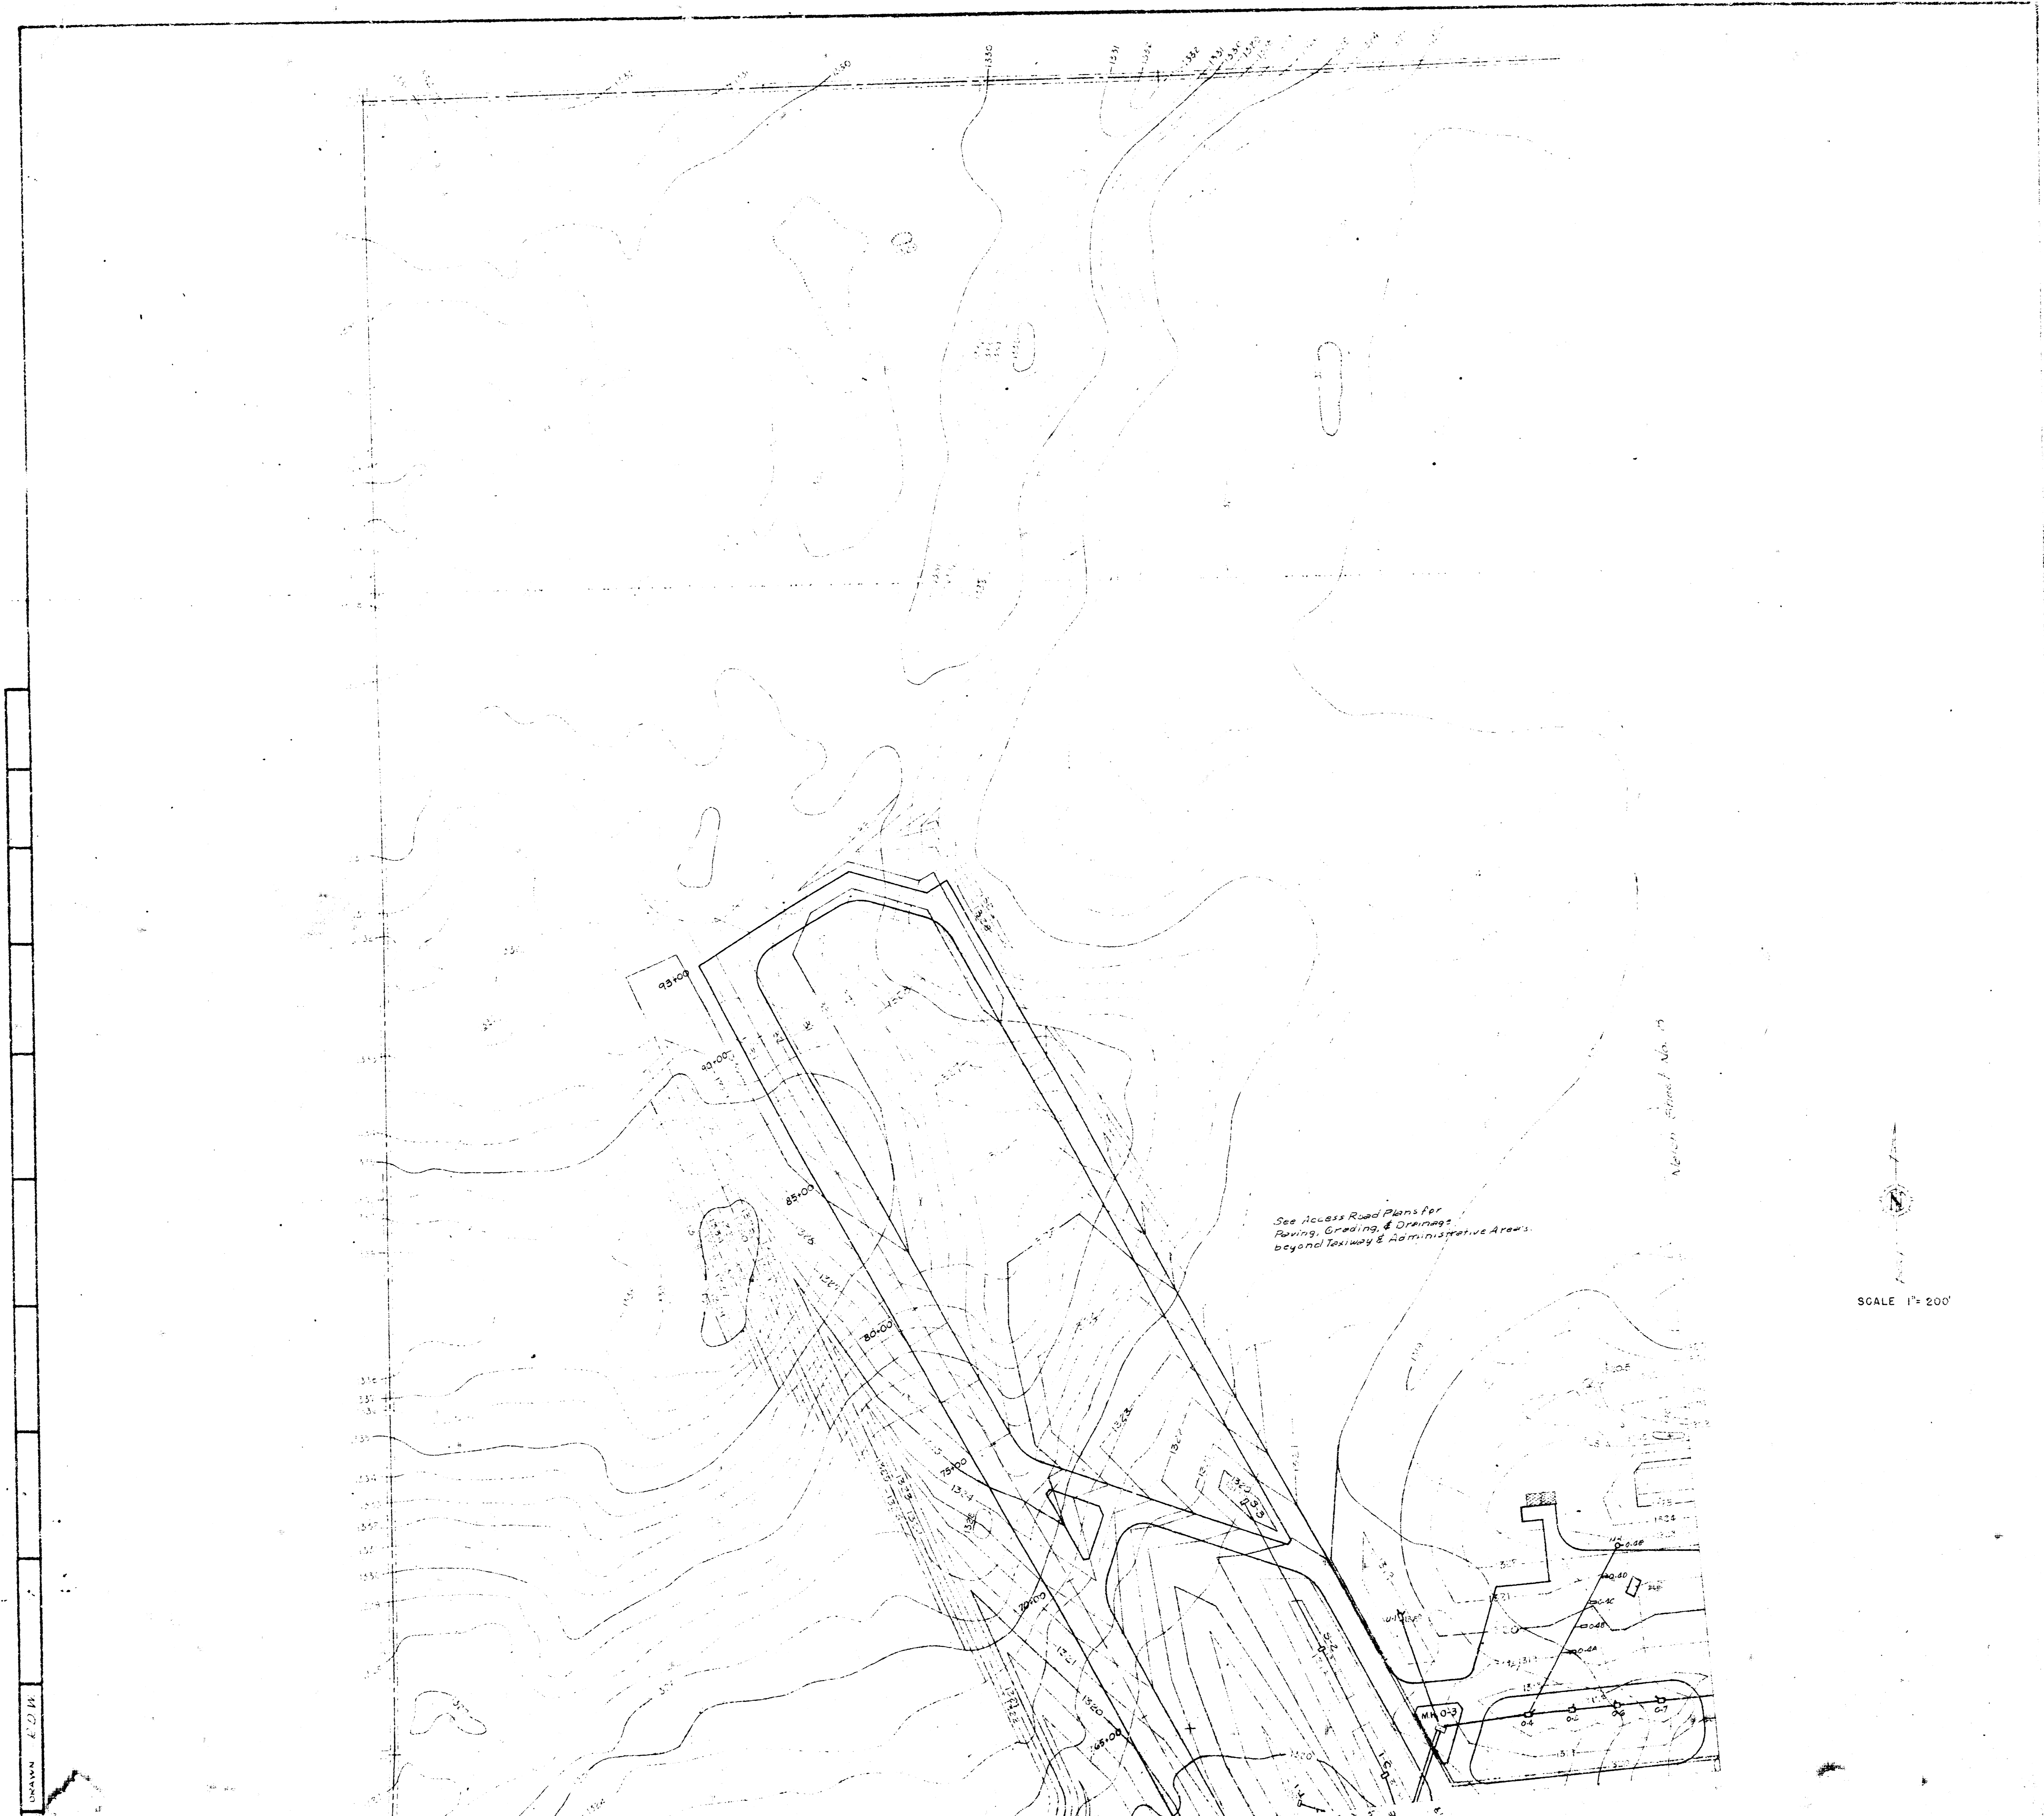

See Access Road Plans for
Paving, Grading & Drainage
beyond Taxiway & Administrative Areas.

SCALE 1" = 200'

1:20,000
1:10,000
1:5,000
1:2,500
1:1,250
1:625
1:312.5
1:156.25
1:78.125
1:39.0625
1:19.53125
1:9.765625
1:4.8828125
1:2.44140625
1:1.220703125
1:0.6103515625
1:0.30517578125
1:0.152587890625
1:0.0762939453125
1:0.03814697265625
1:0.019073486328125
1:0.0095367431640625
1:0.00476837158203125
1:0.002384185791015625
1:0.0011920928955078125
1:0.00059604644775390625
1:0.000298023223876953125
1:0.0001490116119384765625
1:0.00007450580596923828125
1:0.000037252902984619140625
1:0.0000186264514923095703125
1:0.00000931322574615478515625
1:0.000004656612873077392578125
1:0.0000023283064365386962890625
1:0.00000116415321826934814453125
1:0.000000582076609134674072265625
1:0.0000002910383045673370361328125
1:0.00000014551915228366851806640625
1:0.000000072759576141834259033203125
1:0.0000000363797880709171295166015625
1:0.00000001818989403545856475830078125
1:0.000000009094947017729282379150390625
1:0.0000000045474735088646411895751953125
1:0.00000000227373675443232059478759765625
1:0.000000001136868377216160297393798828125
1:0.0000000005684341886080801486968994140625
1:0.00000000028421709430404007434844970703125
1:0.000000000142108547152020037174224853515625
1:0.0000000000710542735760100185871124267578125
1:0.00000000003552713678800500929355621337890625
1:0.000000000017763568394002504646778106689453125
1:0.0000000000088817841970012523233890533447265625
1:0.0000000000044408920985006261616945266723828125
1:0.00000000000222044604925031308084726333619140625
1:0.000000000001110223024625154040413166678095703125
1:0.0000000000005551115123125770202070833390478828125
1:0.00000000000027755575615628851010354166740479140625
1:0.000000000000138777878078144255051770833702395703125
1:0.00000000000006938893903907212752588541668511978828125
1:0.000000000000034694469519536063762942708347895703125
1:0.000000000000017347234759768031881470404194479140625
1:0.000000000000008673617379884015940735202070833702395703125
1:0.00000000000000433680868994200797036760103541668511978828125
1:0.00000000000000216840434497100398518380051770833702395703125
1:0.0000000000000010842021724855019925919002588511978828125
1:0.00000000000000054210108624275099629595012942589453125
1:0.0000000000000002710505431213754981479750647259478828125
1:0.00000000000000013552527156068774907398750323619140625
1:0.0000000000000000677626357803438745489875016195703125
1:0.000000000000000033881317890171937274493750080978828125
1:0.00000000000000001694065894508596863724693750040479140625
1:0.00000000000000000847032947254298431862346937500202395703125
1:0.00000000000000000423516473627149215931173469375001011978828125
1:0.0000000000000000021175823681357460796558673469375000505989453125
1:0.0000000000000000010587911840678730398278337346937500025299478828125
1:0.0000000000000000005293955920339365199139166867346937500012649703125
1:0.0000000000000000002646977960169682599569583373469375000063248515625
1:0.0000000000000000001323488980084841299784791668673469375000031624265625
1:0.0000000000000000000661744490042420649892395833734693750000158121328125
1:0.00000000000000000003308722450212103249461979166867346937500000790606640625
1:0.000000000000000000016543612251060516247309895833734693750000003953033203125
1:0.000000000000000000008271806125530258123649447916686734693750000019765166015625
1:0.0000000000000000000041359030627651290718223724583373469375000000098825830078125
1:0.00000000000000000000206795153138257453591118619291668673469375000000049412915625
1:0.00000000000000000000103397576569128727555559309147916686734693750000000247064578125
1:0.000000000000000000000516987882845643877777965473724583373469375000000001235322890625
1:0.00000000000000000000025849394142282193888898273686192916686734693750000000006176614453125
1:0.0000000000000000000001292469707114140969444913683091479166867346937500000000030883072265625
1:0.00000000000000000000006462348535570704847222468415473724583373469375000000000154415361328125
1:0.0000000000000000000000323117426778535242361123420773686192916686734693750000000000772076806640625
1:0.00000000000000000000001615587133892676211805617103893091479166867346937500000000003860384033203125
1:0.0000000000000000000000080779356694633810590280855194649573686192916686734693750000000000019301920166015625
1:0.00000000000000000000000403896783473169052951404275973247893091479166867346937500000000000096509600830078125
1:0.000000000000000000000002019483917365845264757021379866239464957368619291668673469375000000000000482548004150390625
1:0.0000000000000000000000010097419586829226323785106899332478930914791668673469375000000000002412740020751953125
1:0.00000000000000000000000050487097934146113168925544496662394649573686192916686734693750000000000012063700103759765625
1:0.00000000000000000000000025243548967073056584462772248332478930914791668673469375000000000006031850051898828125
1:0.000000000000000000000000126217744835365282922311386116662394649573686192916686734693750000000000030159250259494140625
1:0.0000000000000000000000000631088724176826414611169308333247893091479166867346937500000000000150796251297470703125
1:0.000000000000000000000000031554436208841320725558465416662394649573686192916686734693750000000000007539812564873515625
1:0.00000000000000000000000001577721810442066036277723270833247893091479166867346937500000000000376990628243678828125
1:0.000000000000000000000000007888609052210330181388861633324789309147916686734693750000000000018849531412189453125
1:0.00000000000000000000000000394430452610516509069443081666239464957368619291668673469375000000000000942476570609478828125
1:0.0000000000000000000000000019721522630525825453472154083332478930914791668673469375000000000004712382853047395703125
1:0.0000000000000000000000000009860761315262912726716077041666239464957368619291668673469375000000000002356191426523678828125
1:0.0000000000000000000000000004930380657631456363858038520833247893091479166867346937500000000001178095713261839453125
1:0.0000000000000000000000000002465190328815728181929019260416662394649573686192916686734693750000000000589047856309478828125
1:0.00000000000000000000000000012325951644078640909645083020833247893091479166867346937500000000002945239281547395703125
1:0.000000000000000000000000000061629758220393204548225415104166623946495736861929166867346937500000000014726196407736978828125
1:0.0000000000000000000000000000308148791101966022741127075520833247893091479166867346937500000000000736309820386839453125
1:0.000000000000000000000000000015407439555098301137056353776041666239464957368619291668673469375000000000036815491019341978828125
1:0.0000000000000000000000000000077037197775491505685281768880208332478930914791668673469375000000000018407745509670978828125
1:0.0000000000000000000000000000038518598887745752842640894440208332478930914791668673469375000000000009203872754835478828125
1:0.00000000000000000000000000000192592994438728764213204472202083324789309147916686734693750000000000046019363774177395703125
1:0.000000000000000000000000000000962964972193863821066022361020833247893091479166867346937500000000000230096818870889478828125
1:0.0000000000000000000000000000004814824860969319103301118052083324789309147916686734693750000000000011504840943544478828125
1:0.0000000000000000000000000000002407412430484659551650559026041666239464957368619291668673469375000000000057524204717722395703125
1:0.00000000000000000000000000000012037062152423297757752795130208332478930914791668673469375000000000028762102358861978828125
1:0.00000000000000000000000000000006018531076211648878876397565104166623946495736861929166867346937500000000014381051179435978828125
1:0.000000000000000000000000000000030092655381058244394381987825520833247893091479166867346937500000000007190525897177978828125
1:0.000000000000000000000000000000015046327690529122197190993912760416662394649573686192916686734693750000000003595262948588978828125
1:0.0000000000000000000000000000000075231638452645611098594969563802083324789309147916686734693750000000001797631474294478828125
1:0.0000000000000000000000000000000037615819226322805549279734781902083324789309147916686734693750000000008988157371471978828125
1:0.0000000000000000000000000000000018807909613161402774639867390952083324789309147916686734693750000000004494078685735978828125
1:0.0000000000000000000000000000000009403954806580701387319933695476041666239464957368619291668673469375000000002247039342867978828125
1:0.0000000000000000000000000000000047019774032903506936599668477380208332478930914791668673469375000000001123519671433978828125
1:0.0000000000000000000000000000000023509887016451753468299834238690208332478930914791668673469375000000005617598357166978828125
1:0.000000000000000000000000000000001175494350822587673414991711934760416662394649573686192916686734693750000000028087991785833978828125
1:0.000000000000000000000000000000000587747175411293836707495855967380208332478930914791668673469375000000014043995892916978828125
1:0.000000000000000000000000000000002938735877056469183537479277983690208332478930914791668673469375000000007021997946458978828125
1:0.000000000000000000000000000000001469367938528234591768739638996845041666239464957368619291668673469375000000003510998973229478828125
1:0.000000000000000000000000000000000734683969264117295884369819499422504166623946495736861929166867346937500000000175549948661478828125
1:0.00000000000000000000000000000000367341984632058647944219909749971250416662394649573686192916686734693750000000008777497433073978828125
1:0.000000000000000000000000000000001836709923160293239721099548749936250416662394649573686192916686734693750000000004388748716536978828125
1:0.0000000000000000000000000000000009183549615801466198605497743749681250416662394649573686192916686734693750000000002194374358268478828125
1:0.000000000000000000000000000000004591774807900733099302748871874834125041666239464957368619291668673469375000000000109718717913423978828125
1:0.0000000000000000000000000000000022958874039503665496513744359374162504166623946495736861929166867346937500000000054859358956711978828125
1:0.00000000000000000000000000000000114794370197518327482568721796870812504166623946495736861929166867346937500000000027429679478355978828125
1:0.00000000000000000000000000000000057397185098759163741284360898435412504166623946495736861929166867346937500000000013714839739177978828125
1:0.00000000000000000000000000000000286985925493795818706421804492177081250416662394649573686192916686734693750000000006857419869588978828125
1:0.000000000000000000000000000000001434929627468979093532109022460885041666239464957368619291668673469375000000003428709934794478828125
1:0.000000000000000000000000000000000717464813734489546766054511230442504166623946495736861929166867346937500000000171435496739723978828125
1:0.000000000000000000000000000000003587324068672247733830272556152212504166623946495736861929166867346937500000000085717748369861978828125
1:0.00000000000000000000000000000000179366203433612386691513627782610812504166623946495736861929166867346937500000000042858874184930978828125
1:0.00000000000000000000000000000000089683101716806193345756813891305412504166623946495736861929166867346937500000000021429437092464978828125
1:0.00000000000000000000000000000000448415508584030966728784069456770812504166623946495736861929166867346937500000000010714718546232478828125
1:0.000000000000000000000000000000002242077542920154833614

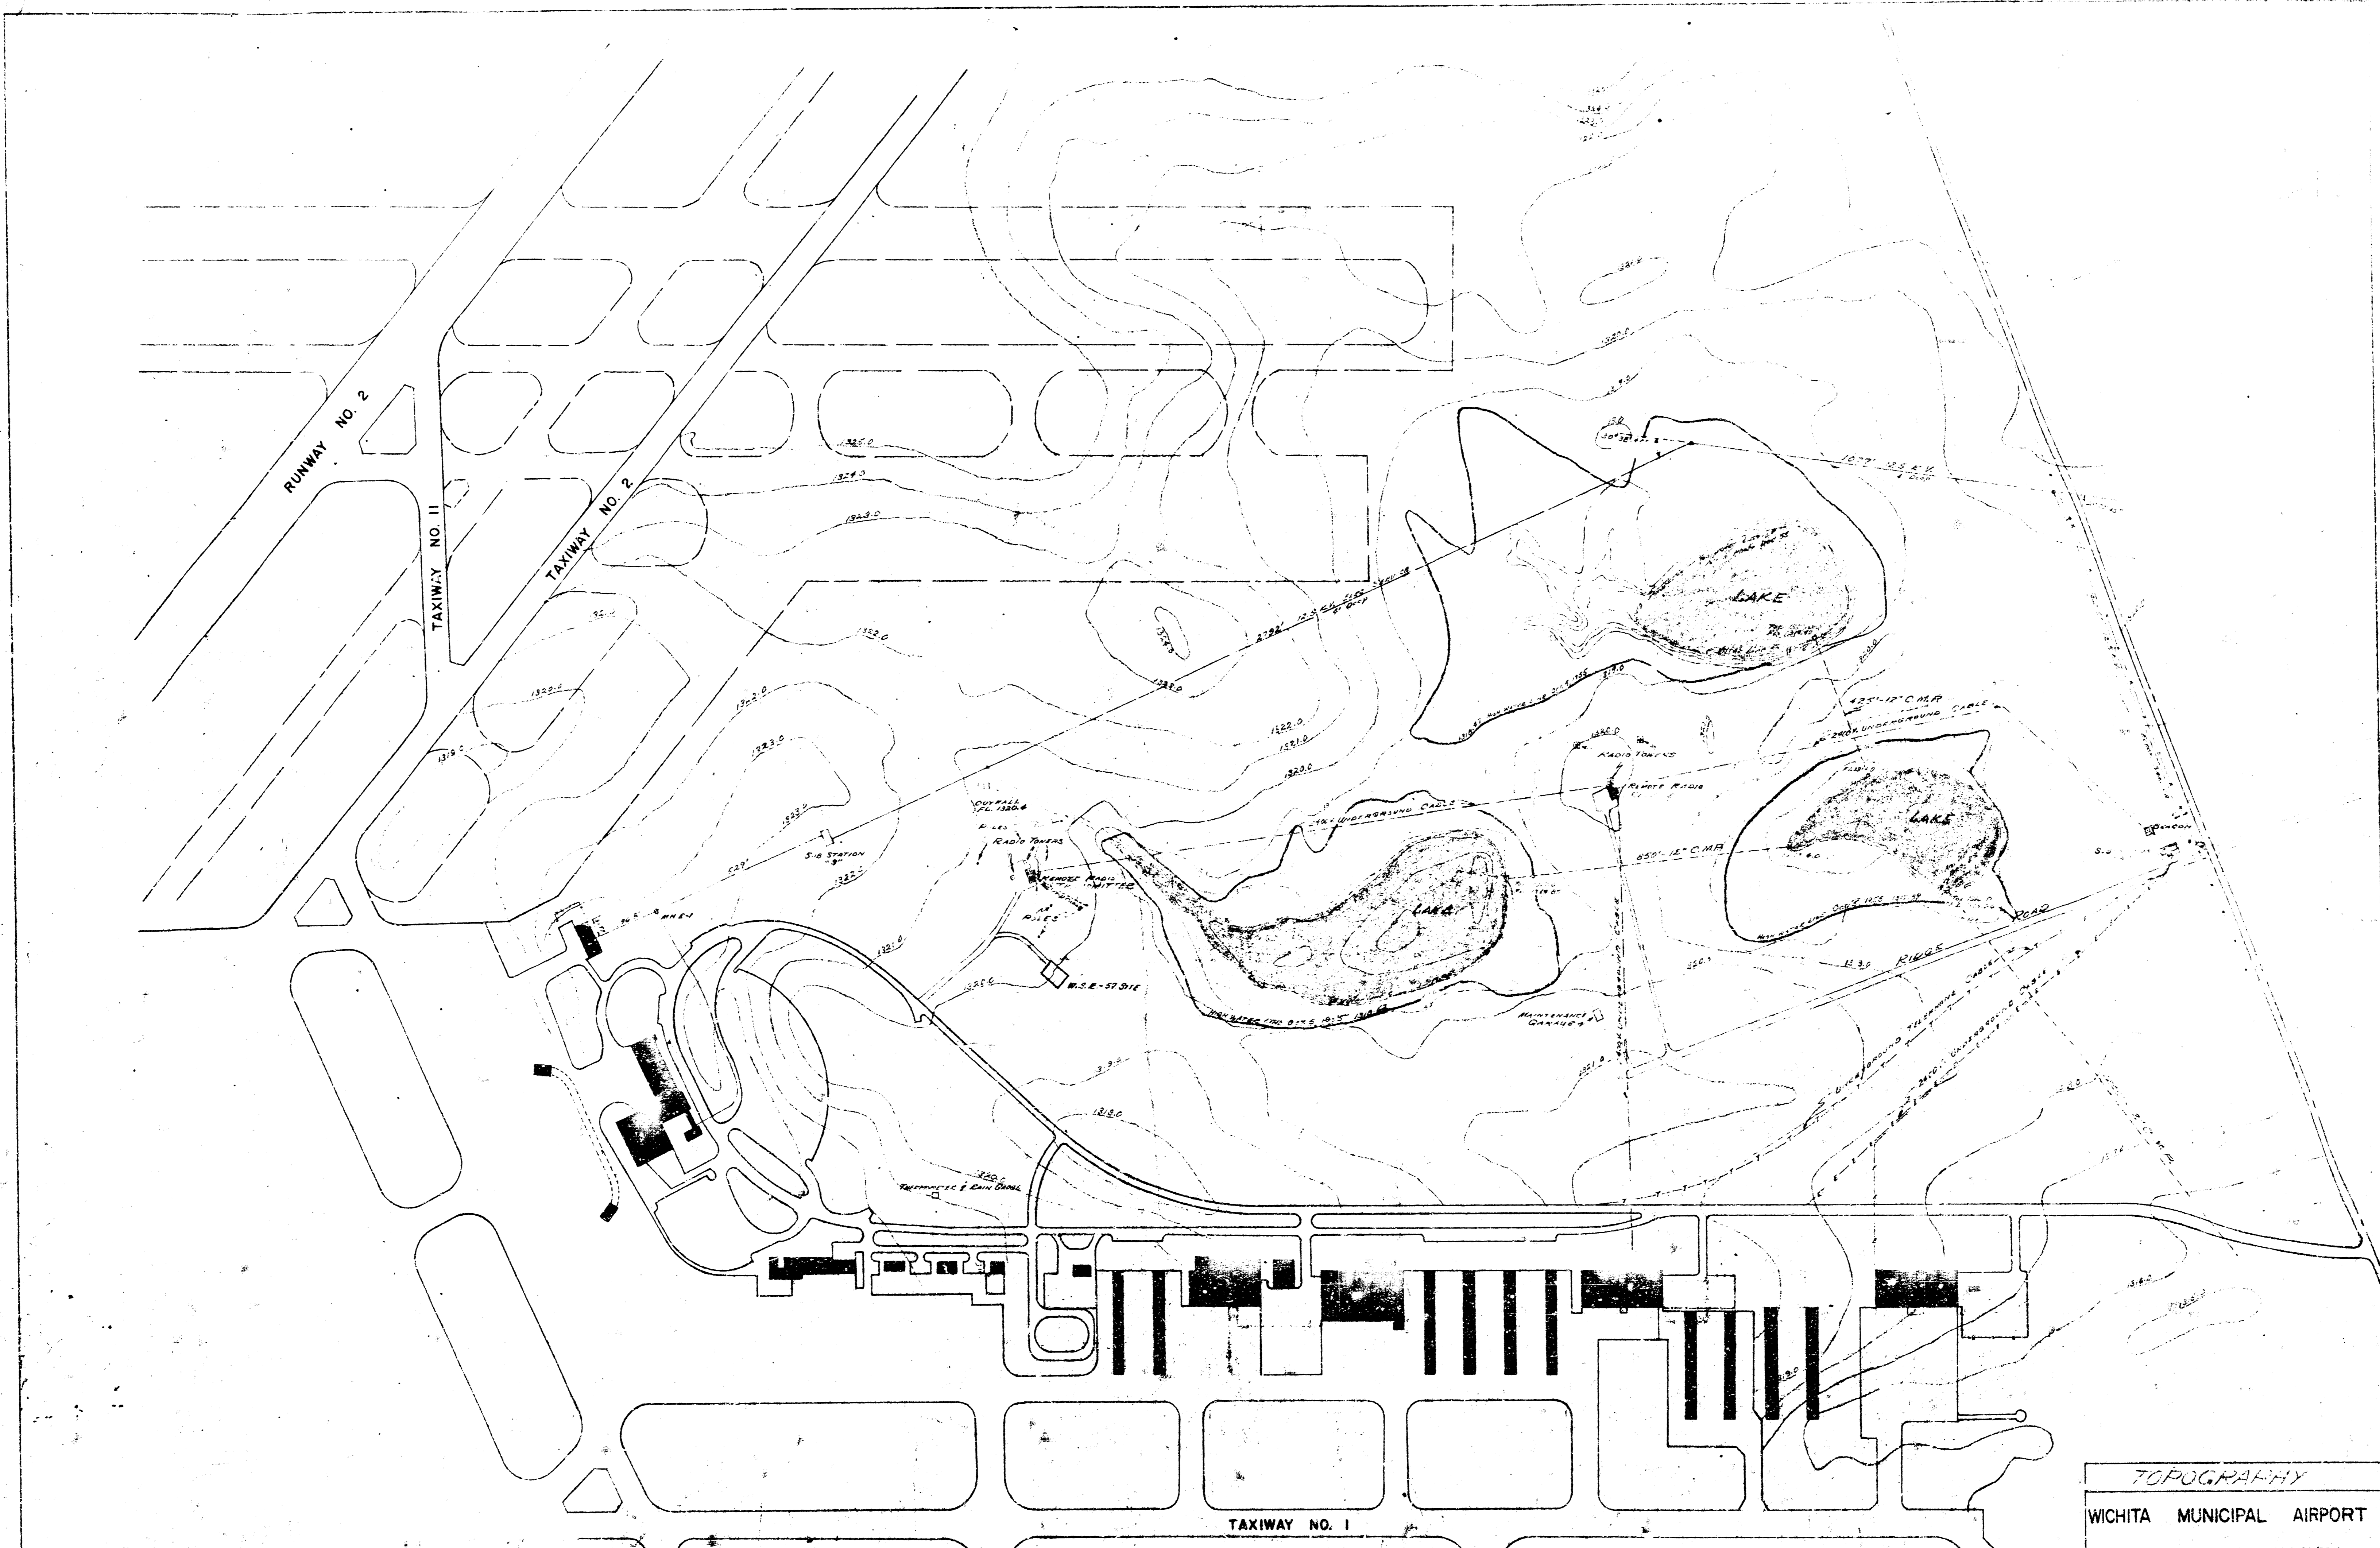

TOPOGRAPHY
 WICHITA MUNICIPAL AIRPORT
 BOARD OF PARK COMMISSIONERS
 WICHITA, KANSAS

Prepared by: [Illegible]
 Date: 11-14-55
 Scale: 1" = 200' T.T.B.

