

SANITARY SEWER PLANS

FOR WSU PHYSICAL PLANT
WICHITA, KANSAS

Low Kingston, Inc. Architects & Engineers 345 Riverview Wichita, Kansas (316) 268-0230	BY: RCF DATE: REVISED:
--	------------------------------

GENERAL NOTES


1. Notify the following companies prior to any trenching:
Arkla Gas Co. 942-8050
Bell Telephone 571-1115
Cablevision 263-5317
Gas Service Co. 263-7511
Kansas Gas and Electric 261-6248
Kansas One Call 1-800-244-7233
2. All block corners and control points will be protected. If removed during construction, Contractor will have them replaced by a licensed land surveyor at his expense.
3. All sanitary sewer lines and manholes shall be installed in accordance with "City of Wichita" Standards and Specifications.
4. There is to be no work started by the Contractor prior to notification and approval of the Chief Engineer of Construction and Survey, City of Wichita Operations and Maintenance Department and the assignment and presence of a Sewer Inspector on the construction site. Should construction be started prior to these requirements being met, the Contractor will be required to re-open any ditches that may have been backfilled.
5. Pavement removal and replacement and backfill of trenches to meet "City of Wichita" standards and specifications. Contractor to make arrangements with the "City of Wichita" Traffic Engineering Department for traffic control while working on the existing Street.

NOTE TO CONTRACTOR

This project will be constructed under the supervision of the CITY ENGINEER and conforming to the SPECIFICATIONS of the CITY OF WICHITA. The CONTRACTOR will pay the City of Wichita for all costs of plan review, inspection and booking per contract.



APPROVED AS SHOWN
By CITY ENGINEER OF WICHITA

Sanitary Sewers VRH 11/10/87
Storm Sewers _____
Driveway Approaches _____
Water Mains _____

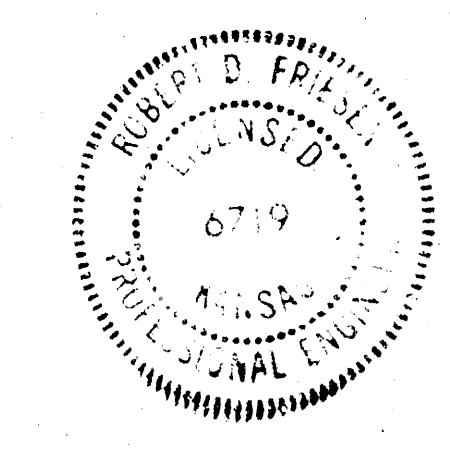

LEGEND

- EXISTING SANITARY SEWER
- NEW SANITARY SEWER
- EXISTING MANHOLE
- NEW MANHOLE
- ▨ REMOVE & REPLACE CONCRETE PAVEMENT

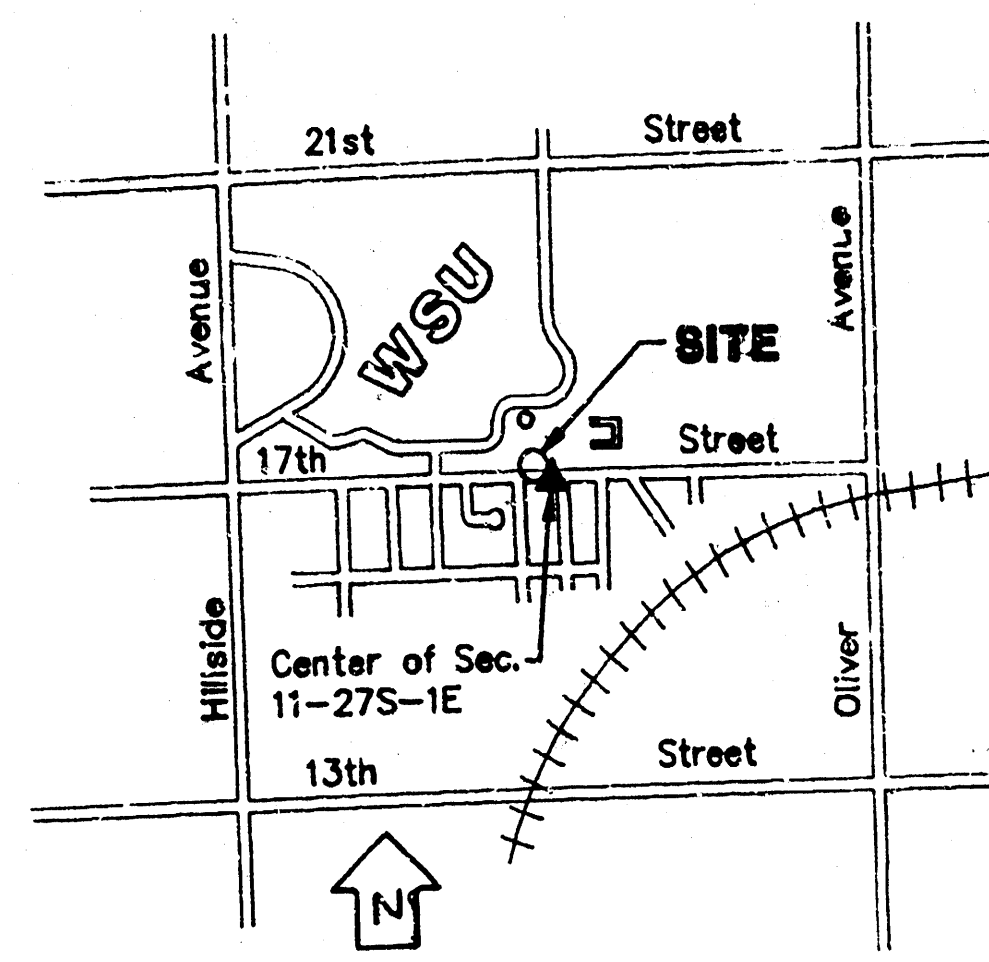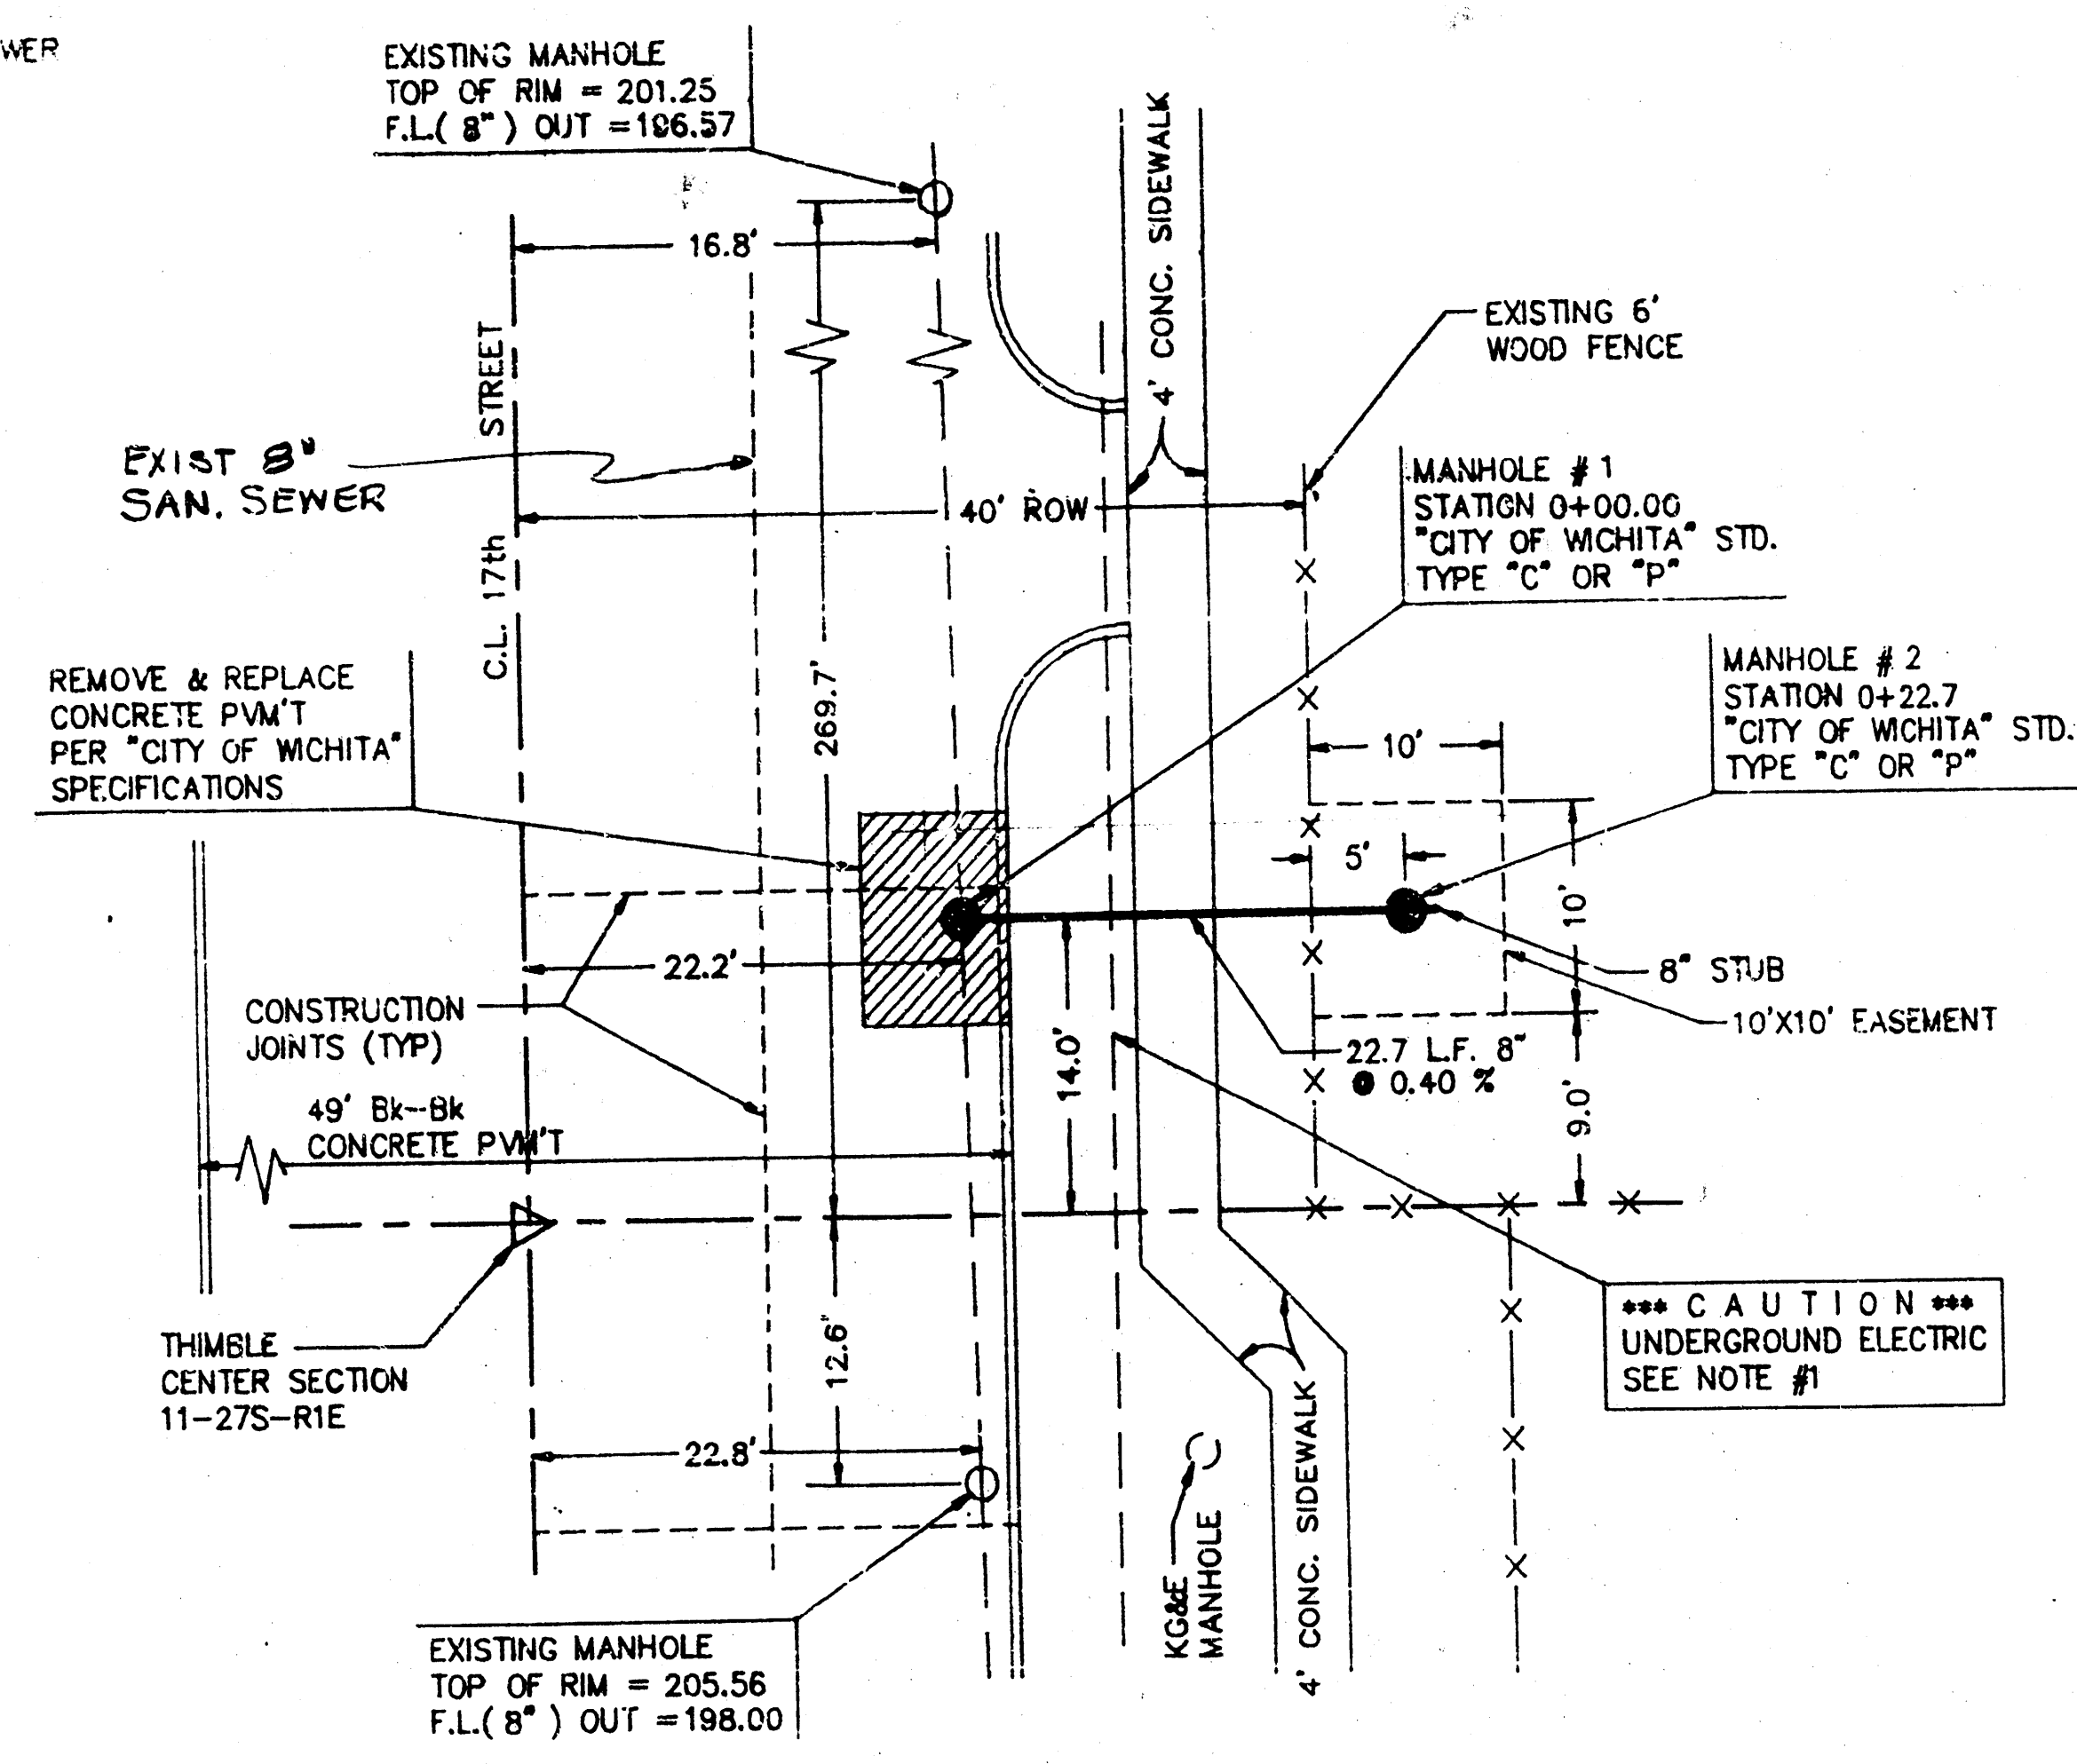

VICINITY MAP
1"=2000'




A

PLAN AND PROFILE

SCALE: PLAN — 1"=10'
PROFILE — 1"=10' HORIZ.
1"=5' VERT.

PRIVATE SAN. SEWER EXTENSION
TO SERVE EXPANSION AT WSU
468-76-245-80001-000-000-141

PRODUCED

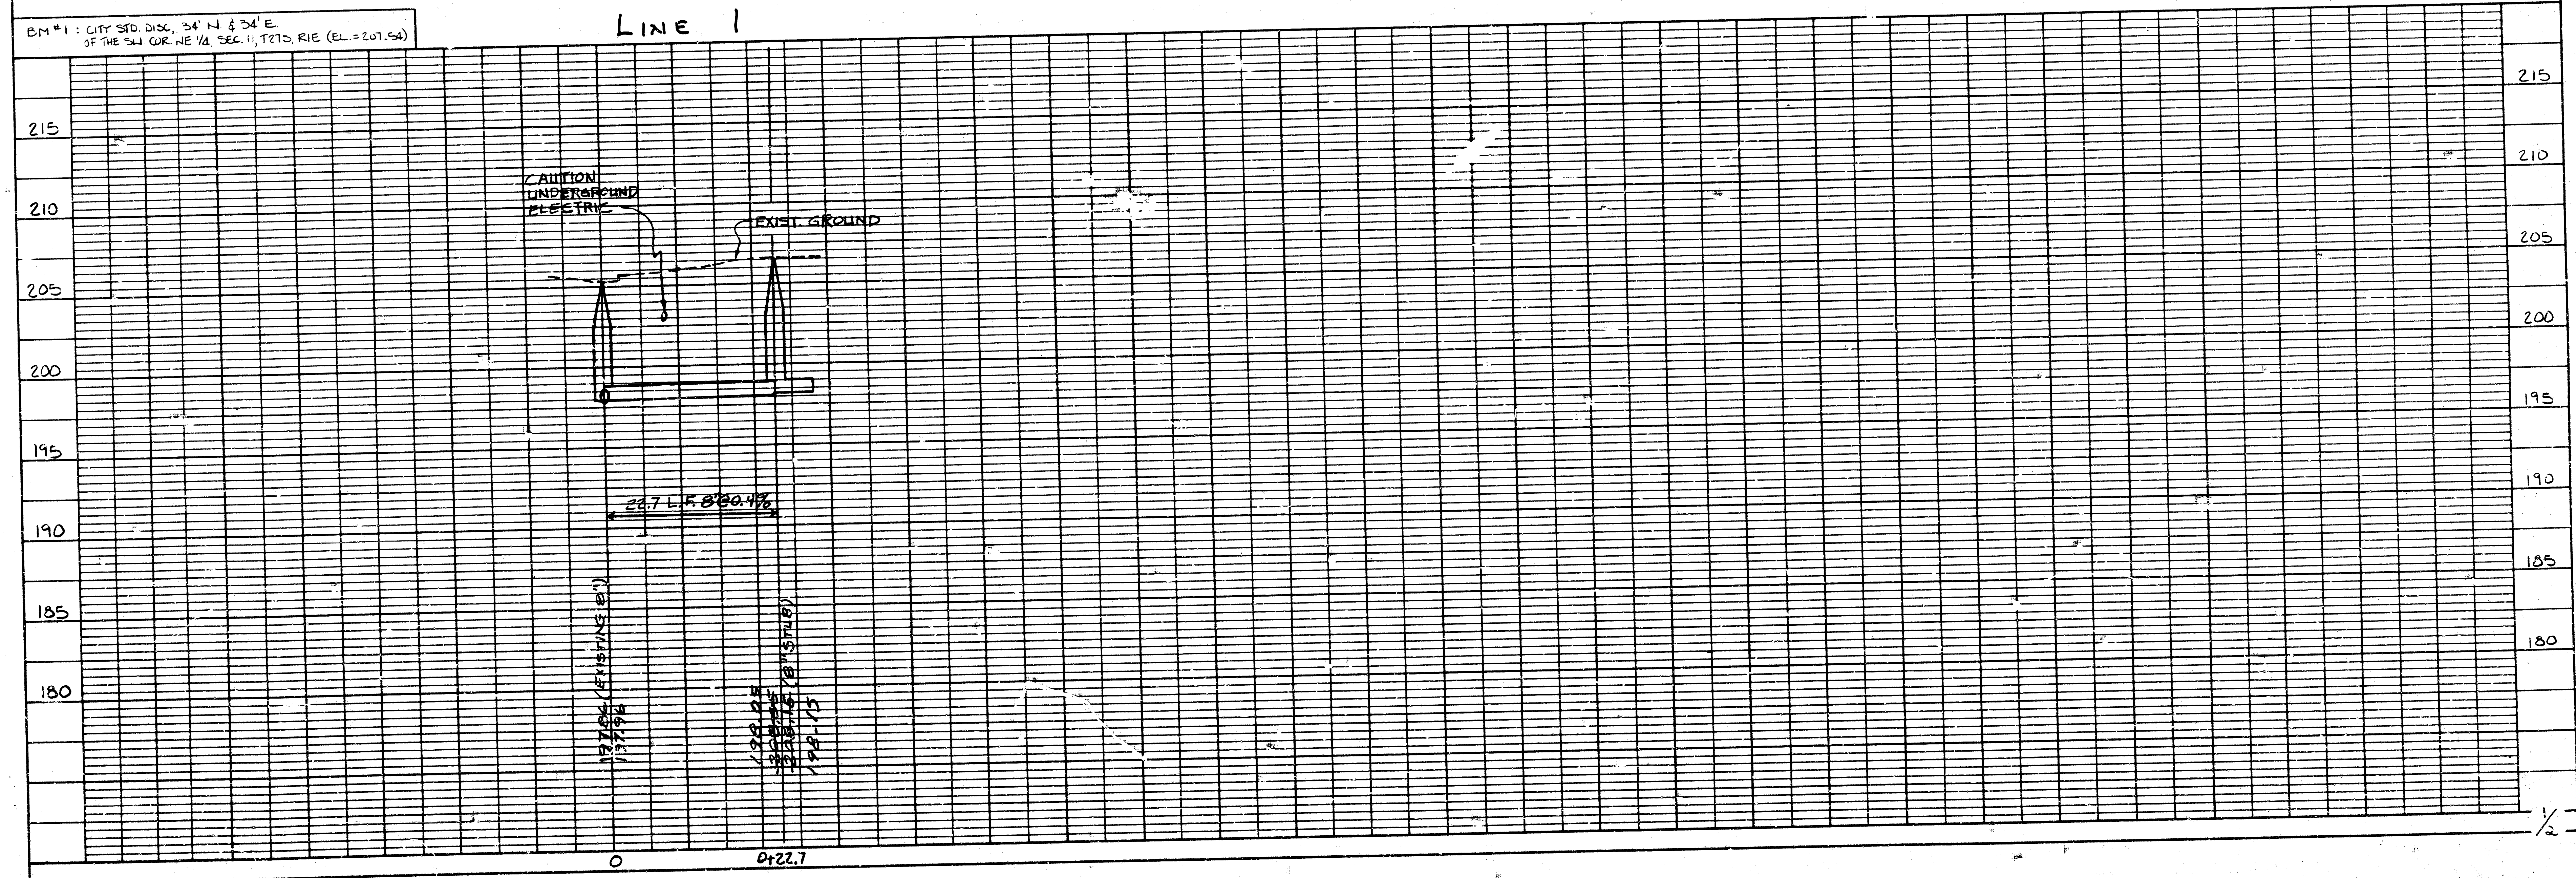


SANITARY SEWER PLANS

FOR WSU GOLF
MAINTENANCE BUILDING
WICHITA, KANSAS

LAW/KINGDON, INC.
ARCHITECTS & ENGINEERS
348 Riverside
Wichita, Kansas
(316) 268-0230



DATE
10/2/87 FOR BIDDING

SHEET OF 40

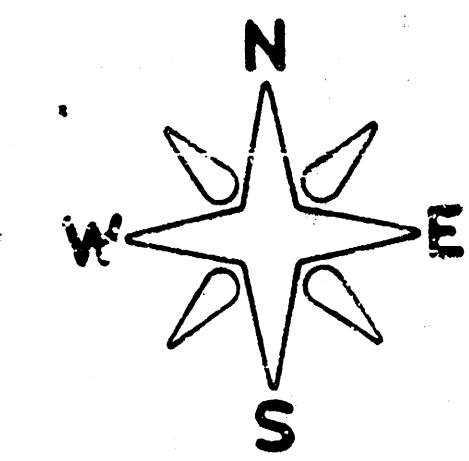

Legend -

M.H. = Manhole
S.S. = Sanitary Sewer
O.E. = Overhead Electric
U.E. = Underground Electric
U.T. = Underground Telephone
USLC = Underground Street Light Circuit
P.P. = Power Pole
L.P. = Light Pole
SLC = Street Light Circuit

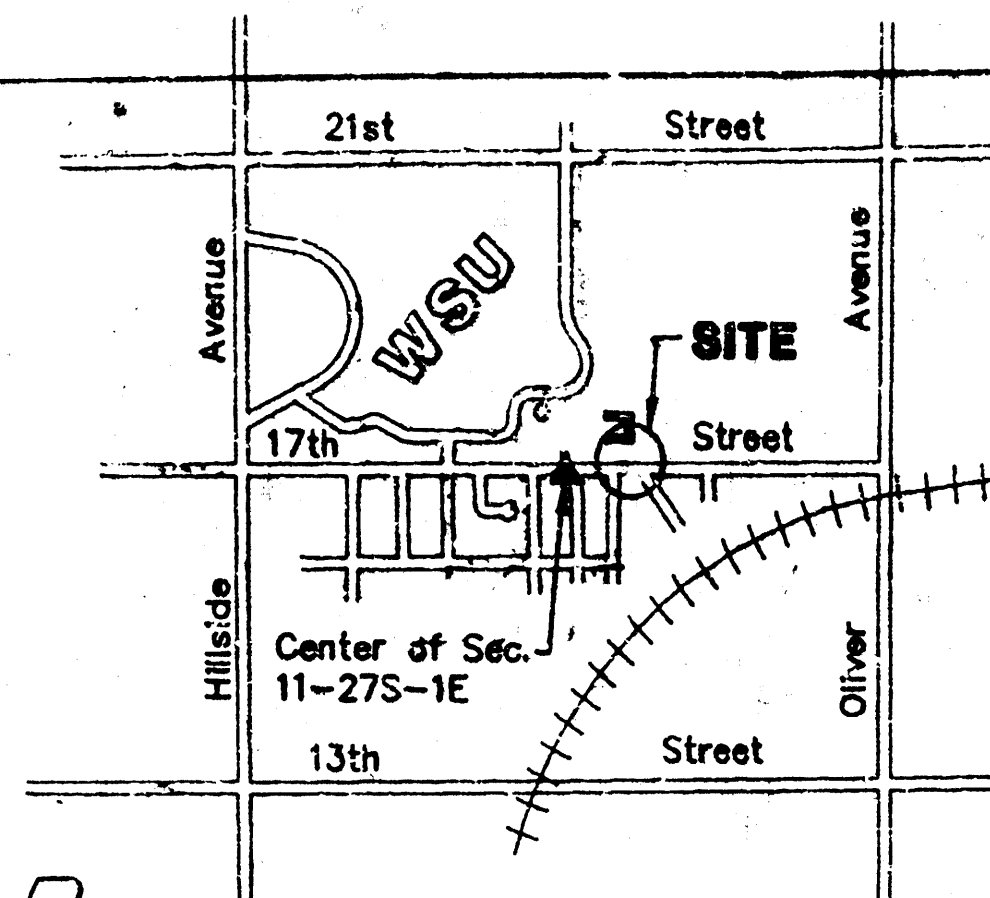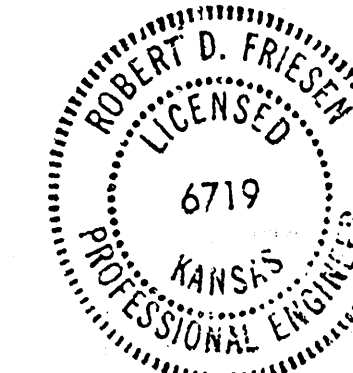


VICINITY MAP
1"=2000'

GENERAL NOTES

1. Notify the following companies prior to any trenching.
Arkla Gas Co. 942-8350
Bell Telephone 571-2115
Cablevision 268-6817
Gas Service Co. 263-7511
Kansas Gas and Electric 261-6248
Kansas One Call 1-800-344-7233
2. All block corners and control points will be protected. If removed during construction, Contractor will have them replaced by a licensed engineer or land surveyor at his expense.
3. All sanitary sewer lines and manholes shall be installed in accordance with "City of Wichita" Standards and Specifications.
4. Make arrangements with Electric company to trench by the power pole and guy wires.
5. There is to be no work started by the Contractor prior to notification and approval of the Chief Engineer of Construction and Survey, City of Wichita Operations and Maintenance Department and the assignment and presence of a Sewer Inspector on the construction site. Should construction be started prior to these requirements being met, the Contractor will be required to reopen any ditches that may have been backfilled.

WHEATSHOCKER

ADDITION

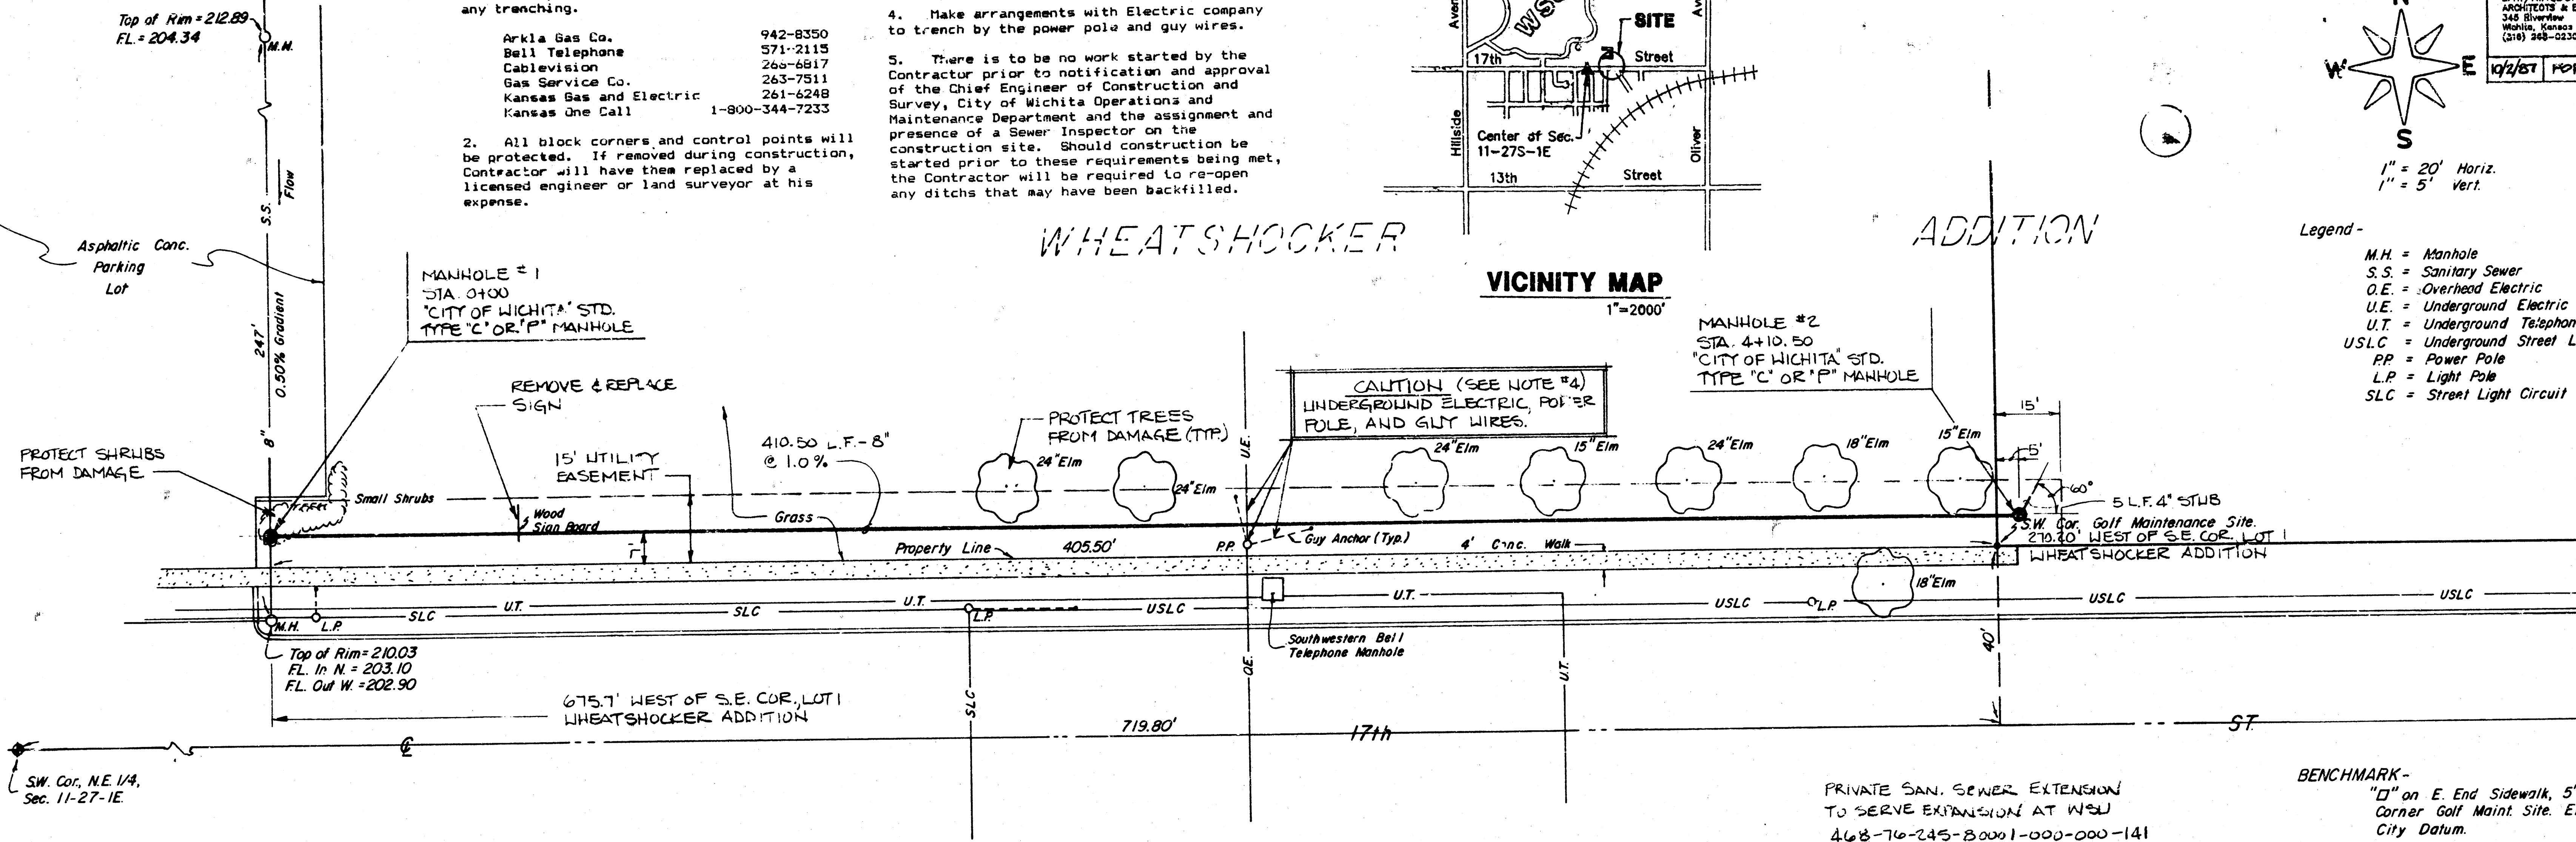

LINE 2

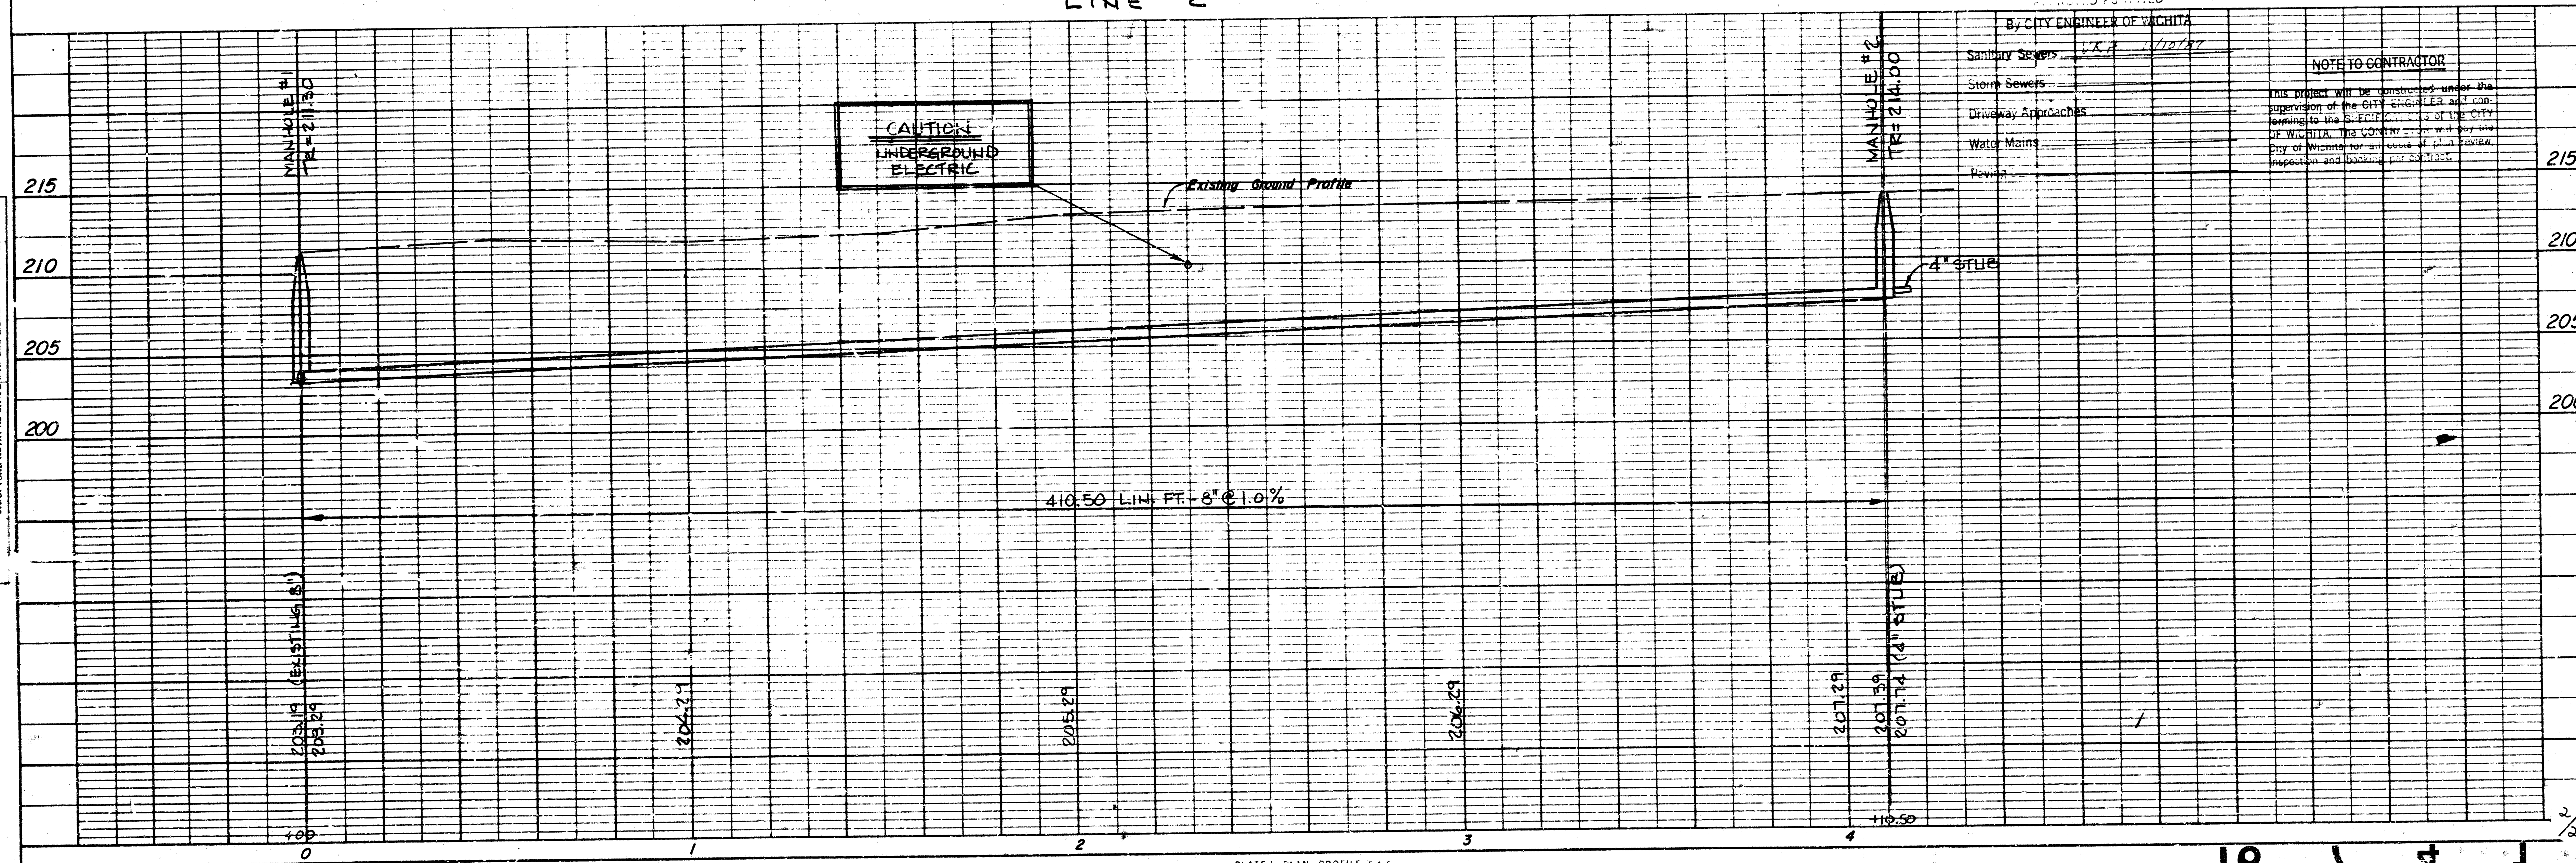


PLATE 1 PLAN & PROFILE - F & S
DRAWING PAPER CO. 5-1-141
NO. 100011

FILMED FROM THE BEST
AVAILABLE COPY....