

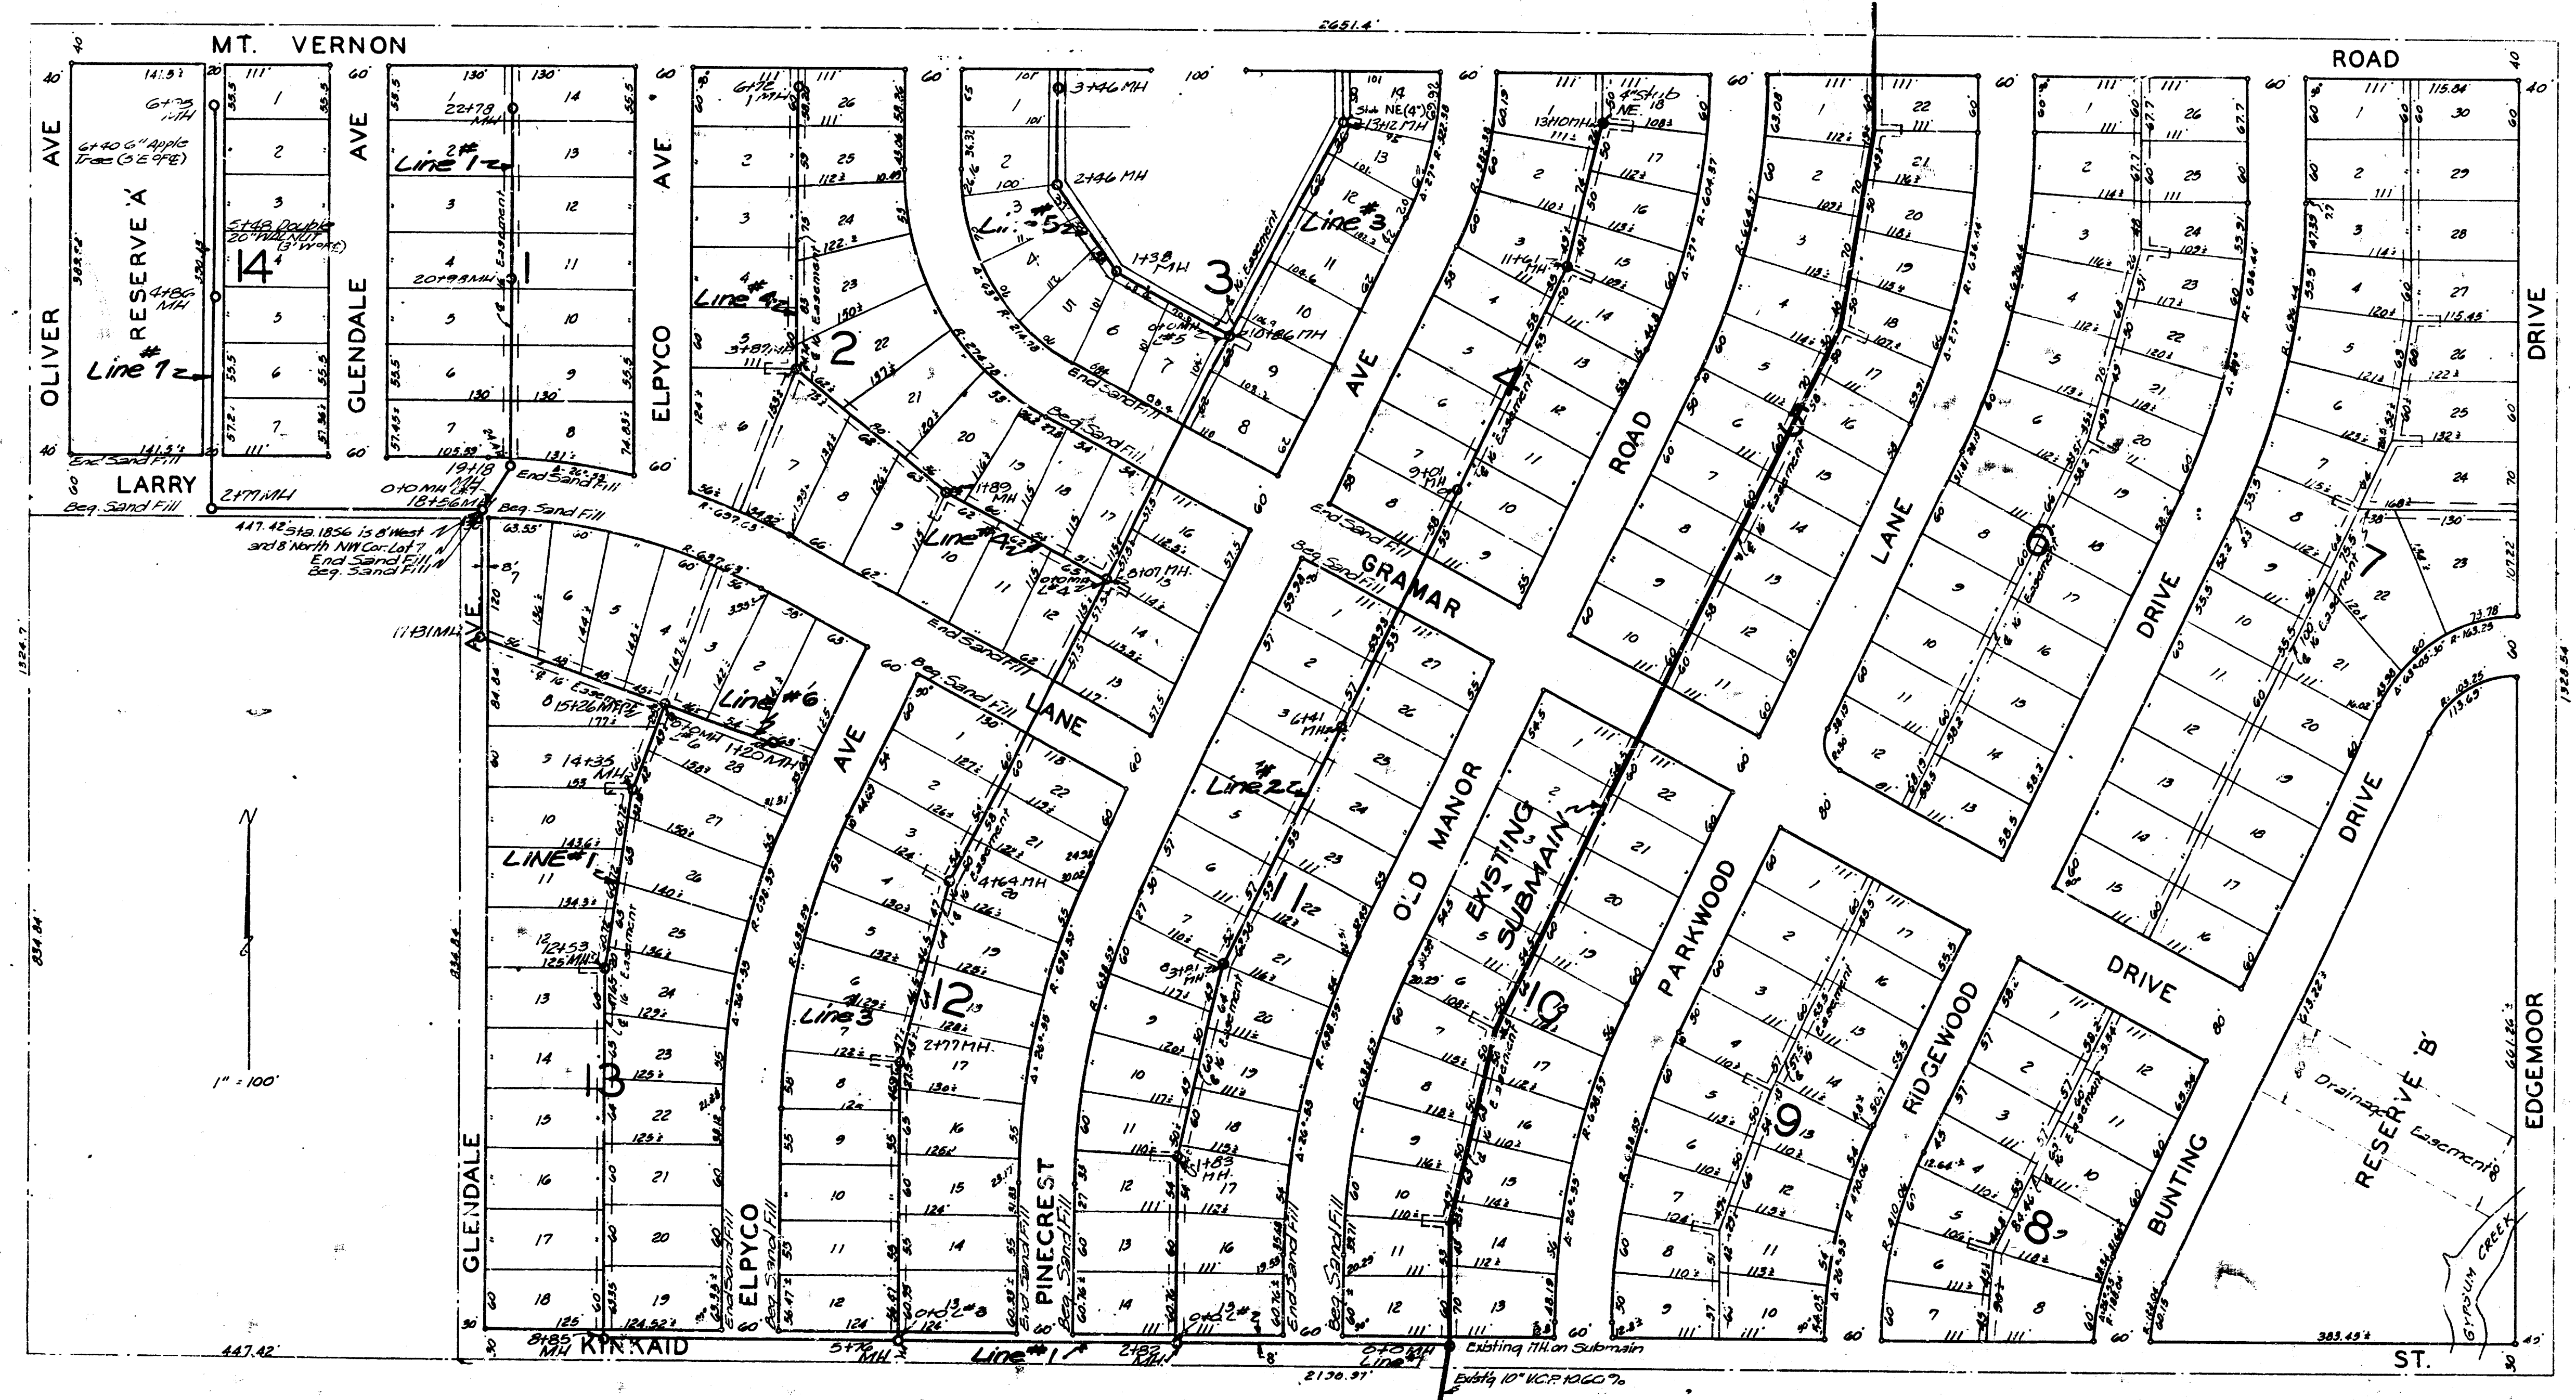


LATERAL 5, DISTRICT I, WAR INDUSTRIES SEWER
WICHITA, KANSAS
1950

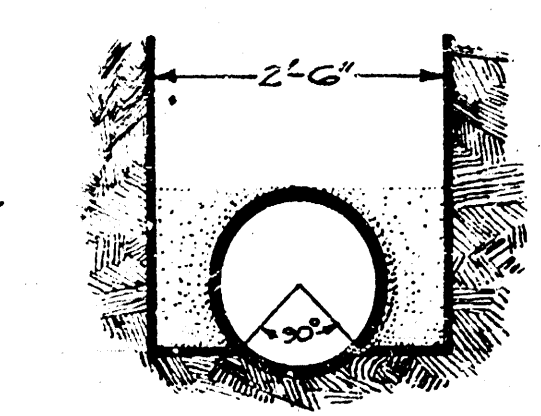

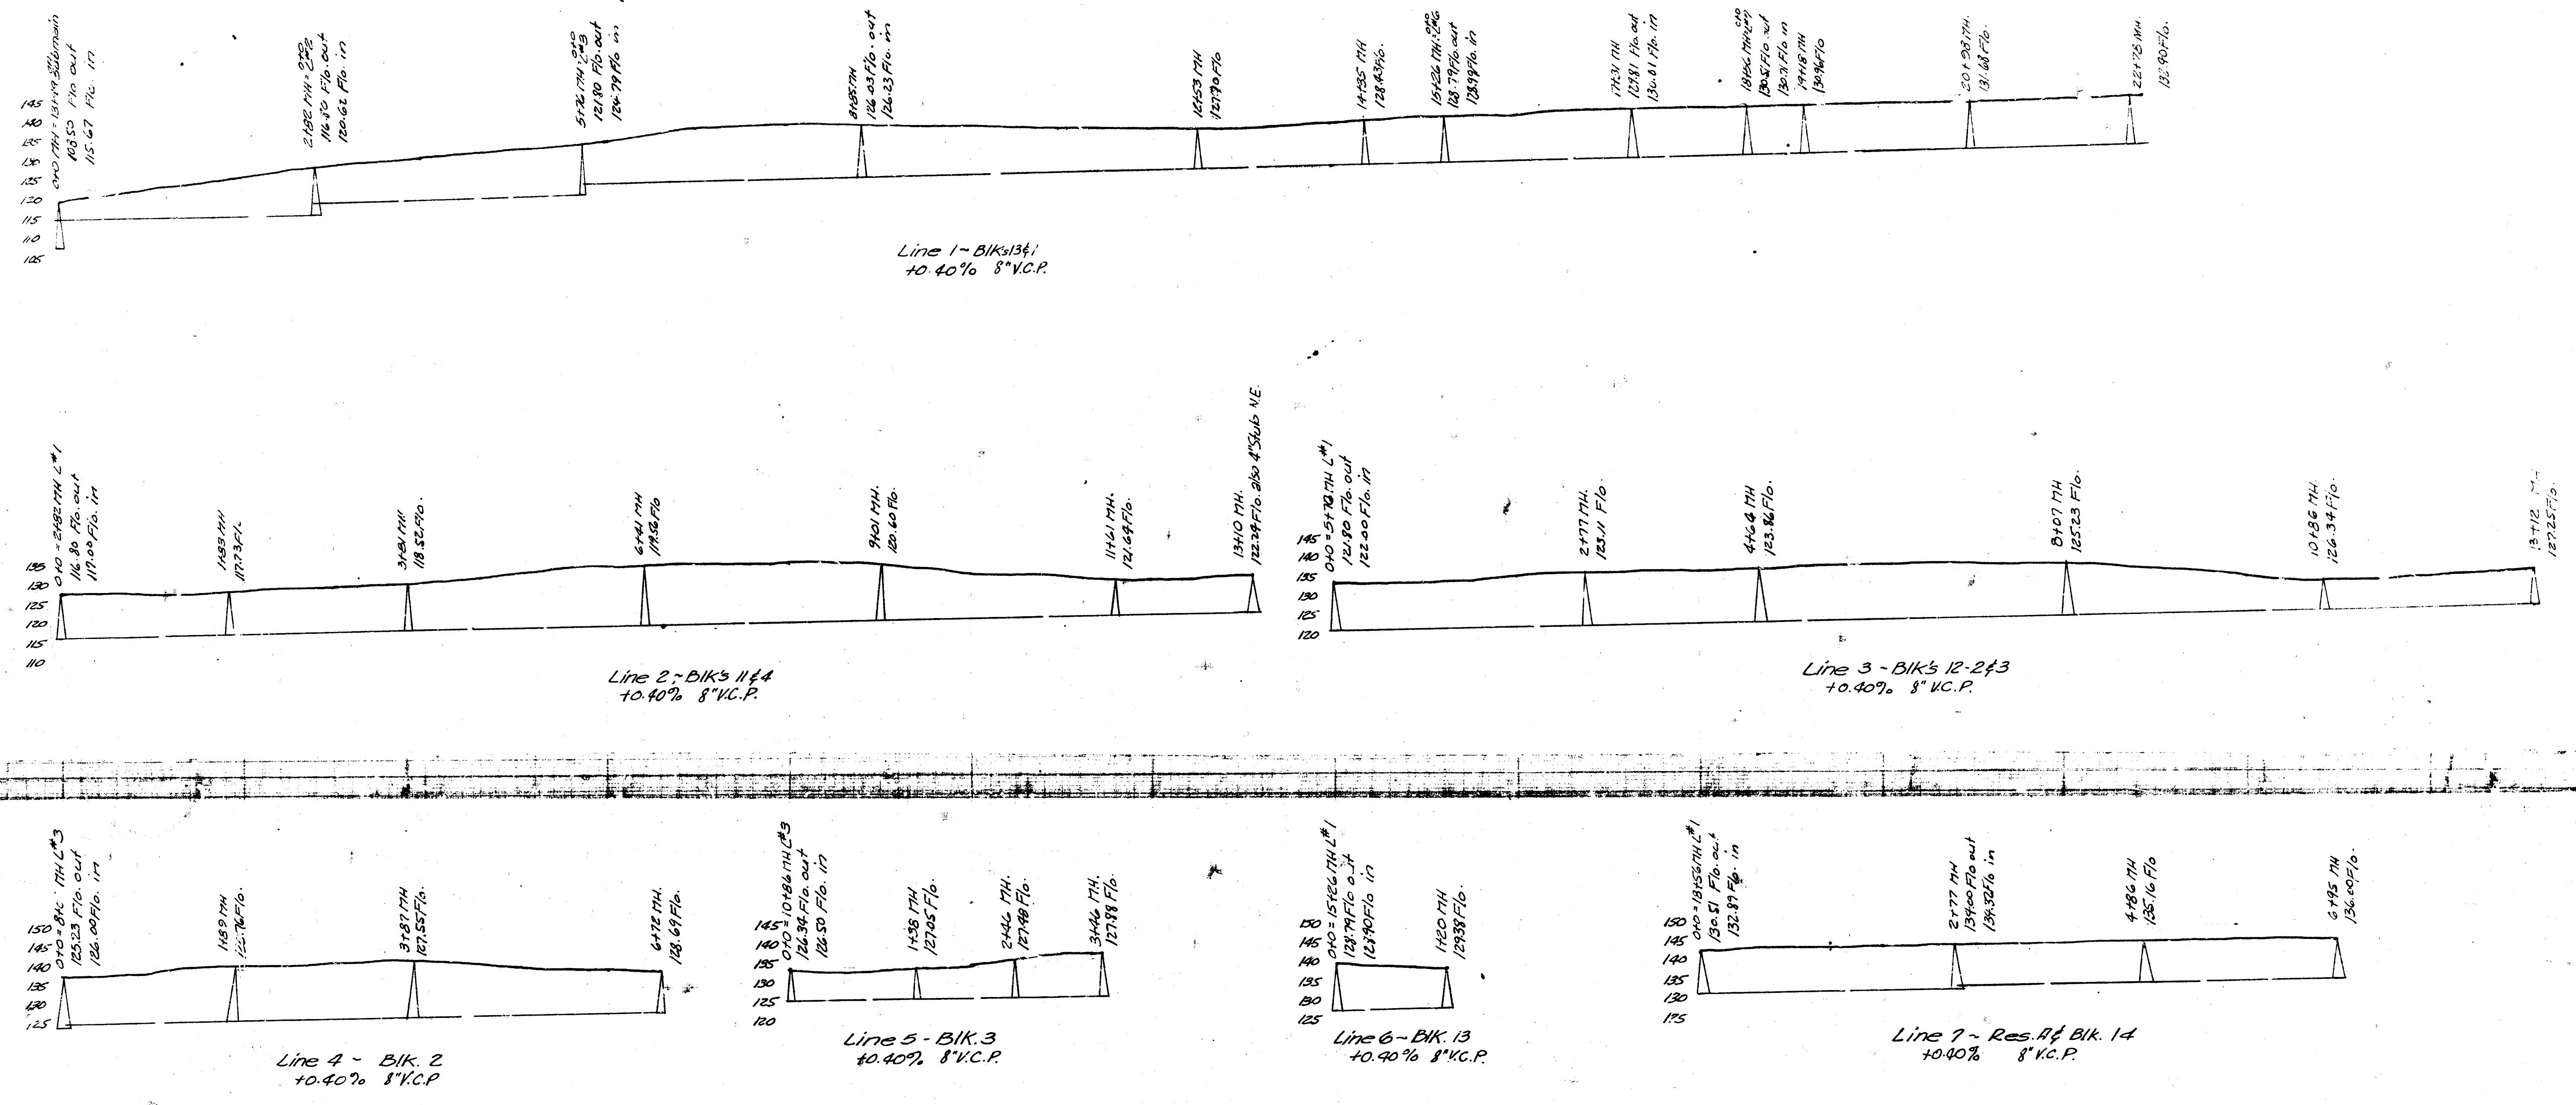

DETAIL OF TAMPED BACKFILL
Note -
Ditches over 13' in depth to be
tamped backfill

LAT. 8, SUBMAIN 1, WAR INDUSTRIES SEWER
CITY OF WICHITA KANSAS
L. K. WHITE - CITY ENGINEER
DATE: 4-6-51, PROJ. NO. C21-3

LAT. 5, DIST. 1, War Industries Sener.
PROFILE'S FOR EDGEWOOD ADDITION
City of Wichita, Kansas
L. K. White - City Engineer.
Date: 3-2-50 C 20-4

Hand-drawn signature
Hand-drawn date: 11-1-1950

SHT. 2/2