

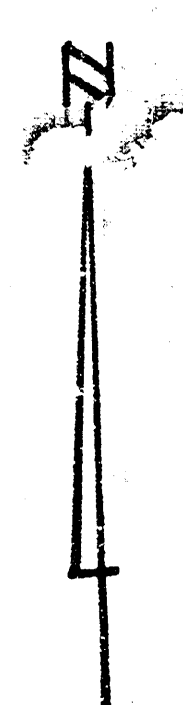


Dulles, Jr. & Co. Inc.
 Civil Engineers
 1000 N. 1st St.
 Kansas City, Mo. 64108

B.M. 154.85 Brass cap top E. end N. Hubgd. R.C.B. 1st E. Rock Rd. on Central
 B.M. 154.38 S. Rim San. Sewer M.H. @ N.W. cor. Lot 1, Blk. 2, Brookhollow 2nd Addn.
 B.M. 169.81 R.R. Spike N.E. Transformer Pole 25' east of Longford Ln. North on S.S. Central.

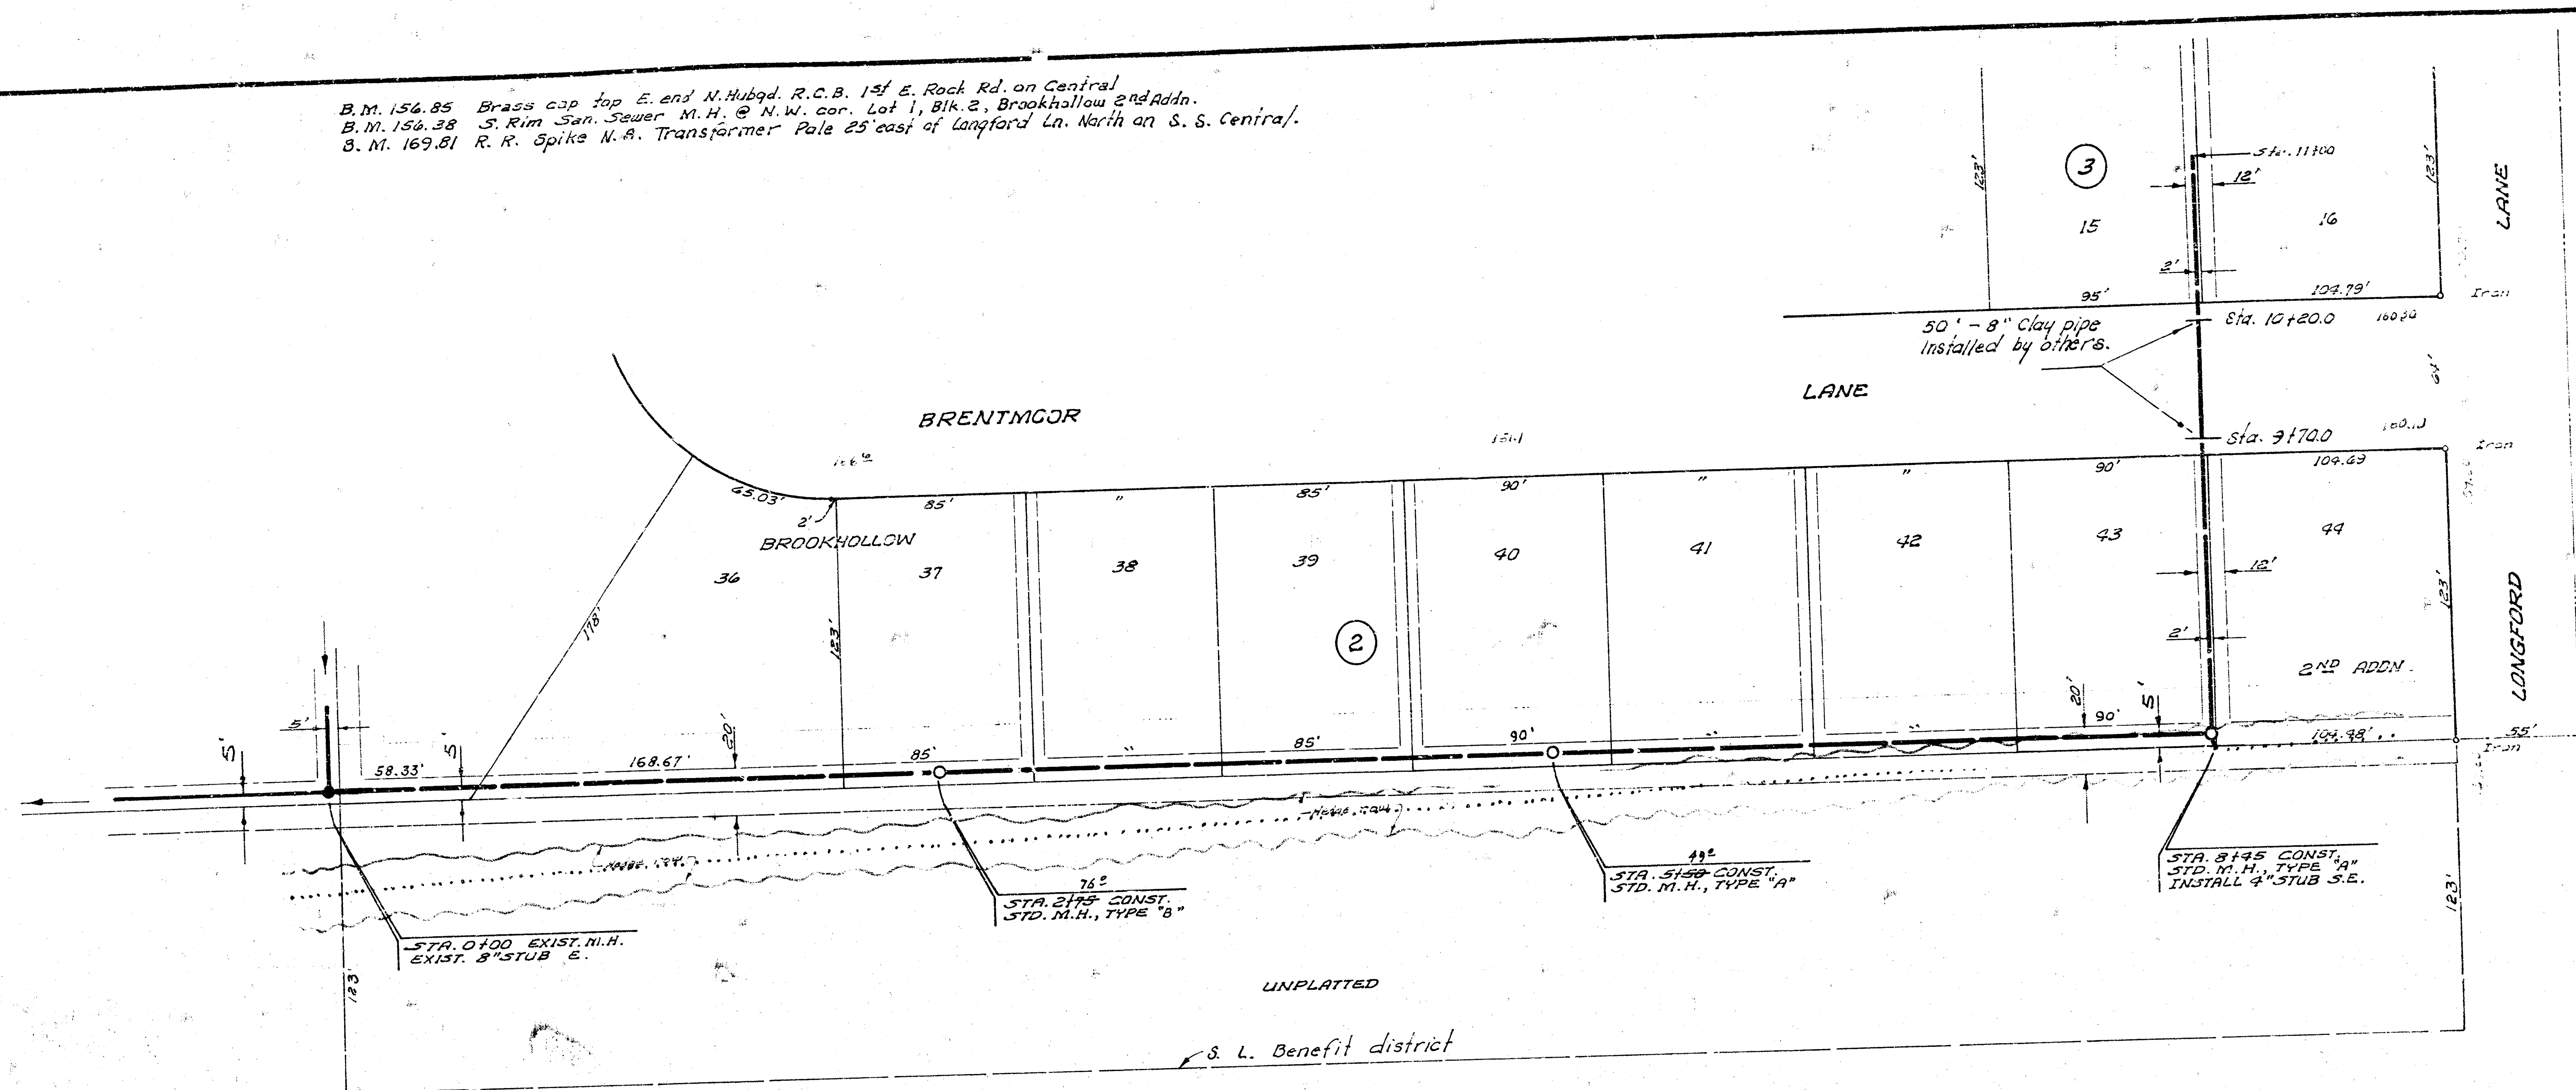

Plan Scale 1"=40'
 Profile Scale 1"=40' Hor.
 1"=4' Vert.

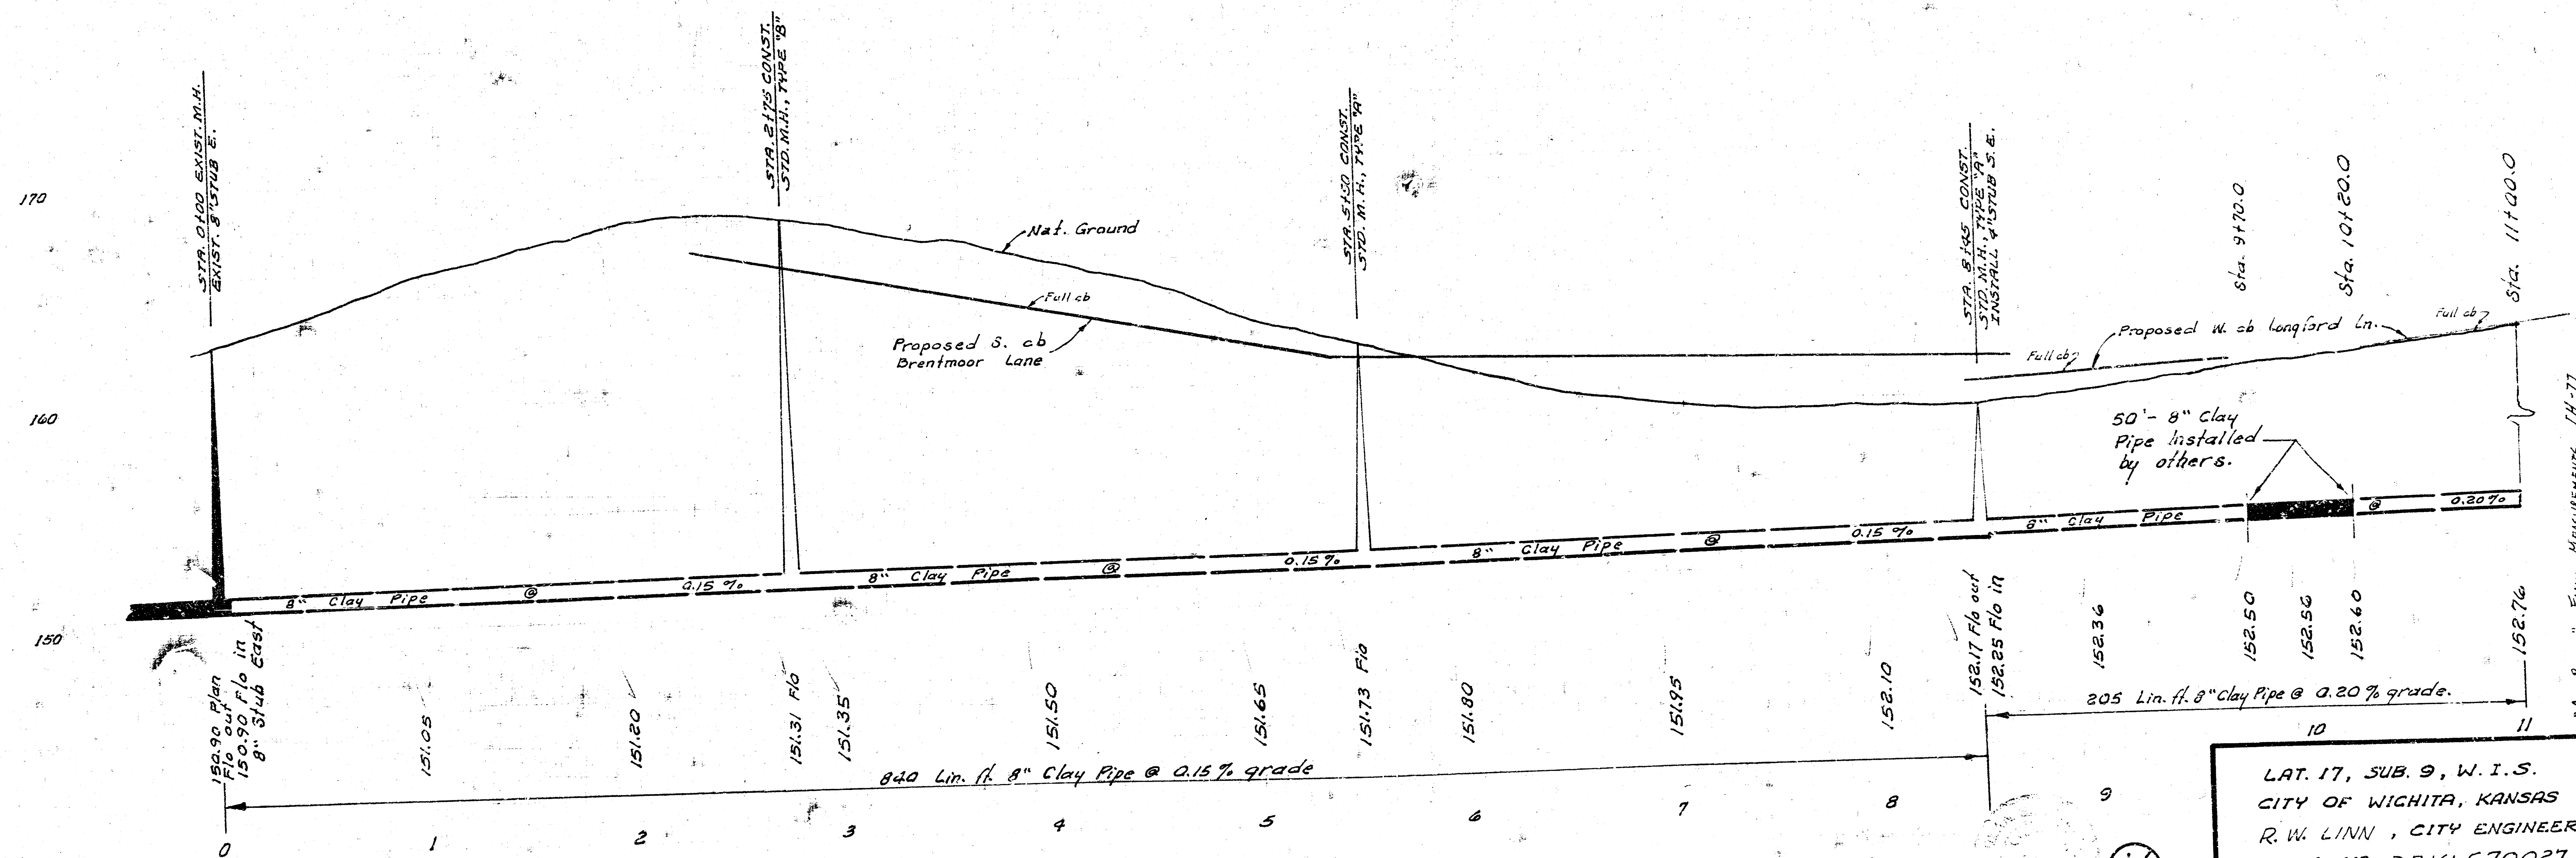

"As Built" Final Measurements 11-77

LAT. 17, SUB. 9, W. 1. S.
 CITY OF WICHITA, KANSAS
 R.W. LINN, CITY ENGINEER
 PROJ. NO. DBKLS70027
 DATE: NOV. 1972

