



B.M. 167.28 City Std. Central And W. Pkwy.  
 B.M. 163.36 "M" Muller Fire Hyd. @ #2 W. Pkwy.  
 B.M. 164.62 "M" Muller Fire Hyd. @ #6 W. Pkwy.  
 B.M. 157.21 Top Brick N.W. Cor. S. Light Brick Hubgd.  
 To Drive #8 W. Pkwy.

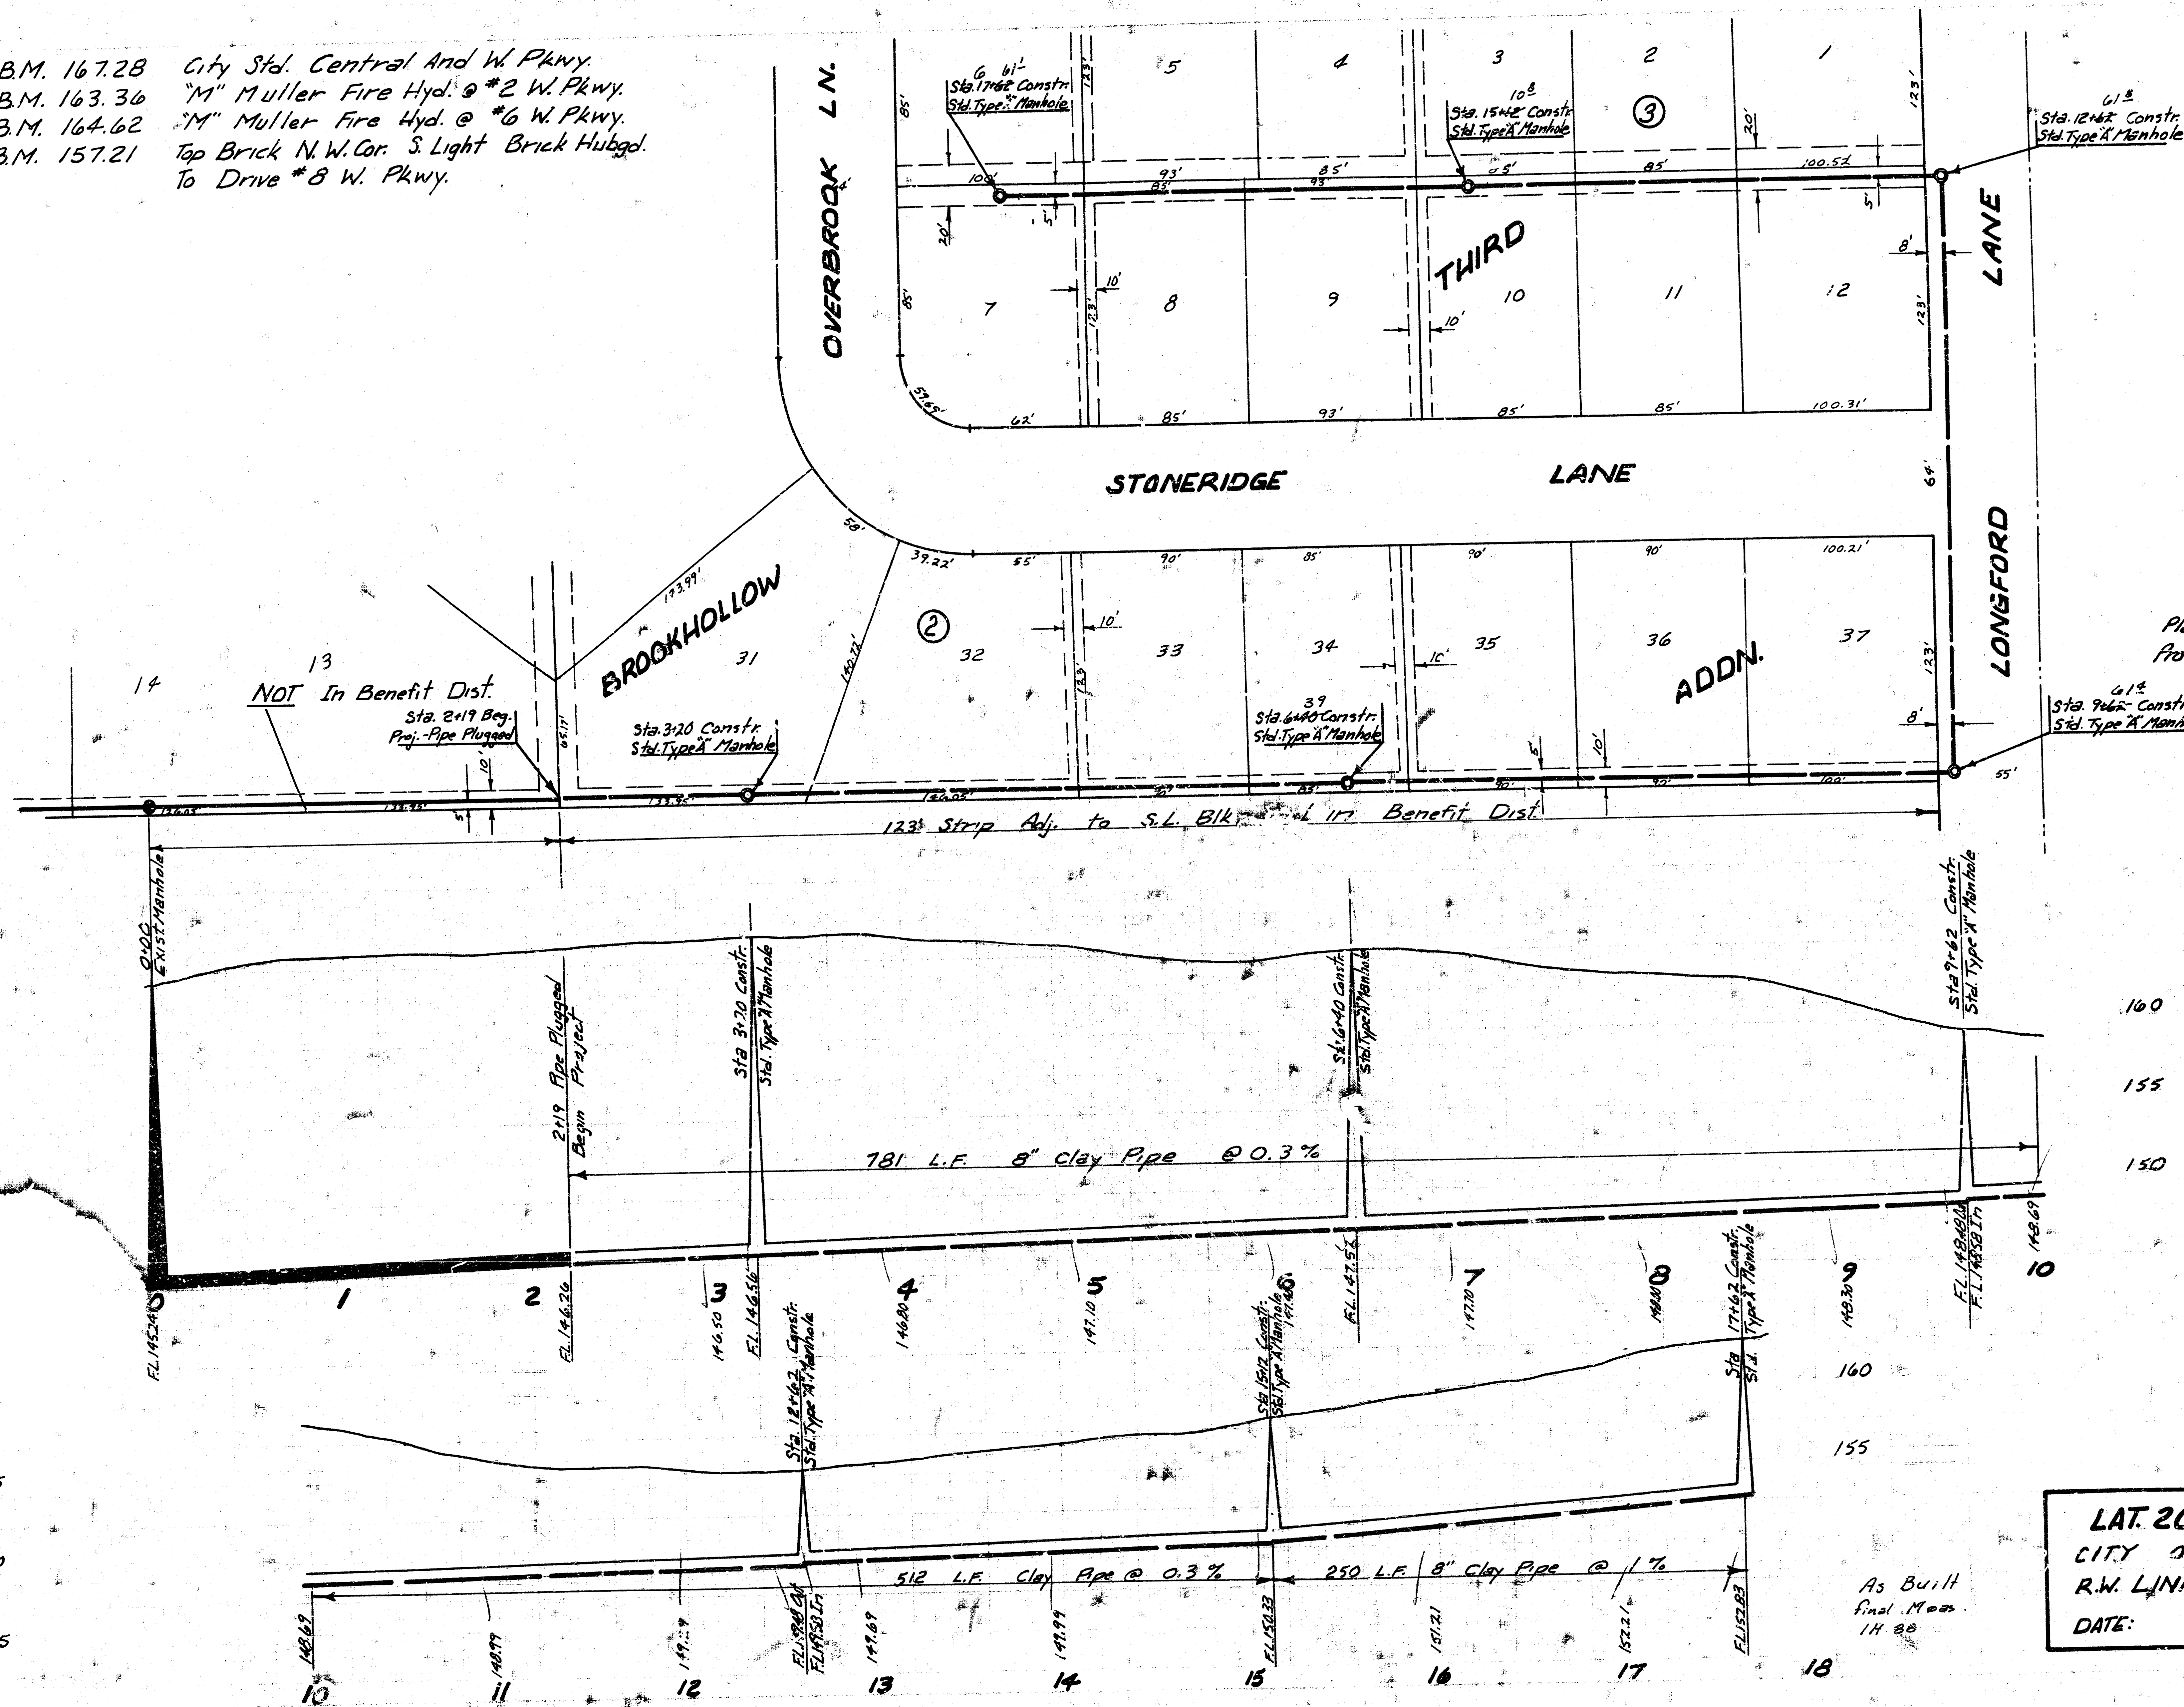

Plan Scale: 1" = 40'  
 Profile Scale: 1" = 40' Horiz.  
 1" = 5' Vert.

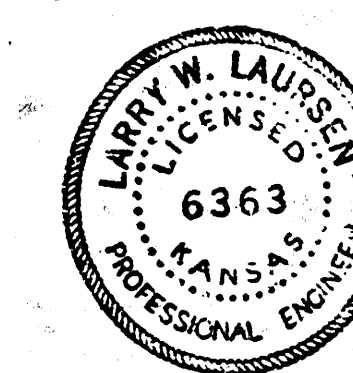

LAT. 20, MAIN 9, W.I.S.  
 CITY OF WICHITA, KS.  
 R.W. LINN - CITY ENGINEER  
 DATE: PROJ. NO. DBKL57304B

As Built  
 Final Meas.  
 14 88

FILMED FROM THE REAR