


B. M. 167.69 Rock Rd. & Central City B. M.
 a chiseled on S.E. cor. conc. valve
 box NW cor. intersection S. N. of N.
 cb on Central.

B. M. 156.23 set a chiseled on S.E. cor
 conc. pkg. lot behind Privy Shop
 366 Rock Rd.



Sta. 0100.0 Const.
 Std. M. H. Type "A"
 over exist. 12" S.S.

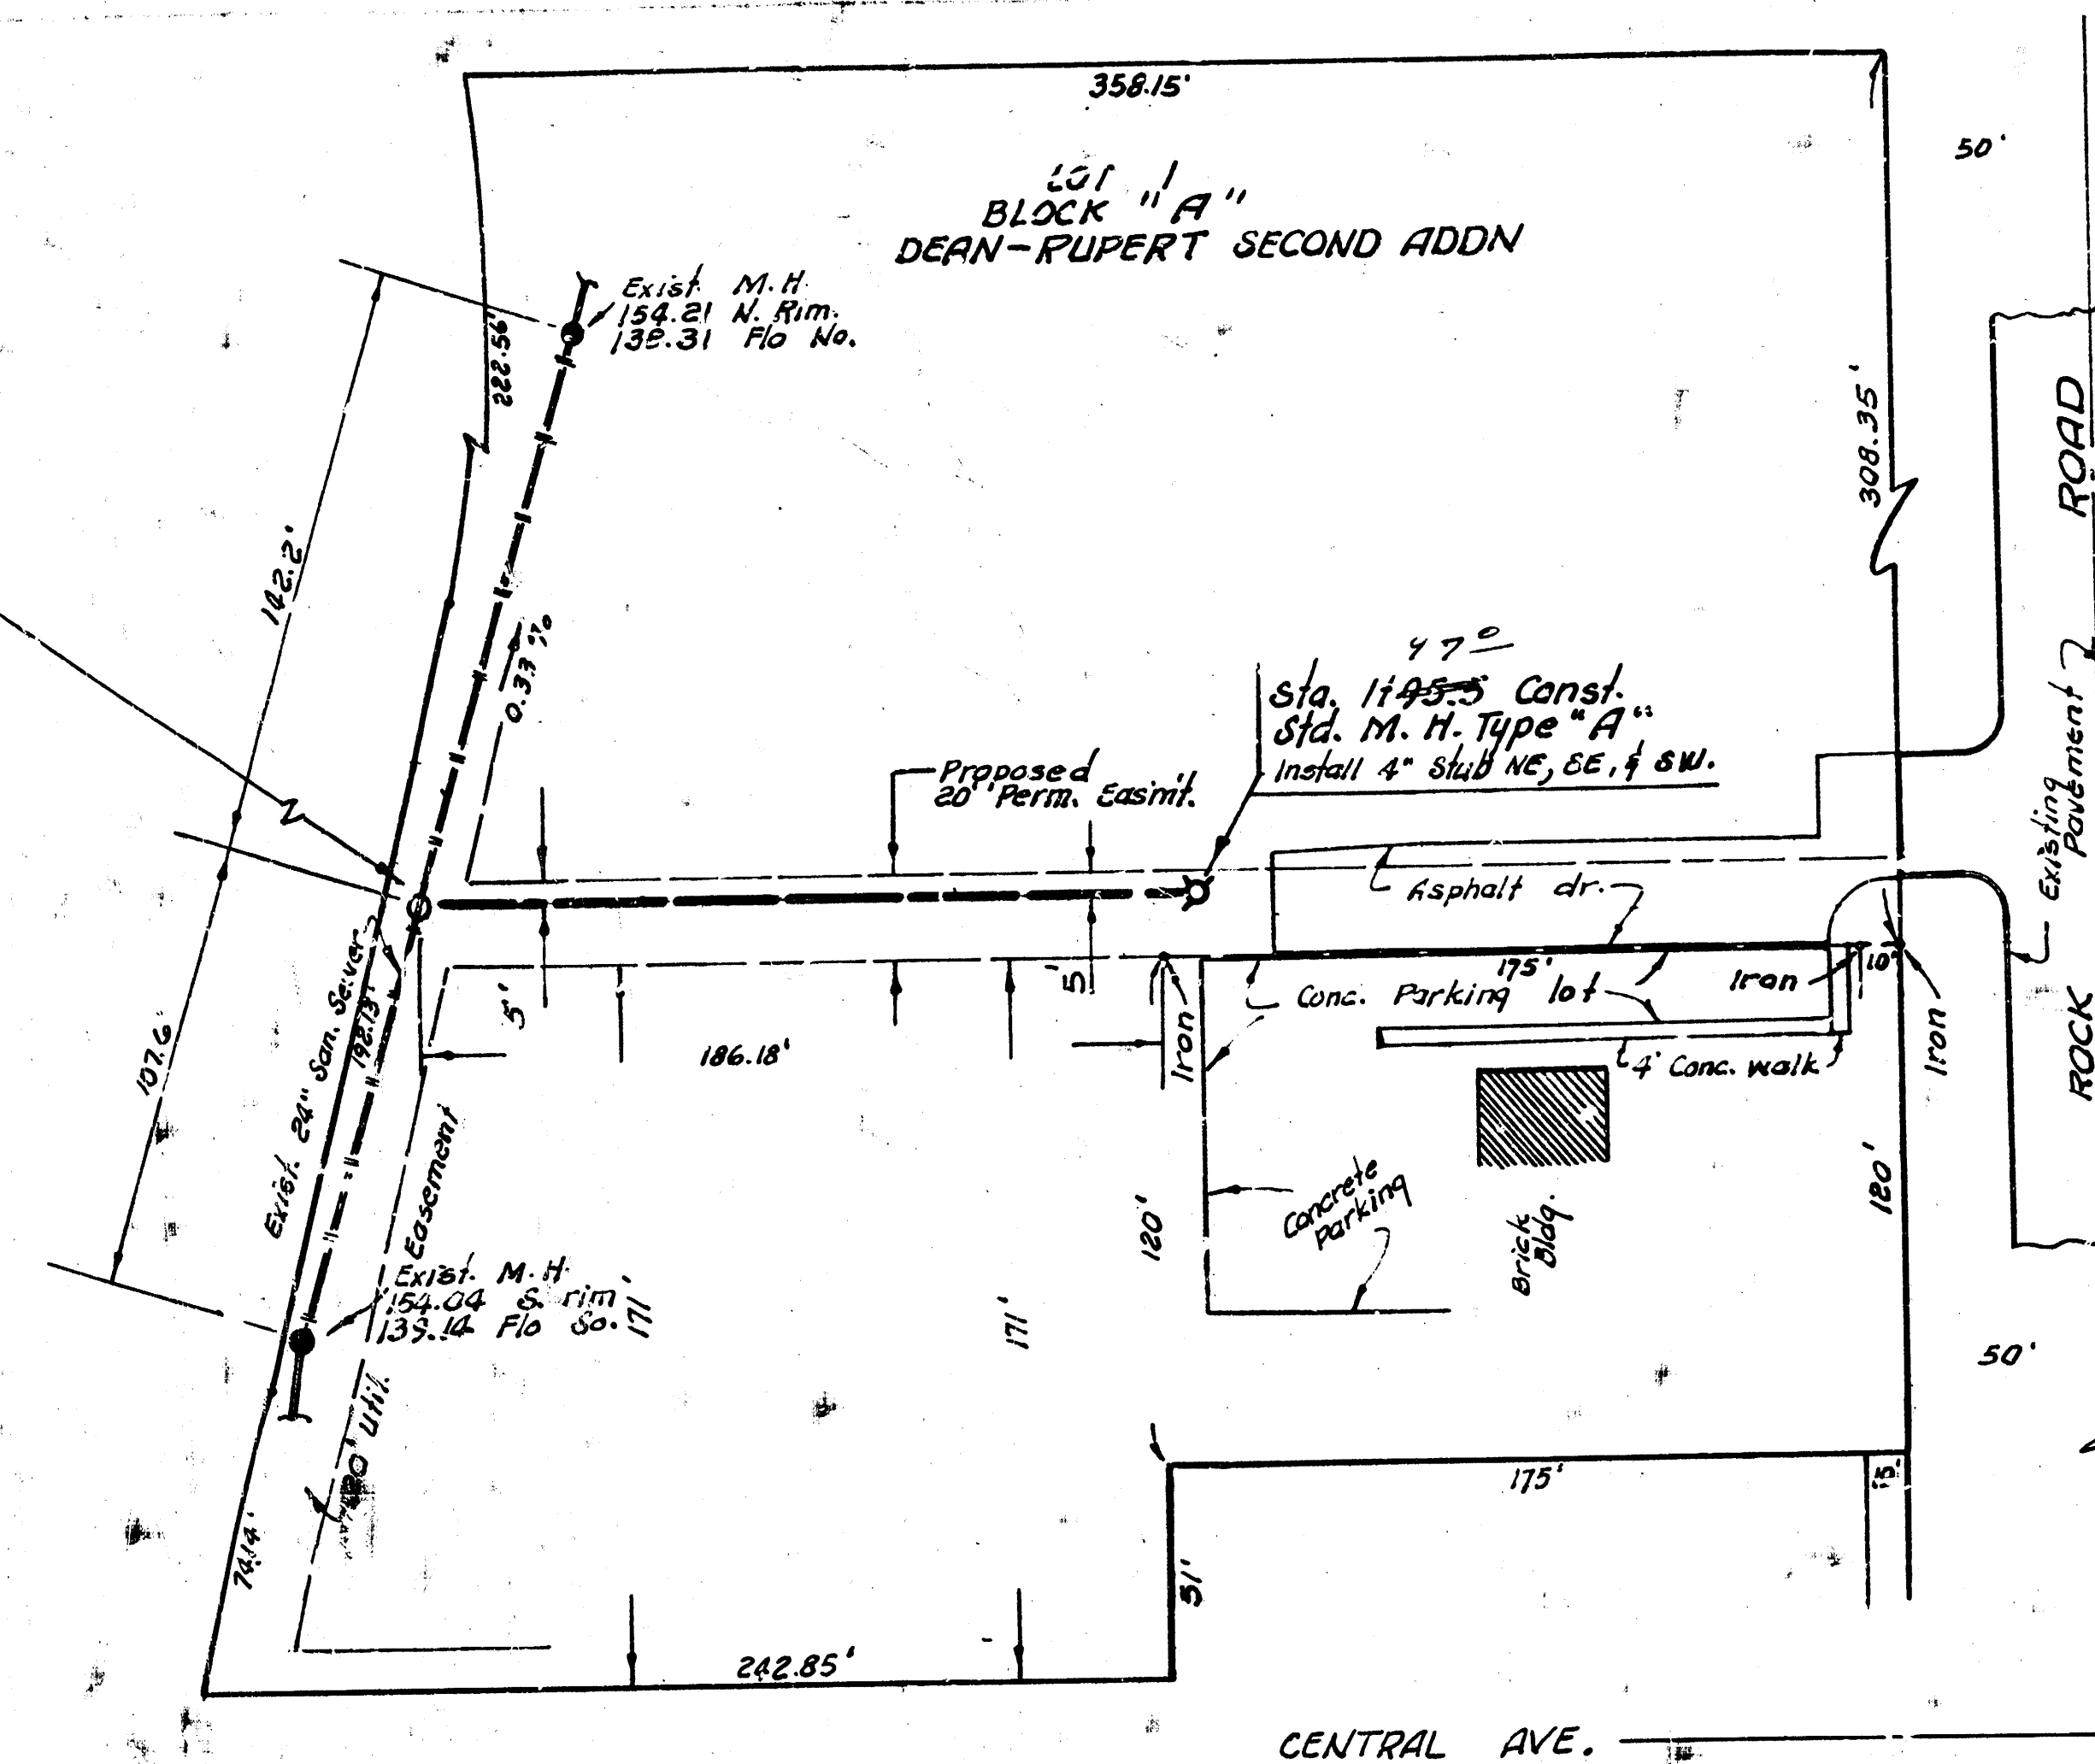

Plan Scale 1" = 40'
 Profile Scale 1" = 5' Vert.

Sta. 0100.0 Const.
 Std. M. H. Type "A"
 over exist. 12" S.S.

Sta. 1495.5 Const.
 Std. M. H. Type "A"
 install 4" slab NE, SE, & SW.

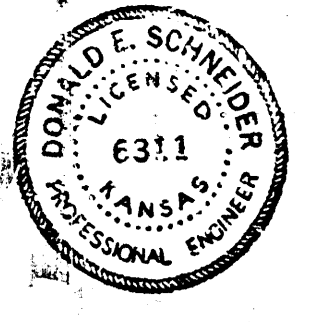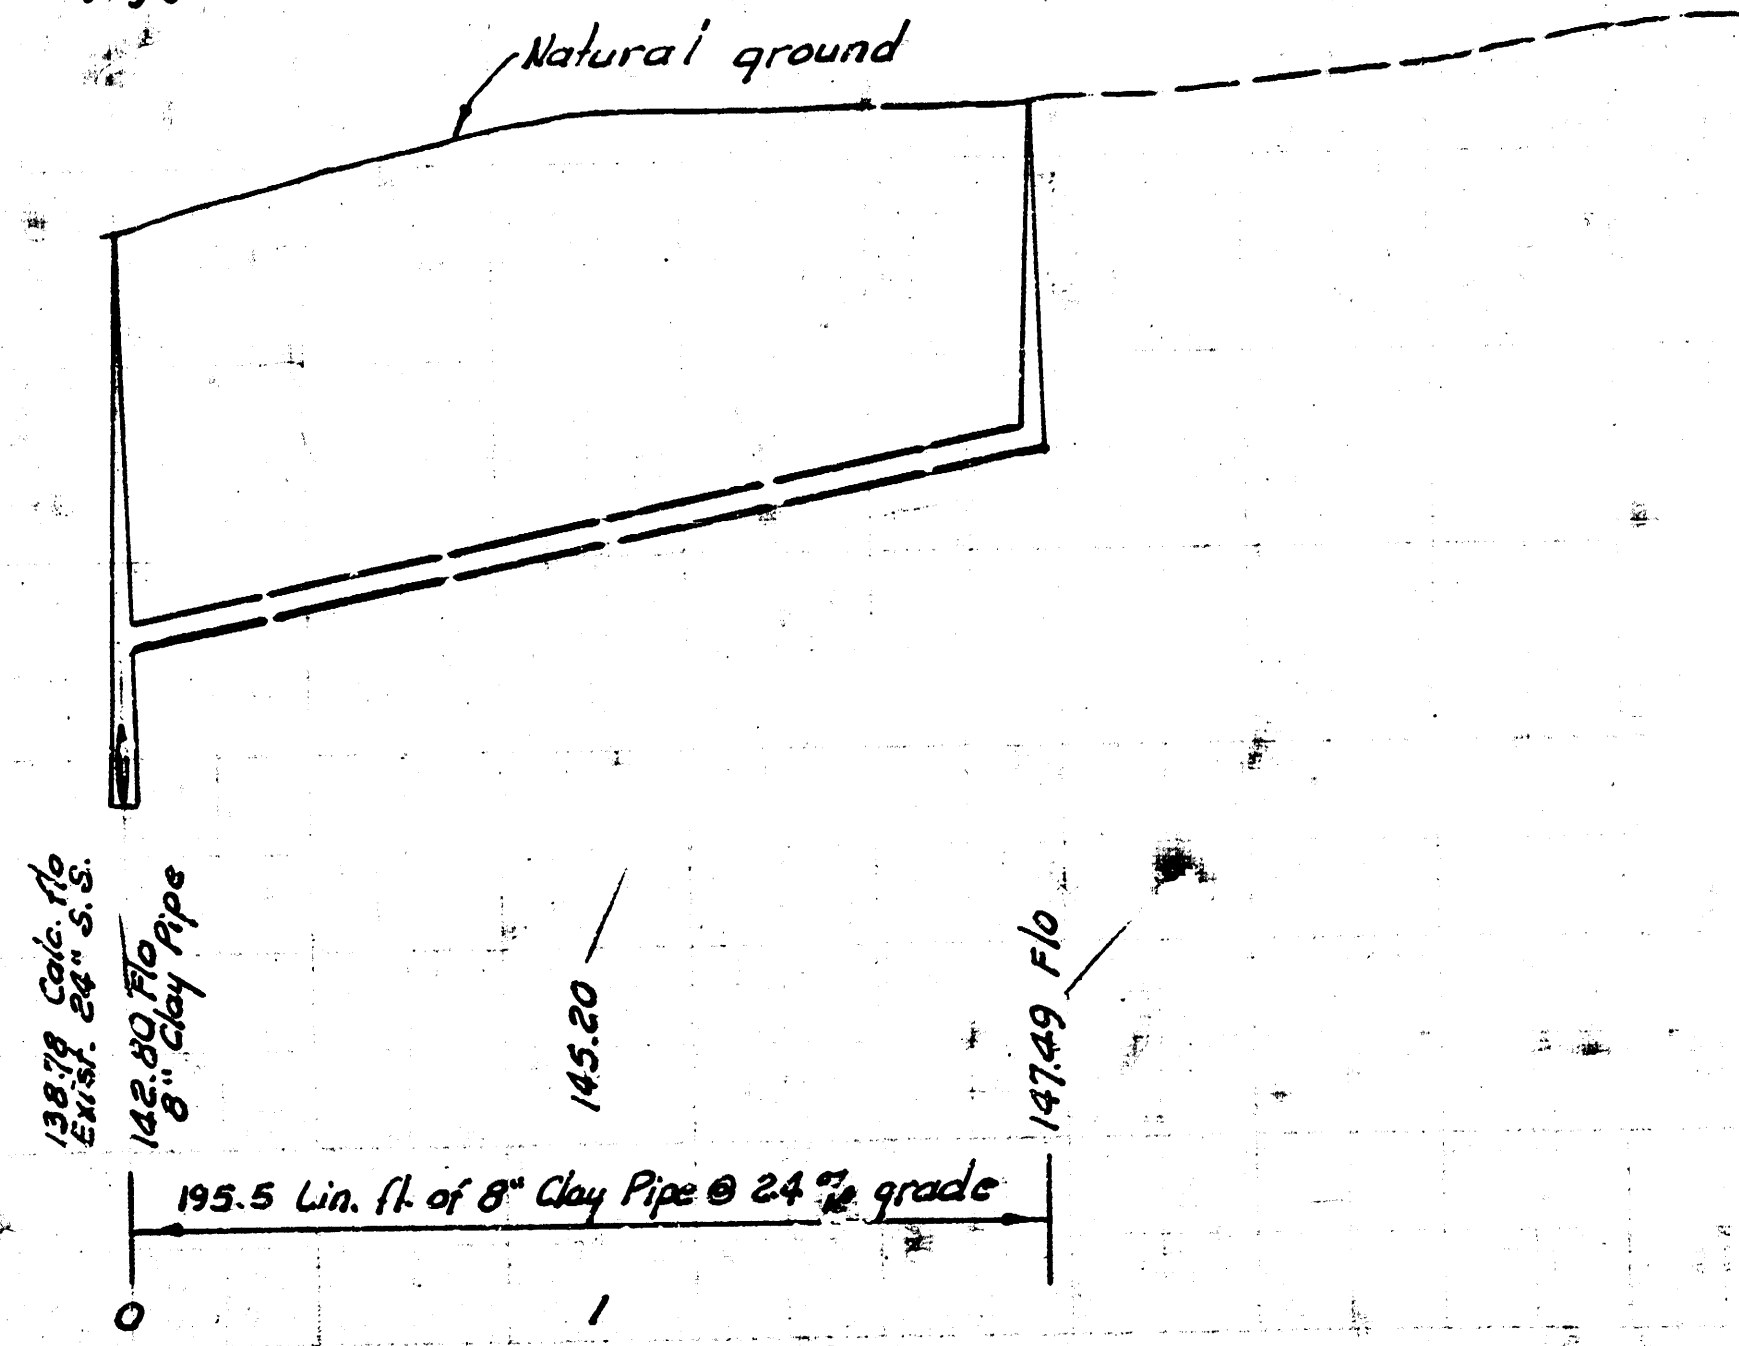

As Built Final Plans 7-1-75
 LAT. 22, MAIN 9, W. I. S.
 CITY OF WICHITA, KANSAS
 R. W. LINN — CITY ENGINEER
 MAR. 1974 PROJECT NO. DBKL574007

FILMED FROM THE BEST
 AVAILABLE COPY