


B. M. 167.69 Rock Rd. & Central City B. M.
 a chiseled on S.E. conc. conc. valve
 box NW cor. intersection S.N. of N.
 cb on Central.

B. M. 156.23 set a chiseled on S.E. cor
 conc. pkg. lot behind Privy Shop
 366 Rock Rd.



Sta. 0+00.0 Const.
 Std. M. H. Type "A"
 over Exis. 12" S.S.

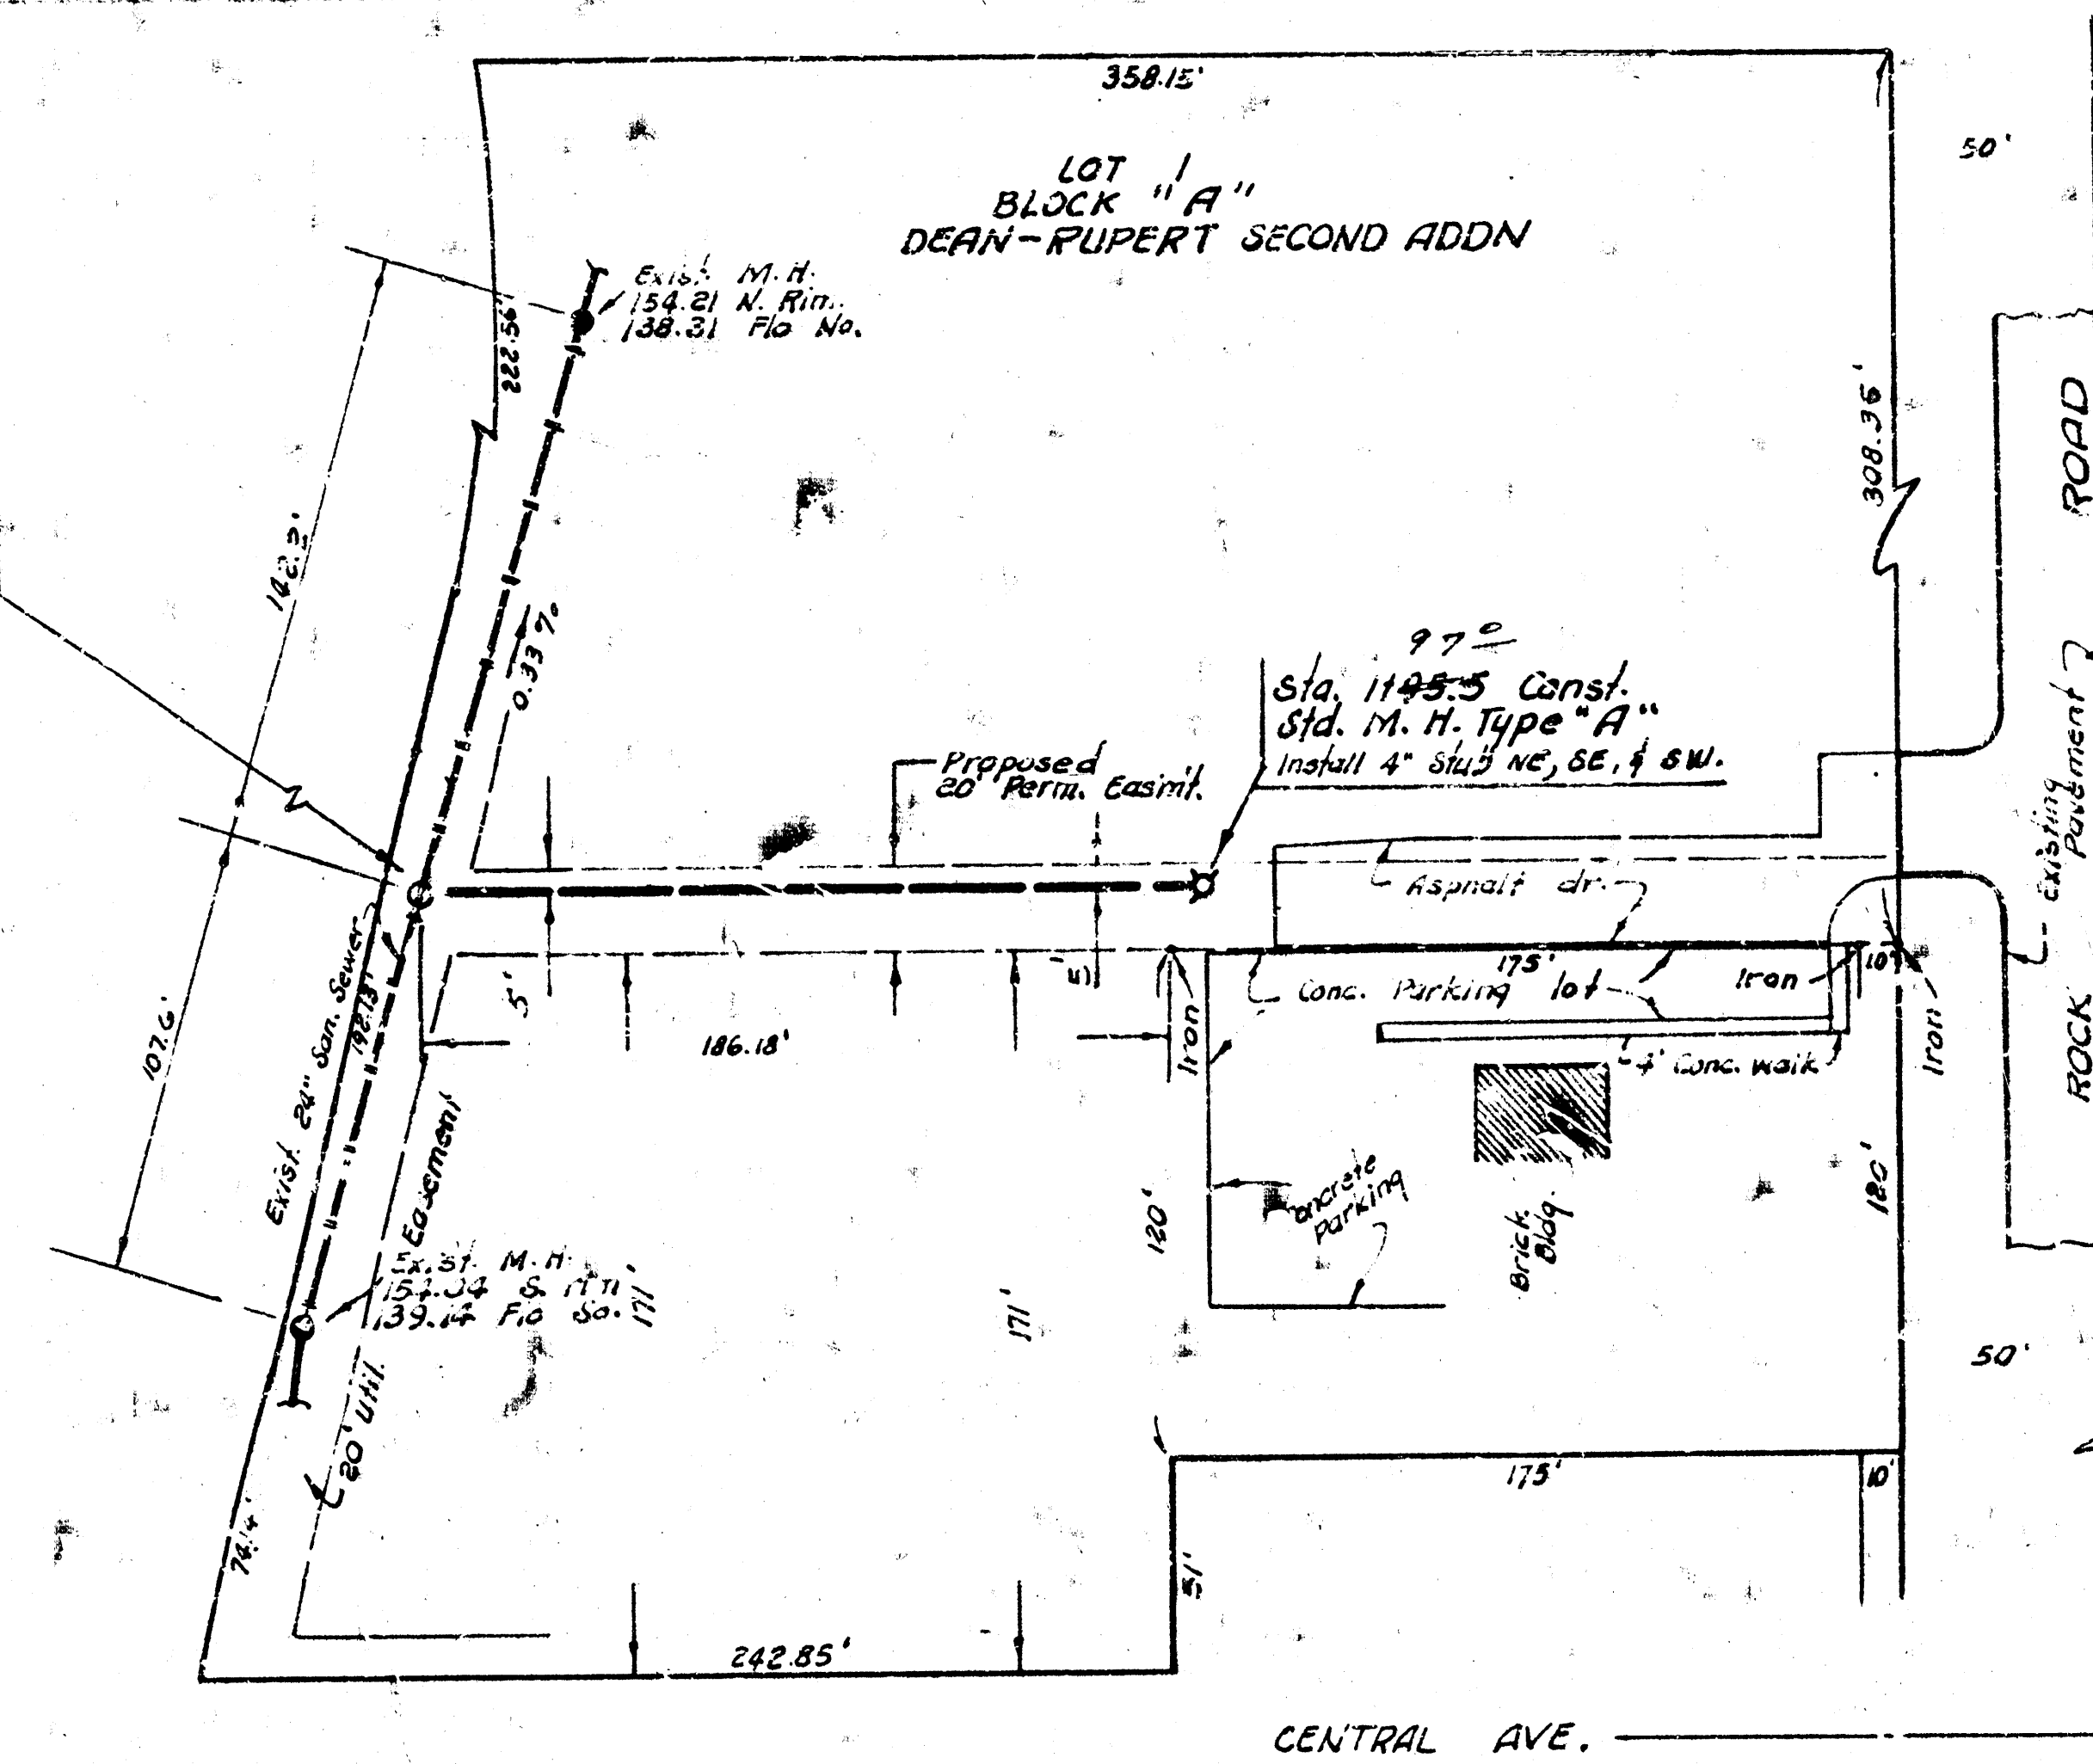

Plan Scale 1" = 40'
 Profile Scale 1" = 40' Horiz.
 1" = 5' Vert.

Sta. 0+00.0 Const.
 Std. M. H. Type "A"
 over Exis. 12" S.S.

Sta. 1+95.5 Const.
 Std. M. H. Type "A"
 Install 4" S.S. 12" S.S. & SW.

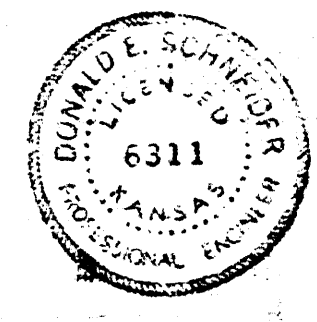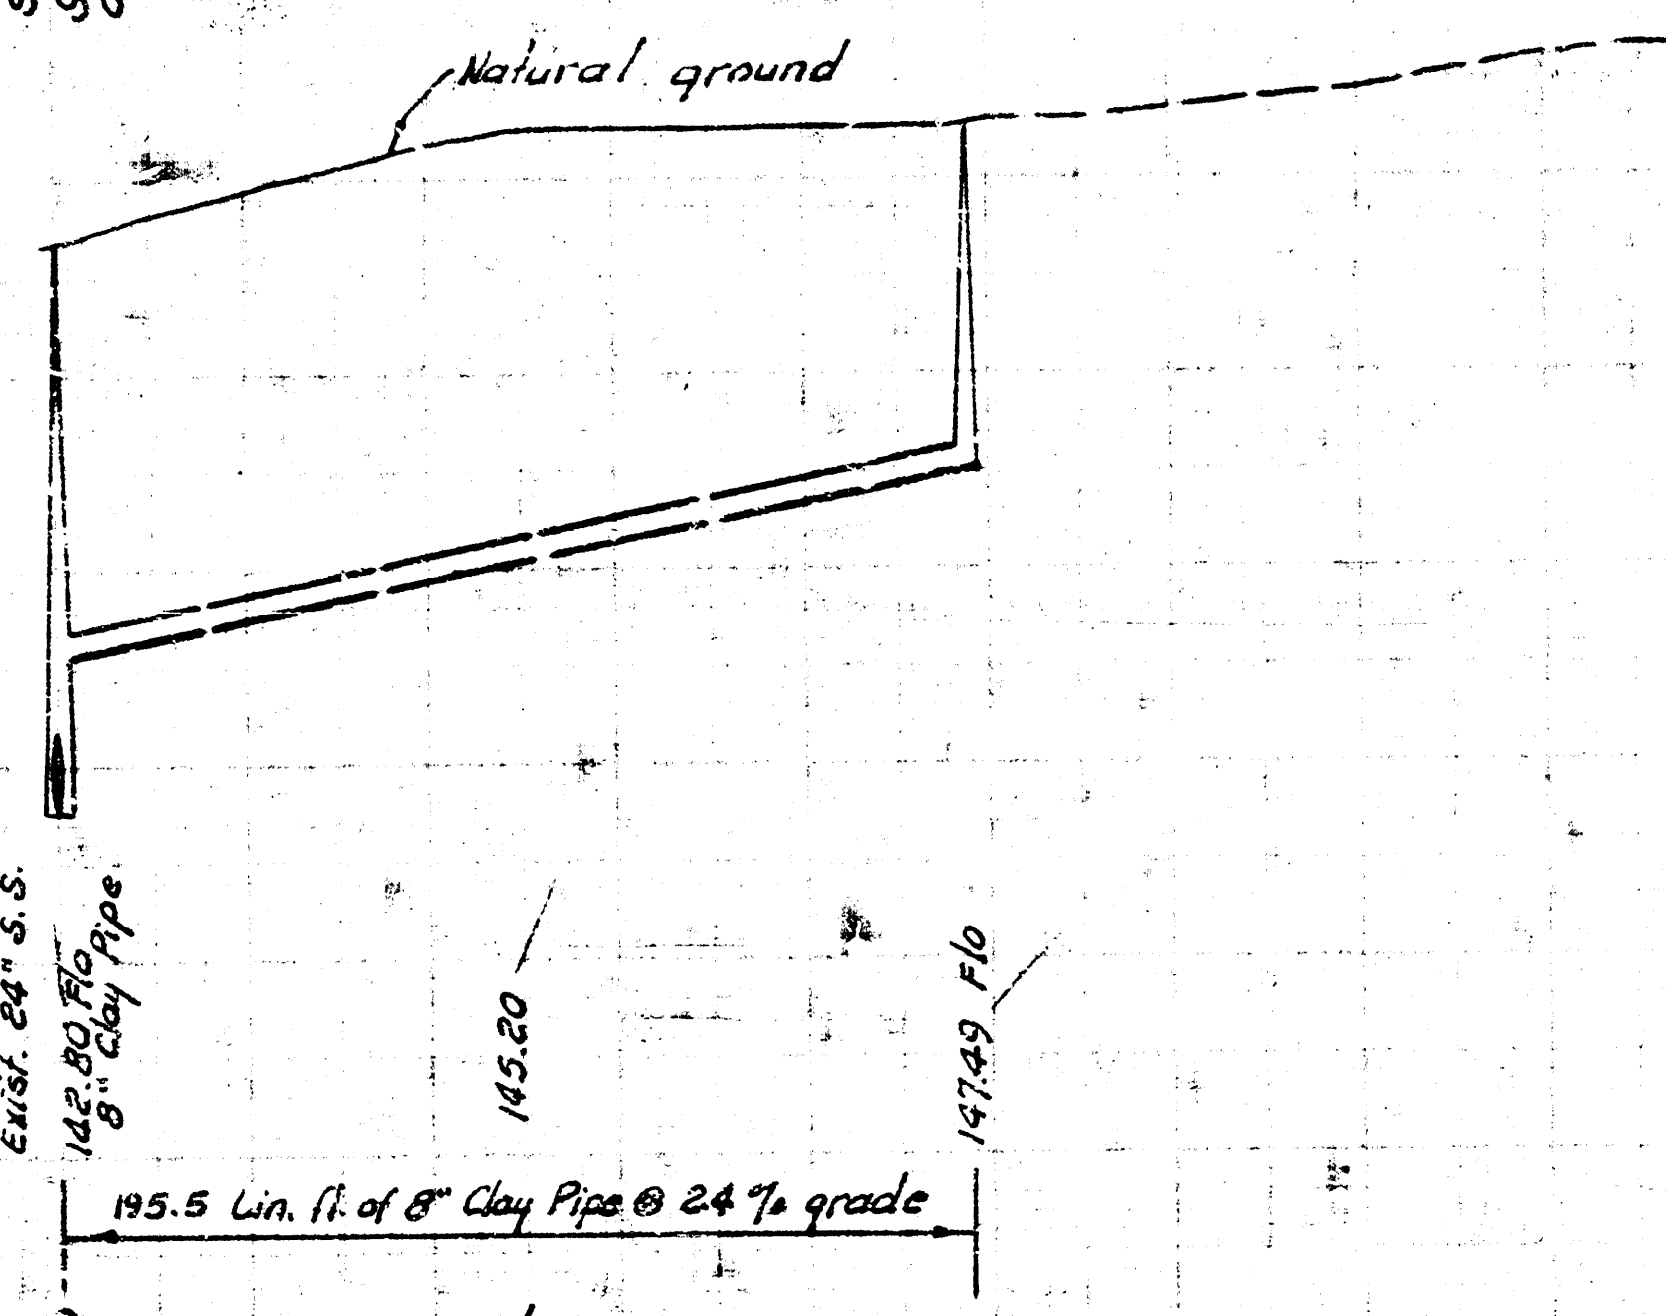

As Built Final Plans JH-25
 LAT. 22, MAIN 9, W. 1. S.
 CITY OF WICHITA, KANSAS
 R. W. LINN — CITY ENGINEER
 MAR. 1974 PROJECT NO. DBKL574-007