



BM 172.90 City Std. at George Wash. Blvd. & 31st St. South
 BM 141.94 R.R. spike W. side large Elm Tree, W. Side Geo. Wash. Blvd.
 Approx. 220' N. of N. Line of New Jersey Dr.
 BM 134.13 "x" cut on SE cor. conc. Patio, at NE Cor. Brick Apt.
 Bldg. No. 2904 Bunker Hill Dr.

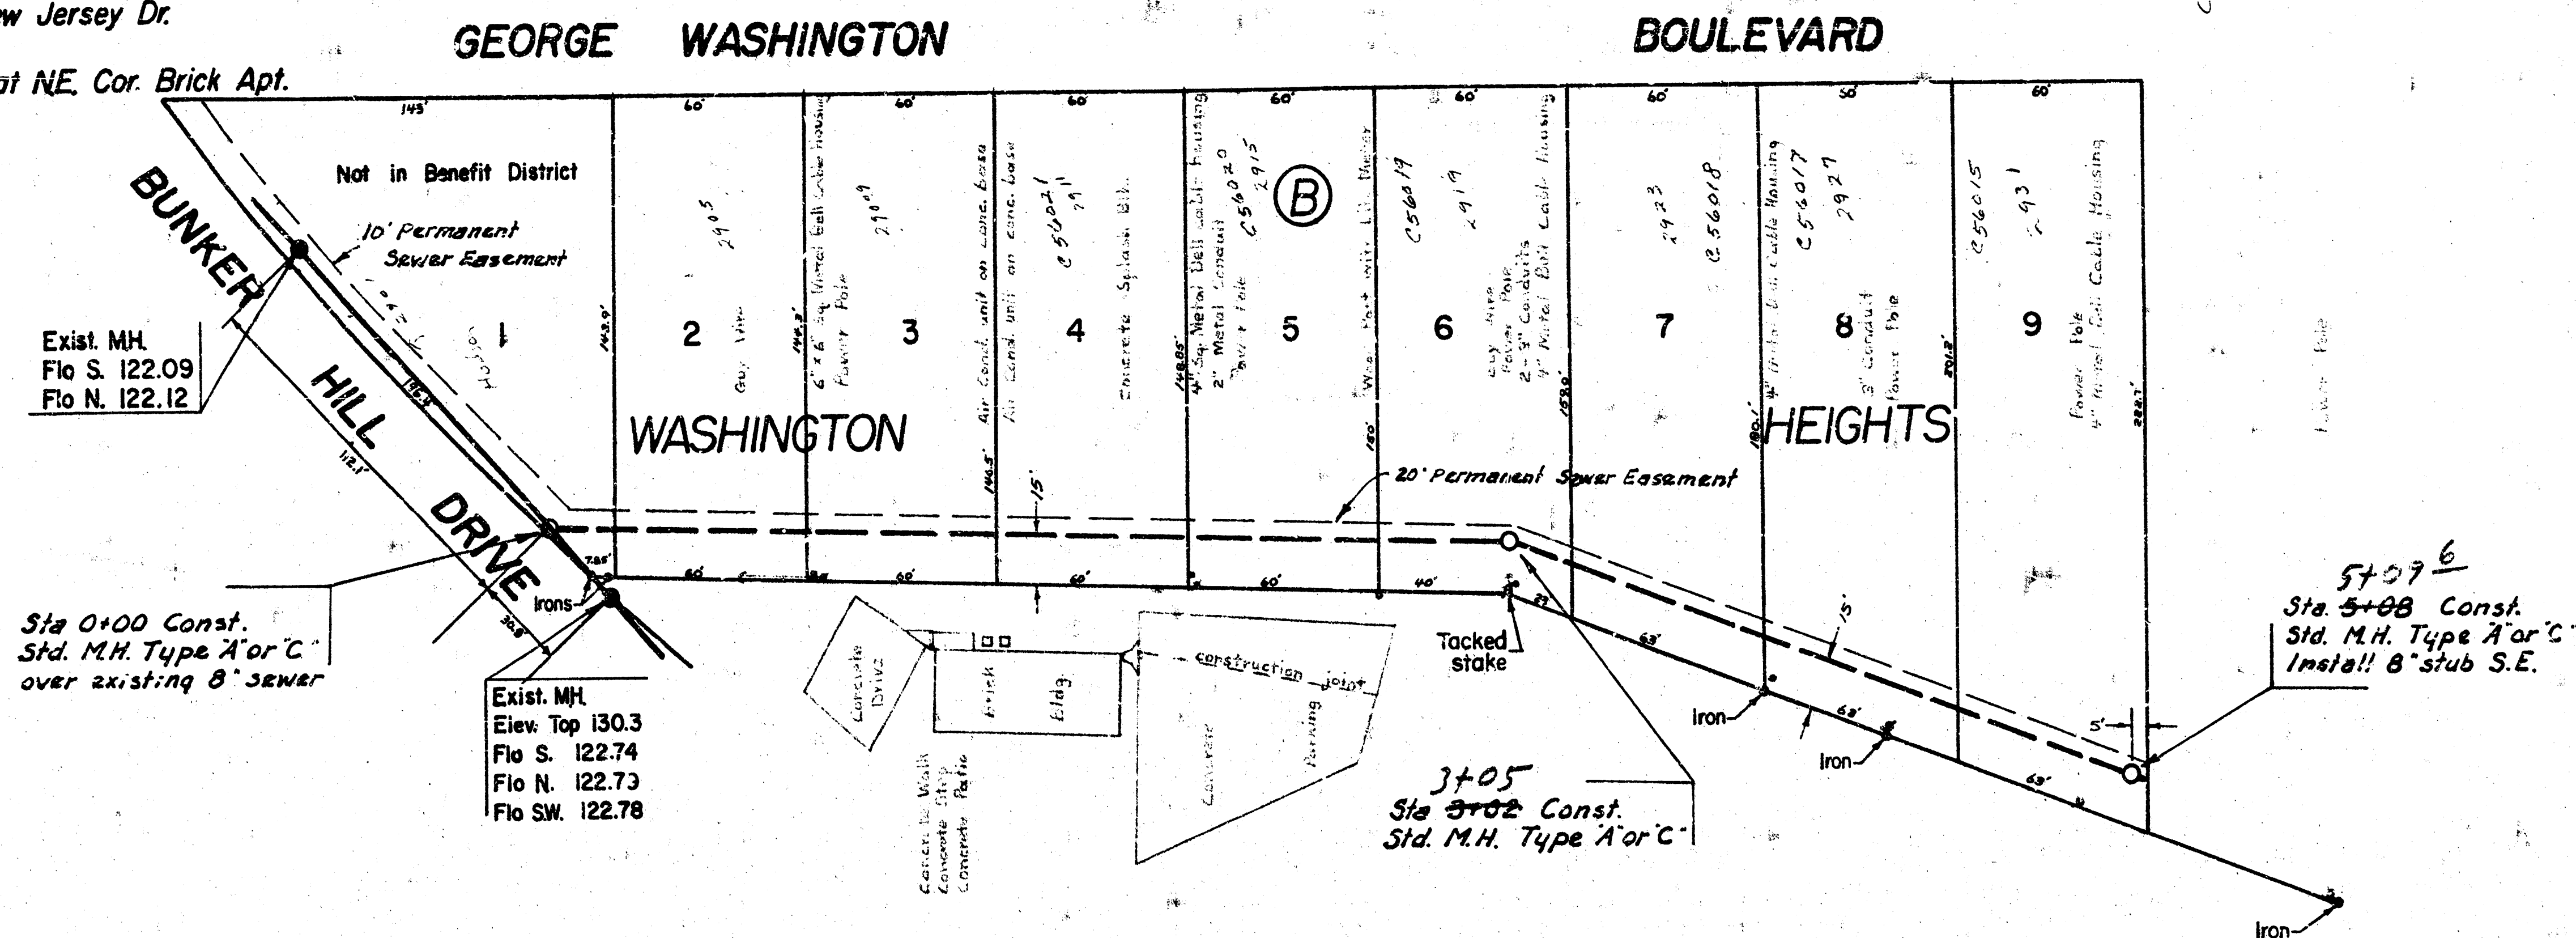

Plan Scale 1" = 40'
 Profile Scale 1" = 40' Horz.
 1" = 5' Vert.

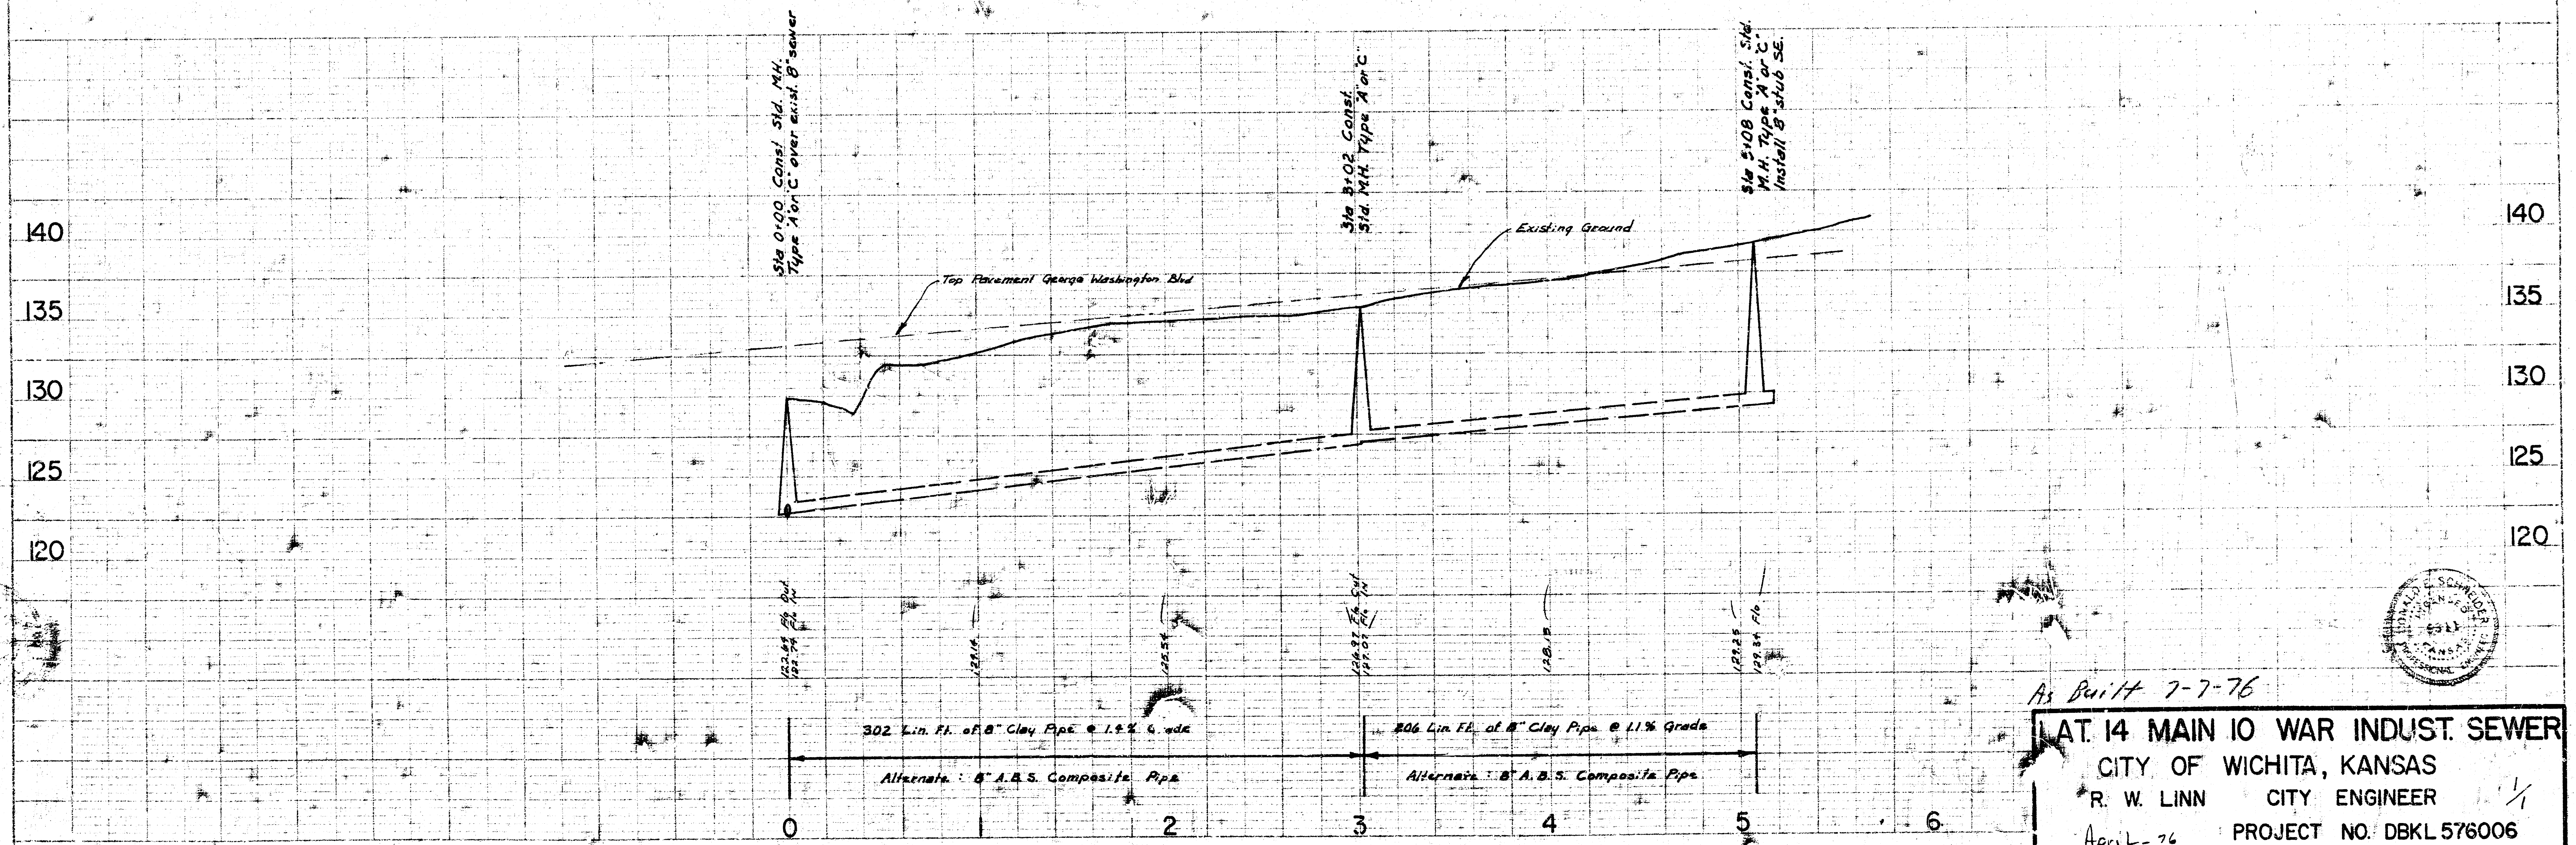

As Built 7-7-76

LAT. 14 MAIN IO WAR INDUST. SEWER
 CITY OF WICHITA, KANSAS
 R. W. LINN CITY ENGINEER
 April-76 PROJECT NO. DBKL 576006