

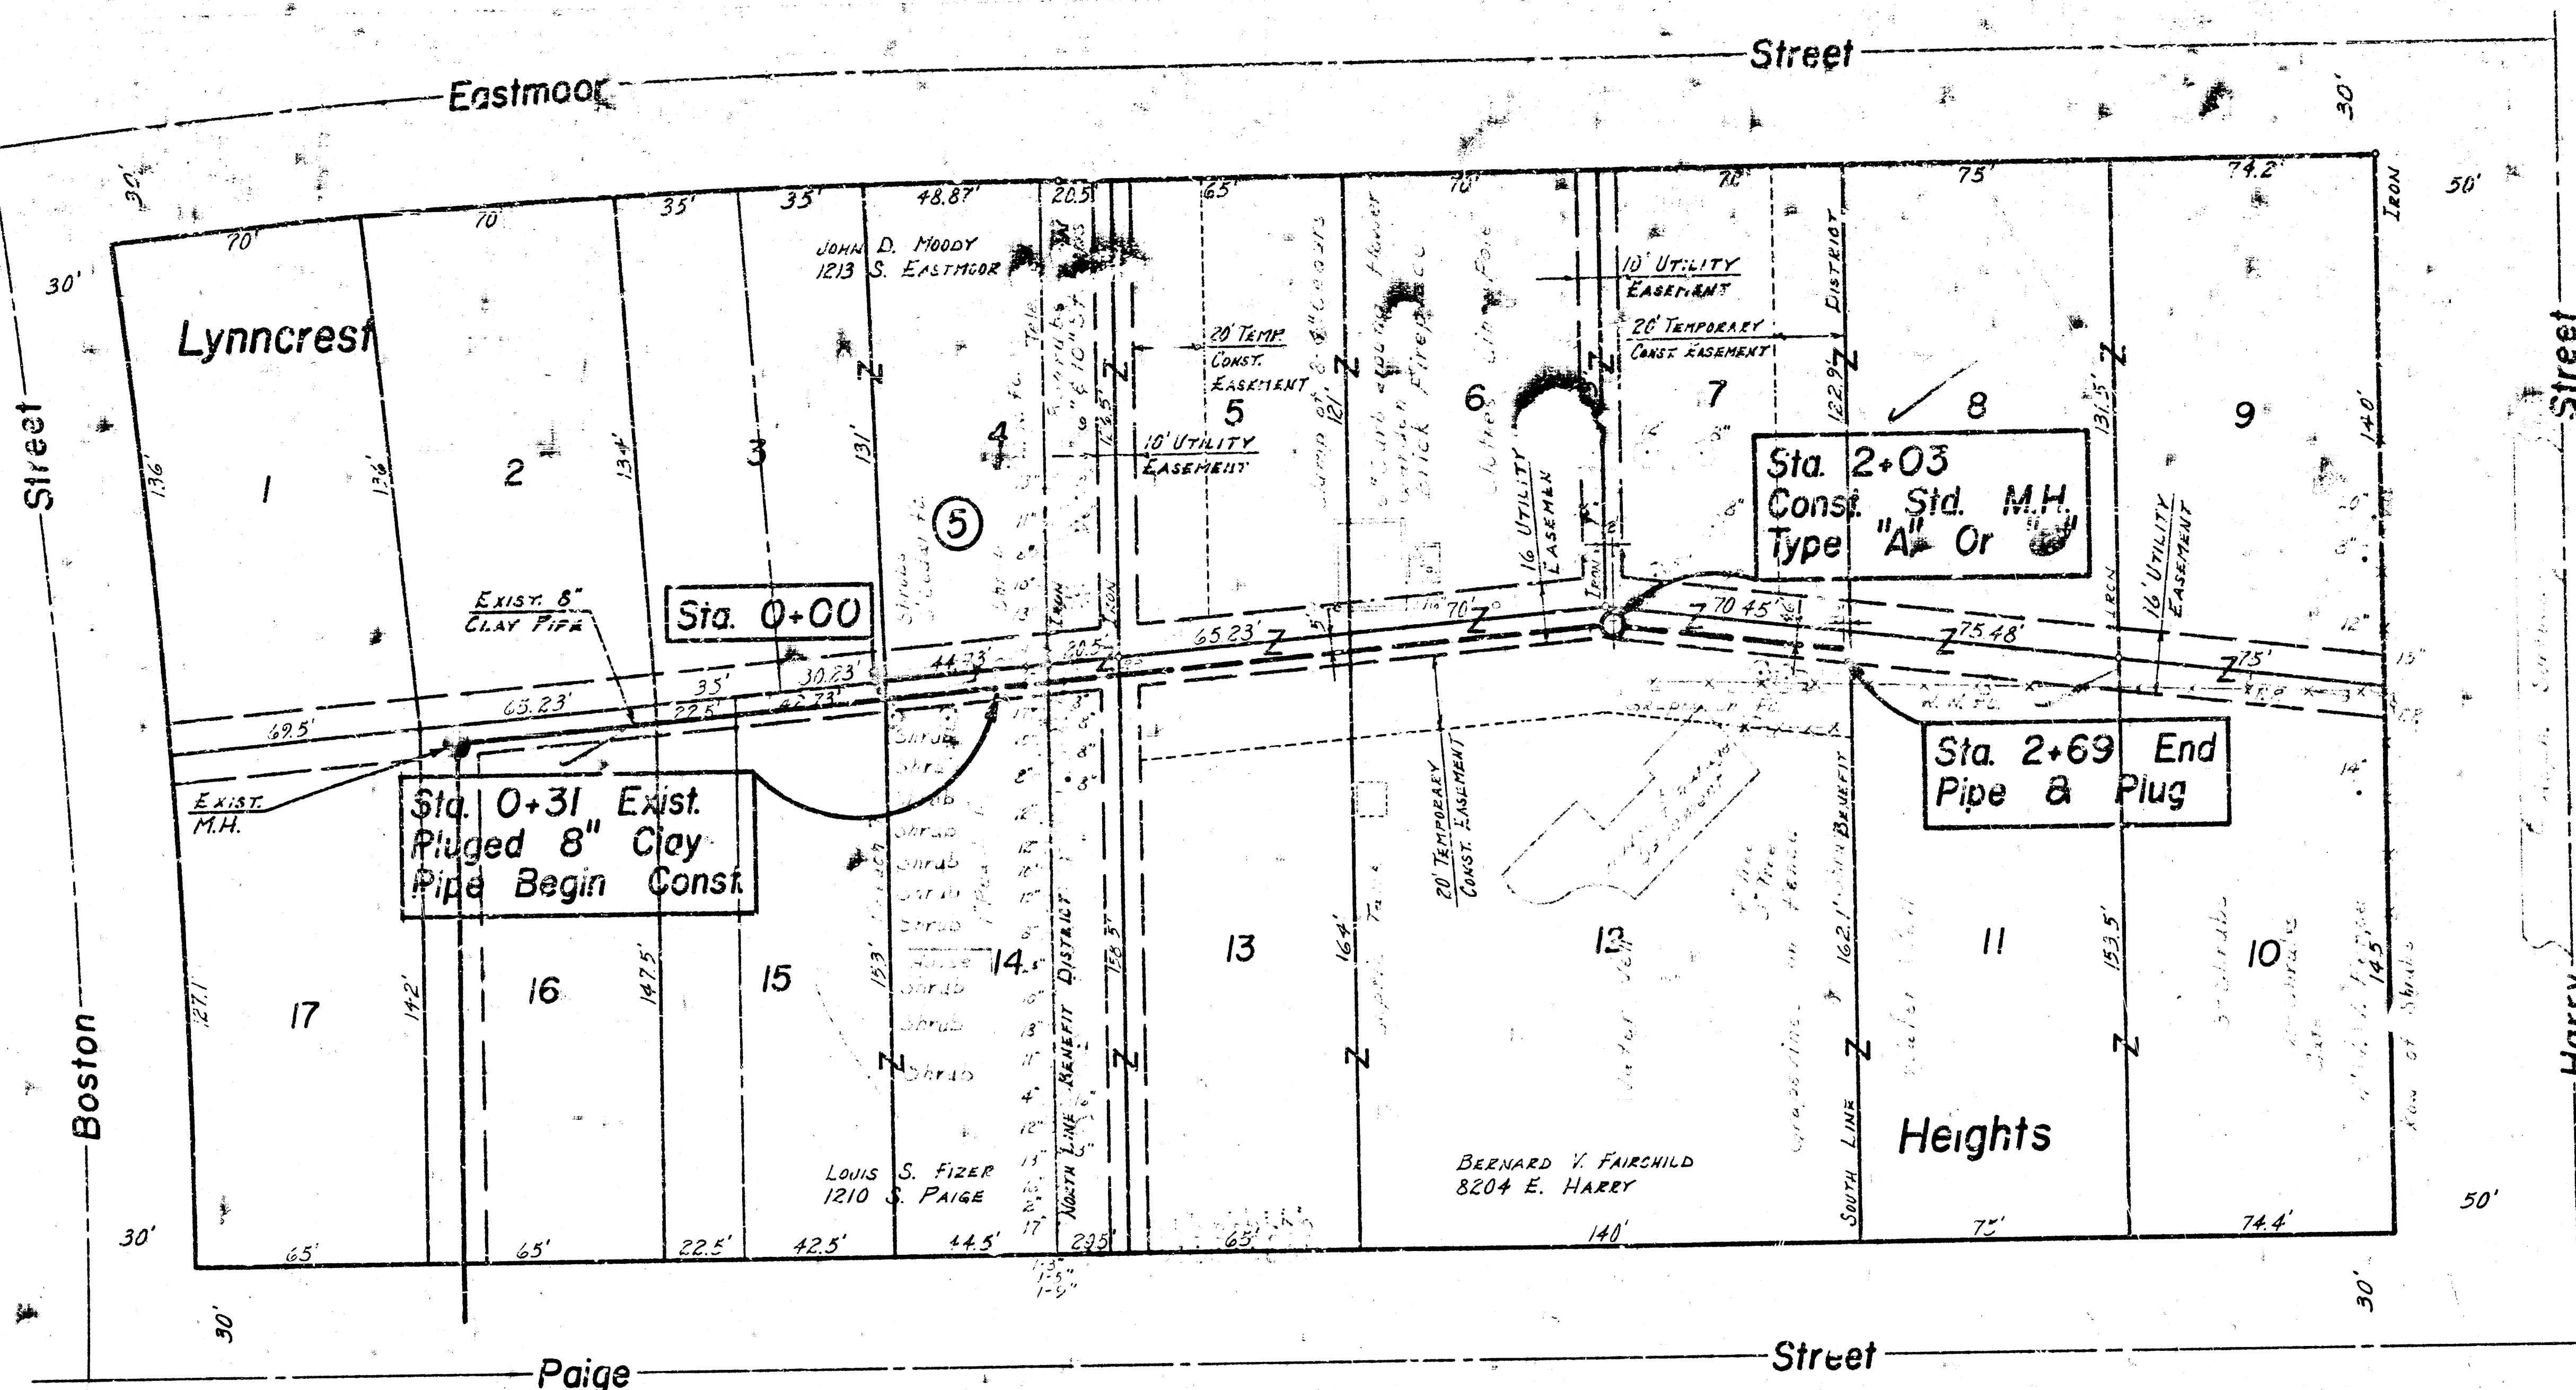
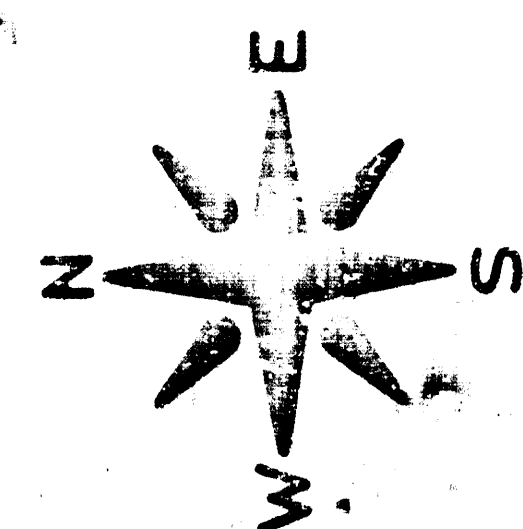


B.M. 148.52 F.H. - E.S. Paige, N.S. Harry
 "O" in Open
 B.M. 145.41 Rock Rd. & Harry, "+" Cut
 West End North Handrail
 RCB 250' E Of Rock Rd.

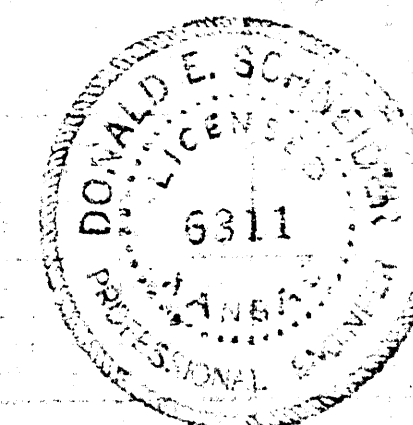

Scale =
 Plan 1" = 40'
 Profile 1" = 40' Horiz.
 1" = 5' Vert.

NOTE: CONTRACTOR WILL BE REQUIRED TO OBTAIN FIELD ENGINEER'S APPROVAL PRIOR TO REMOVING ANY EXIST. CONTRACTOR WILL BE REQUIRED TO GIVE PROPERTY OWNER A MINIMUM OF 24 HOUR NOTICE PRIOR TO STARTING CONSTRUCTION. THE PROPERTY OWNER HAS INDICATED THAT OTHER ROUTES ARE ACCESS TO THE ADJACENT PROPERTY AVAILABLE. CONTRACTOR MUST HAVE PROPERTY OWNER'S APPROVAL FOR USE OF LAND FOR WORK AREA TO BE USED OR IN ADDITION TO THAT SHOWN BY PLANS.

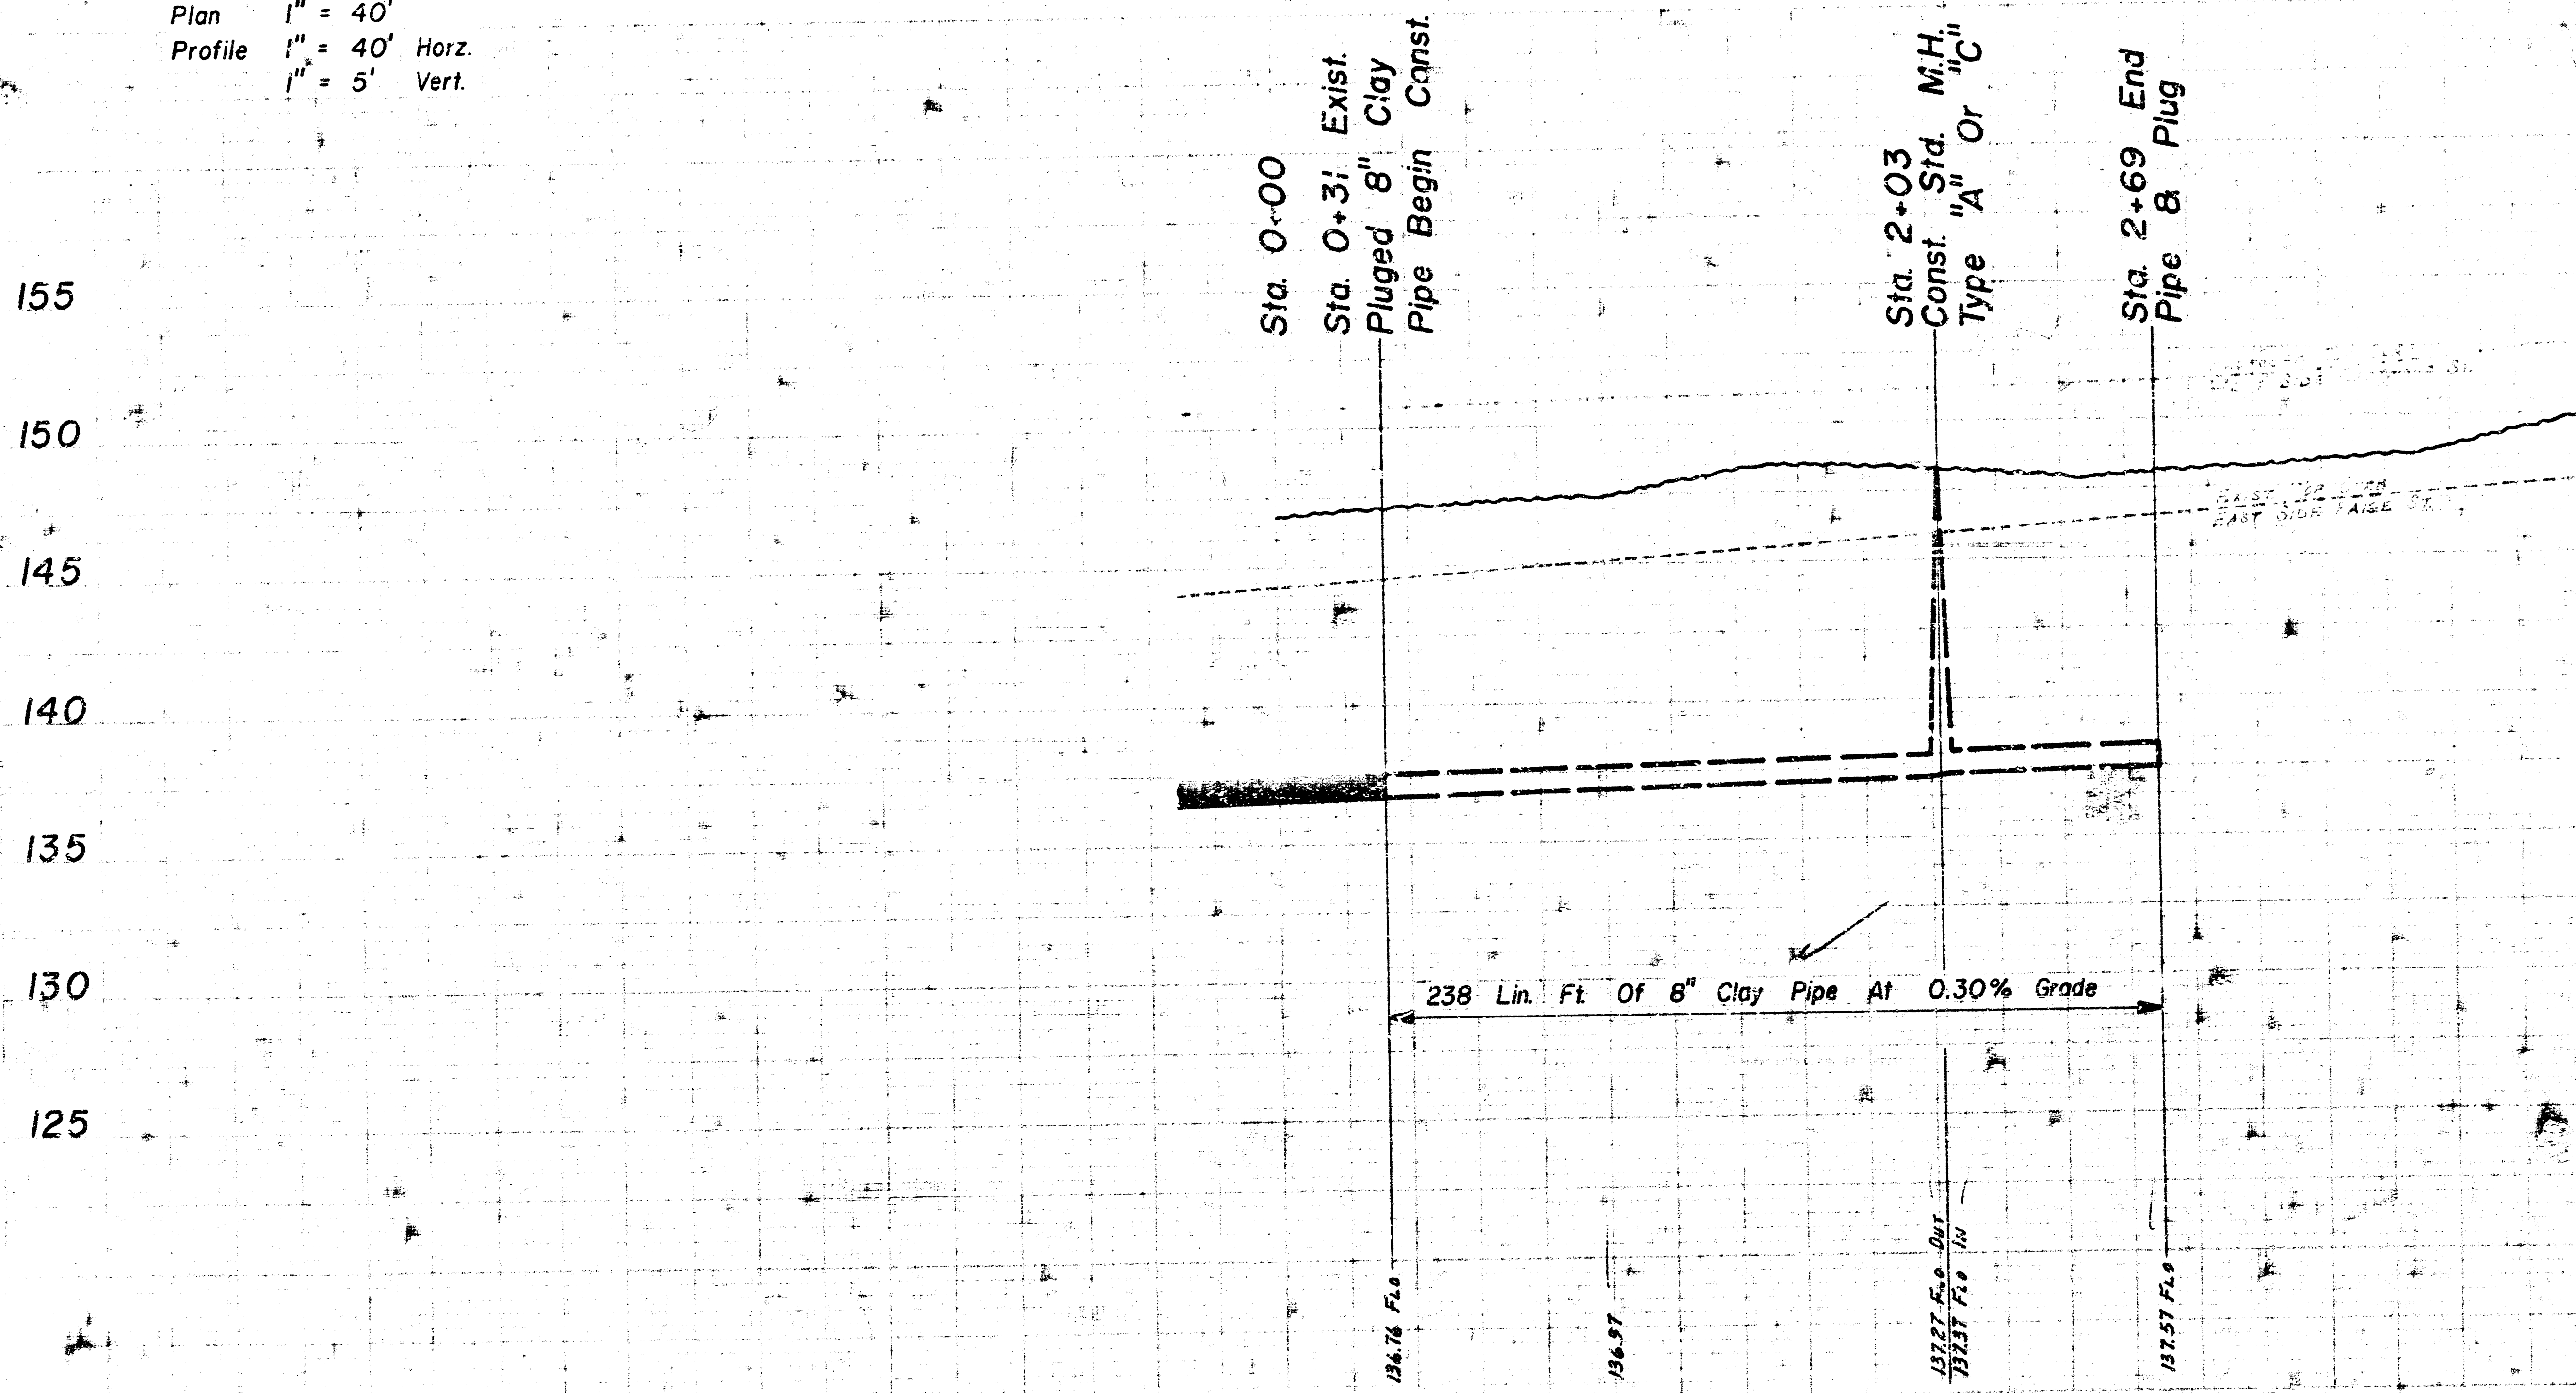

As built 10-30-

Lat. 10, Main 11, War Industries Sewer
 City Of Wichita, Kansas

R. W. Linn City Engineer

Proj. No. 468 76 80398 OGA-000 001 Date:
 Proj. No. DBK1577056 Sheet 1 of 1