



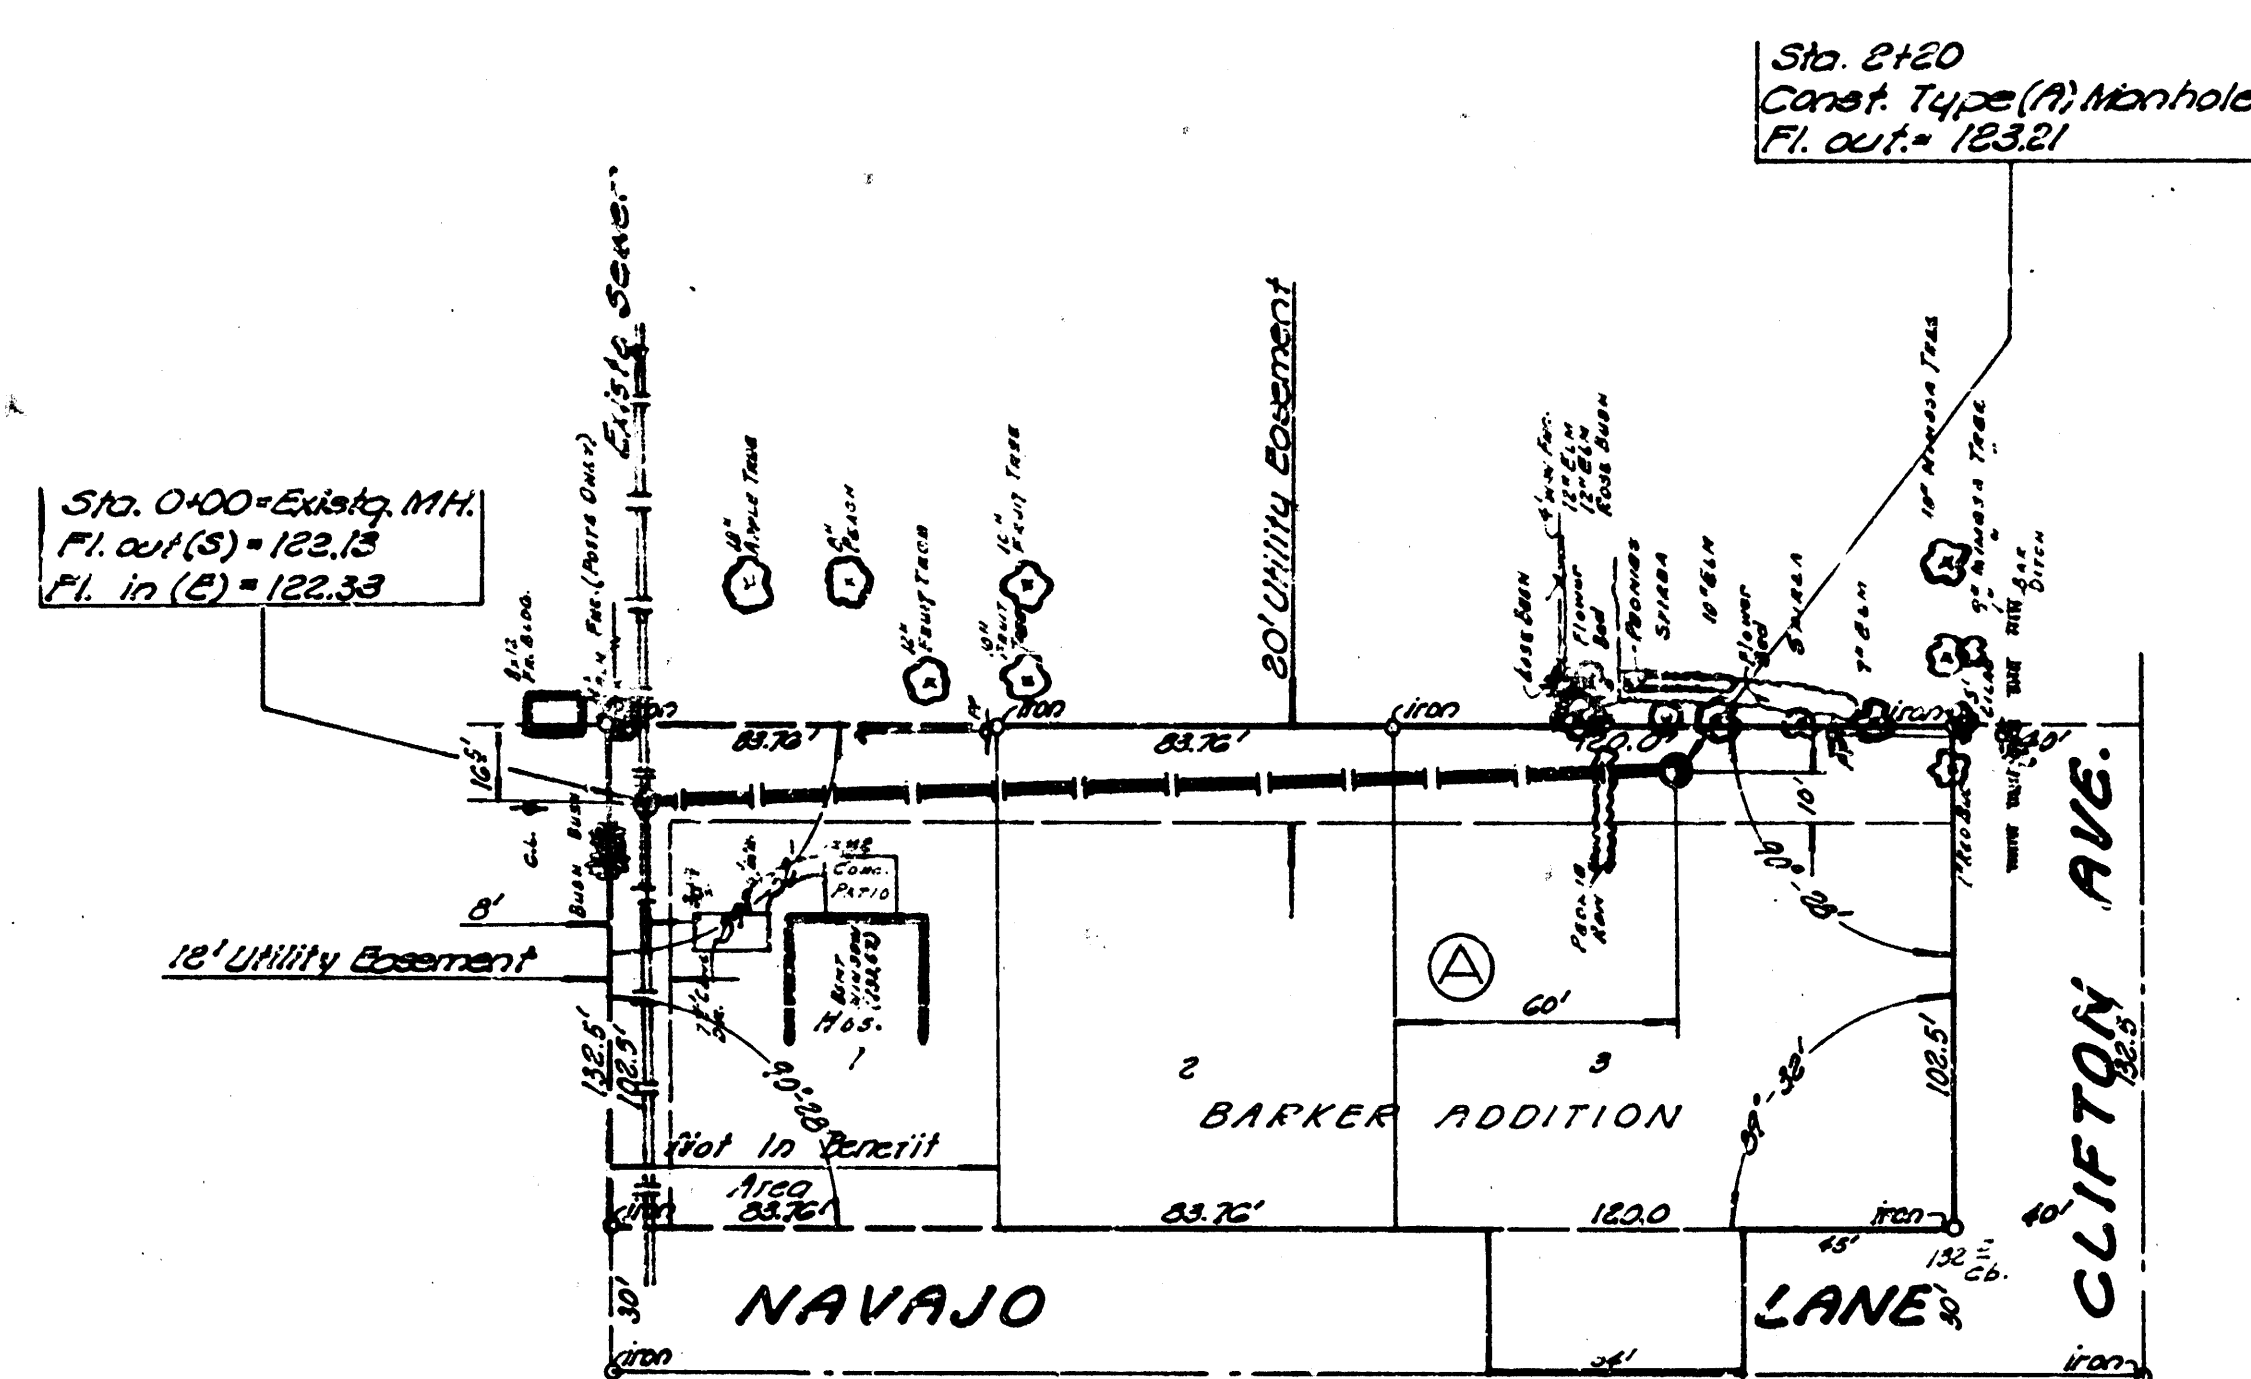



1" = 40'
   
 B.M. 134.595 MM Cor. Bdr'n Conc. Step
   
 on N.S. Has. T 3482 Navajo Lane

Profile = 1" = 20' Horiz.
   
 1" = 5' Vert.

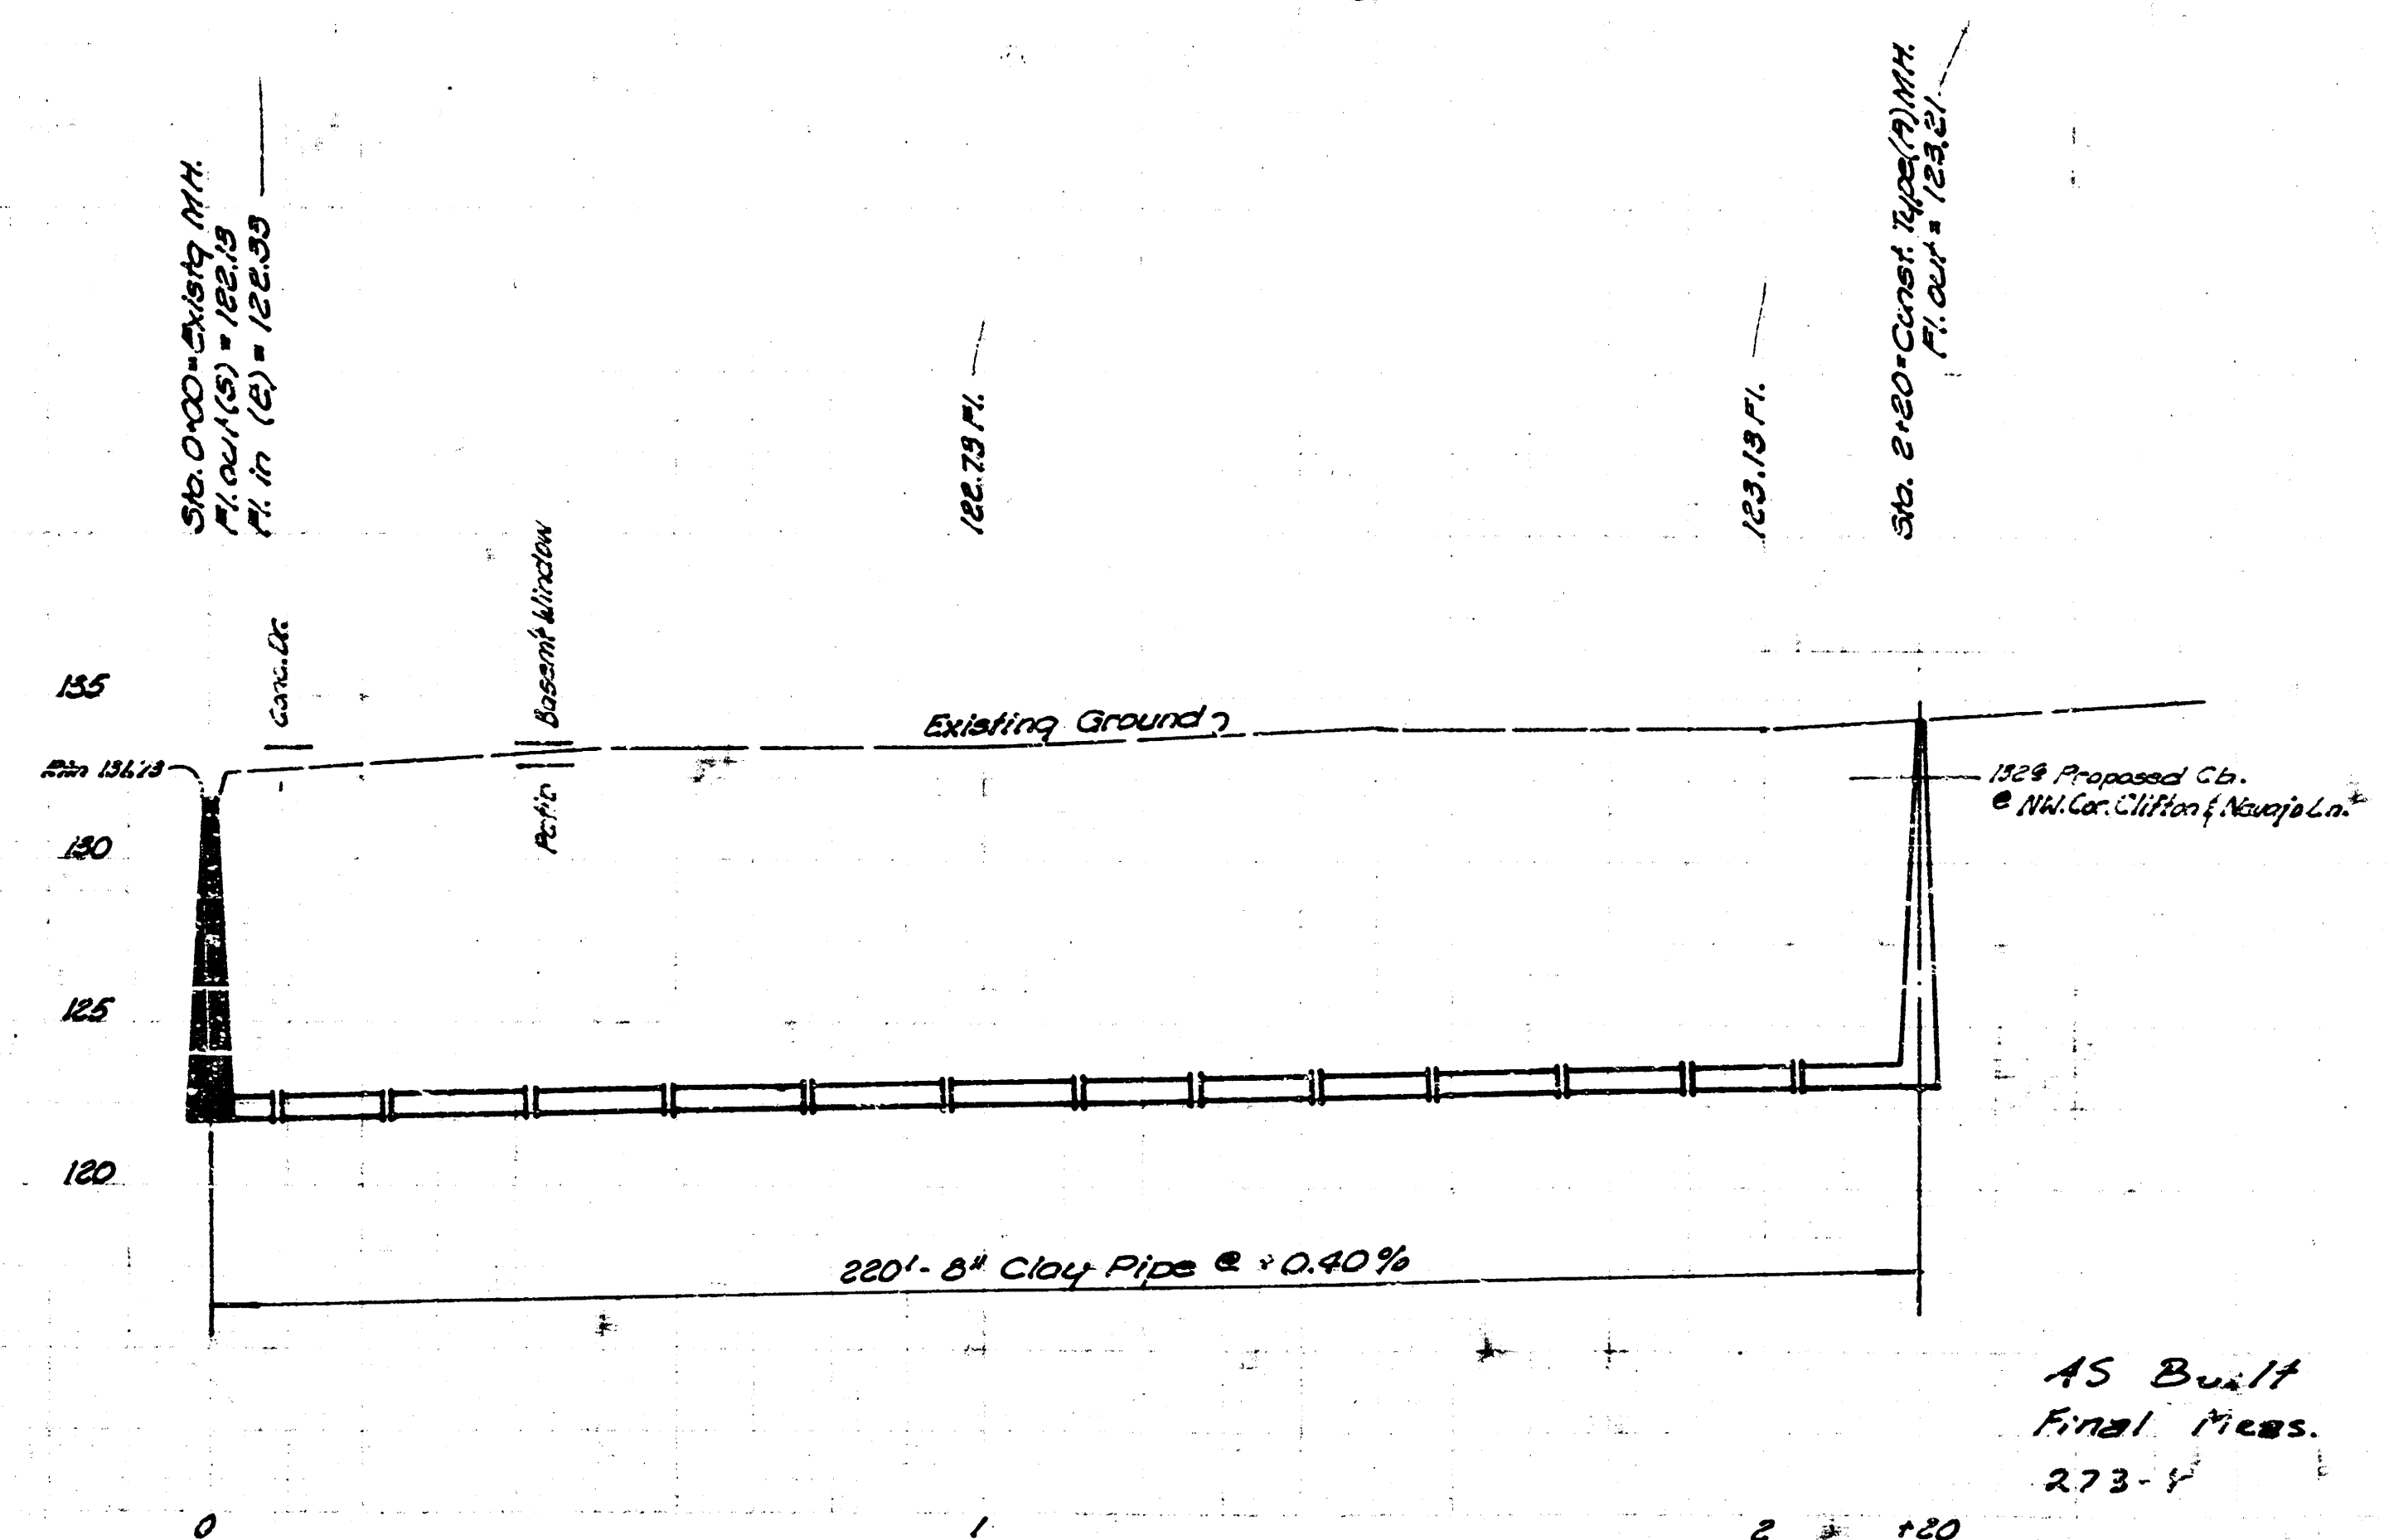

AS BUILT
   
 Final Meas.
   
 273 - V

**LAT. 5, SUBMAIN 14, M.I.S.**
  
 City Of Wichita, Kansas
   
 R.W. Linn City Engineer
   
 Date - Jan, 1974 DBK 2 570057

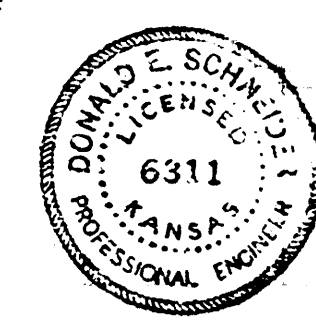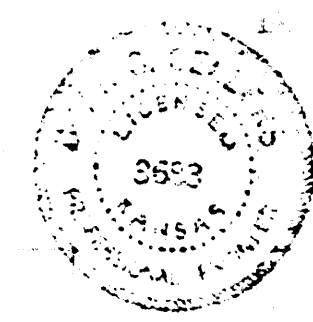

16- Engr 5
   
 1- W.L.L.