



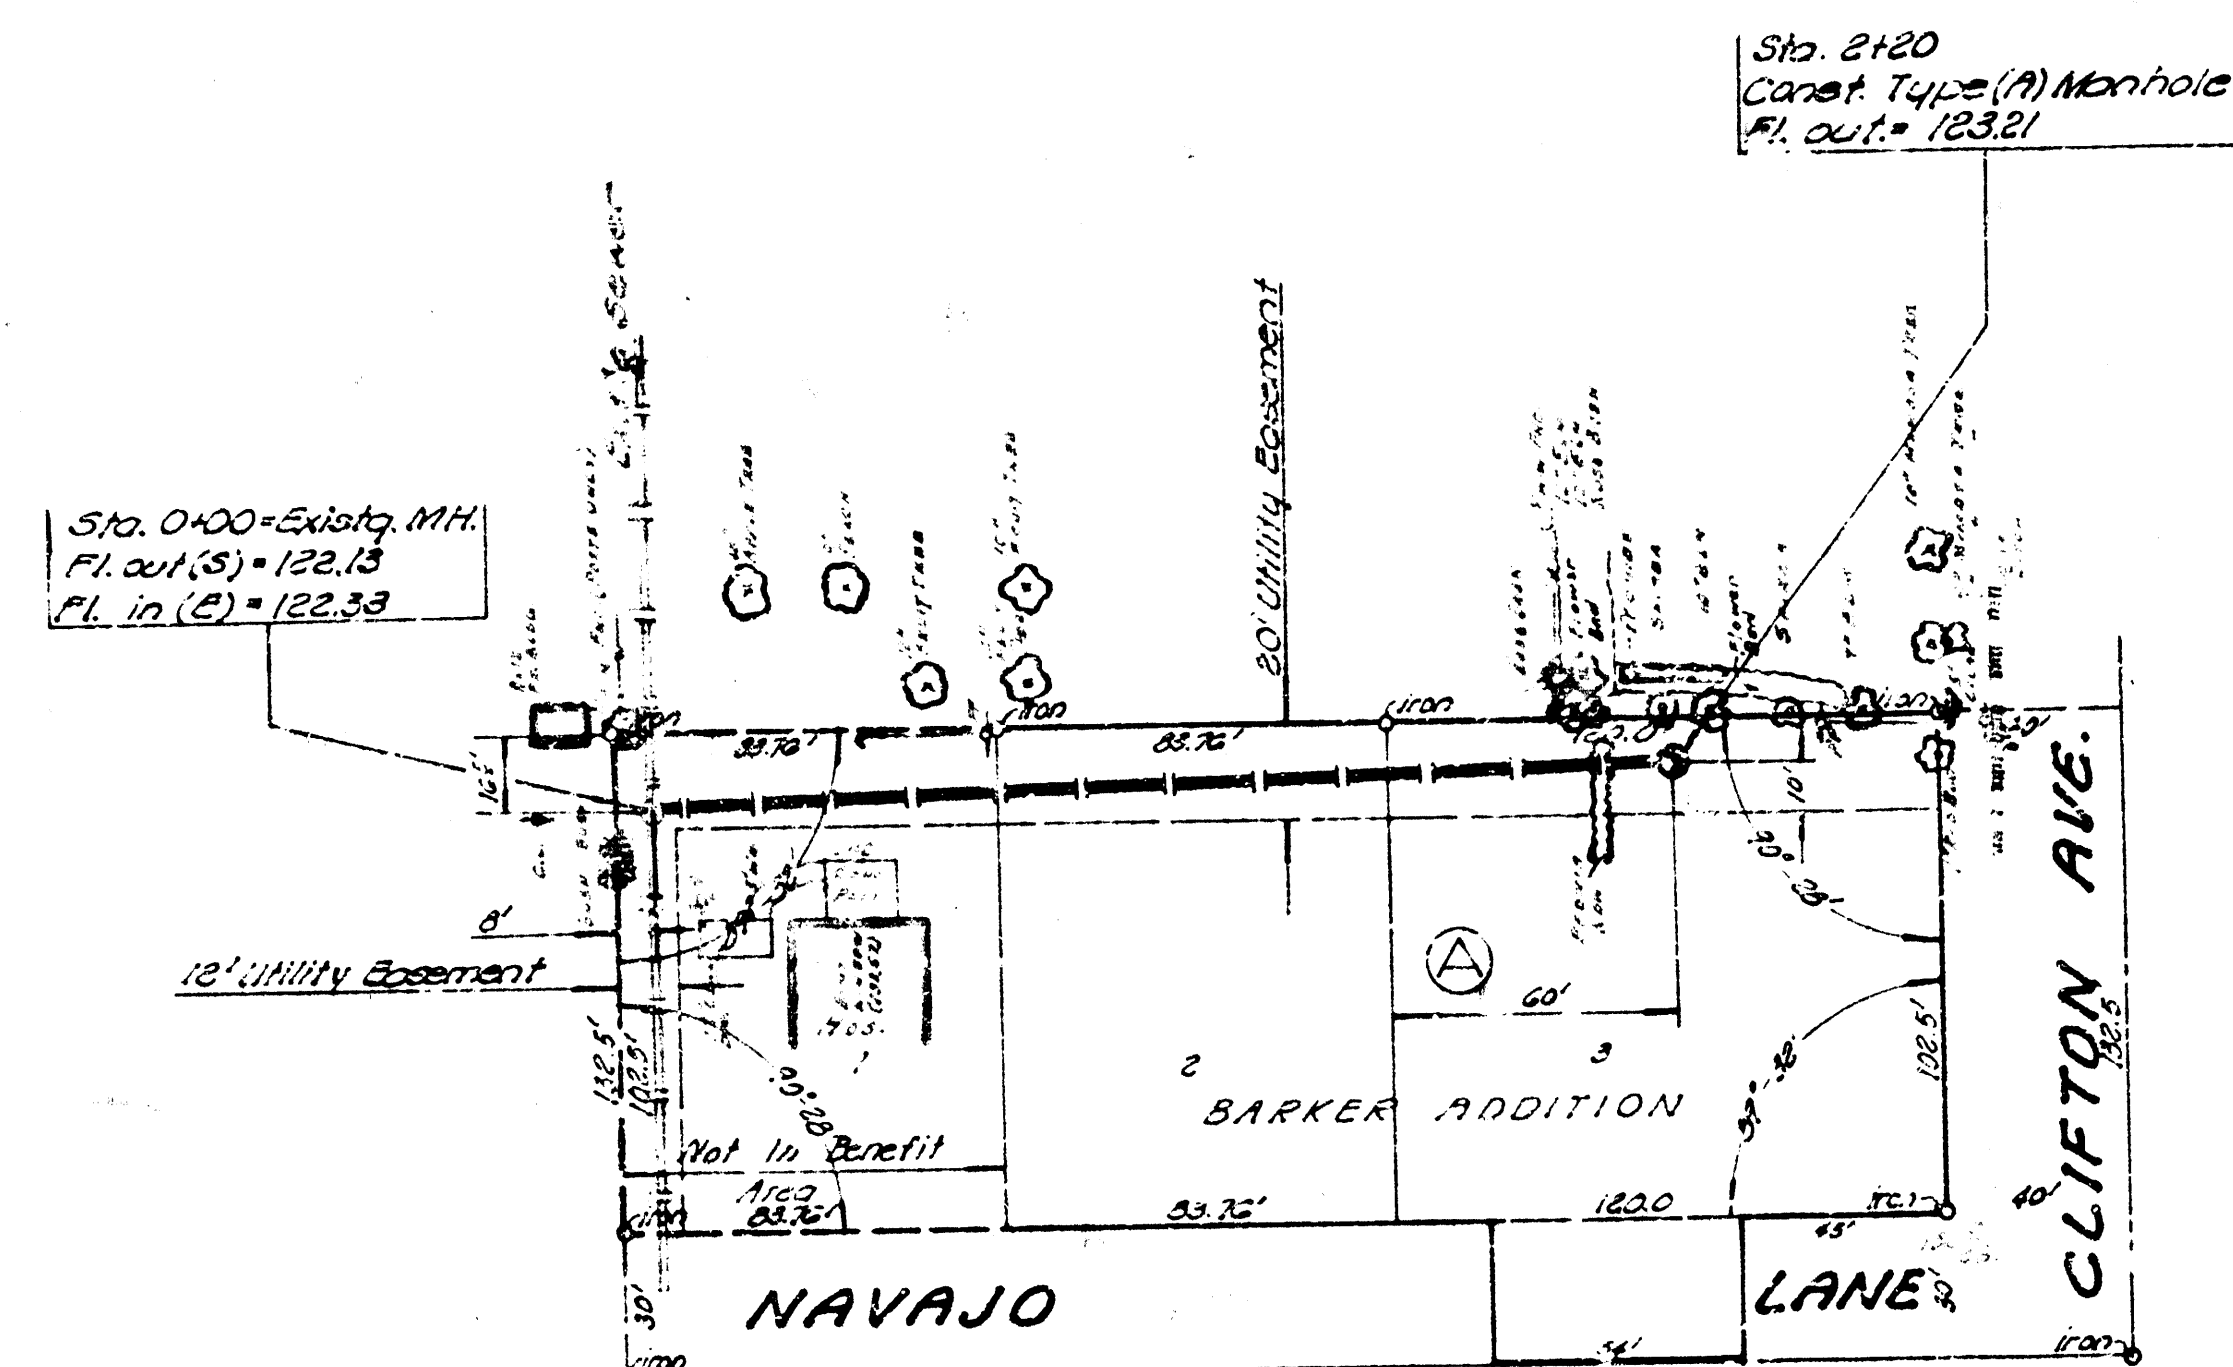

11' = 40'
 811. 134.536 N.W. Cor. Below Con. Stop
 on N.S. Prop. # 342G Navajo Lane

Profile = 1" = 20' Horiz.
 1" = 5' Vert.

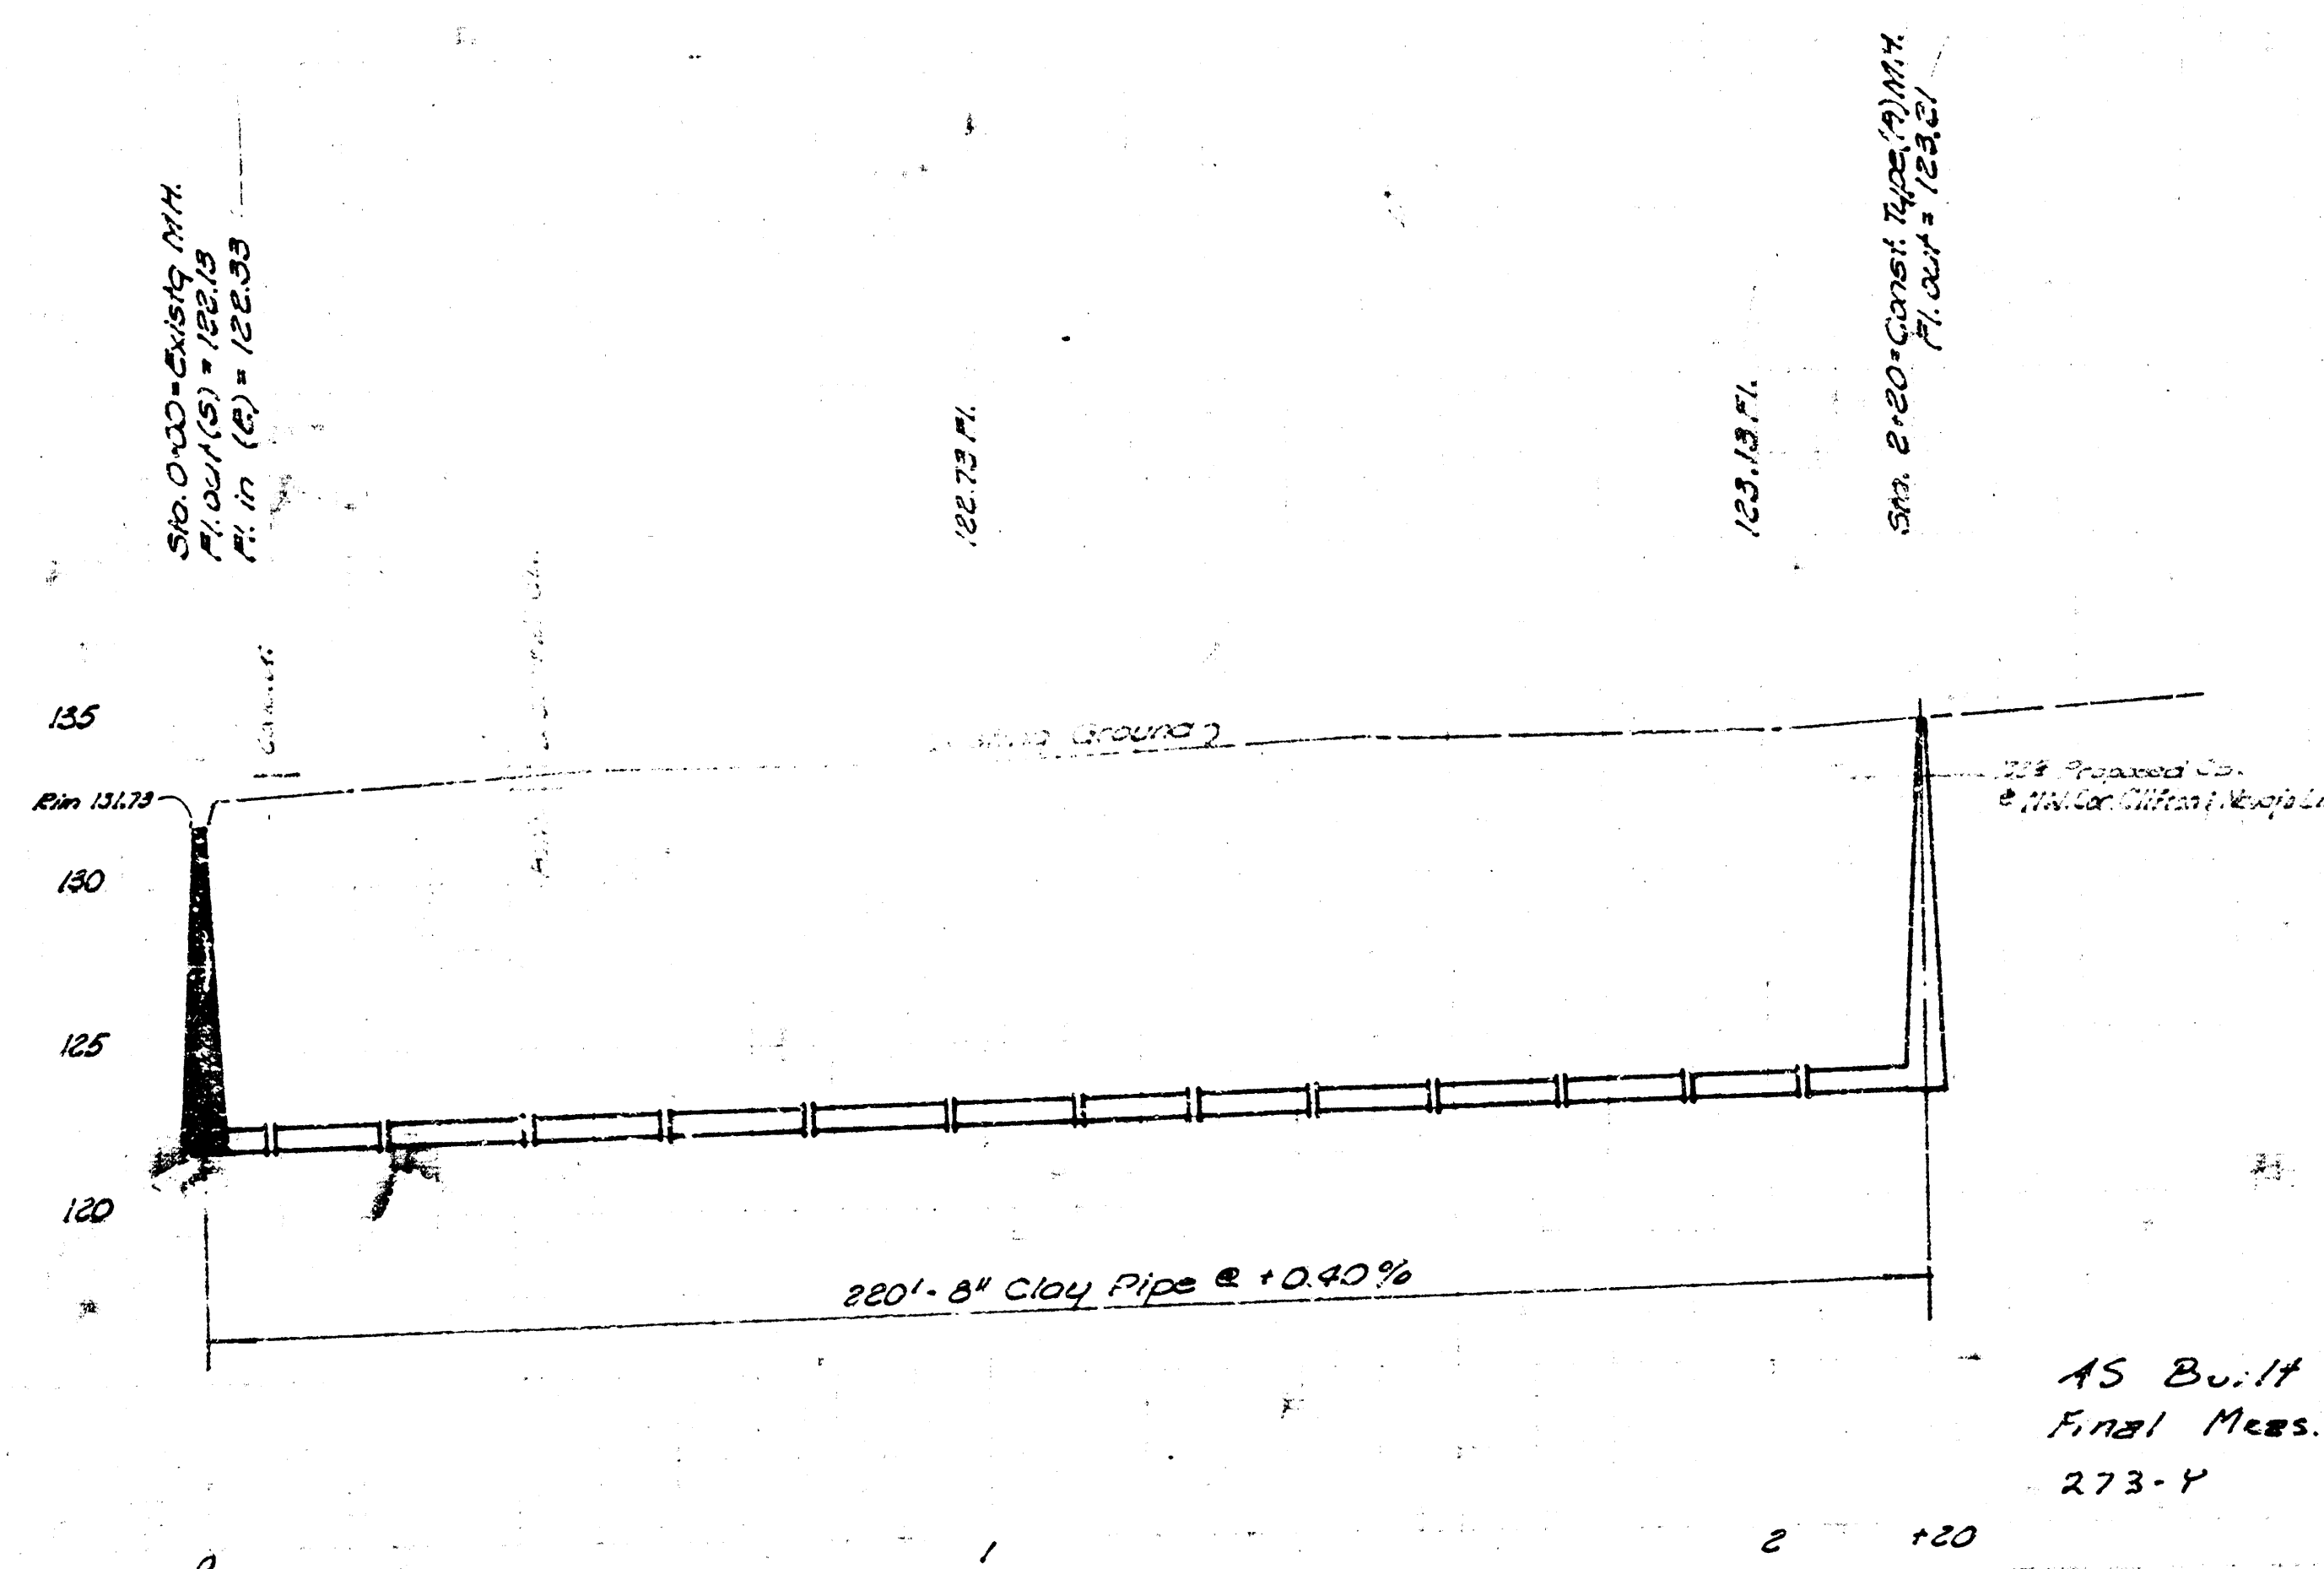

AS BUILT
 Final Meas.
 273-Y

LAT. 5, SUBMAIN 14, W.I.S.

City of Wichita, Kansas
 R.W. Linn City Engineer
 Date - Jan. 1974 DBK 570057

14 e 5 6