



B.M. 98.97 R.R. Spike 5'-10" Tree 50' N. of Butler Dr. E. Side of K-15 Hwy.

D.P.C. & S.P.
D. Cranner

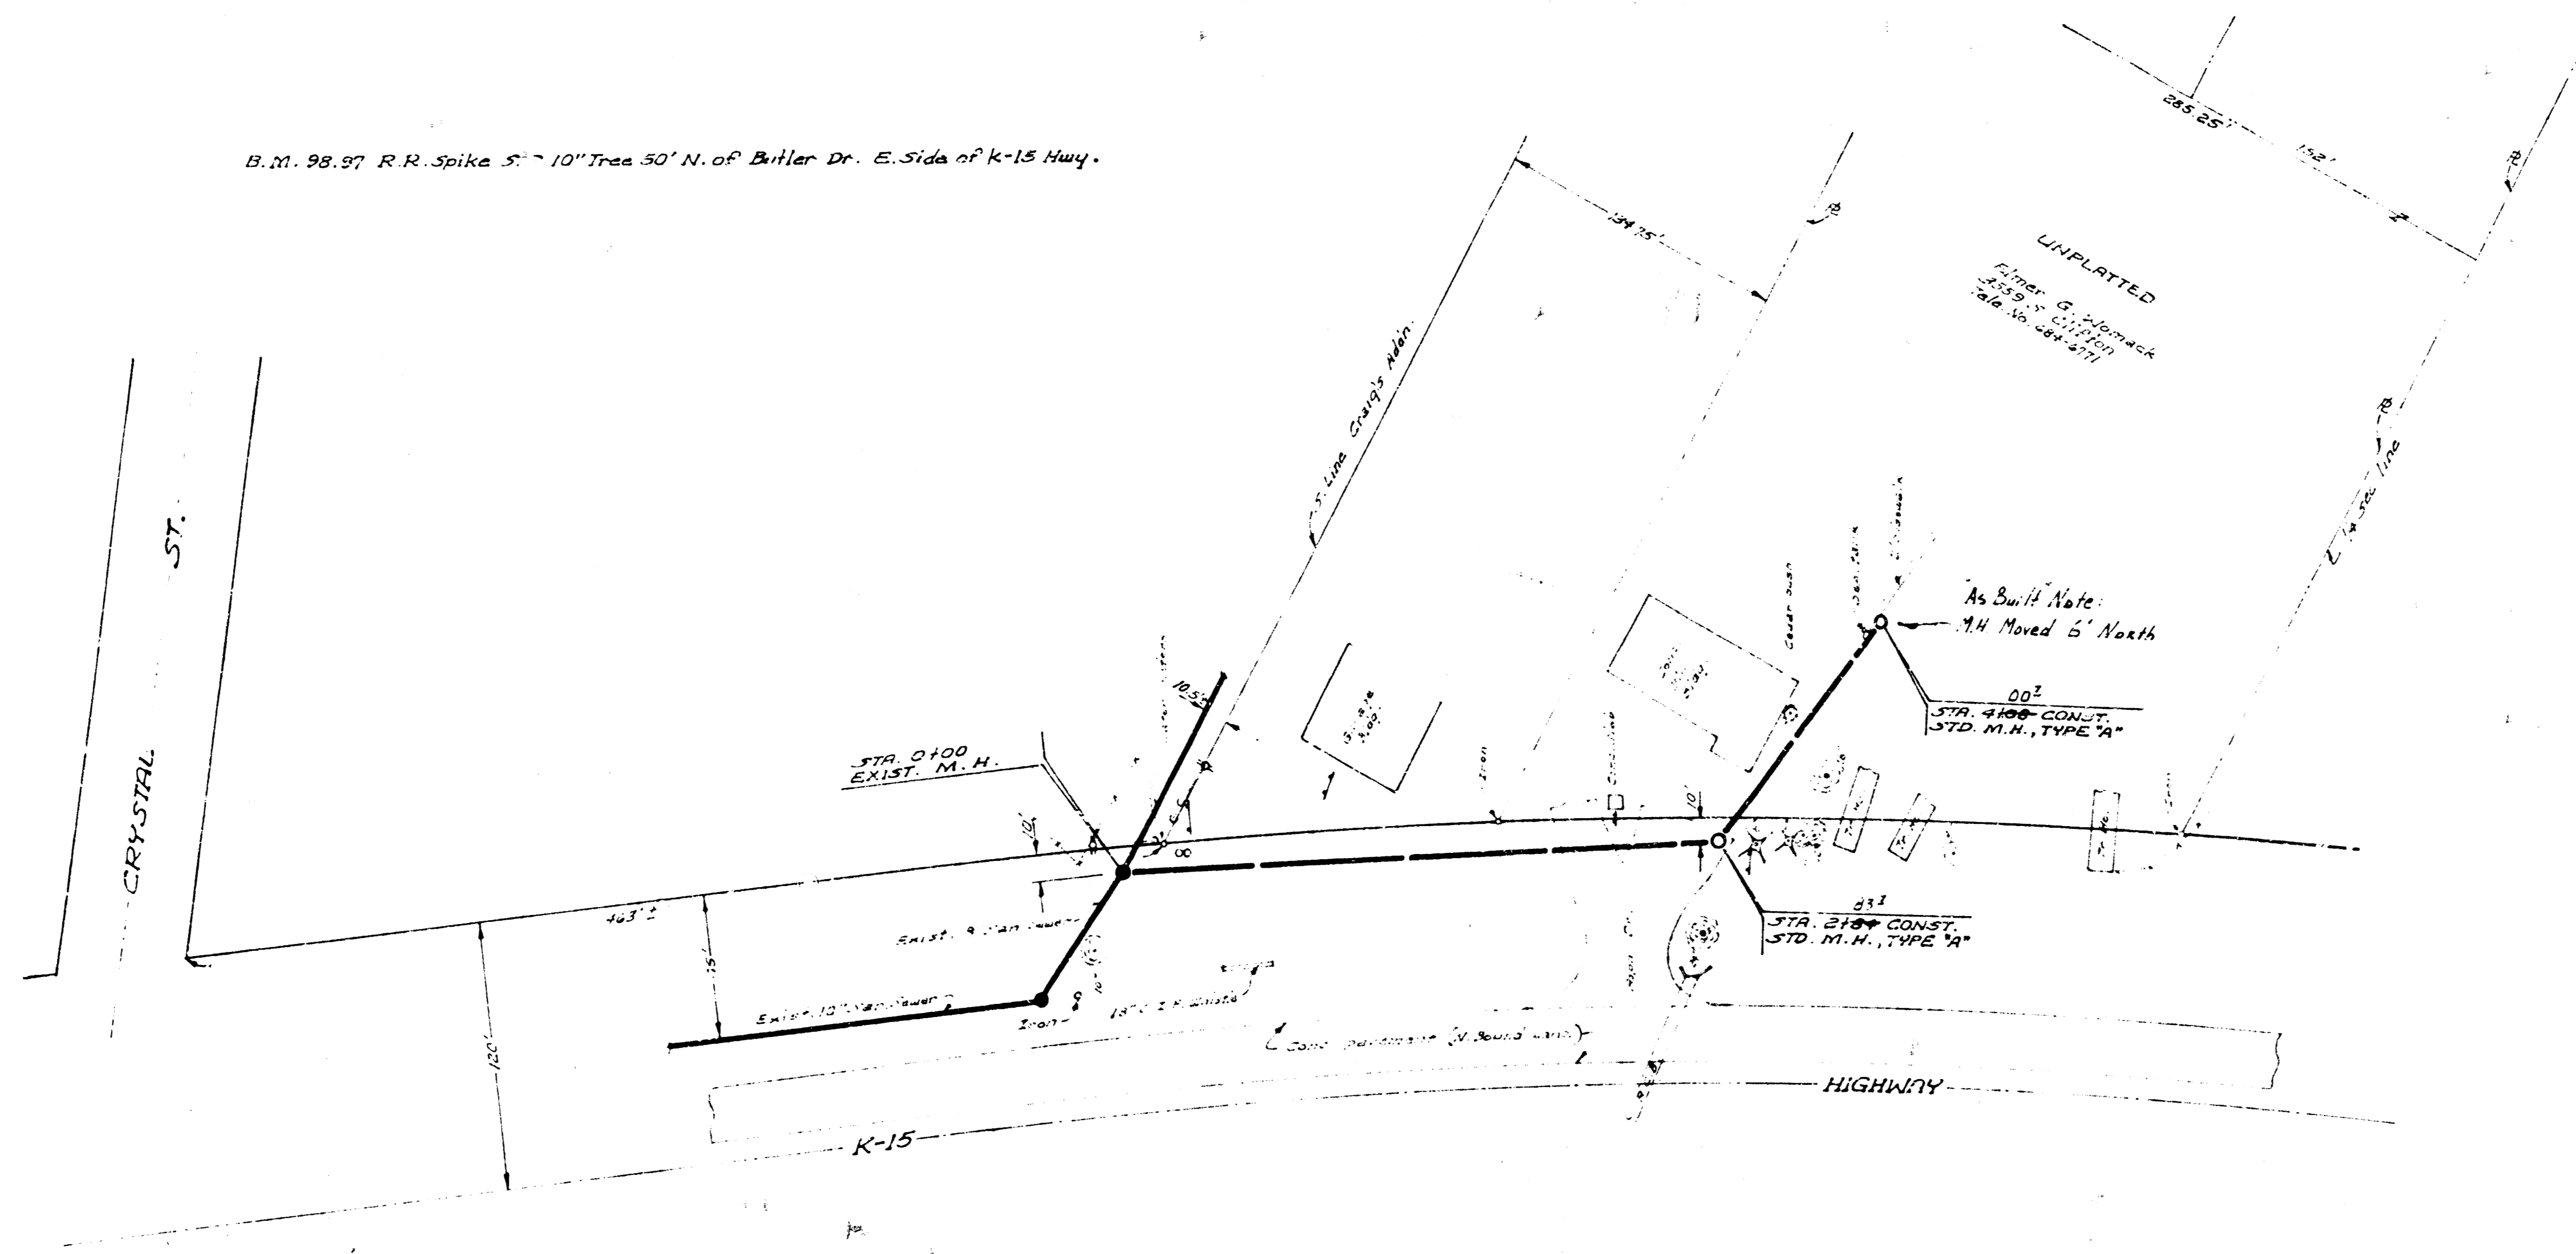

Plan Scale 1"=50'
Profile Scale 1"=5' Vert.

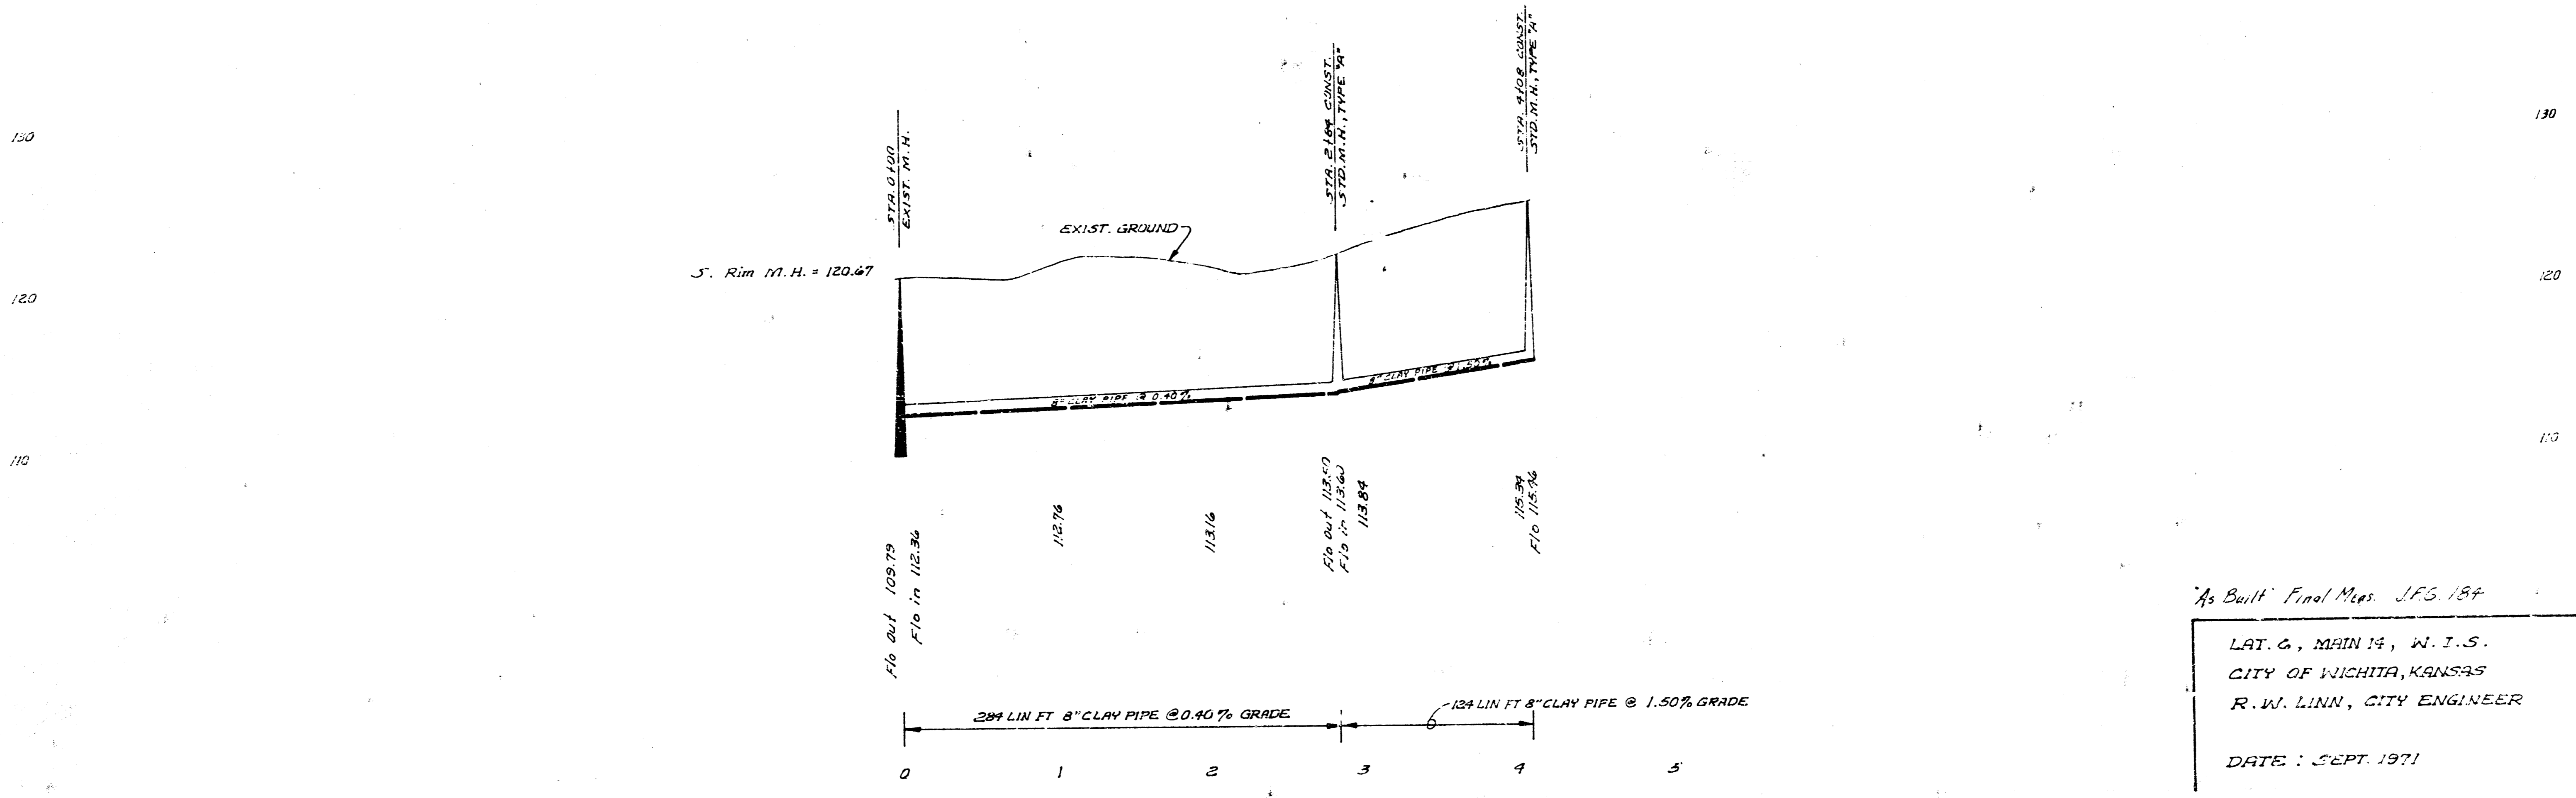

As Built Final Map JFS 184
LAT. 6, MAIN 14, W. I. S.
CITY OF WICHITA, KANSAS
R. W. LINN, CITY ENGINEER
DATE: SEPT. 1971