
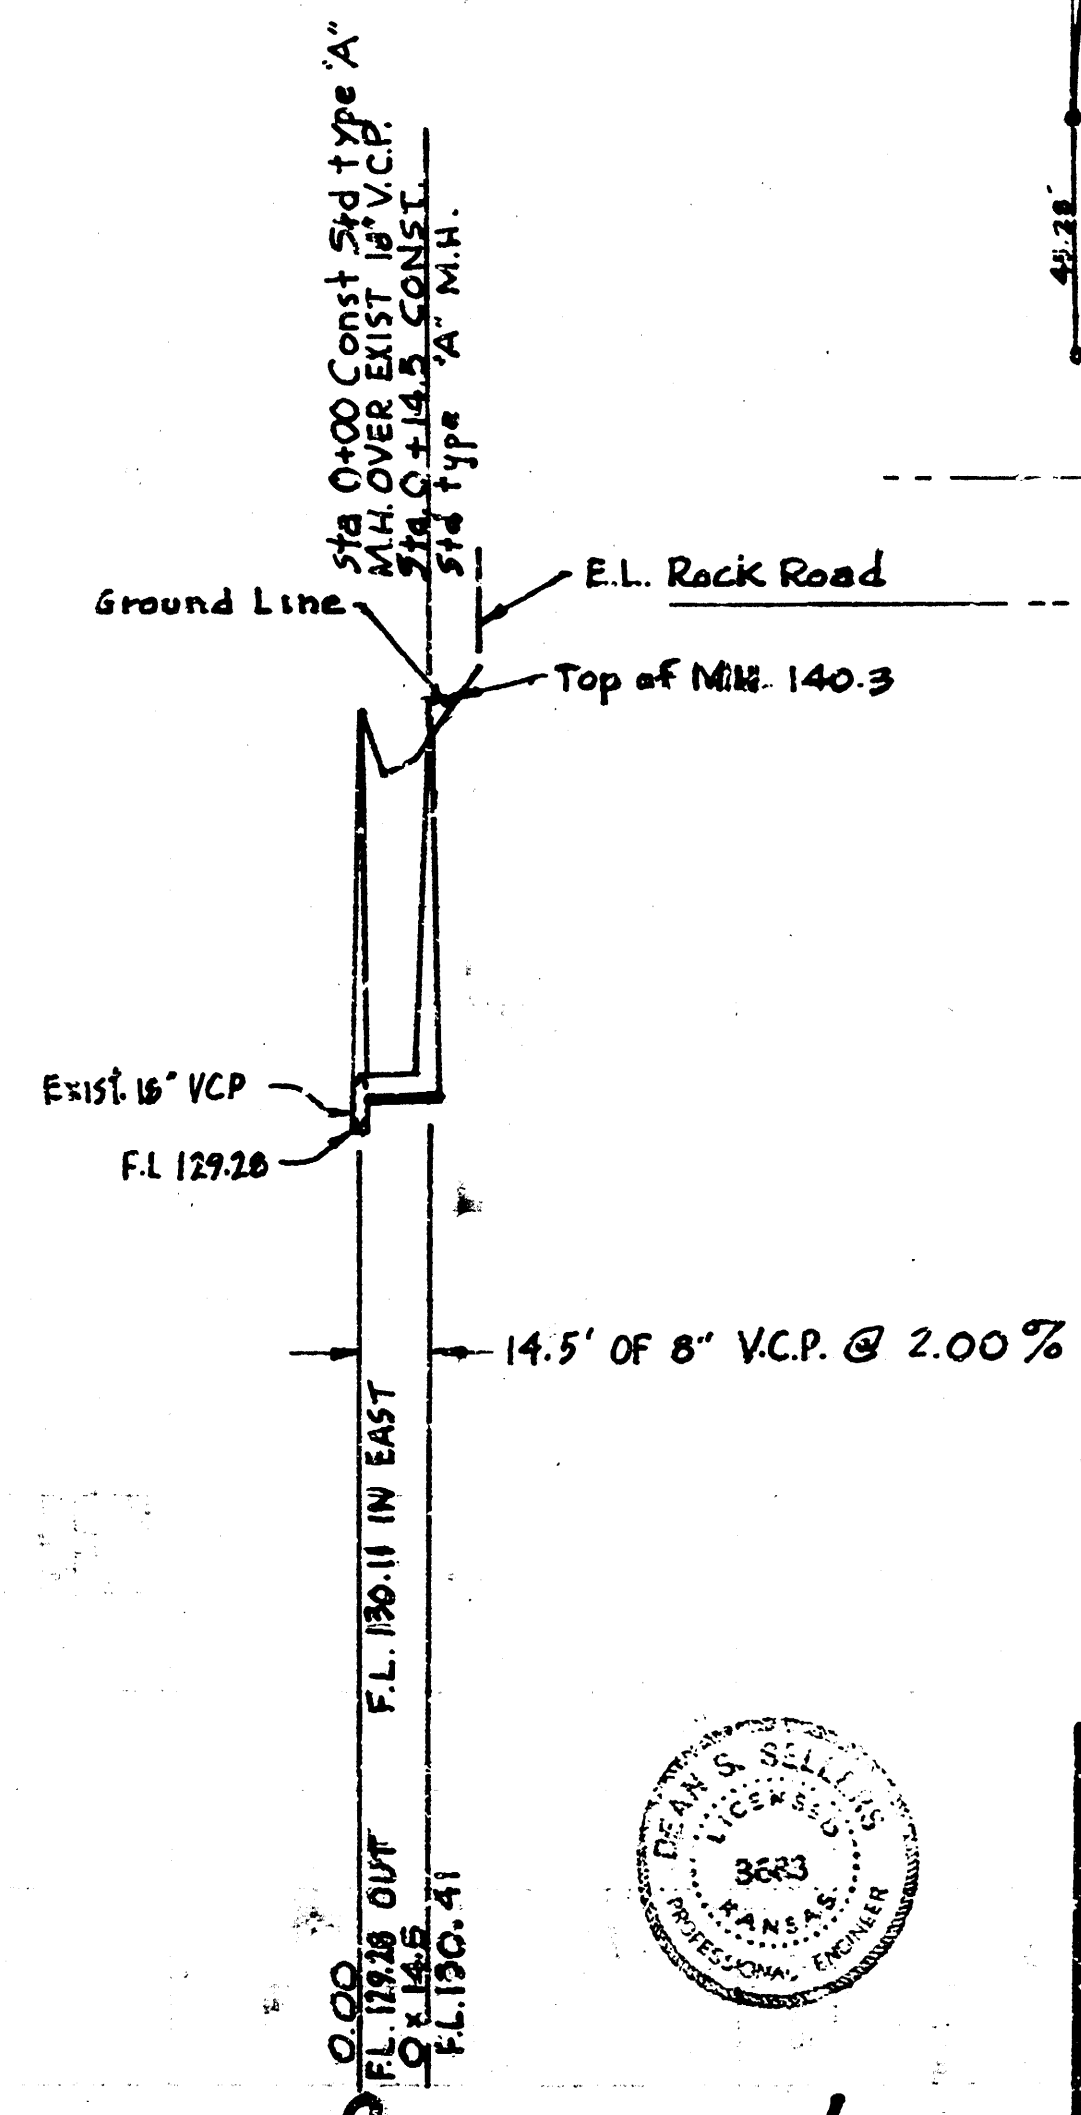
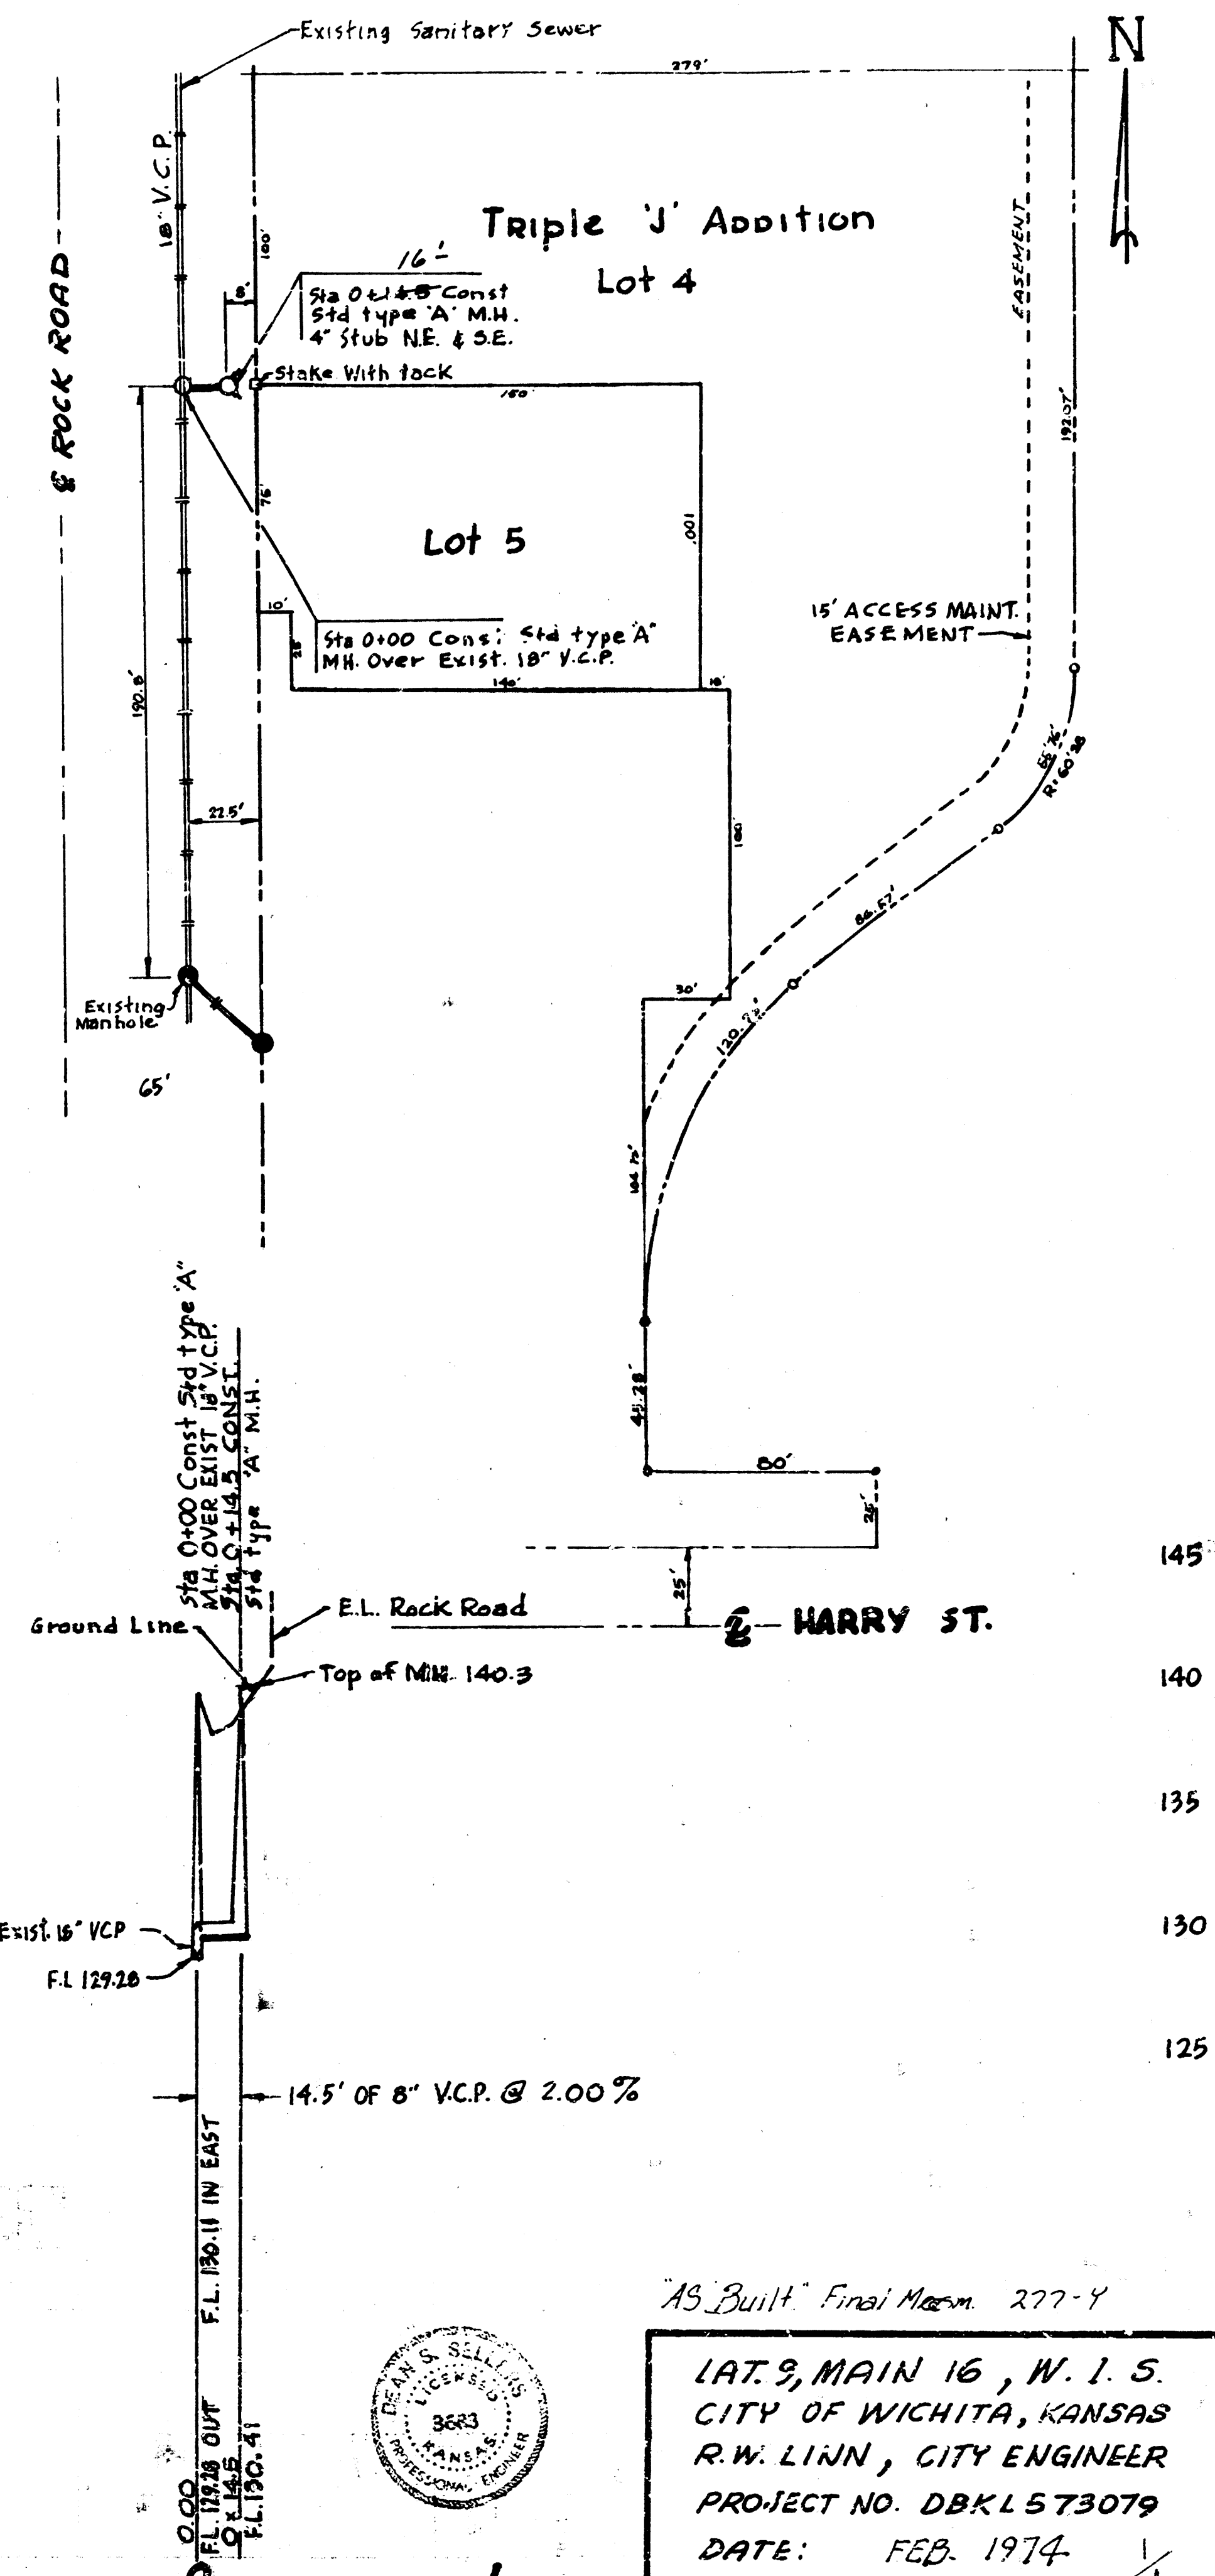
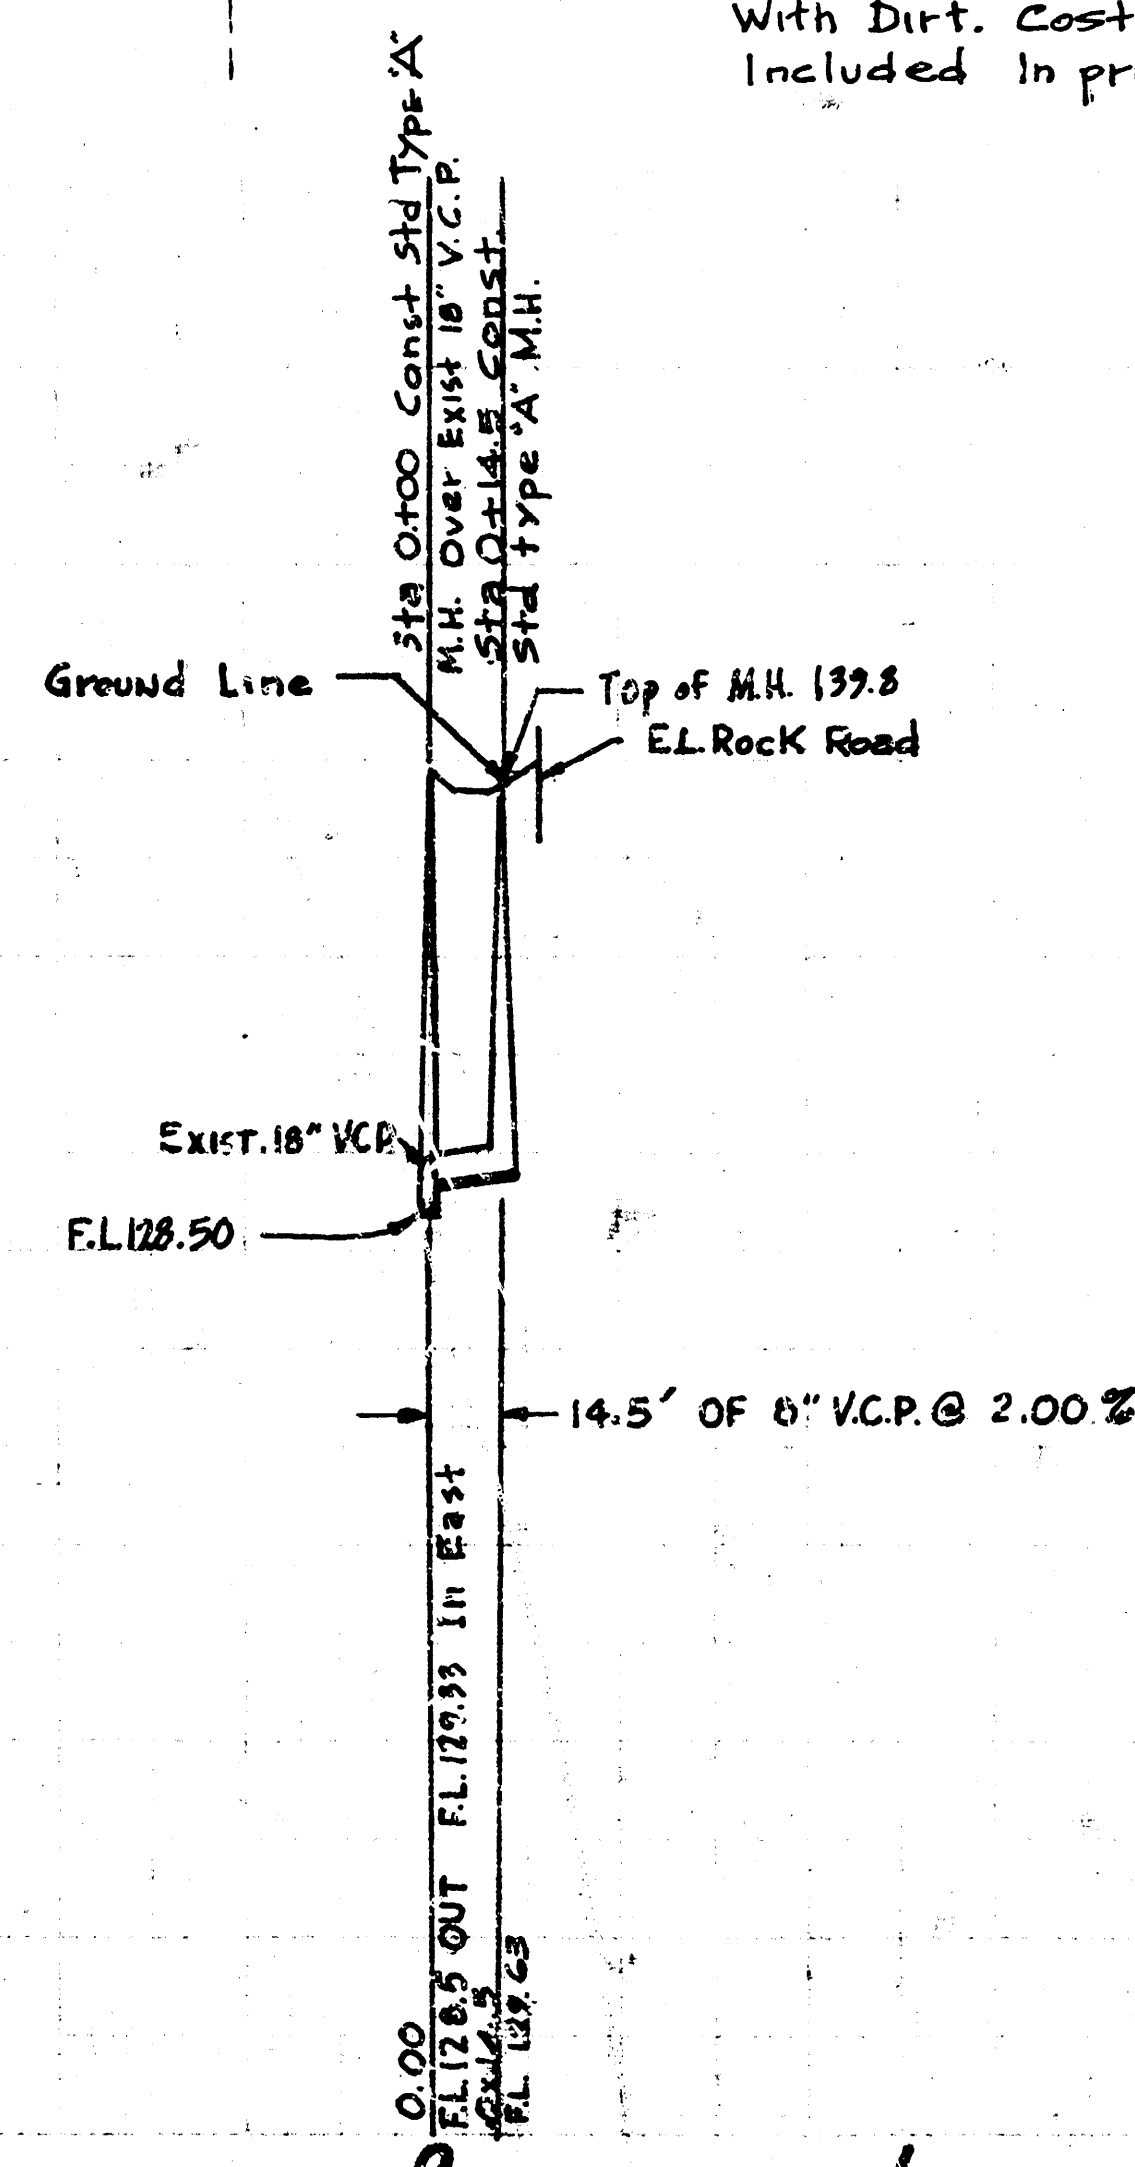
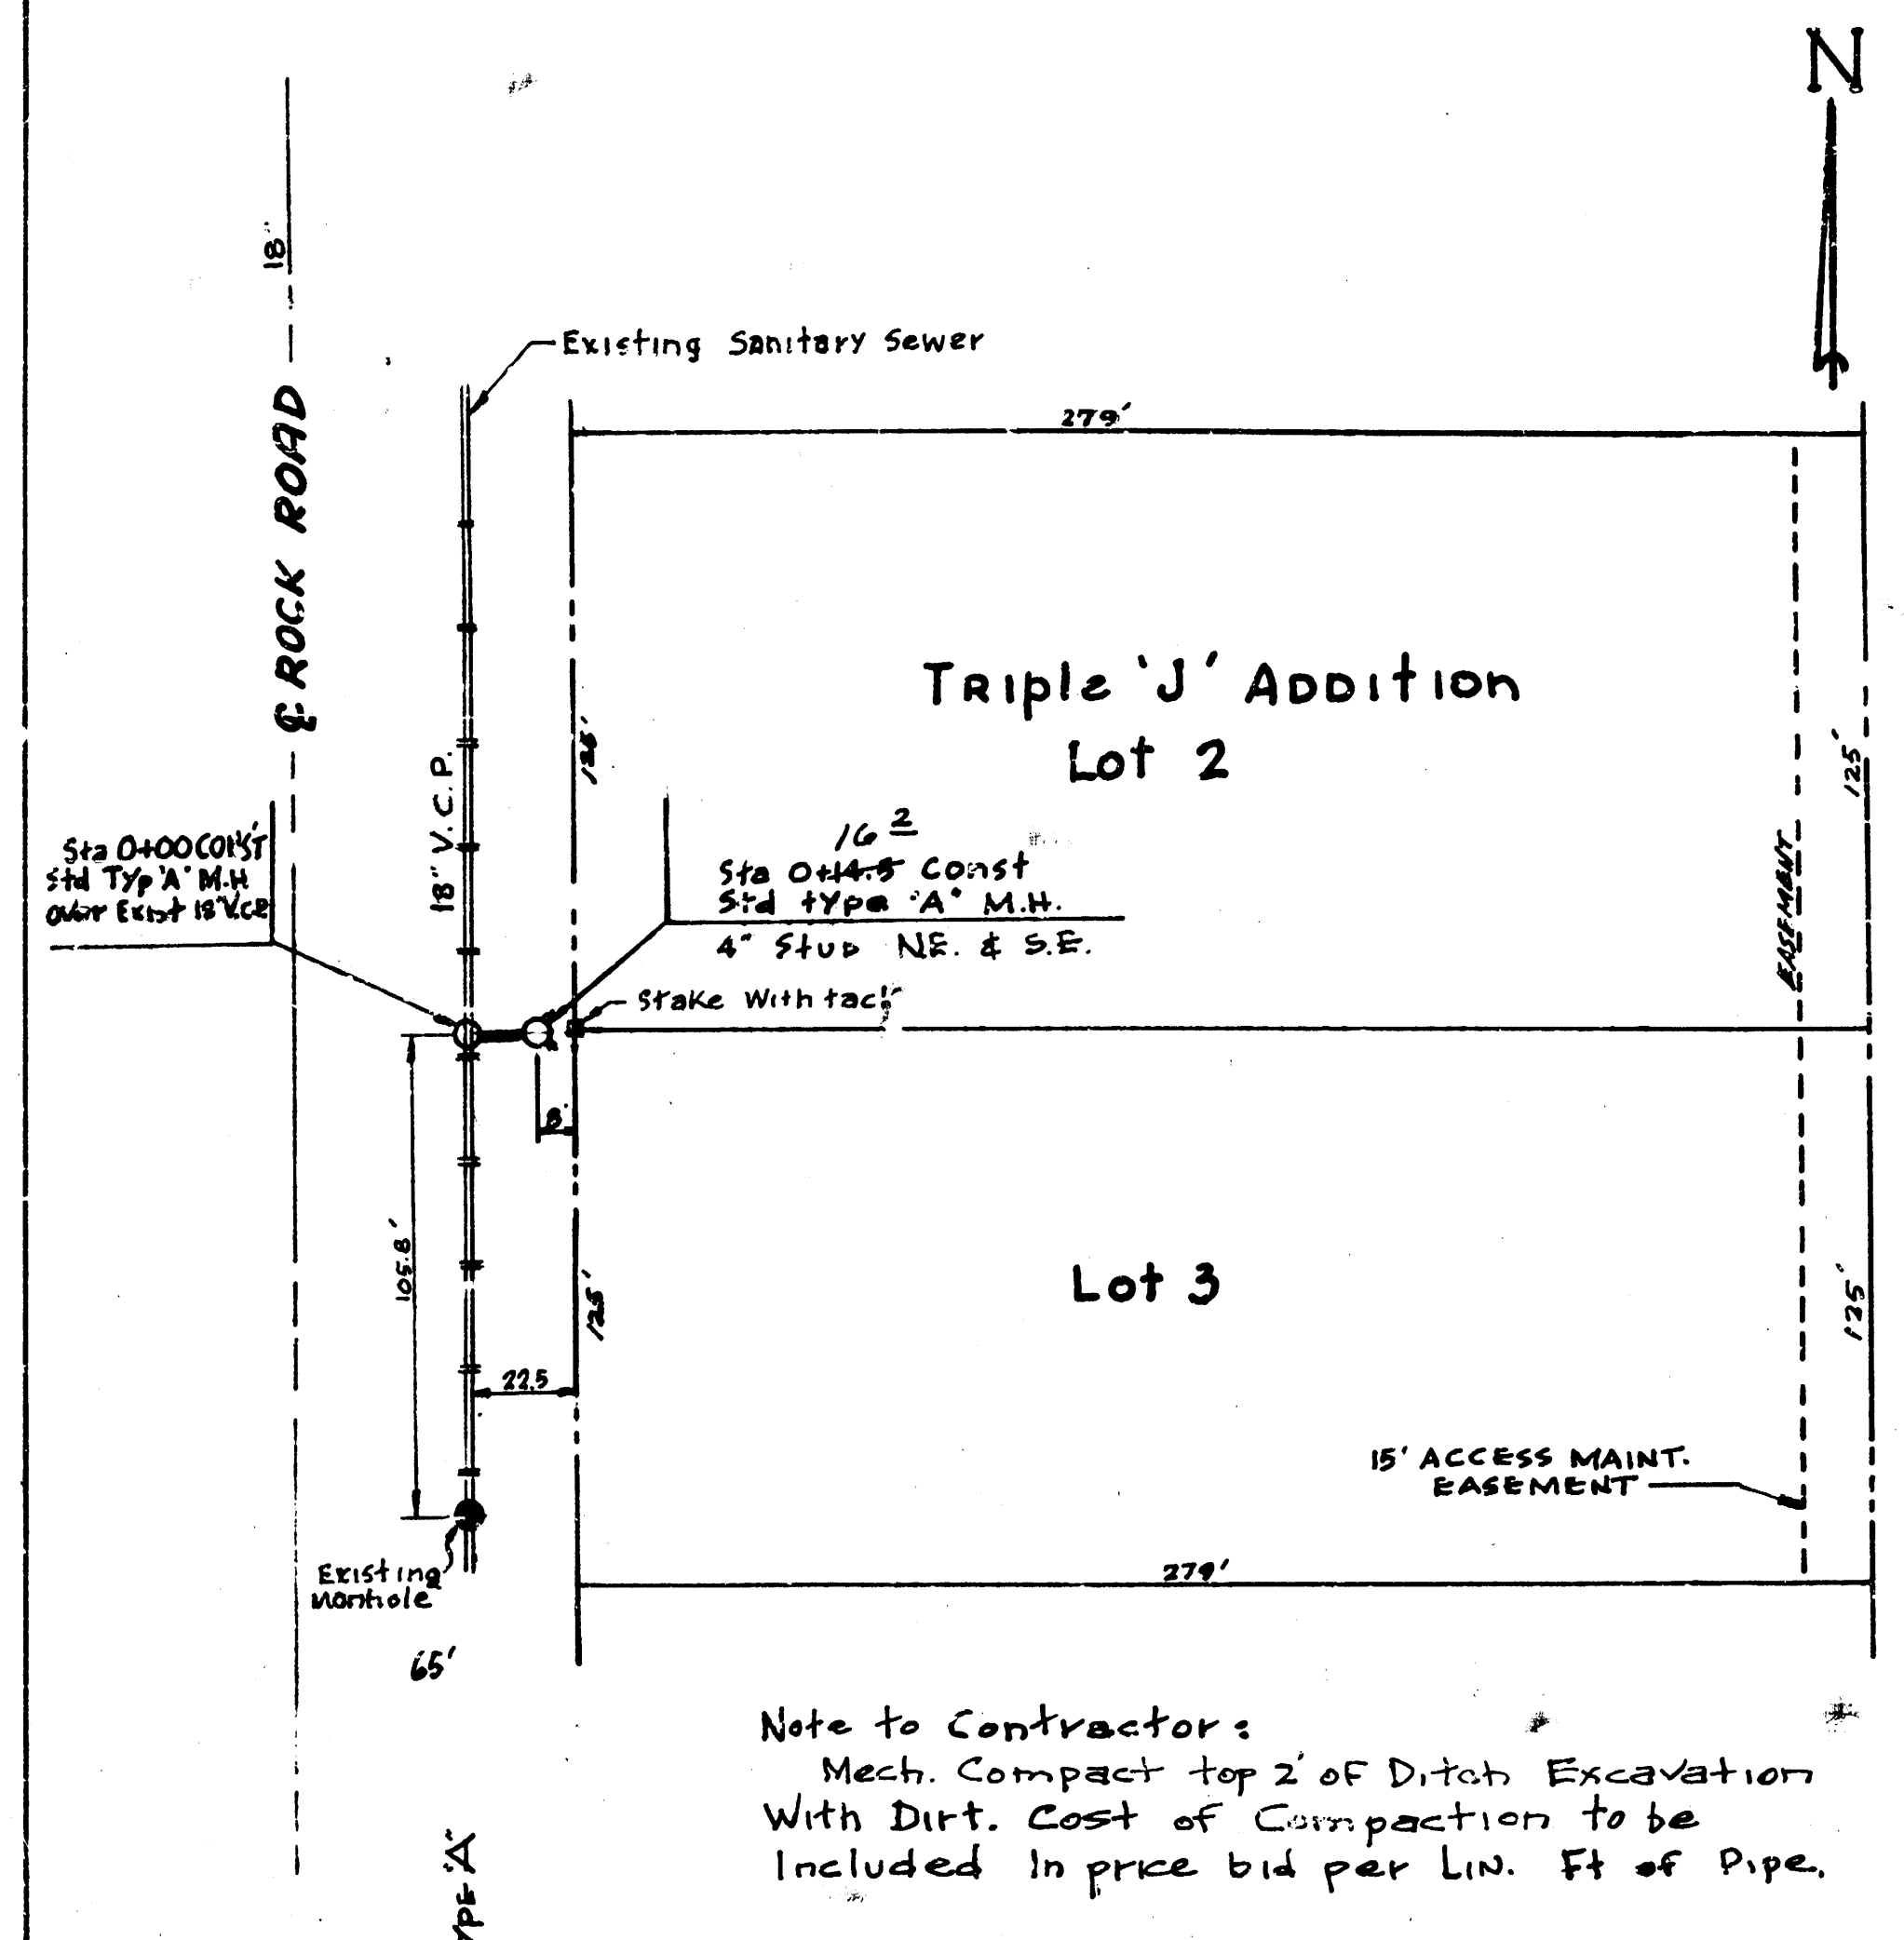
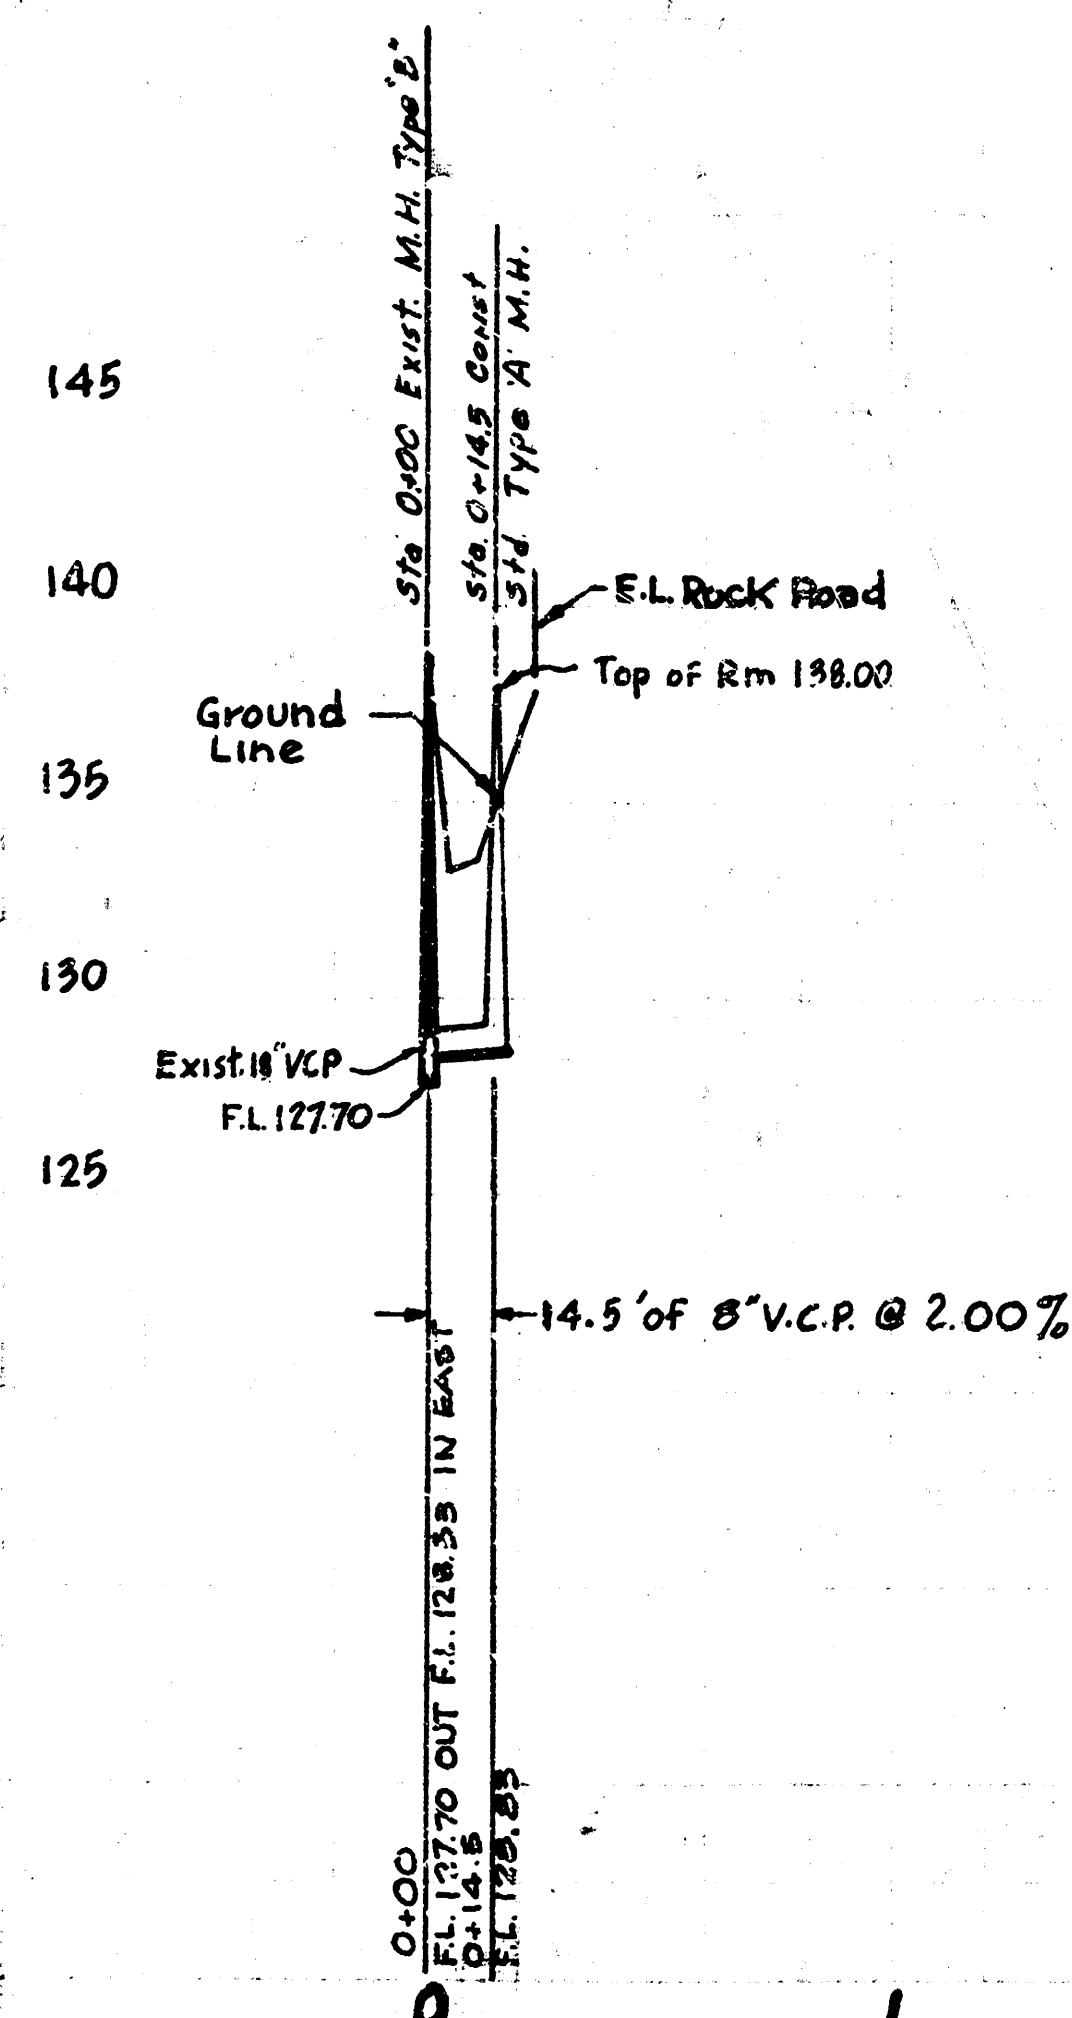


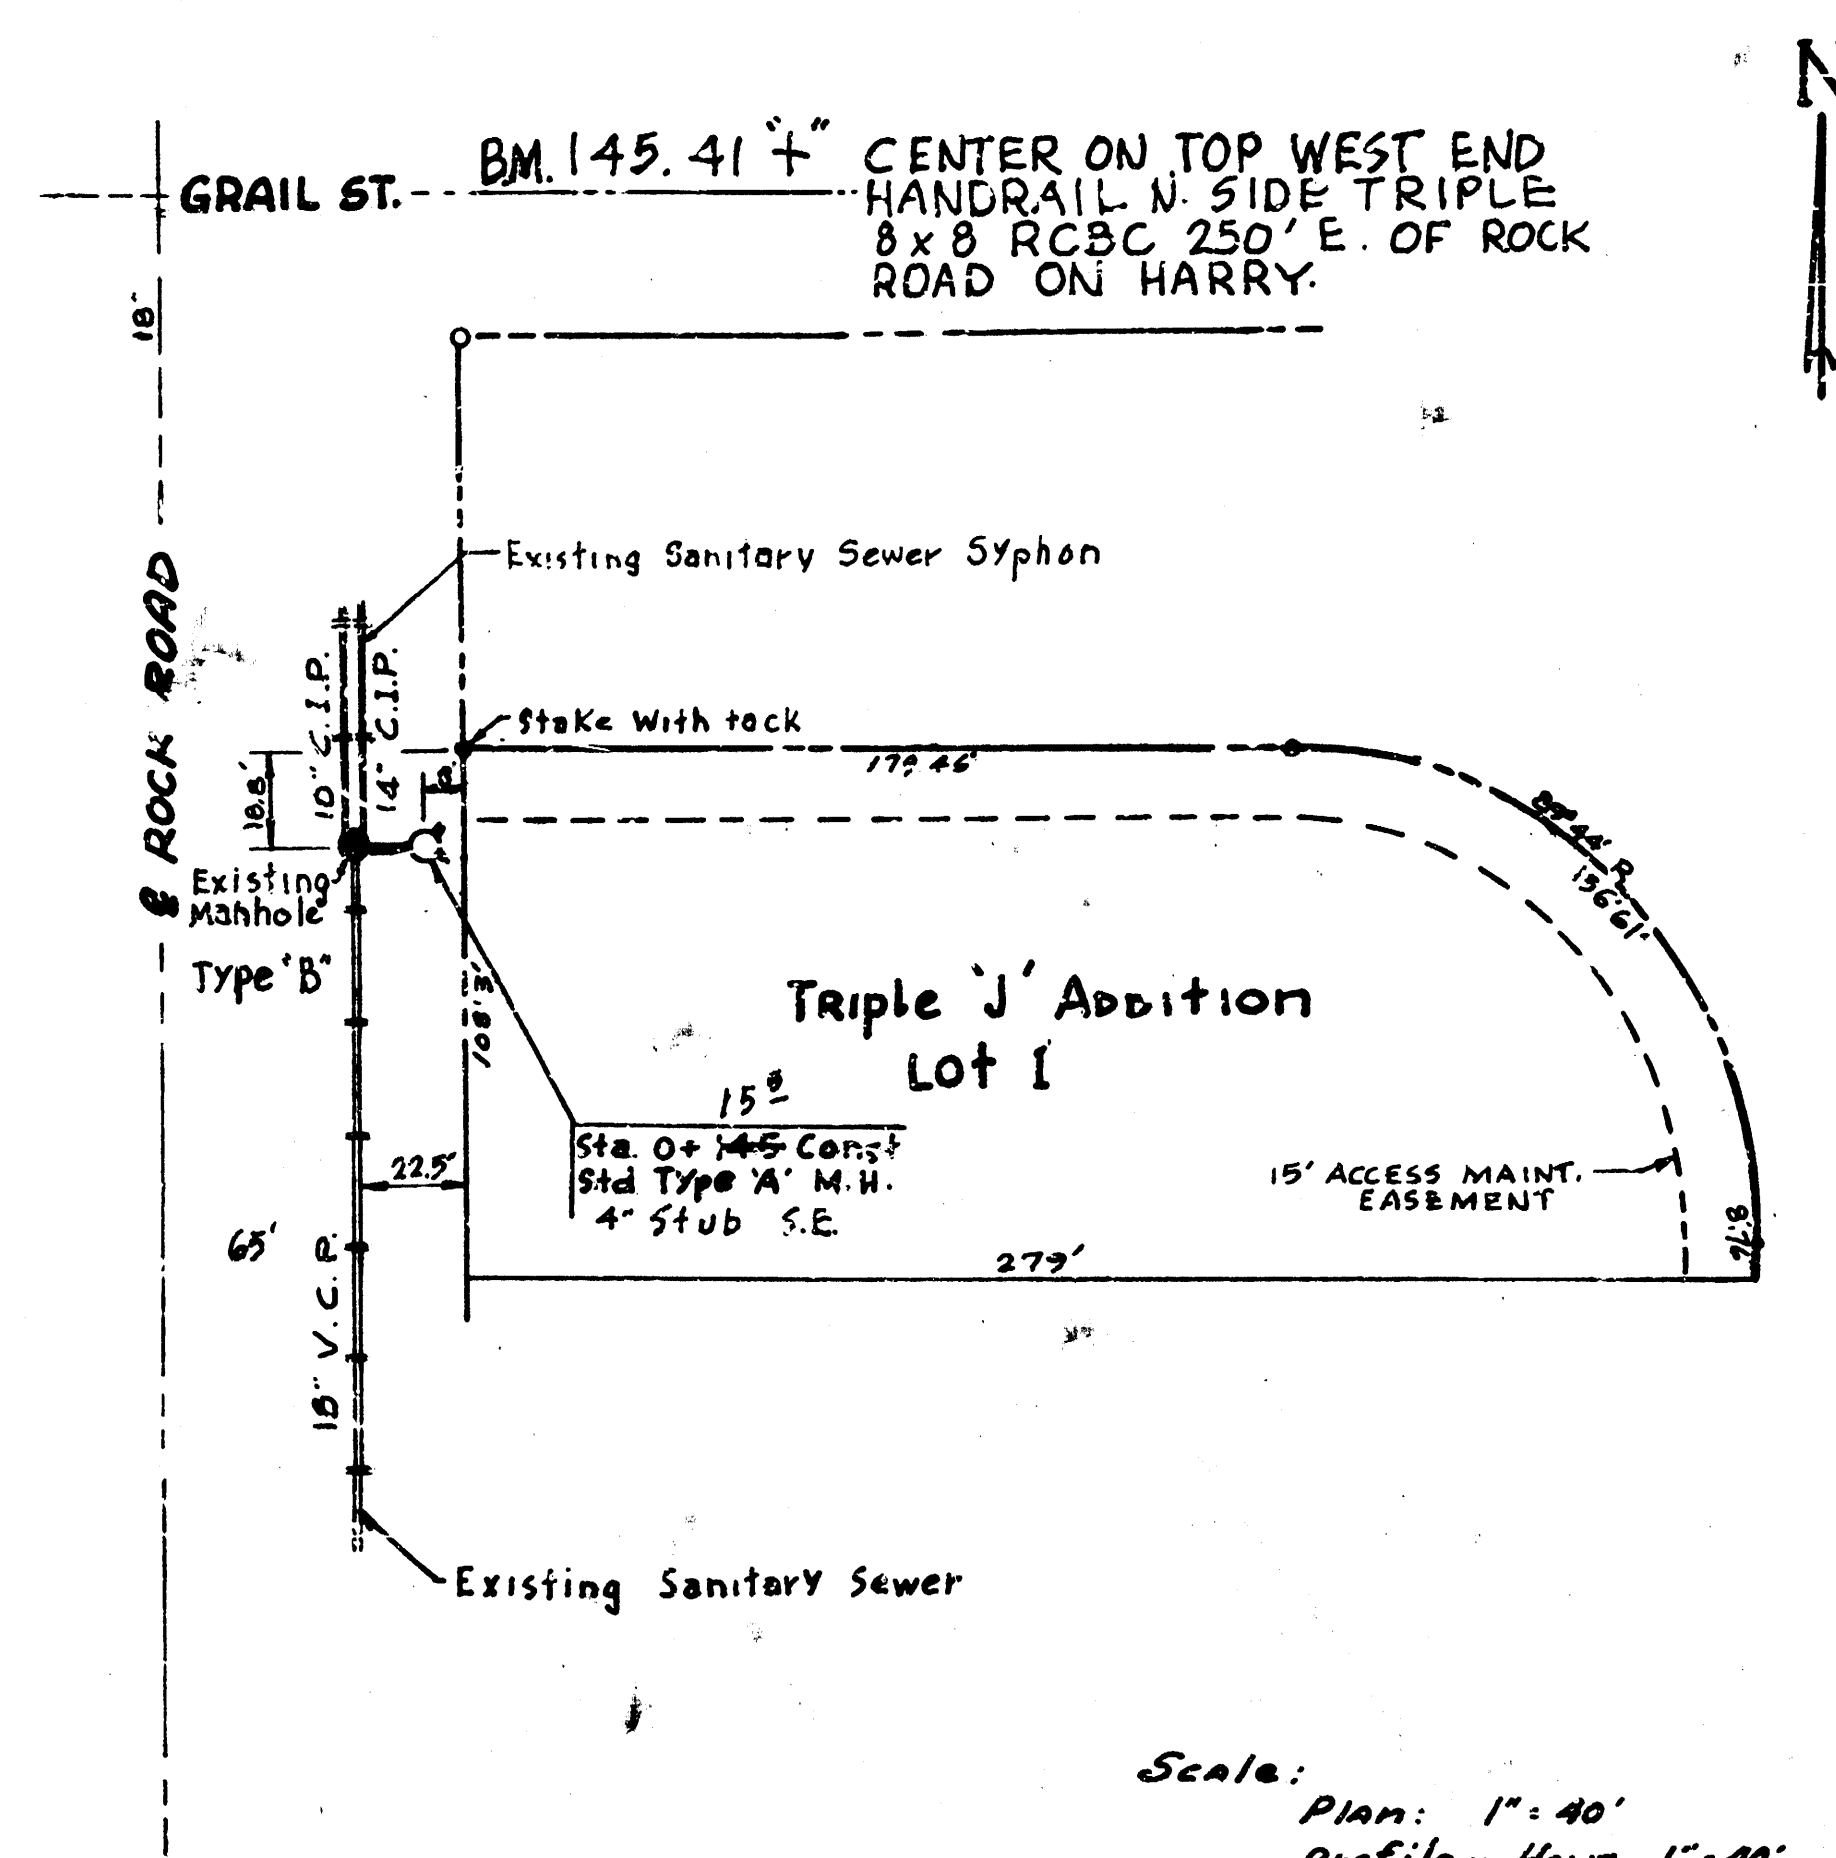

AS BUILT Final Map 277-Y

LAT. 9, MAIN 16, W. 1. S.
CITY OF WICHITA, KANSAS
R.W. LINN, CITY ENGINEER
PROJECT NO. DBK L 573079
DATE: FEB. 1974