



BM 145.41 Chiseled "+" in center on top West end handrail on North Side of triple 8x8 RCBC 250 ft. East of Rock Rd. on Hwy.

BM 139.64 Chiseled "□" in N.E. corner of top of Concrete Inlet at West edge of Rock Rd. between Zimmerly and Grail St.

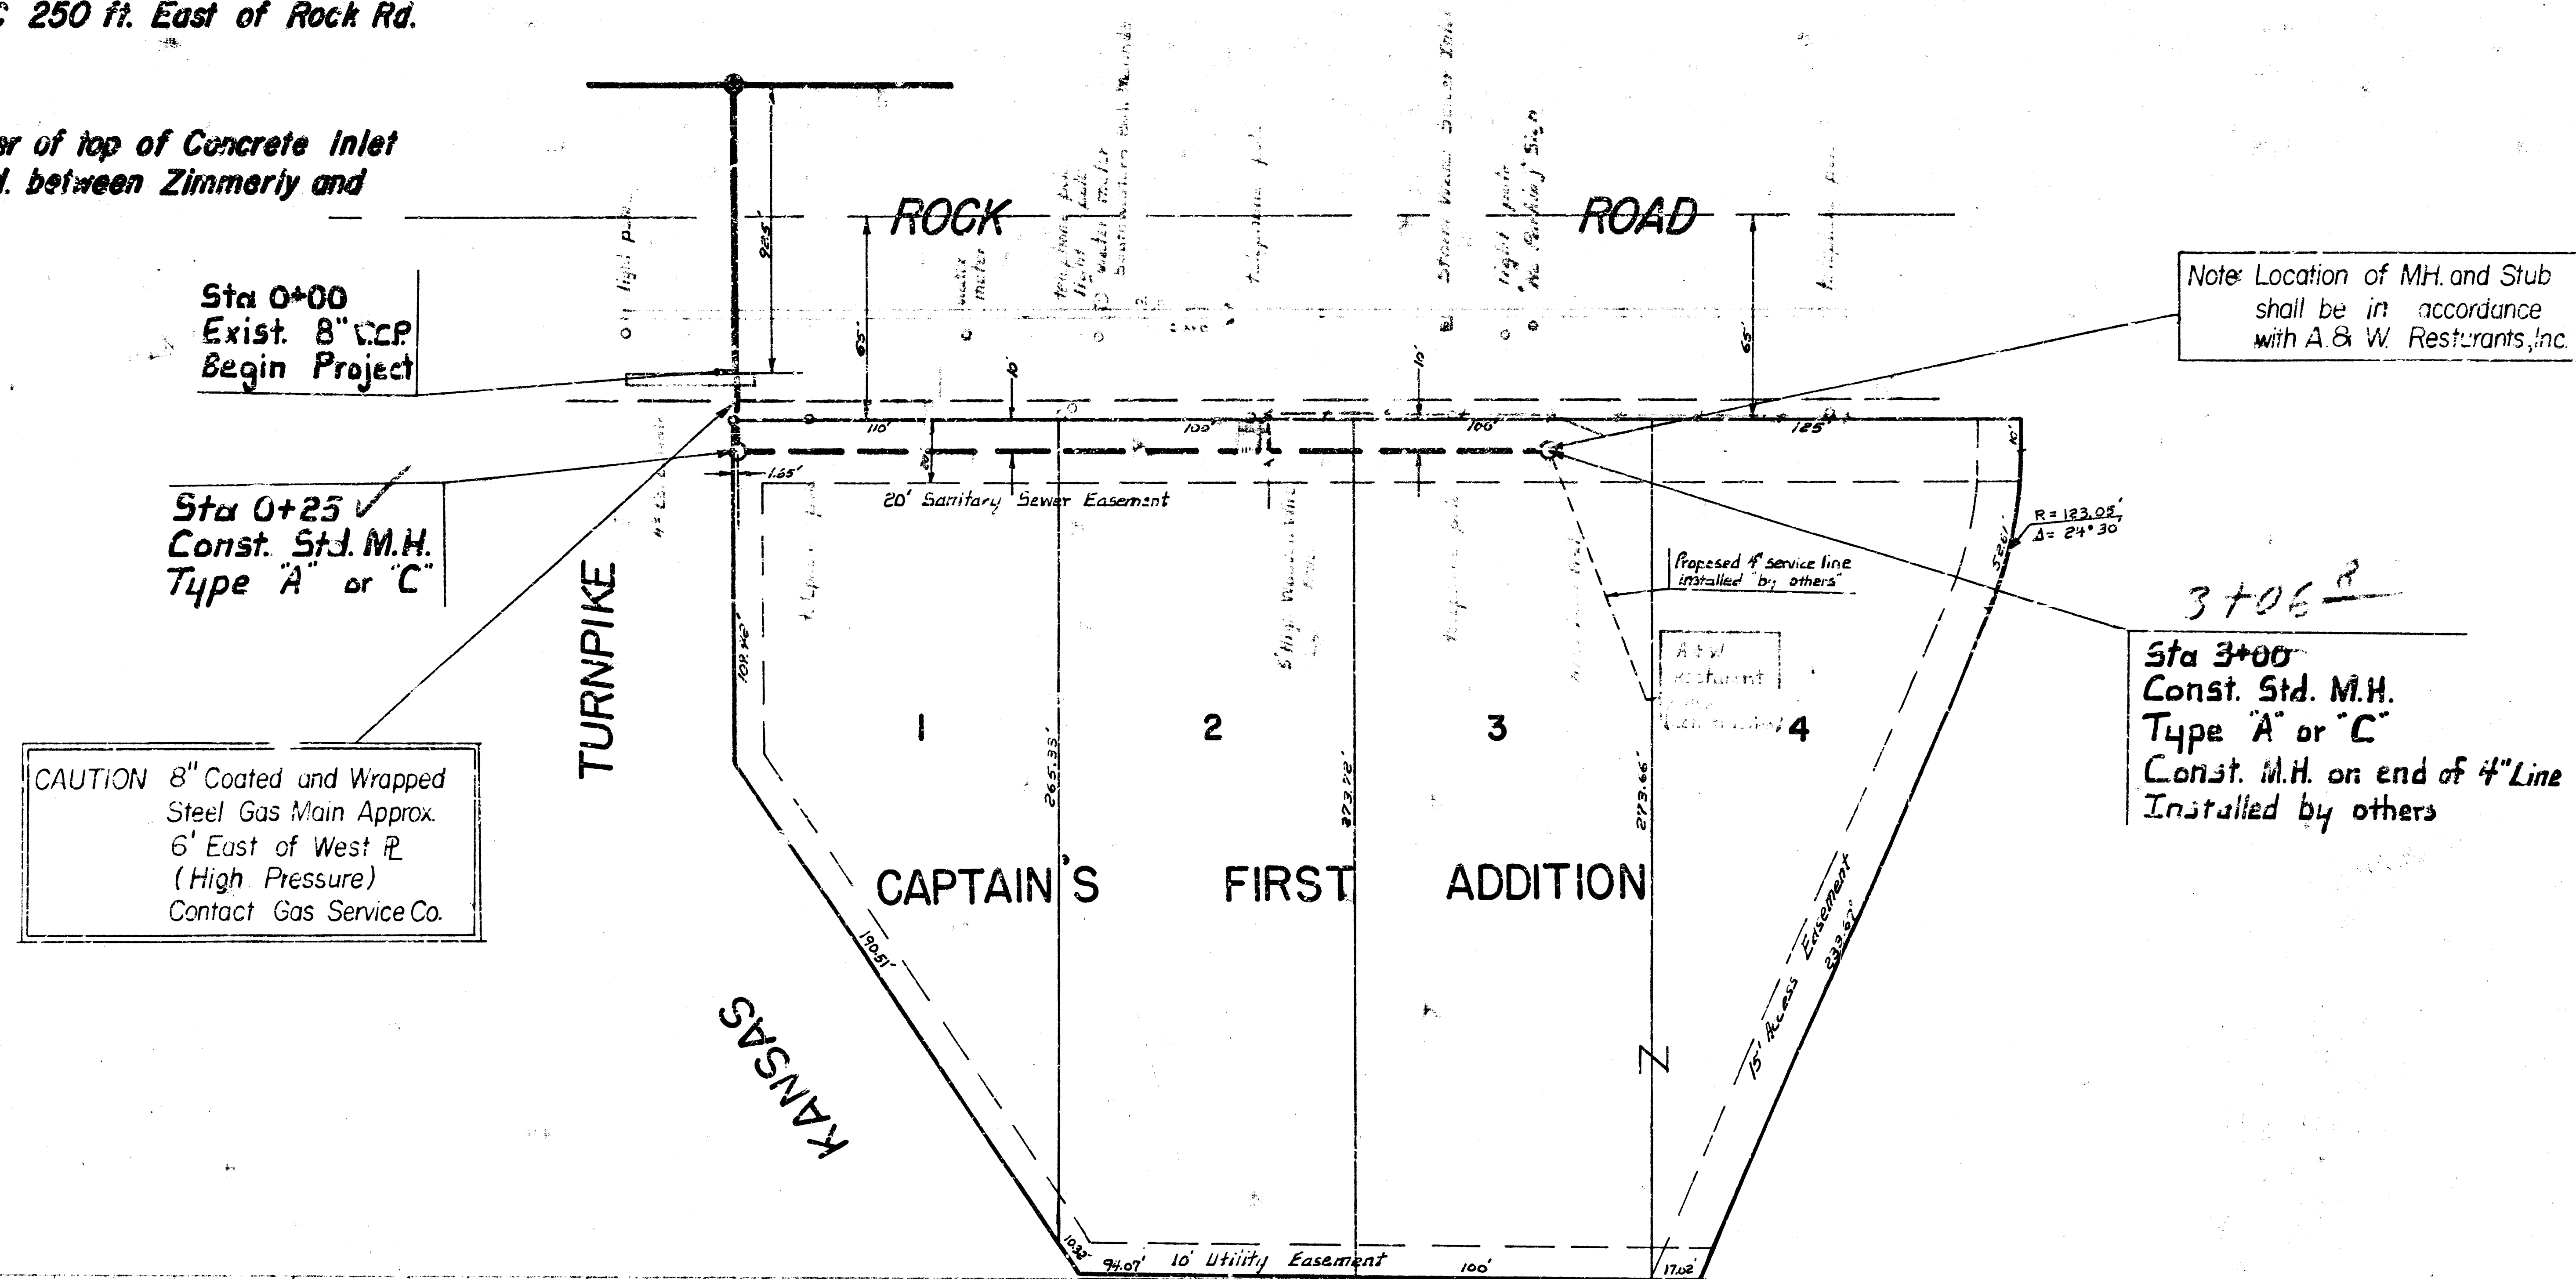

Plan Scale 1" = 40'
Profile Scale 1" = 40' vert
1" = 5' hor

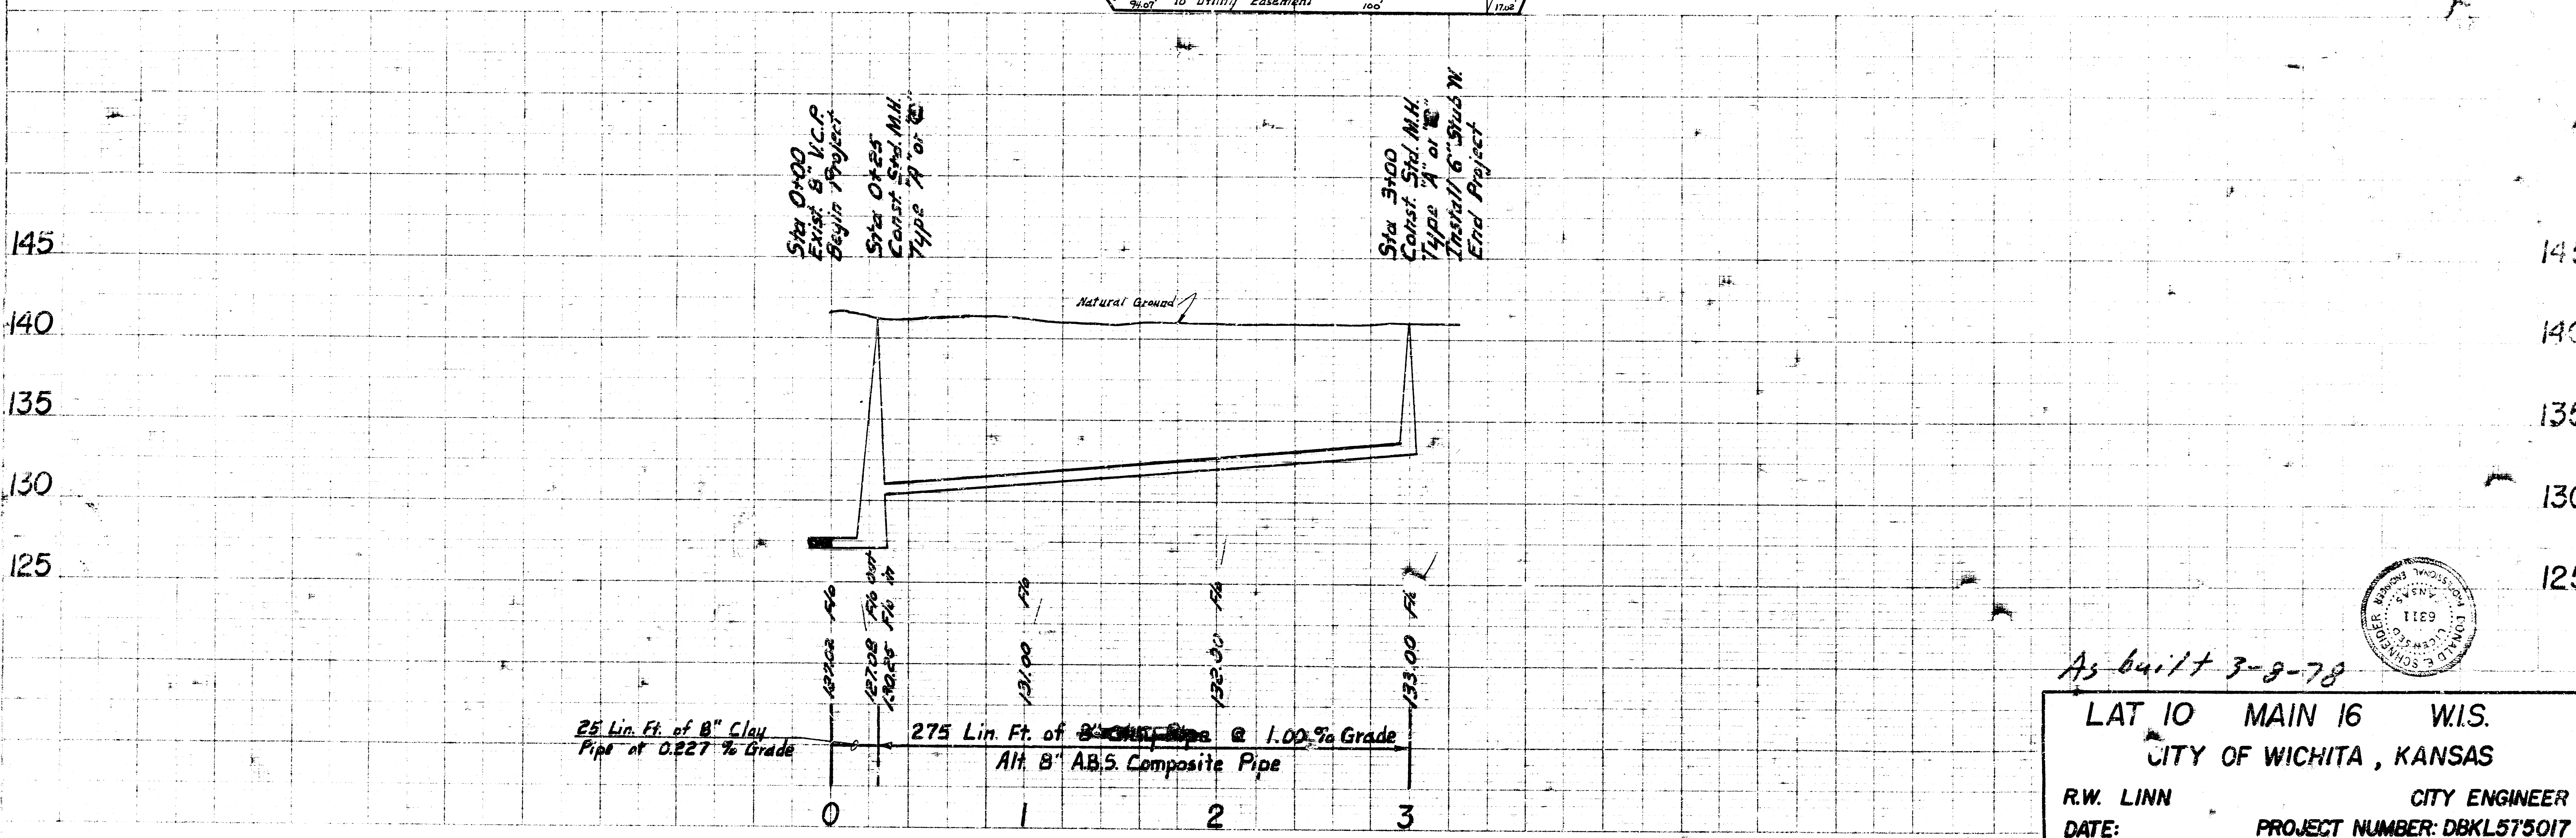

As built 3-9-78

LAT 10 MAIN 16 W.S.
CITY OF WICHITA, KANSAS

R.W. LINN CITY ENGINEER
DATE: PROJECT NUMBER: DBKL575017