




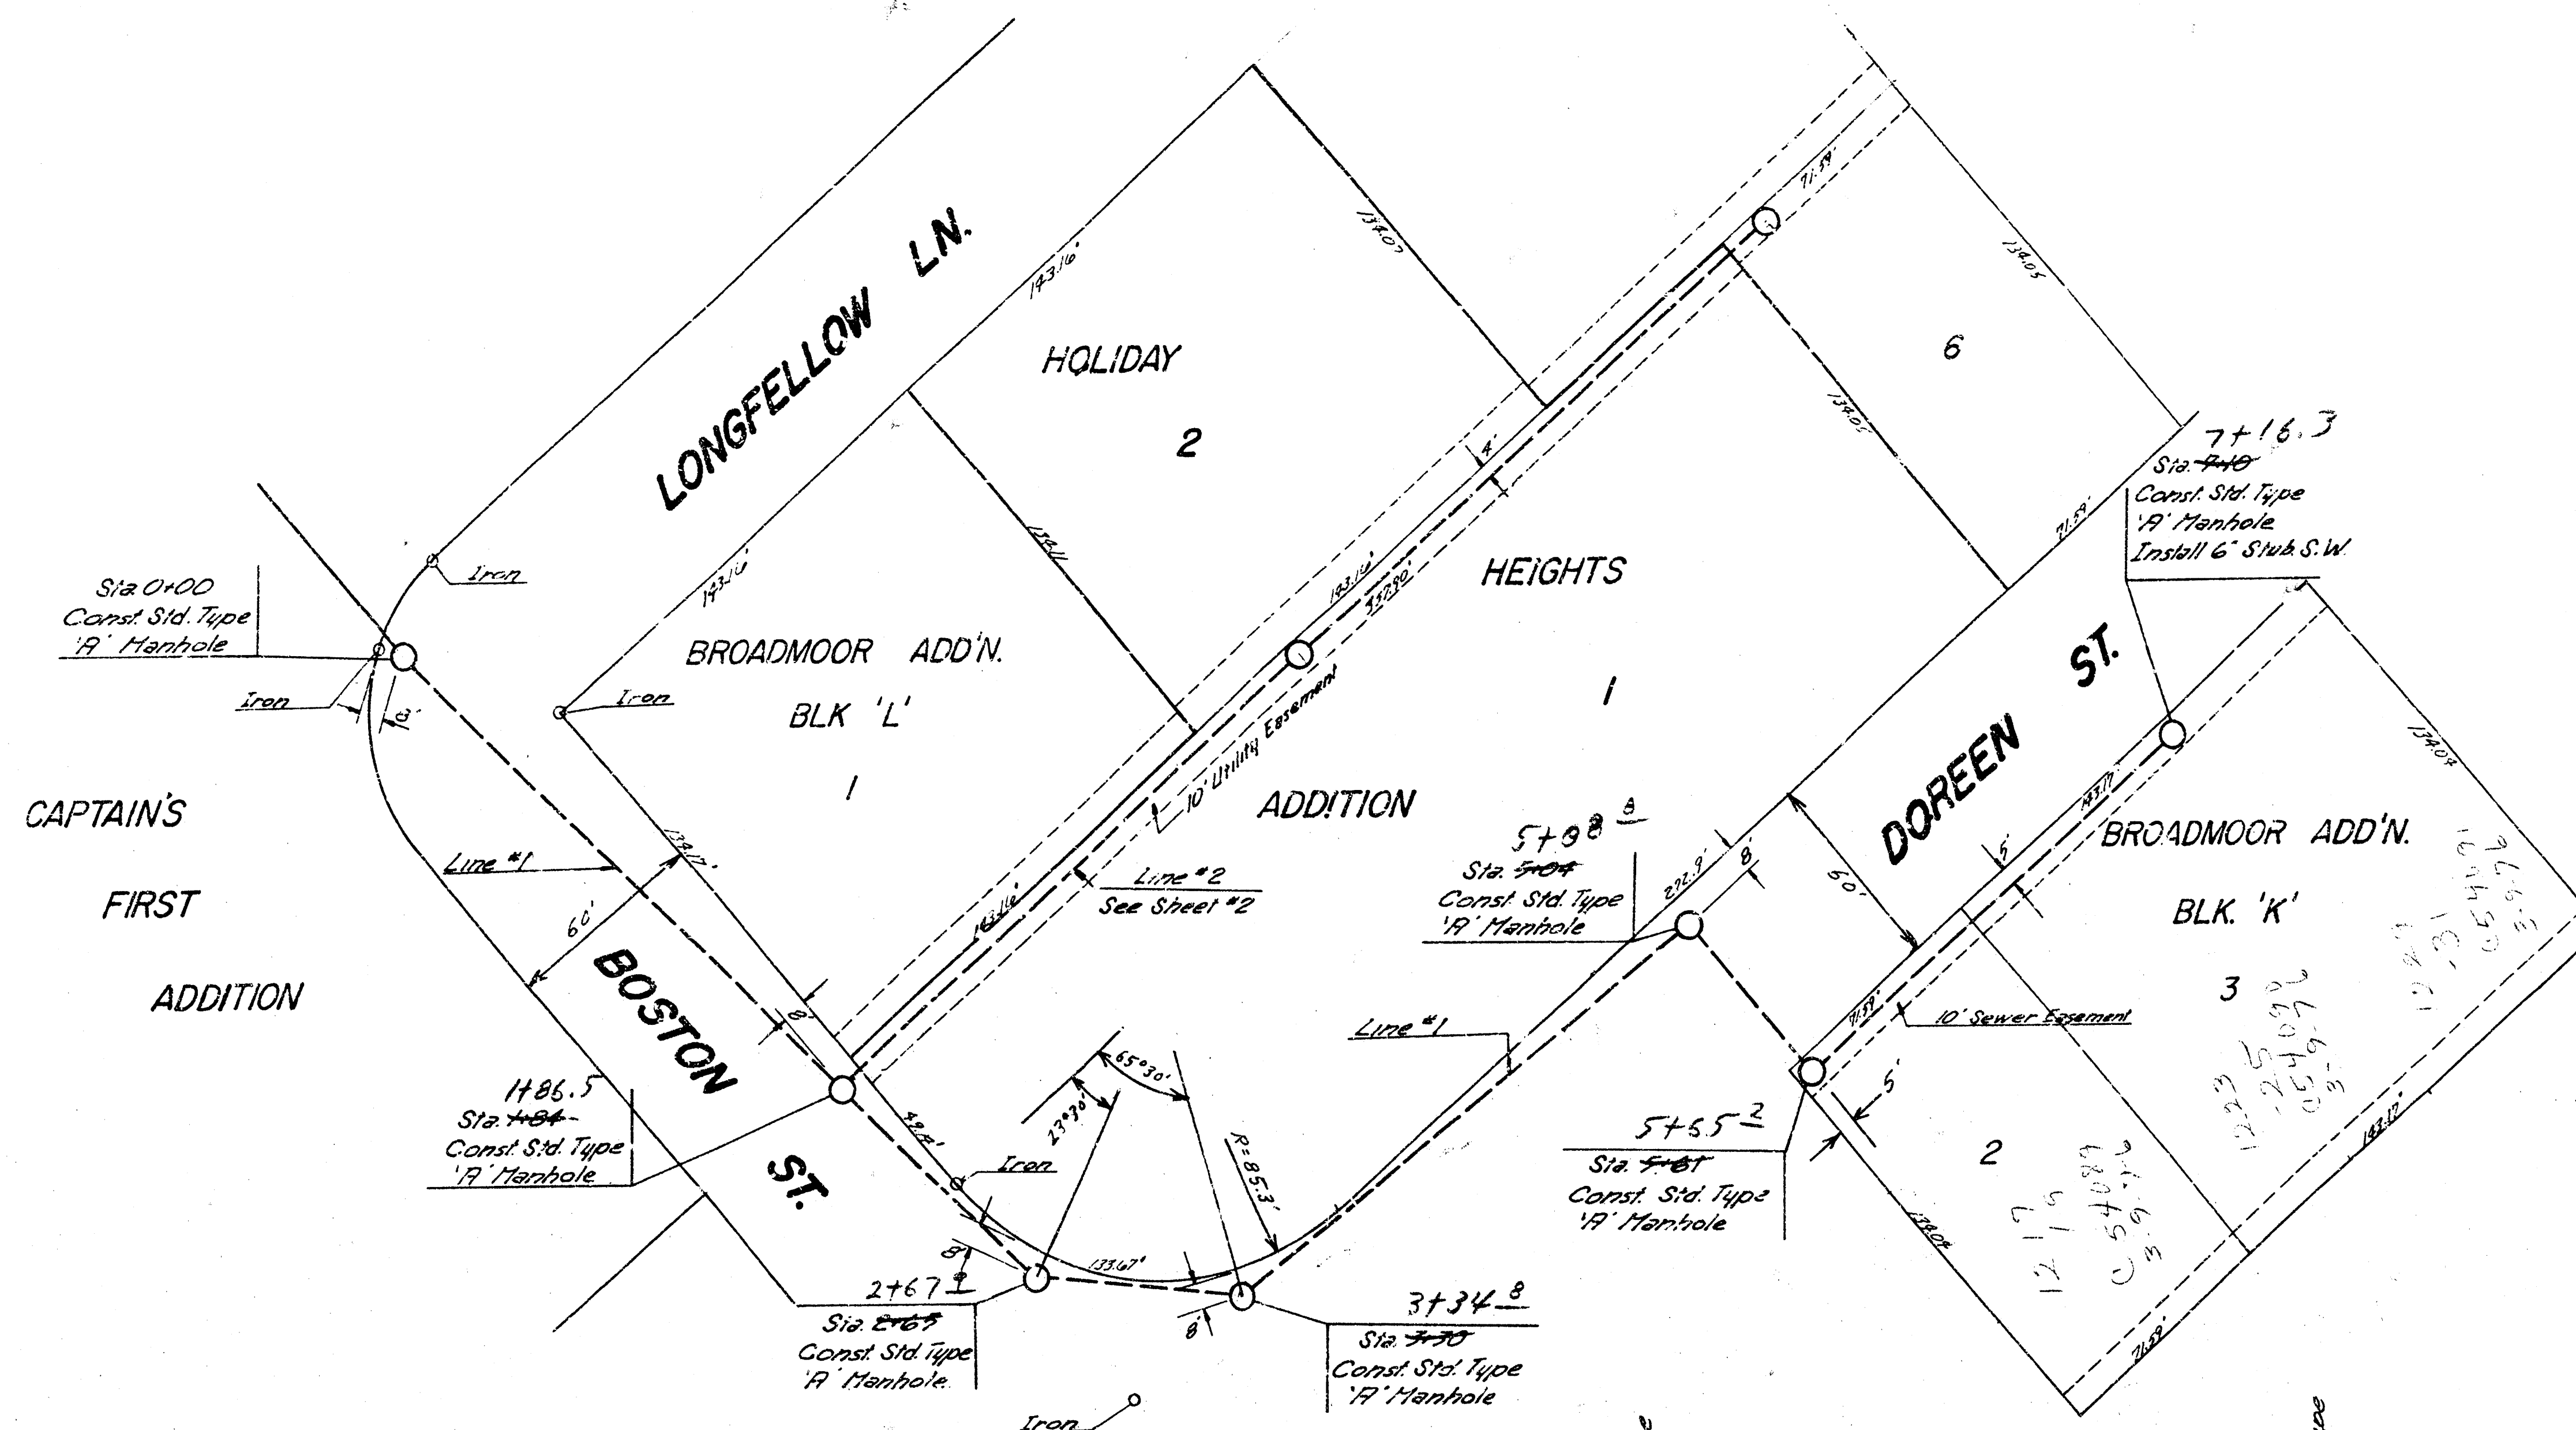

B.M. 145.4' Chiseled "X" in Ctr. of top W. End Handrail N.S. Triple 8x8 R.C.B. 250' East of Rock Rd. on Harry

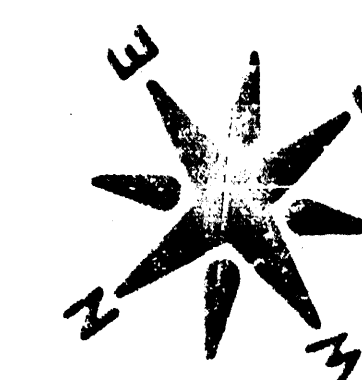


SCALES:
PLAN: 1"=40'
PROFILE: 1"=40'
VERT. 1"=5'

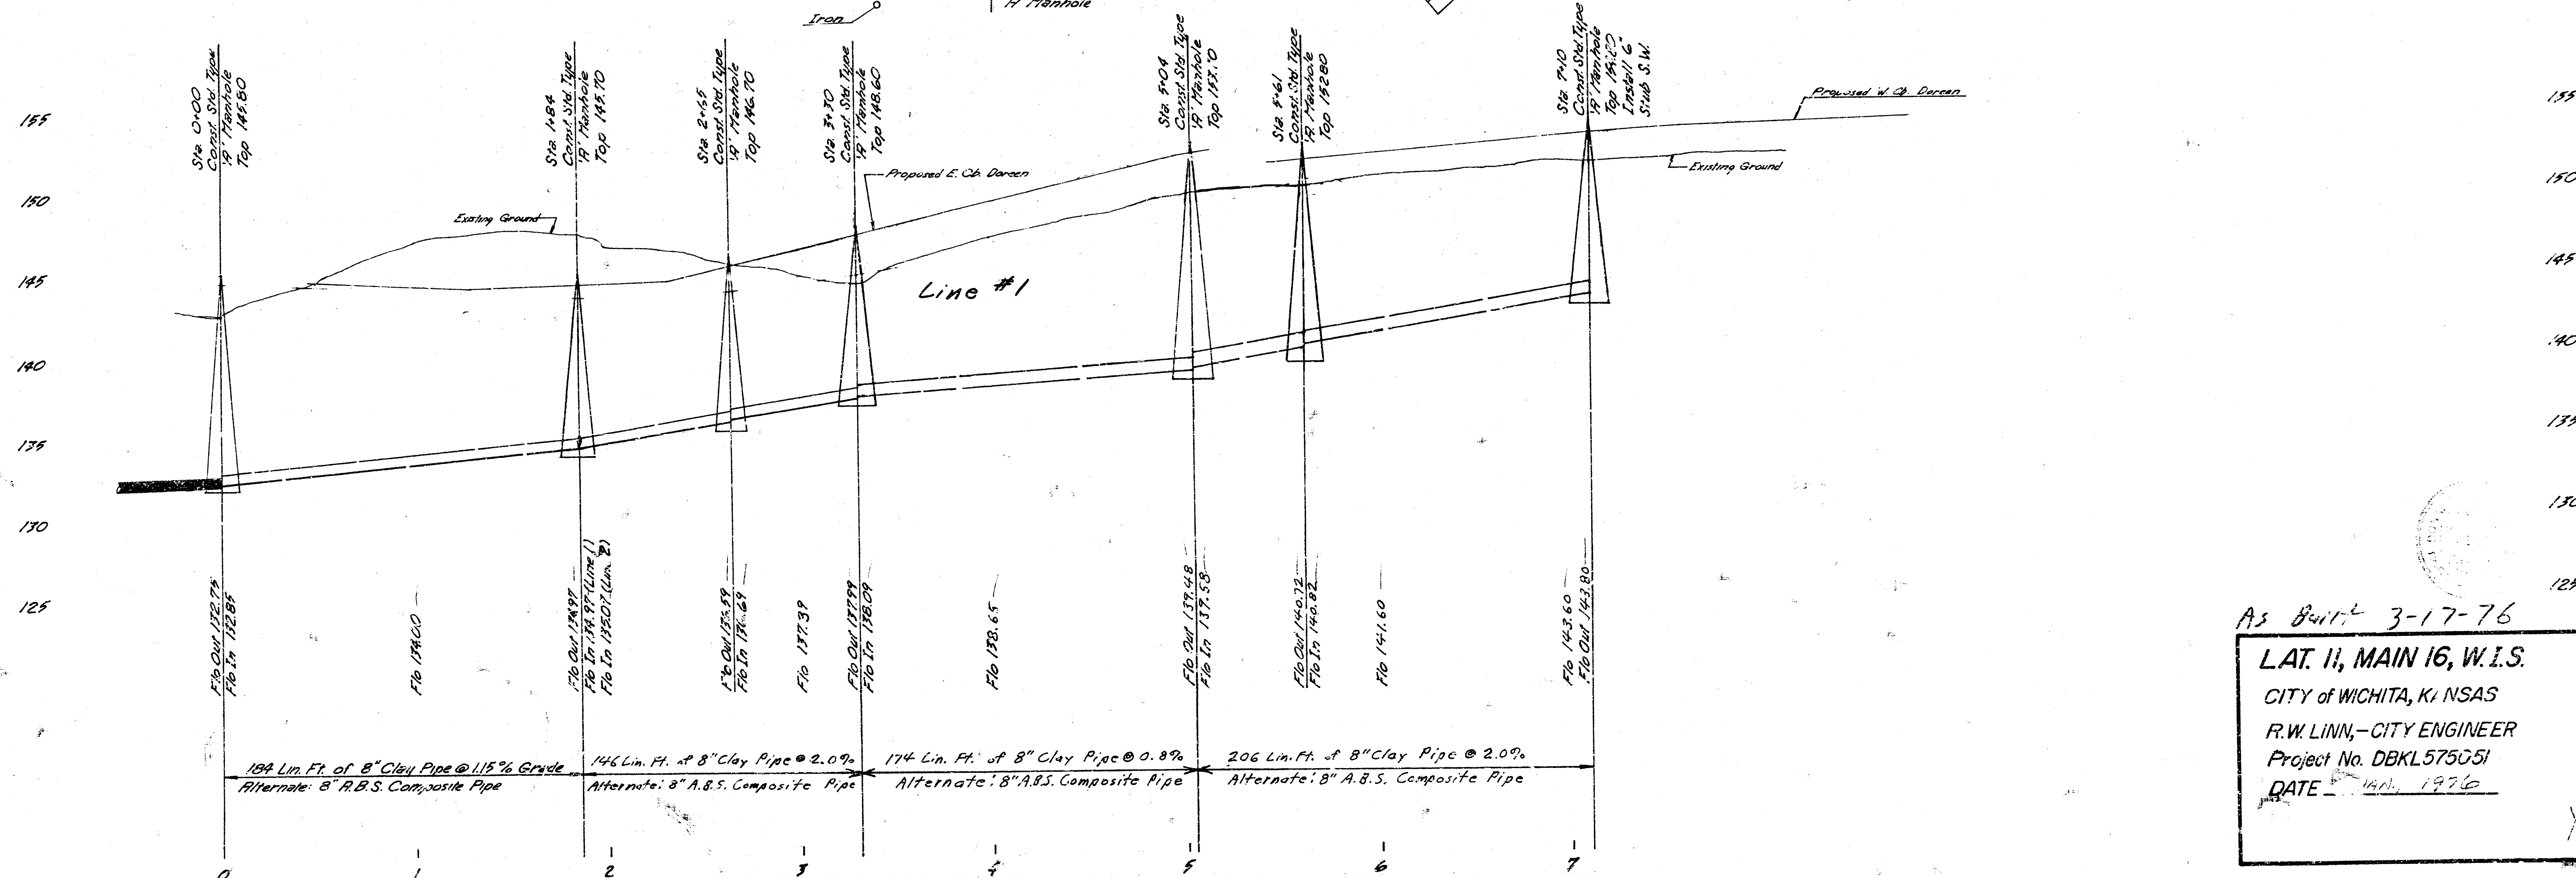

As Built 3-17-76


LAT. 11, MAIN 16, W.I.S.
CITY OF WICHITA, KANSAS
R.W. LINN, CITY ENGINEER
Project No. DBKL575051
DATE: JAN. 1976

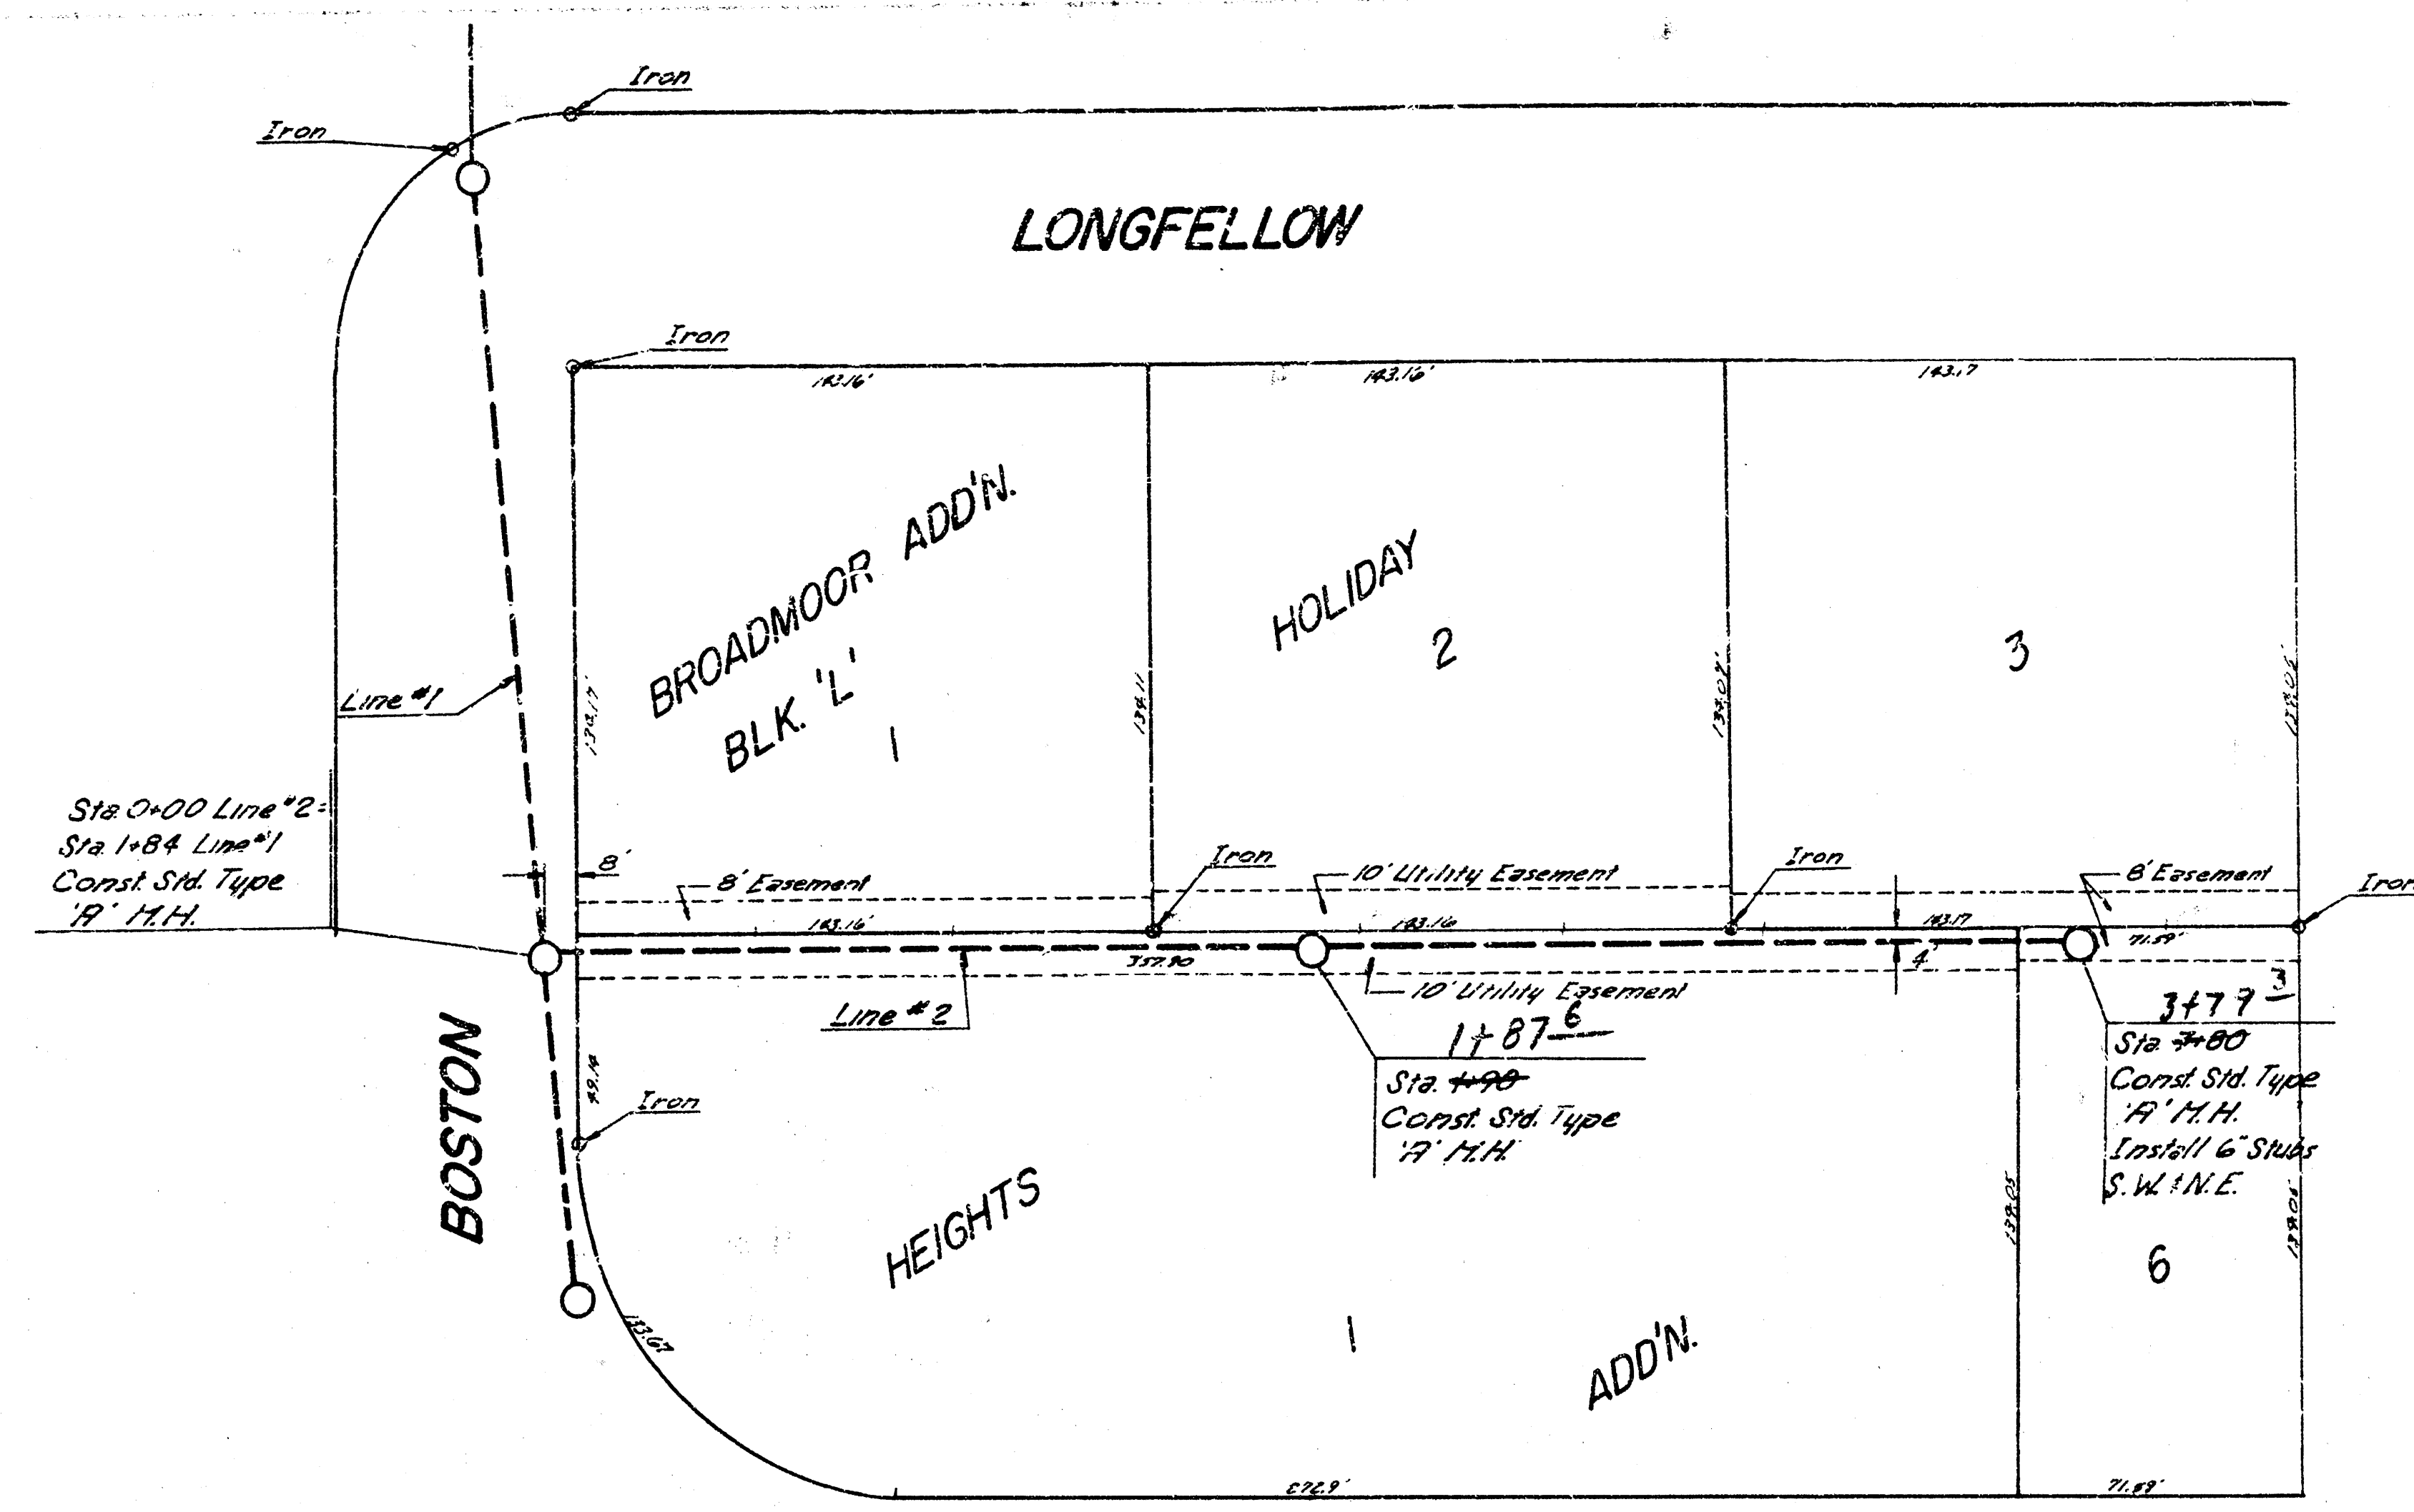

B.M. 145.41 Chiseled "X" Ctr. of top W. End Handrail N.S. Triple 8x8 R.C.B. 250' East of Rock Rd. on Harry



SCALE
Plan 1"=40'
Profile
Hori 1"=40'
Vert 1"=5'

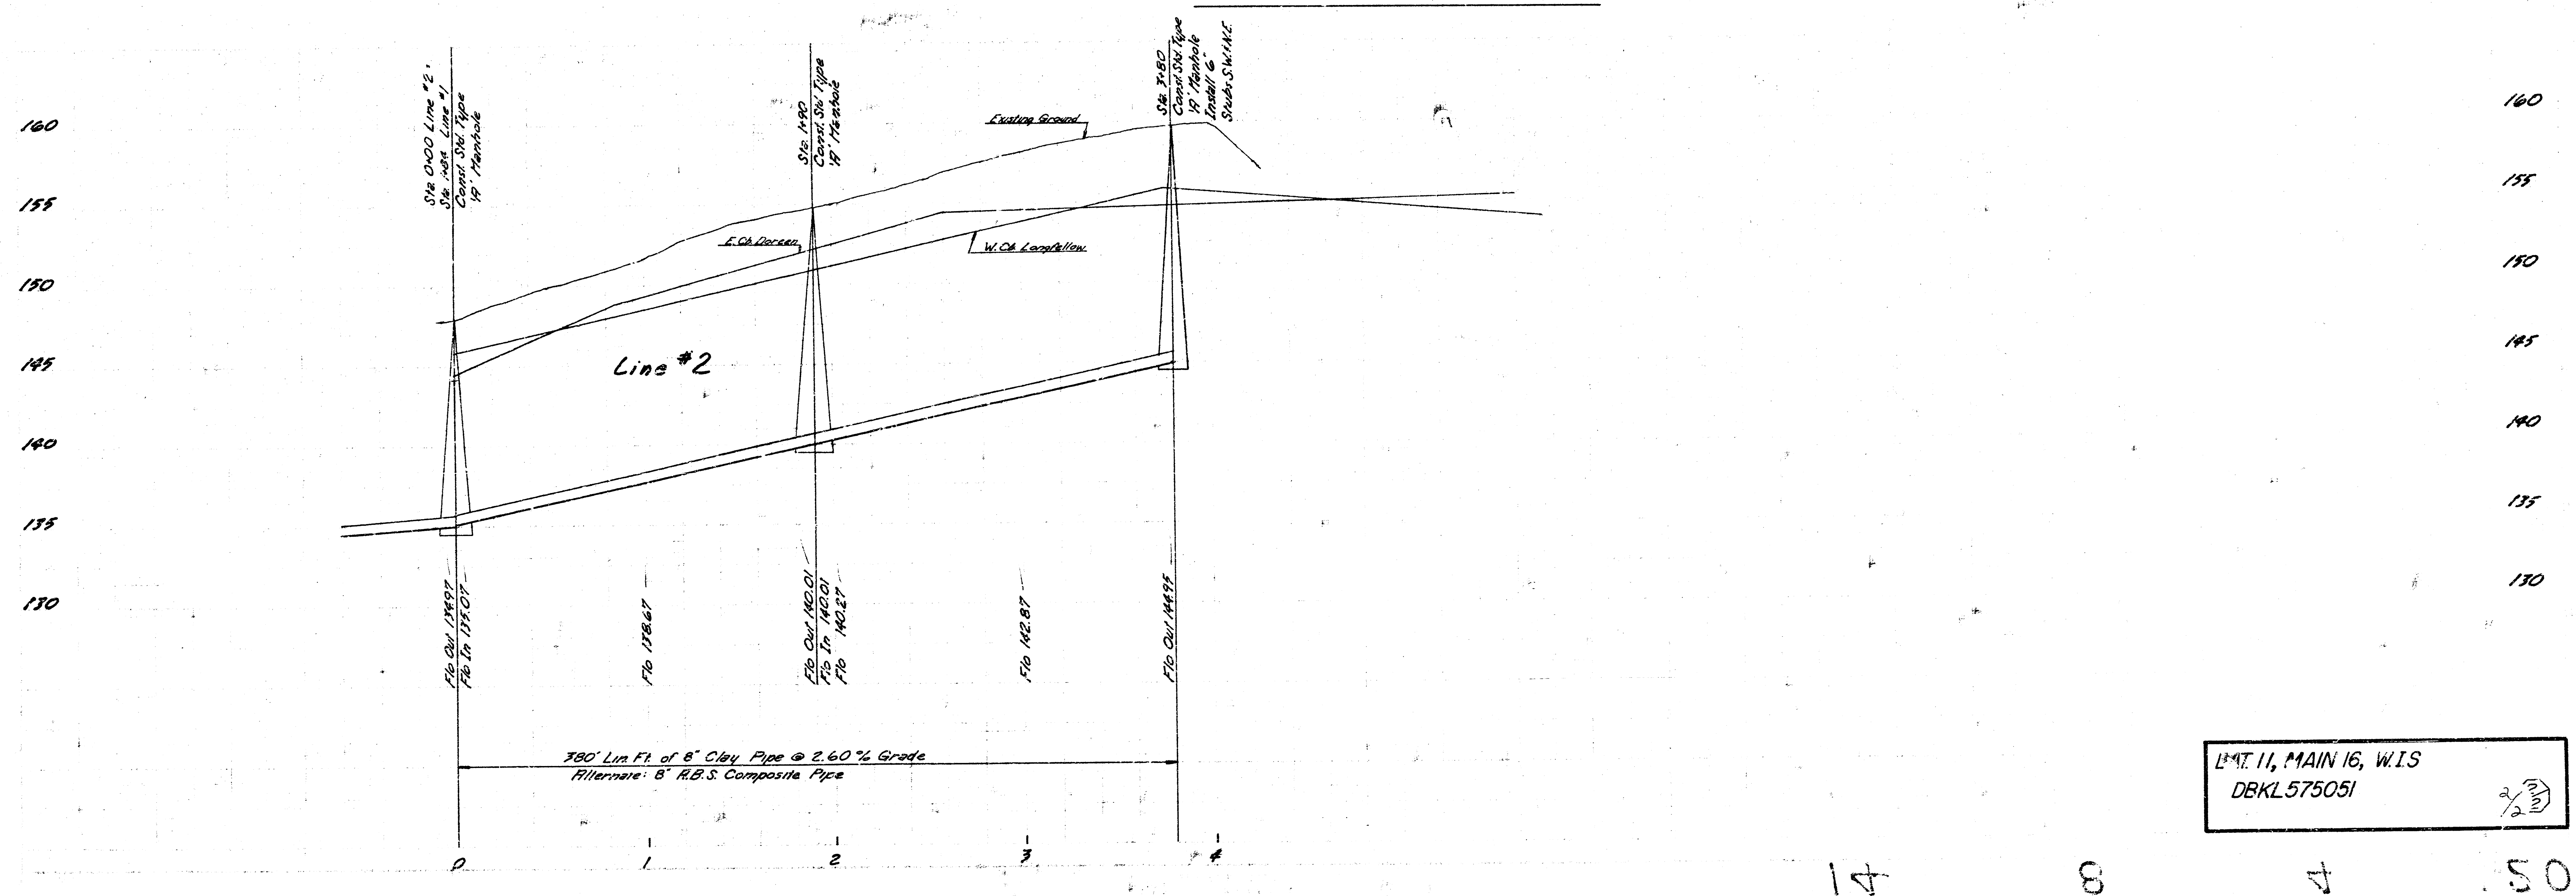

Lt. 11, MAIN 16, W.I.S
DEKL575051

14 8 4 50