




MAIN 17, WAR INDUSTRIES SEWER
 CITY OF WICHITA, KANSAS
 R. W. LINN — CITY ENGINEER
 JULY 1973, PROJECT NO. DBKM 573034

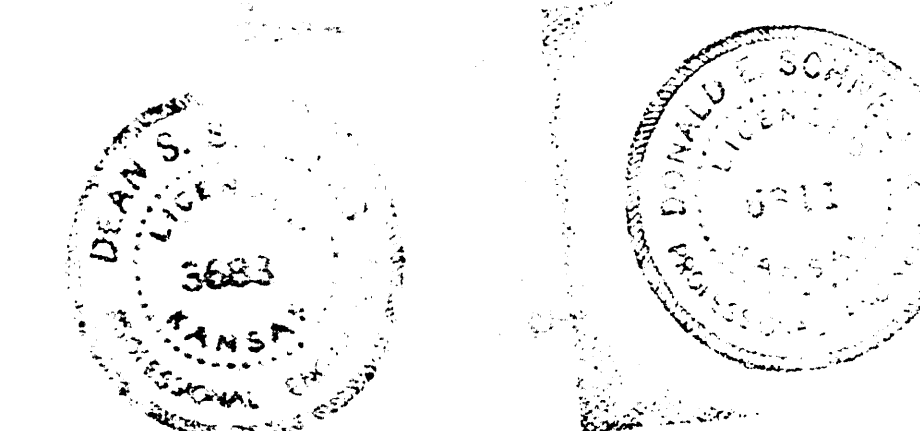

"As Built" Final Meas. 280-9
 MAIN 17, WAR INDUSTRIES SEWER
 PROJECT NO. DBK M573034

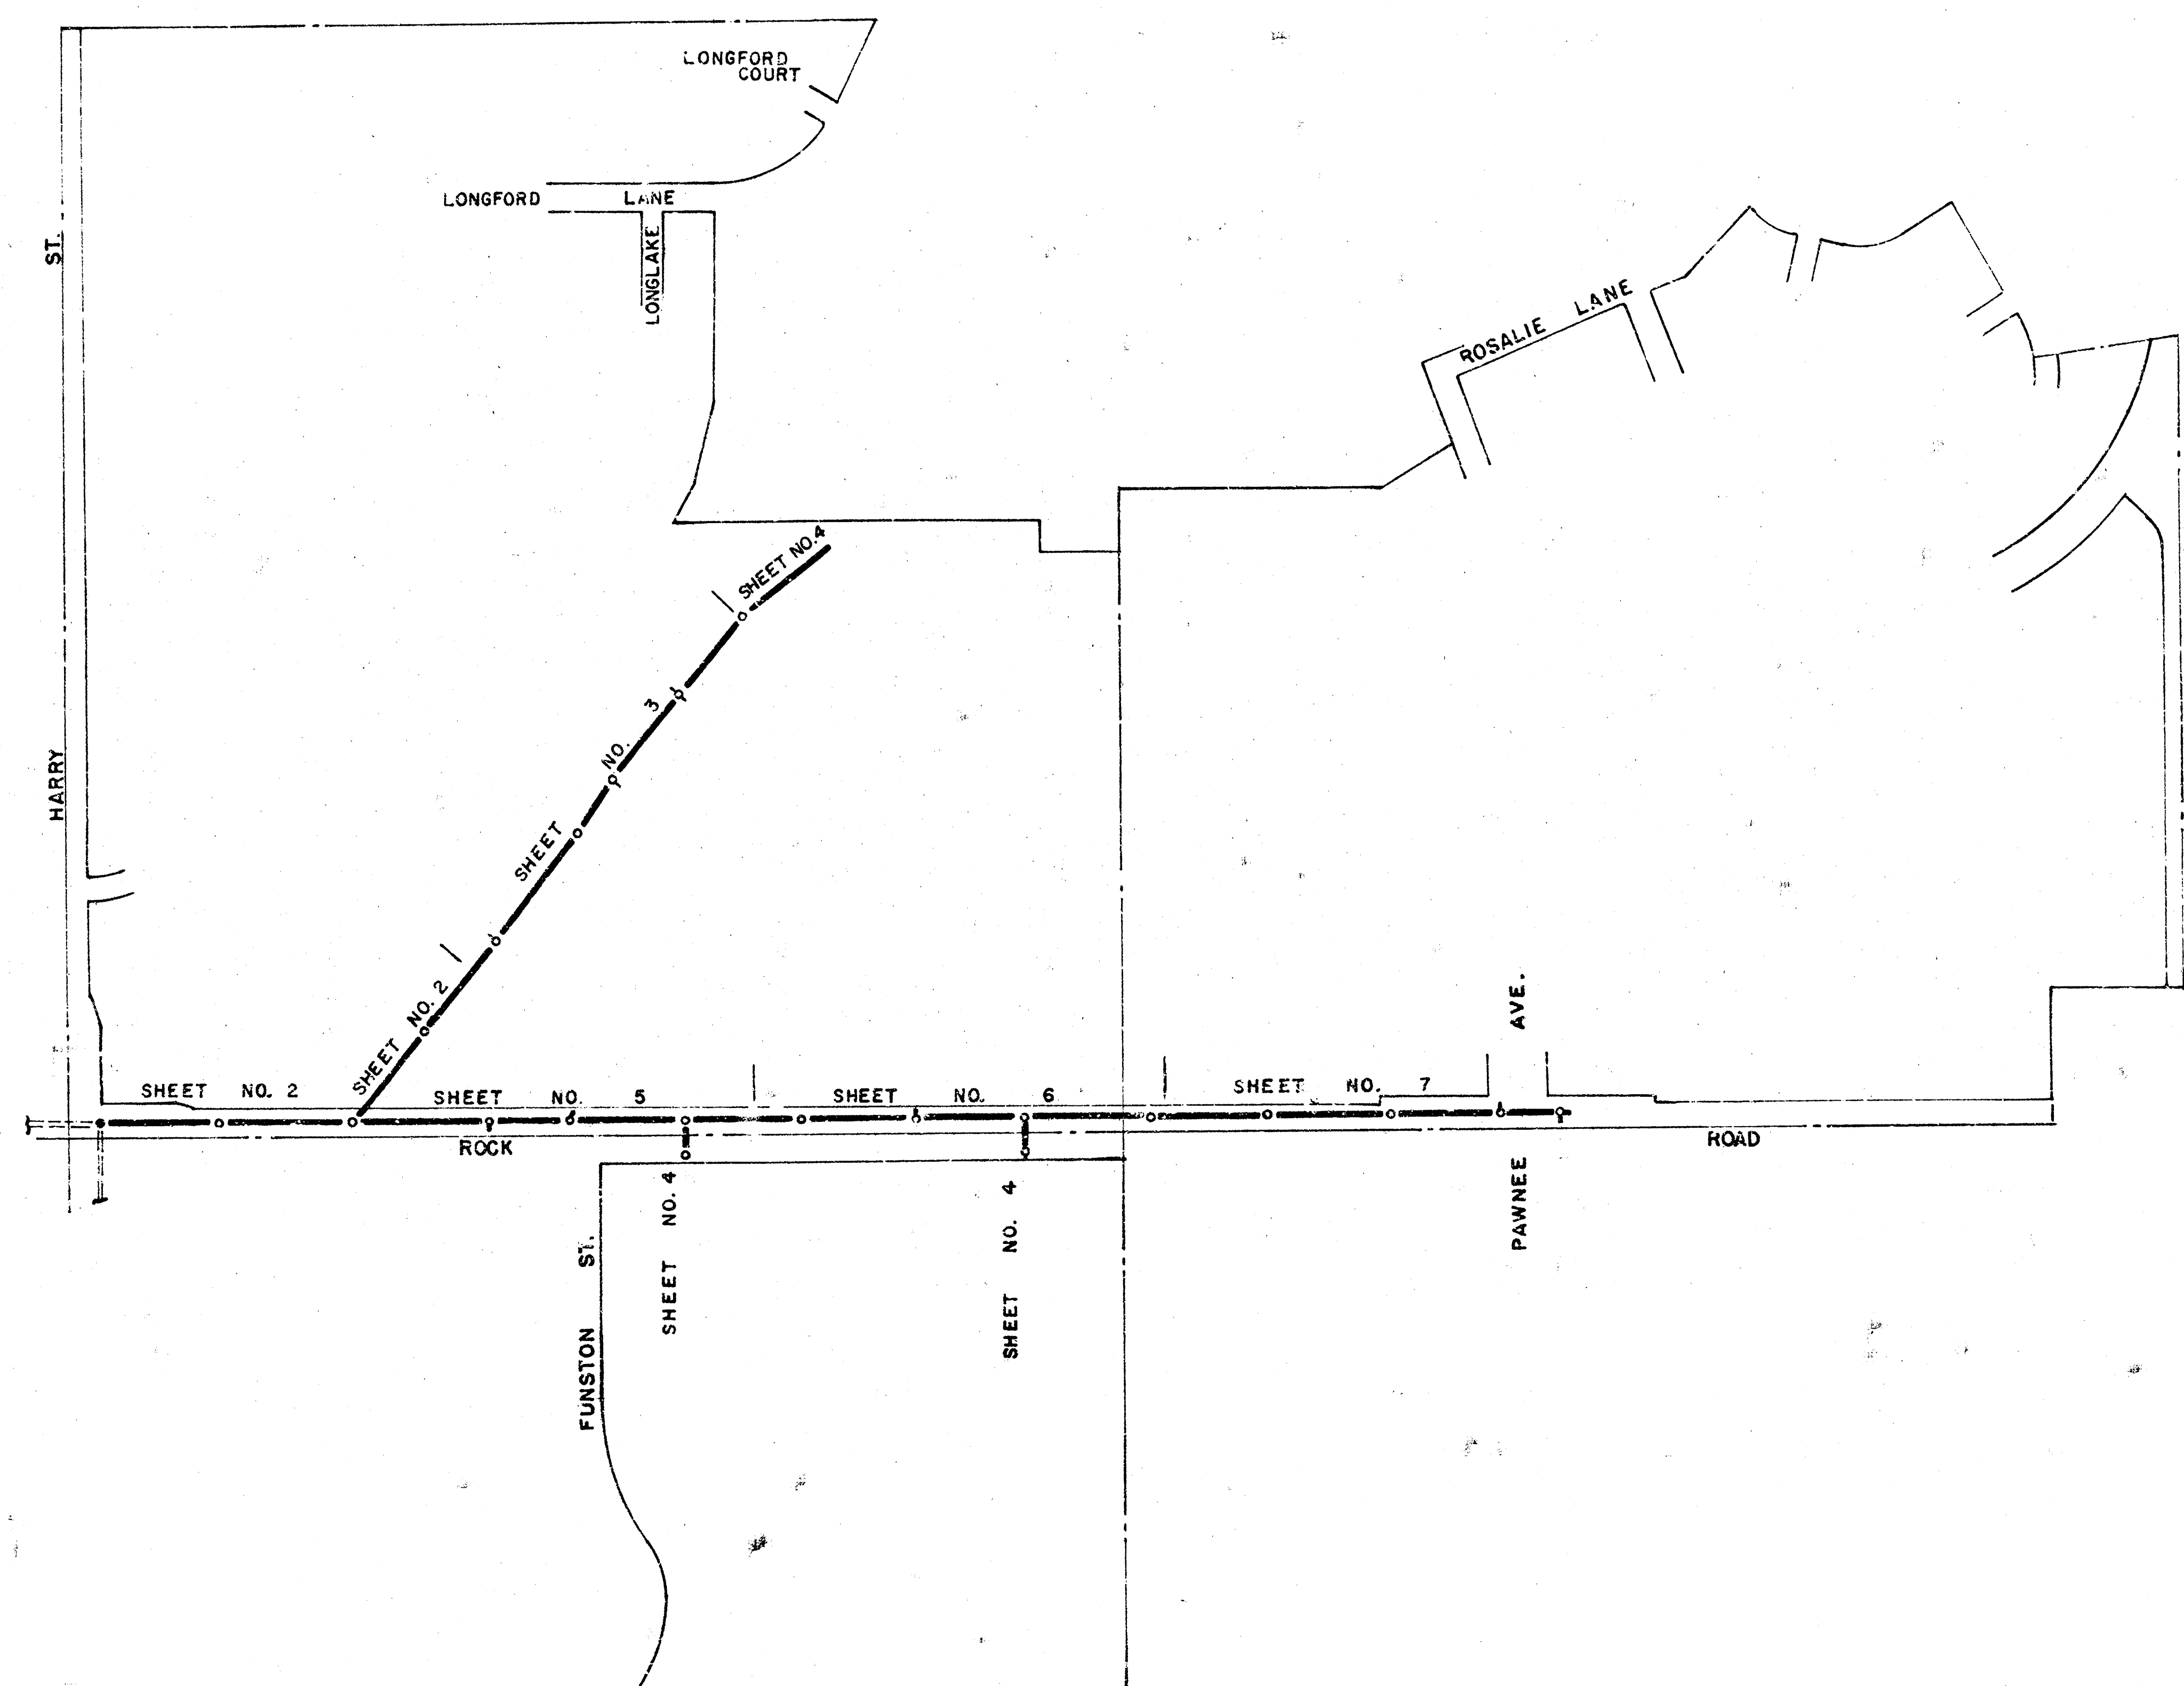


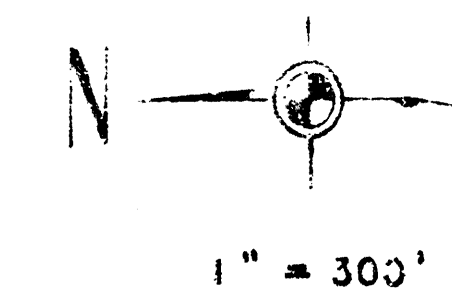


 Plan Scale 1" = 40'

 Profile Scale 1" = 40' Horiz.



 5' Vert.

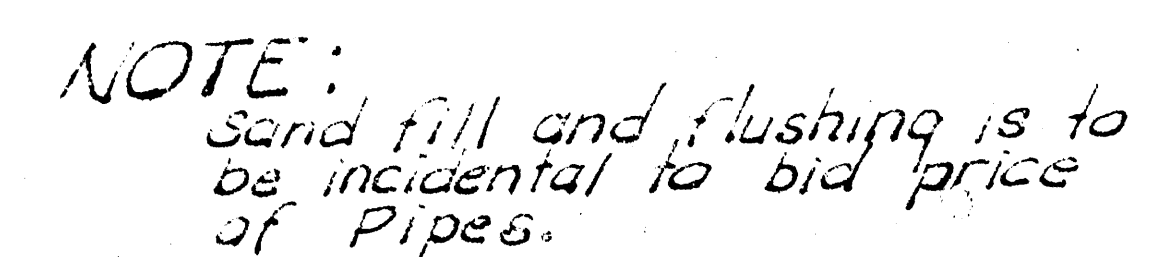



MAIN 17, WAR INDUSTRIES SEWER
CITY OF WICHITA, KANSAS
R. W. LINN — CITY ENGINEER
JULY 1973 PROJECT NO. DBKM573034

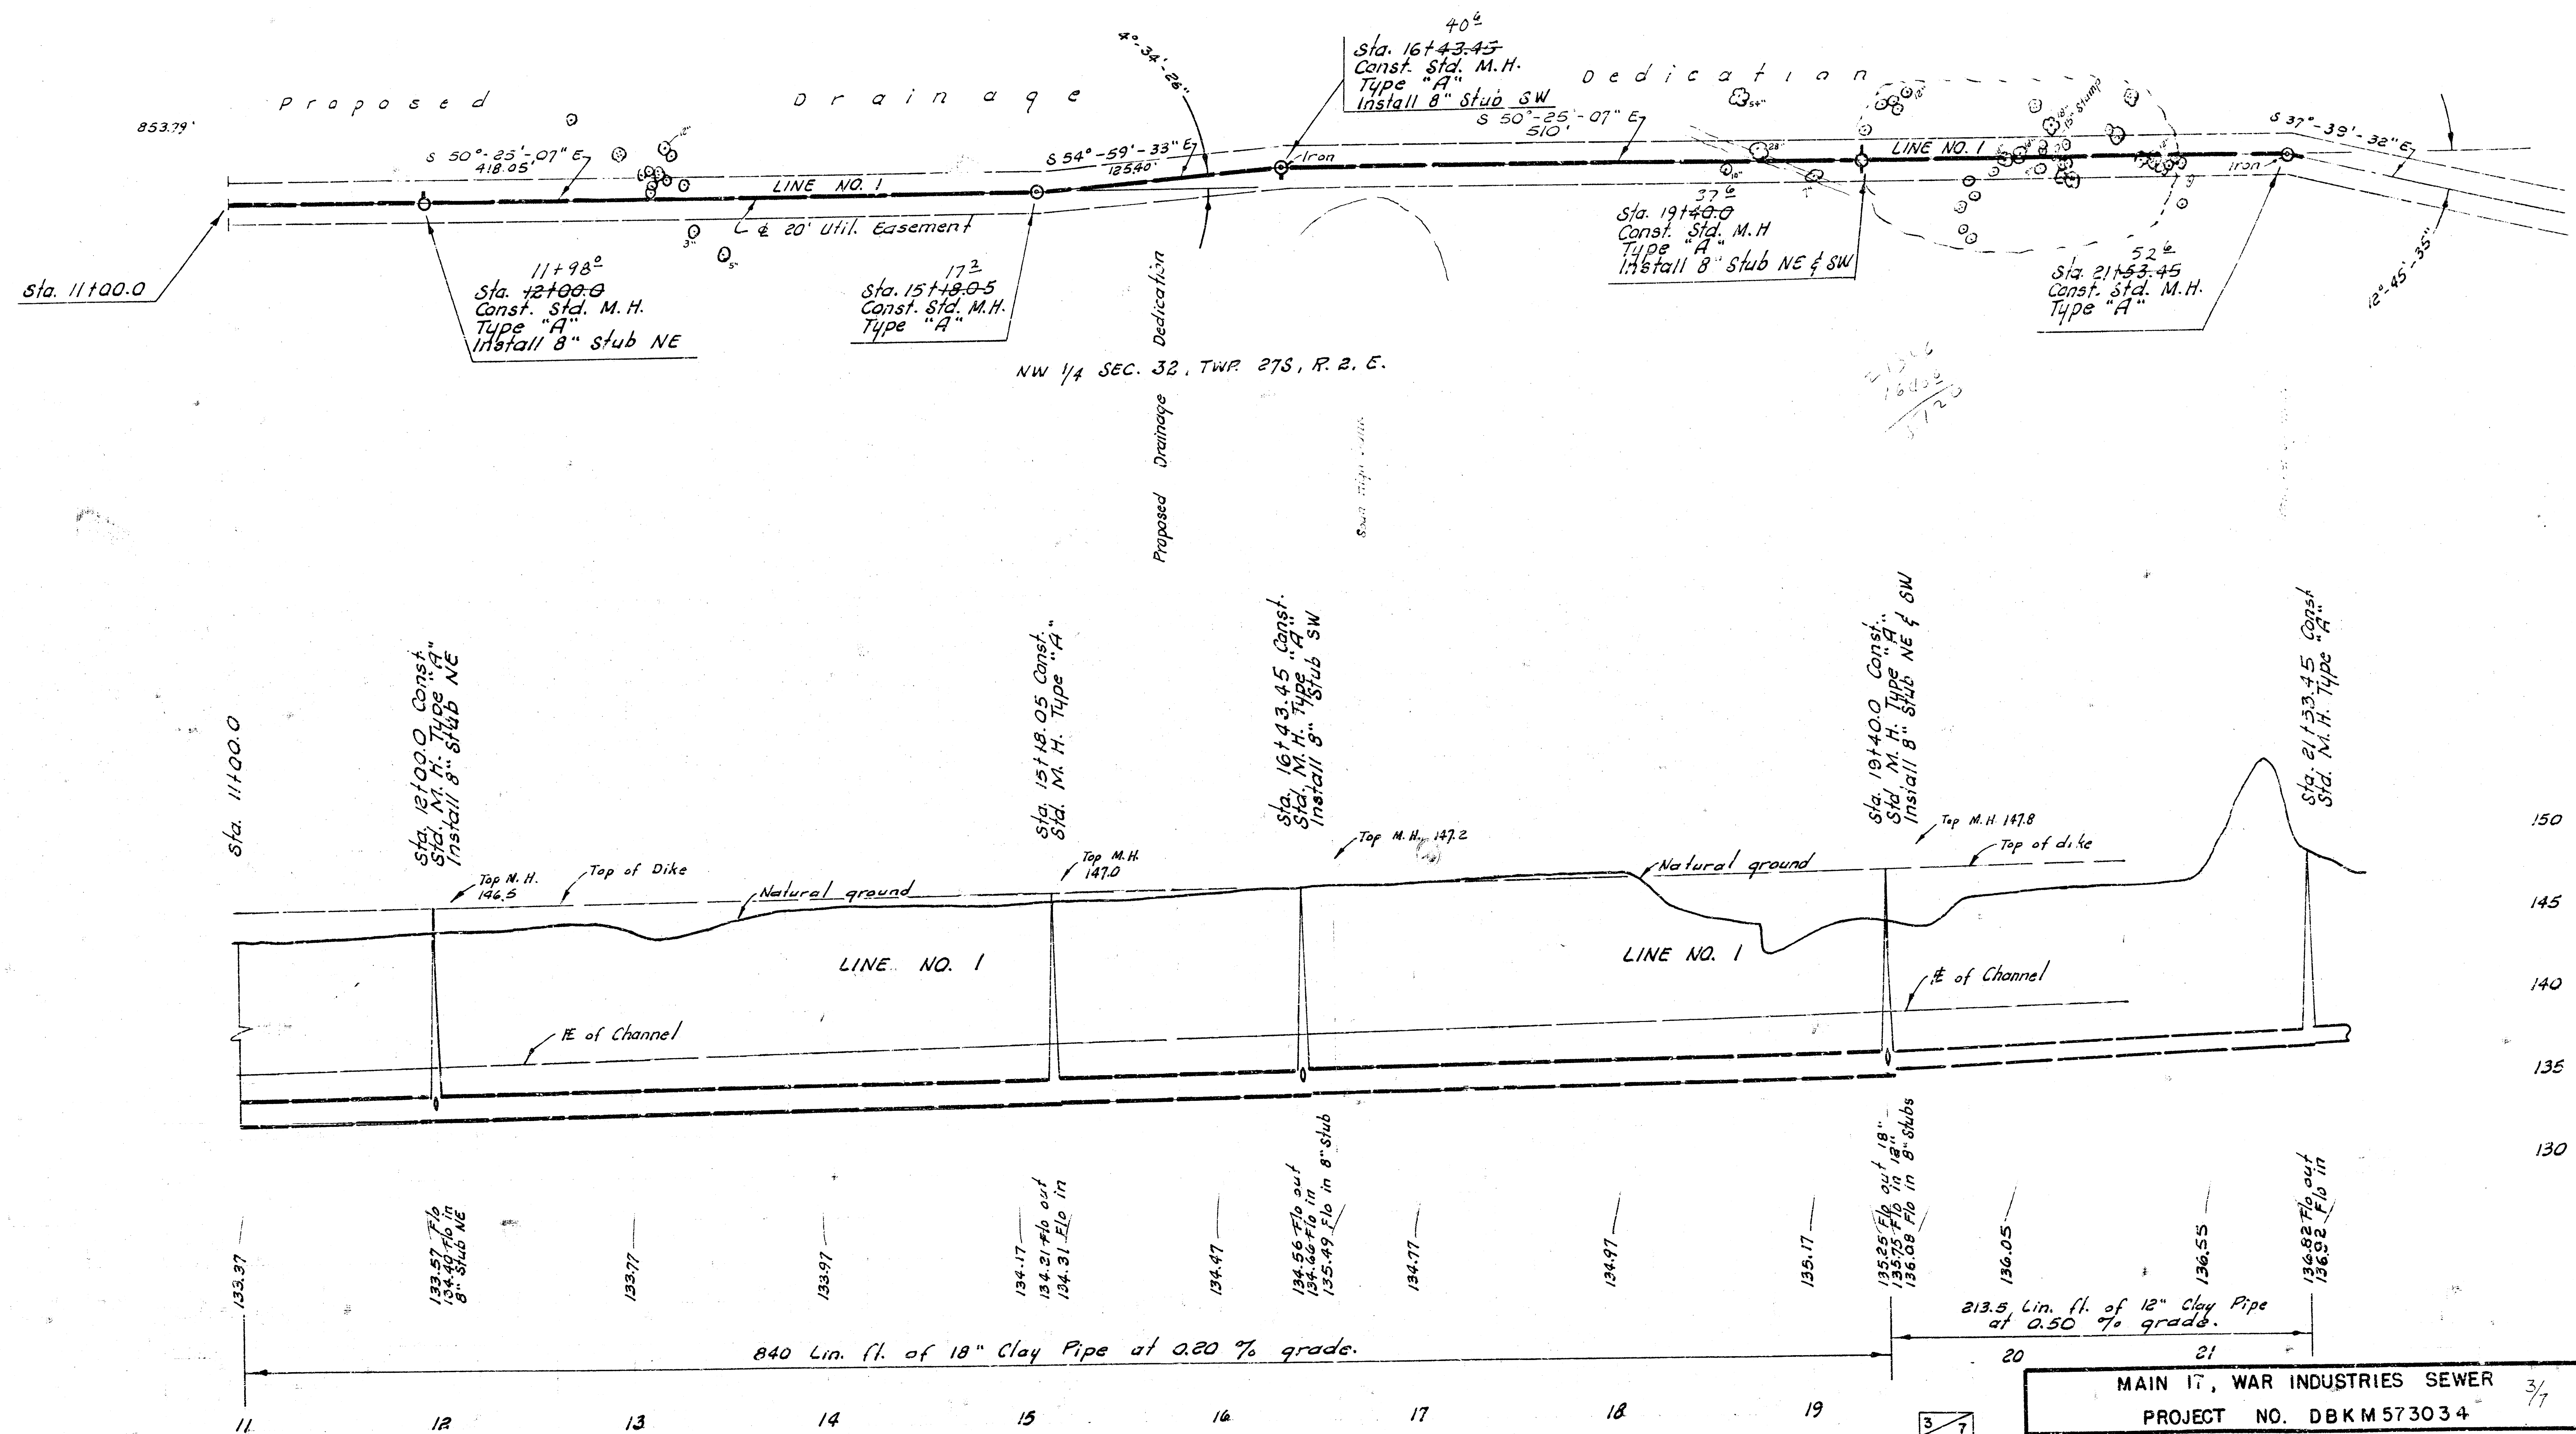

NW 1/4 SEC. 32, TWP. 27S, R. 2, E.

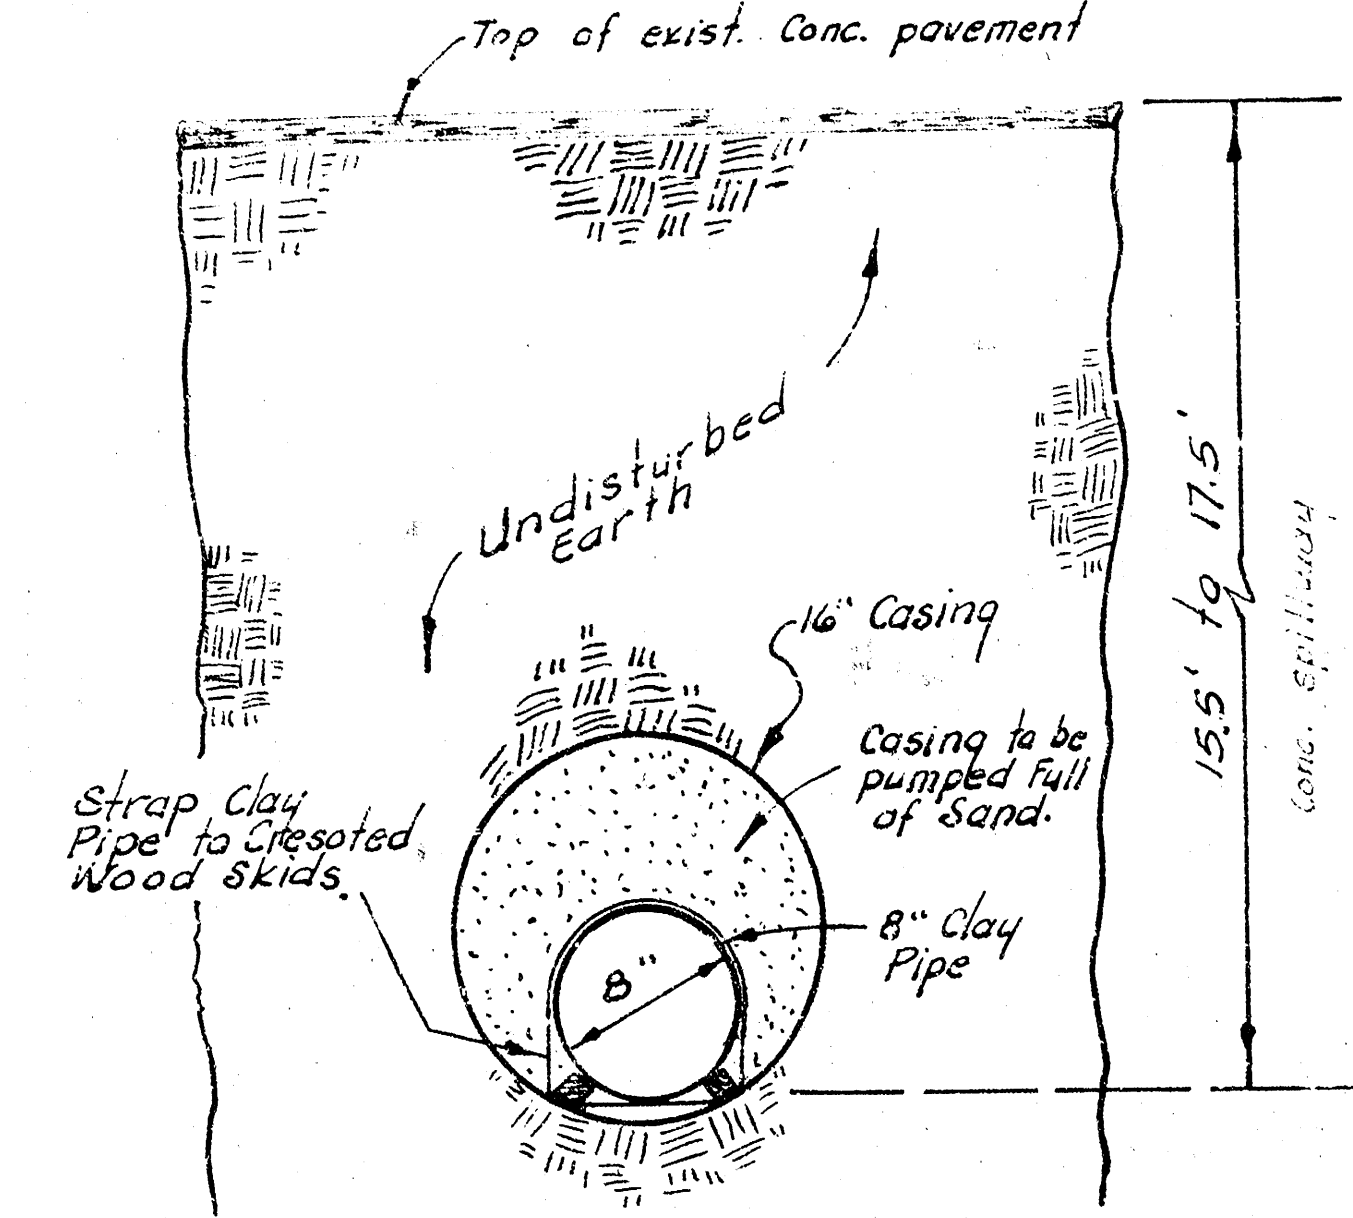
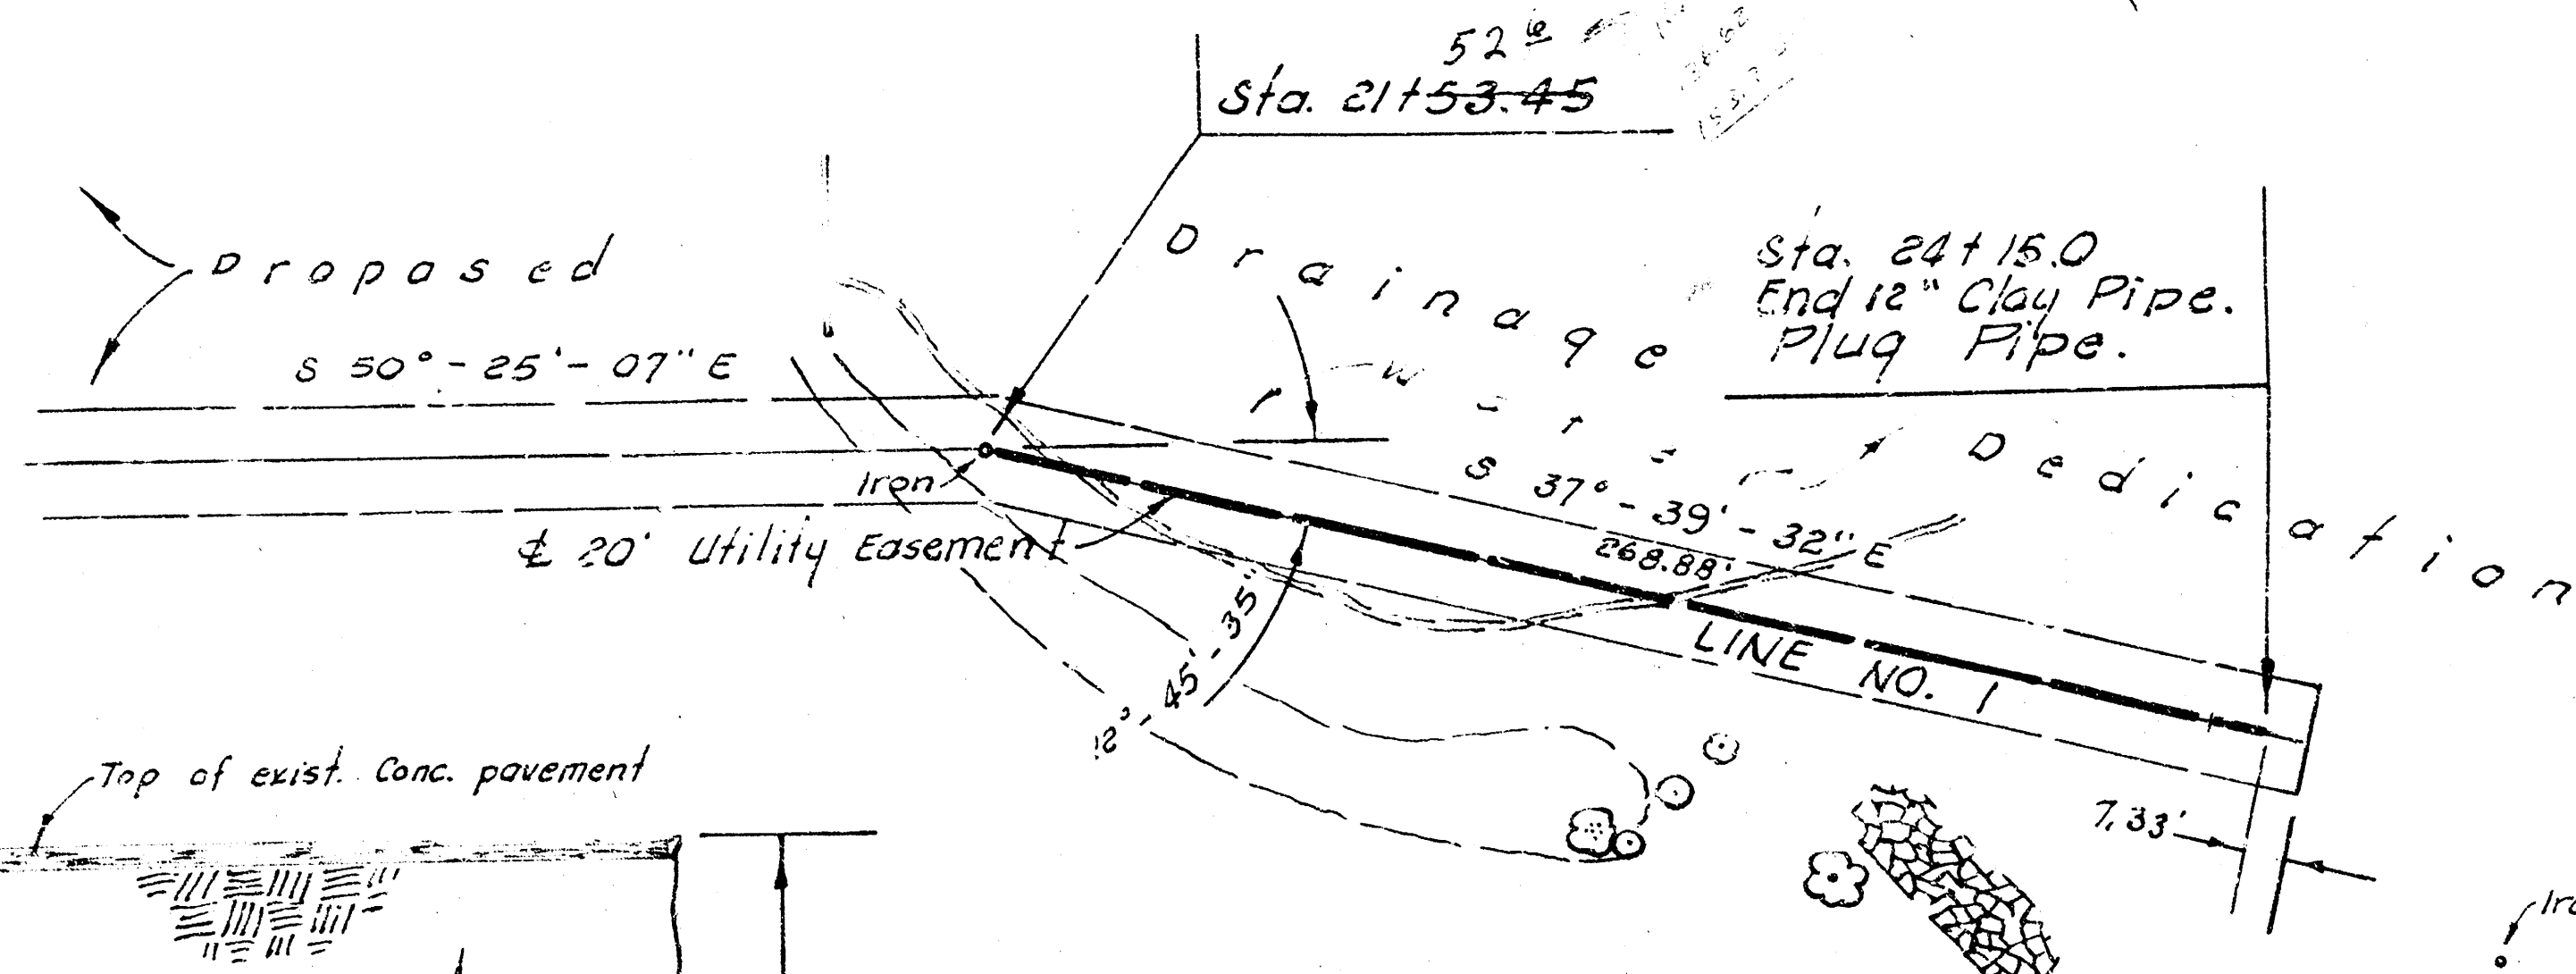



NOTE:
The bid price of Lin. ft. of casing shall include the augering, wood skids, straps and the pumping of sand.

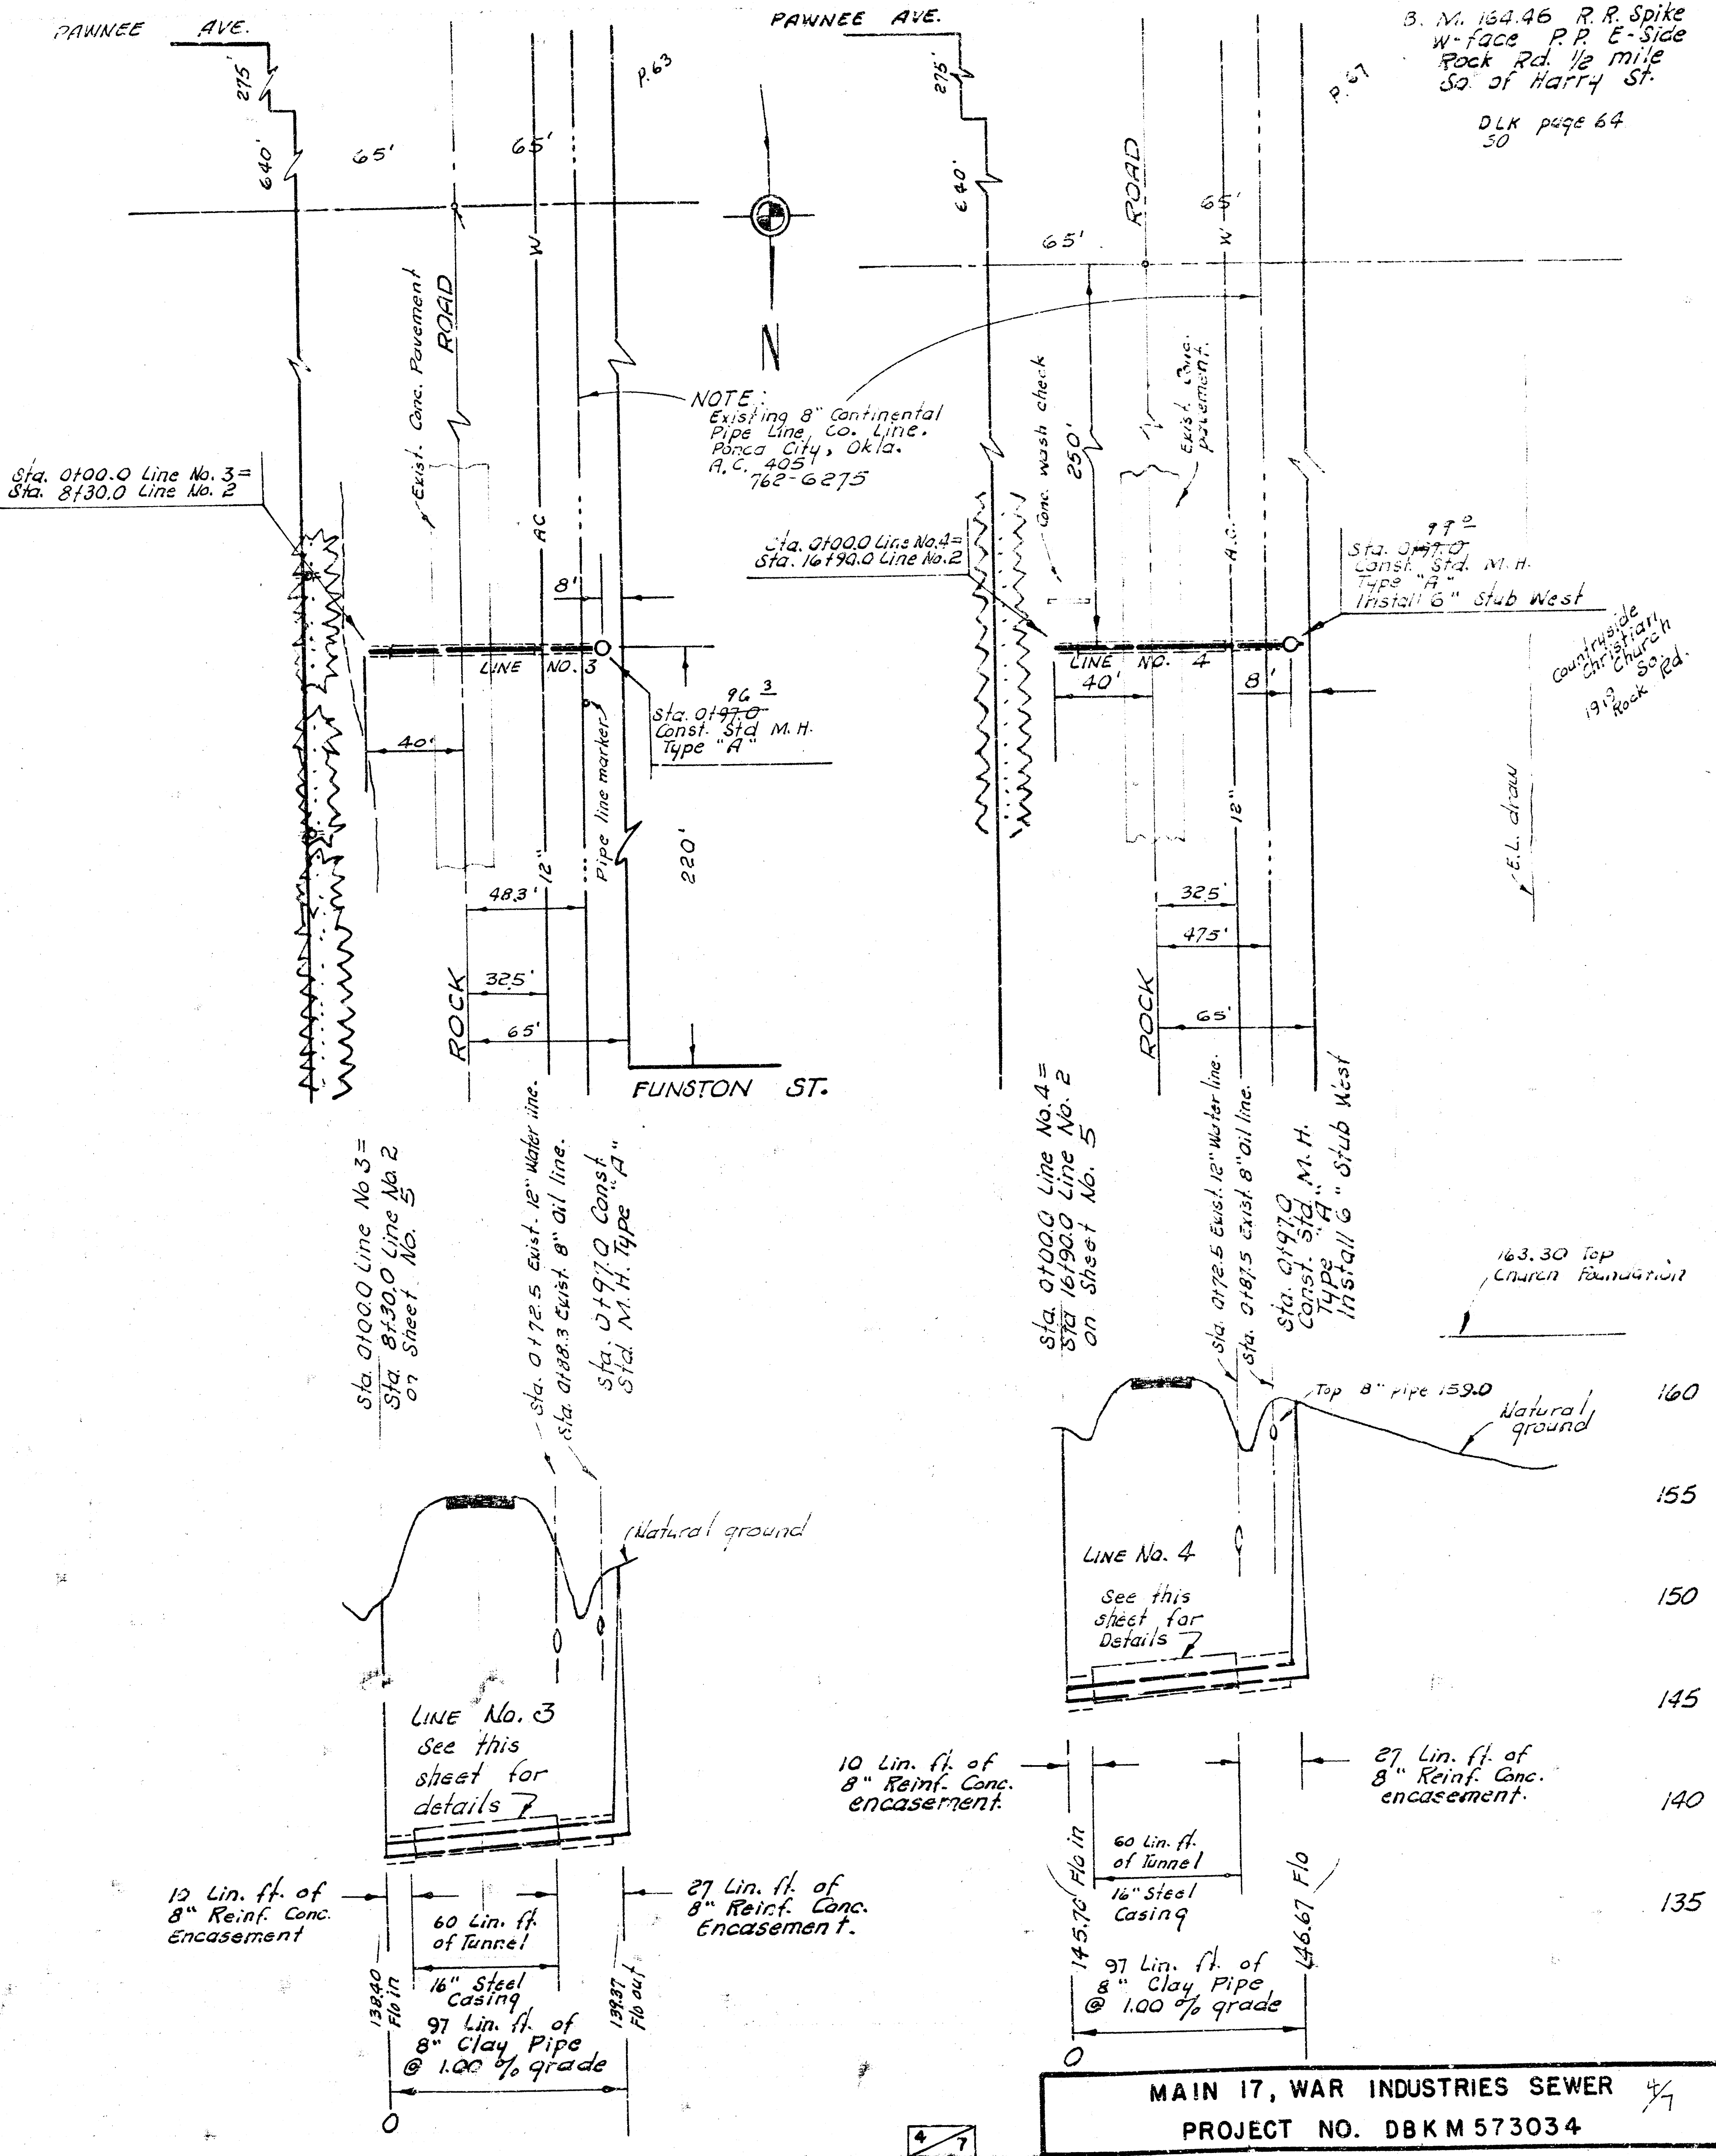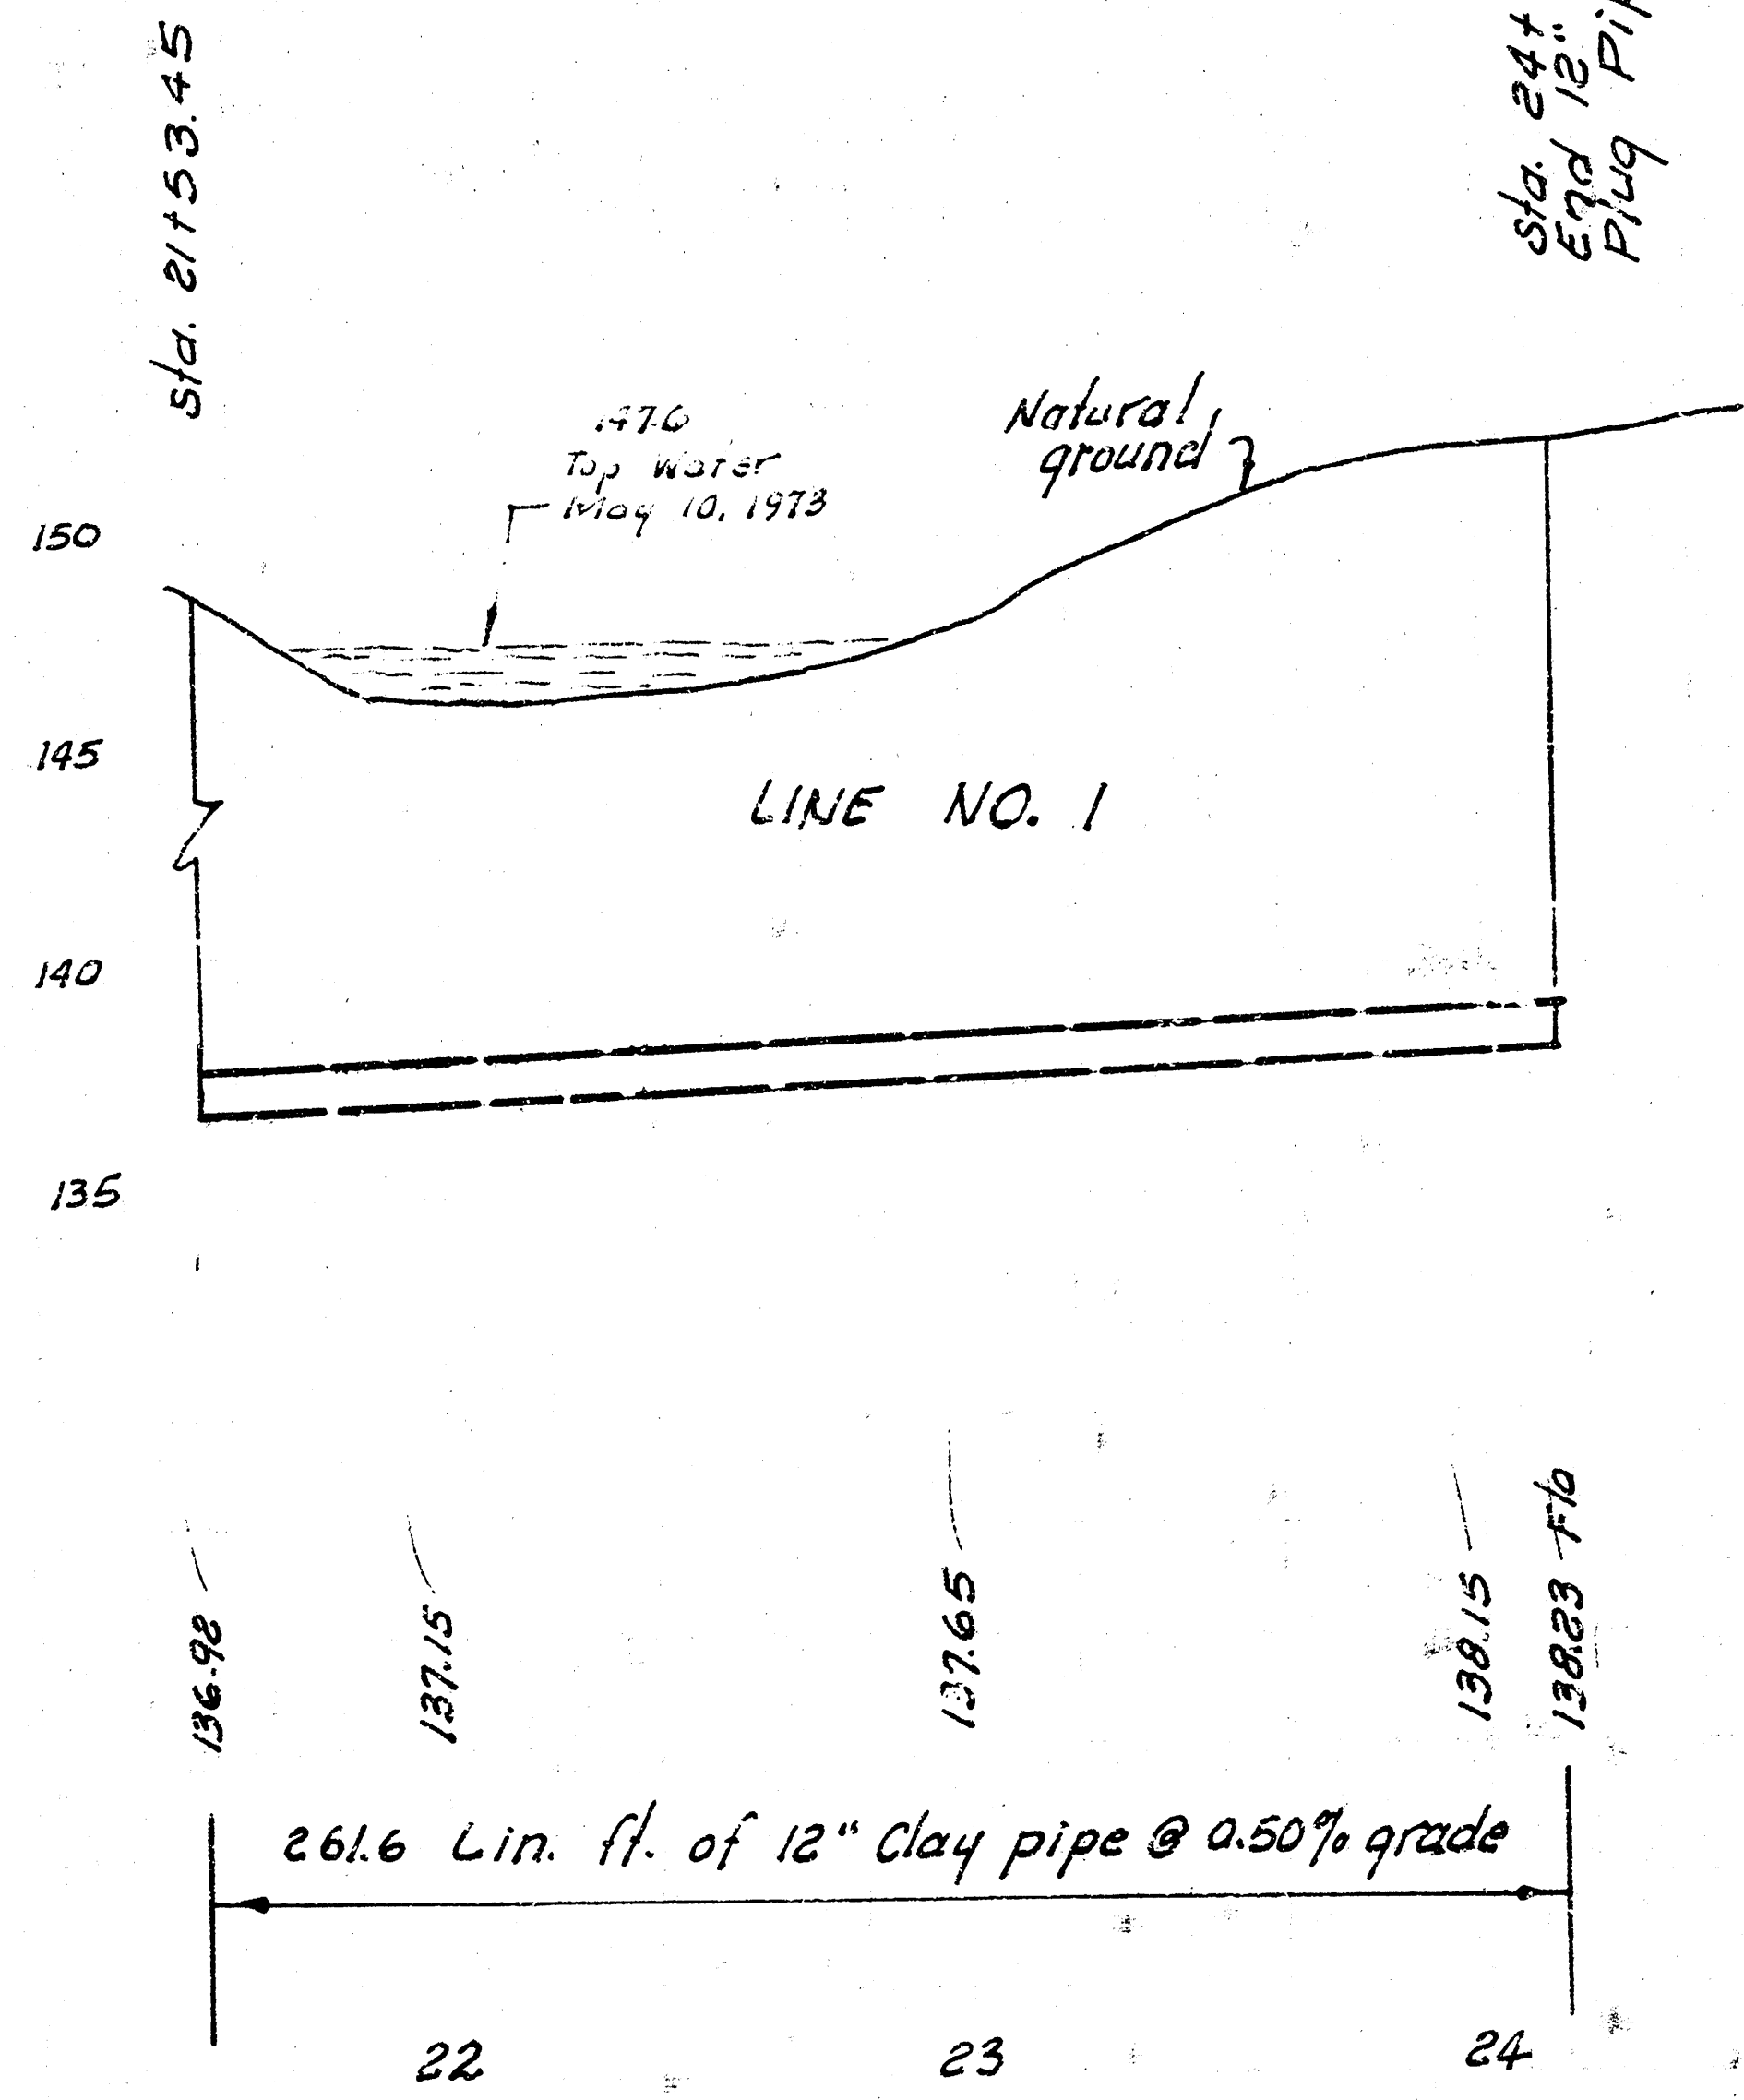

MAIN 17, WAR INDUSTRIES SEWER
PROJECT NO. DBKM 573034

B.M. 154.49 R.R. Spk. W-face P.P. E.L. Rock Rd.
S.L. Funston extended.

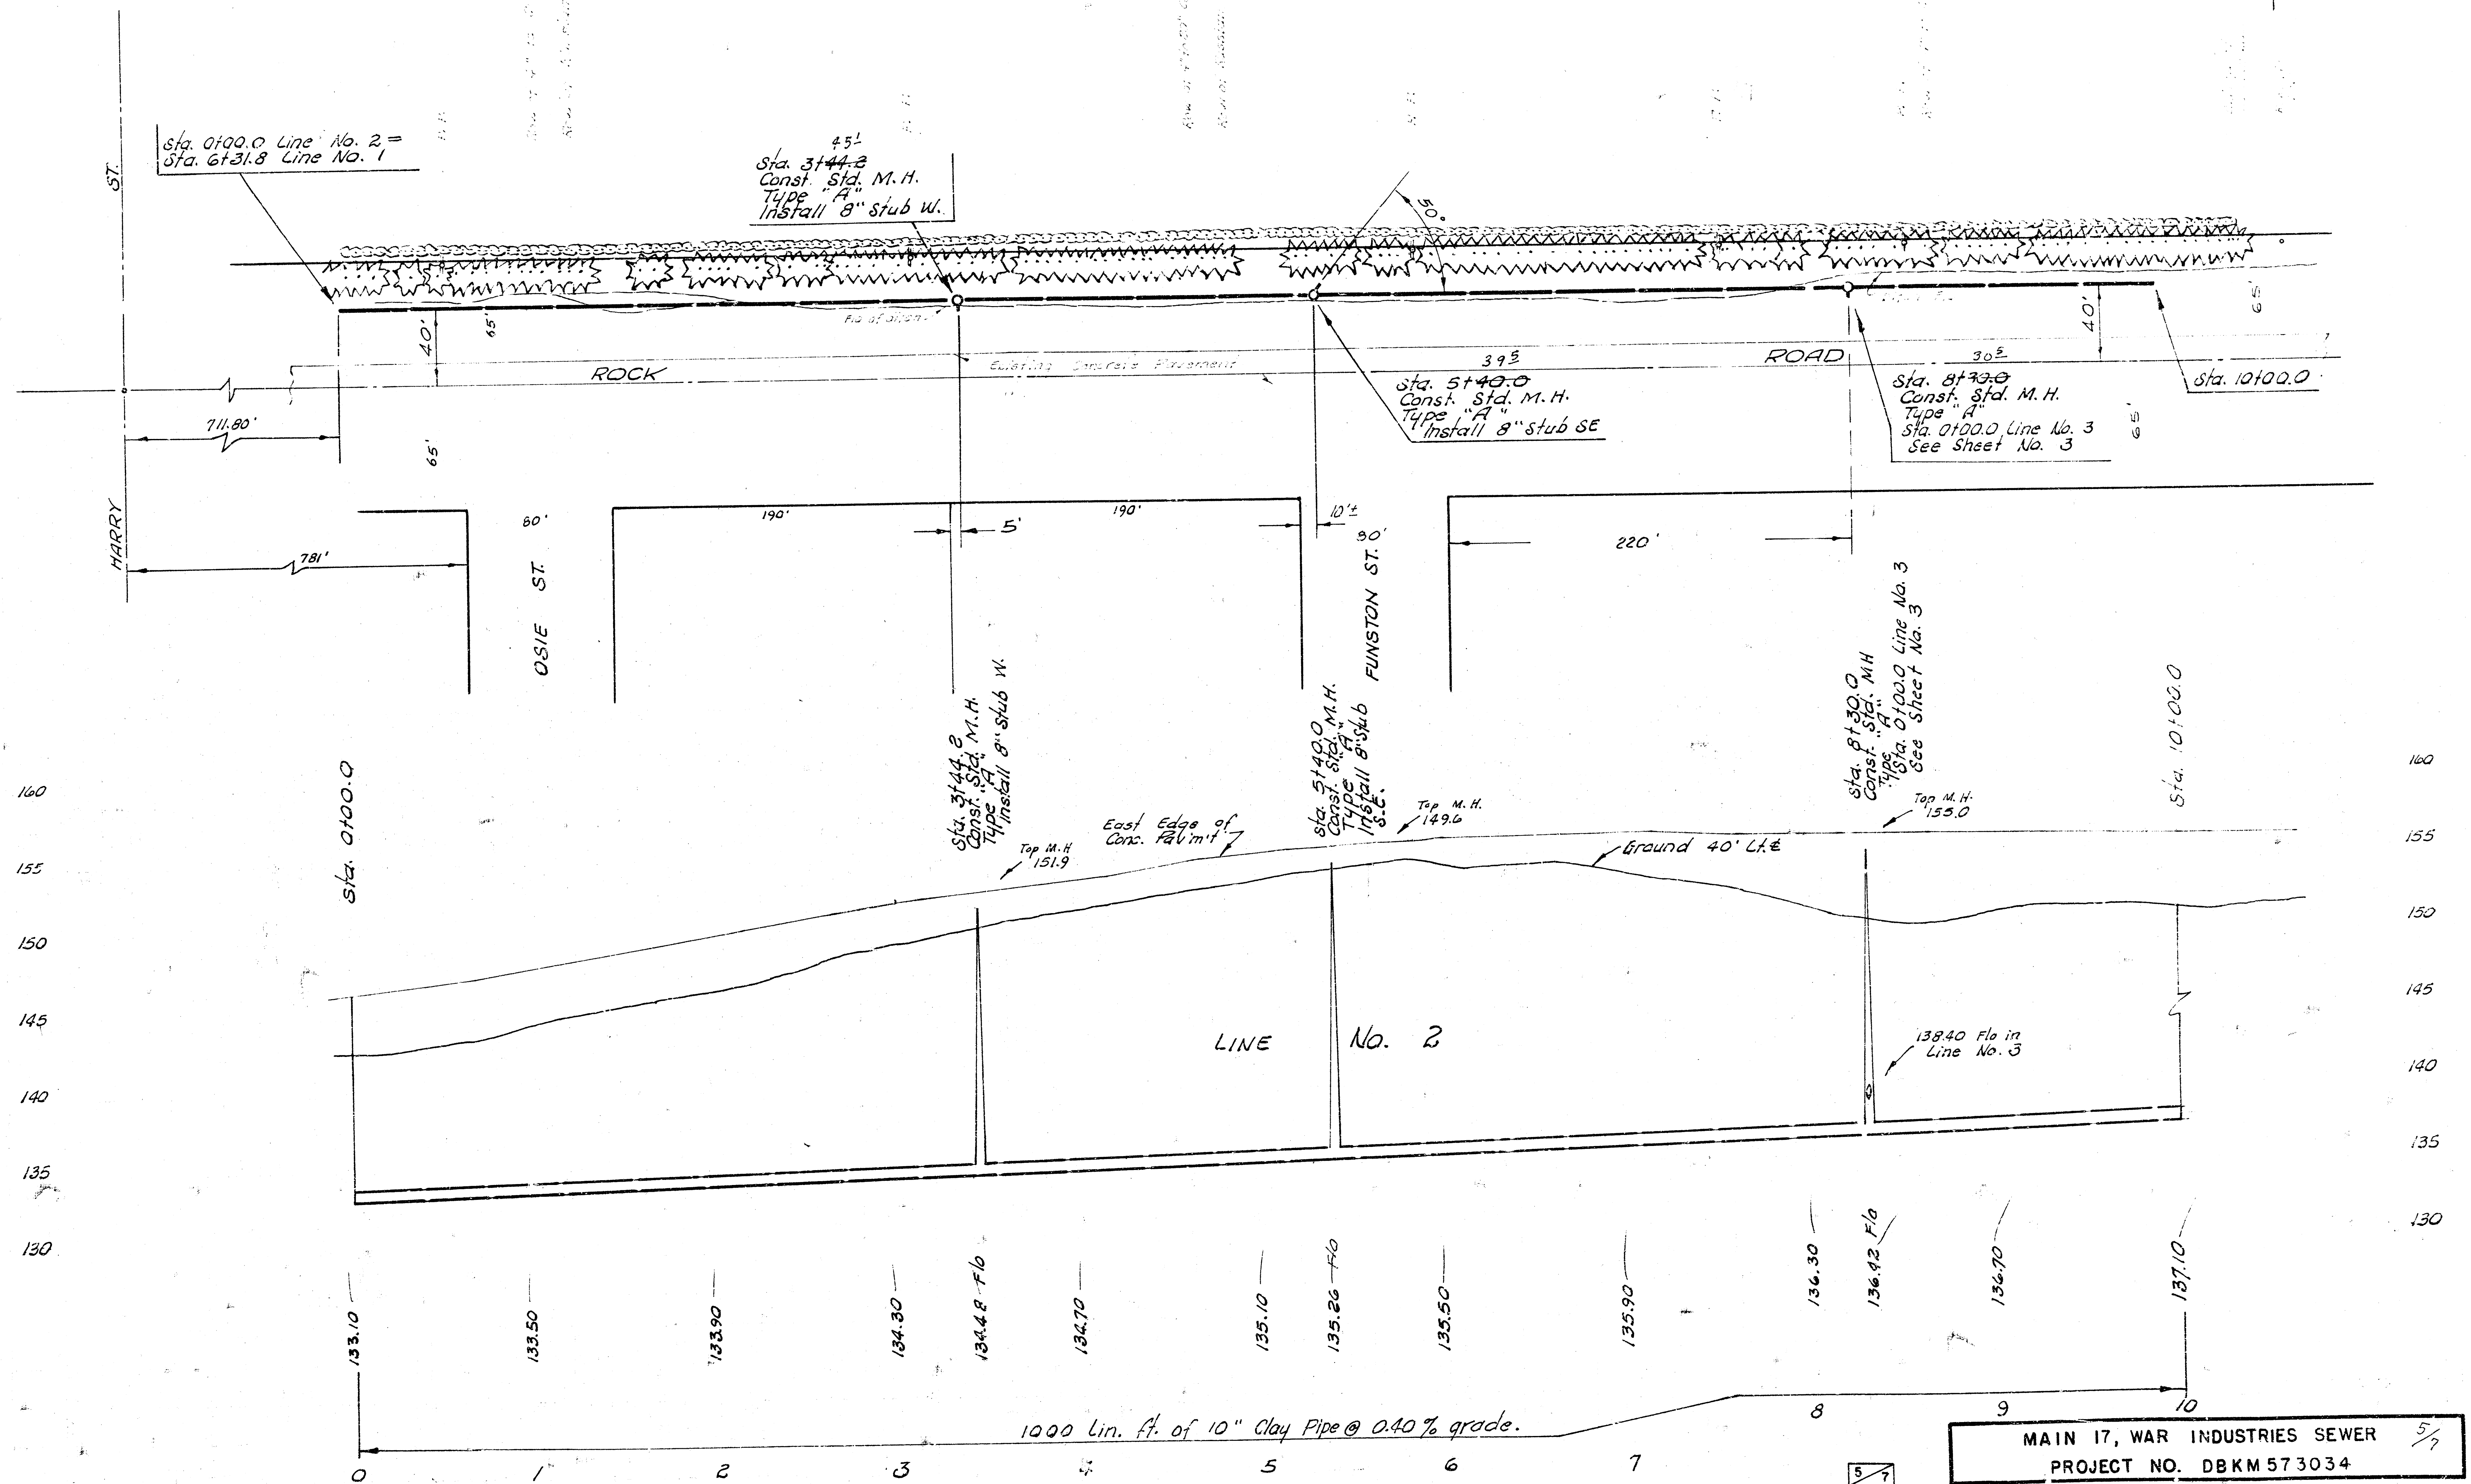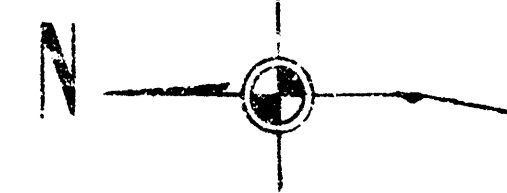

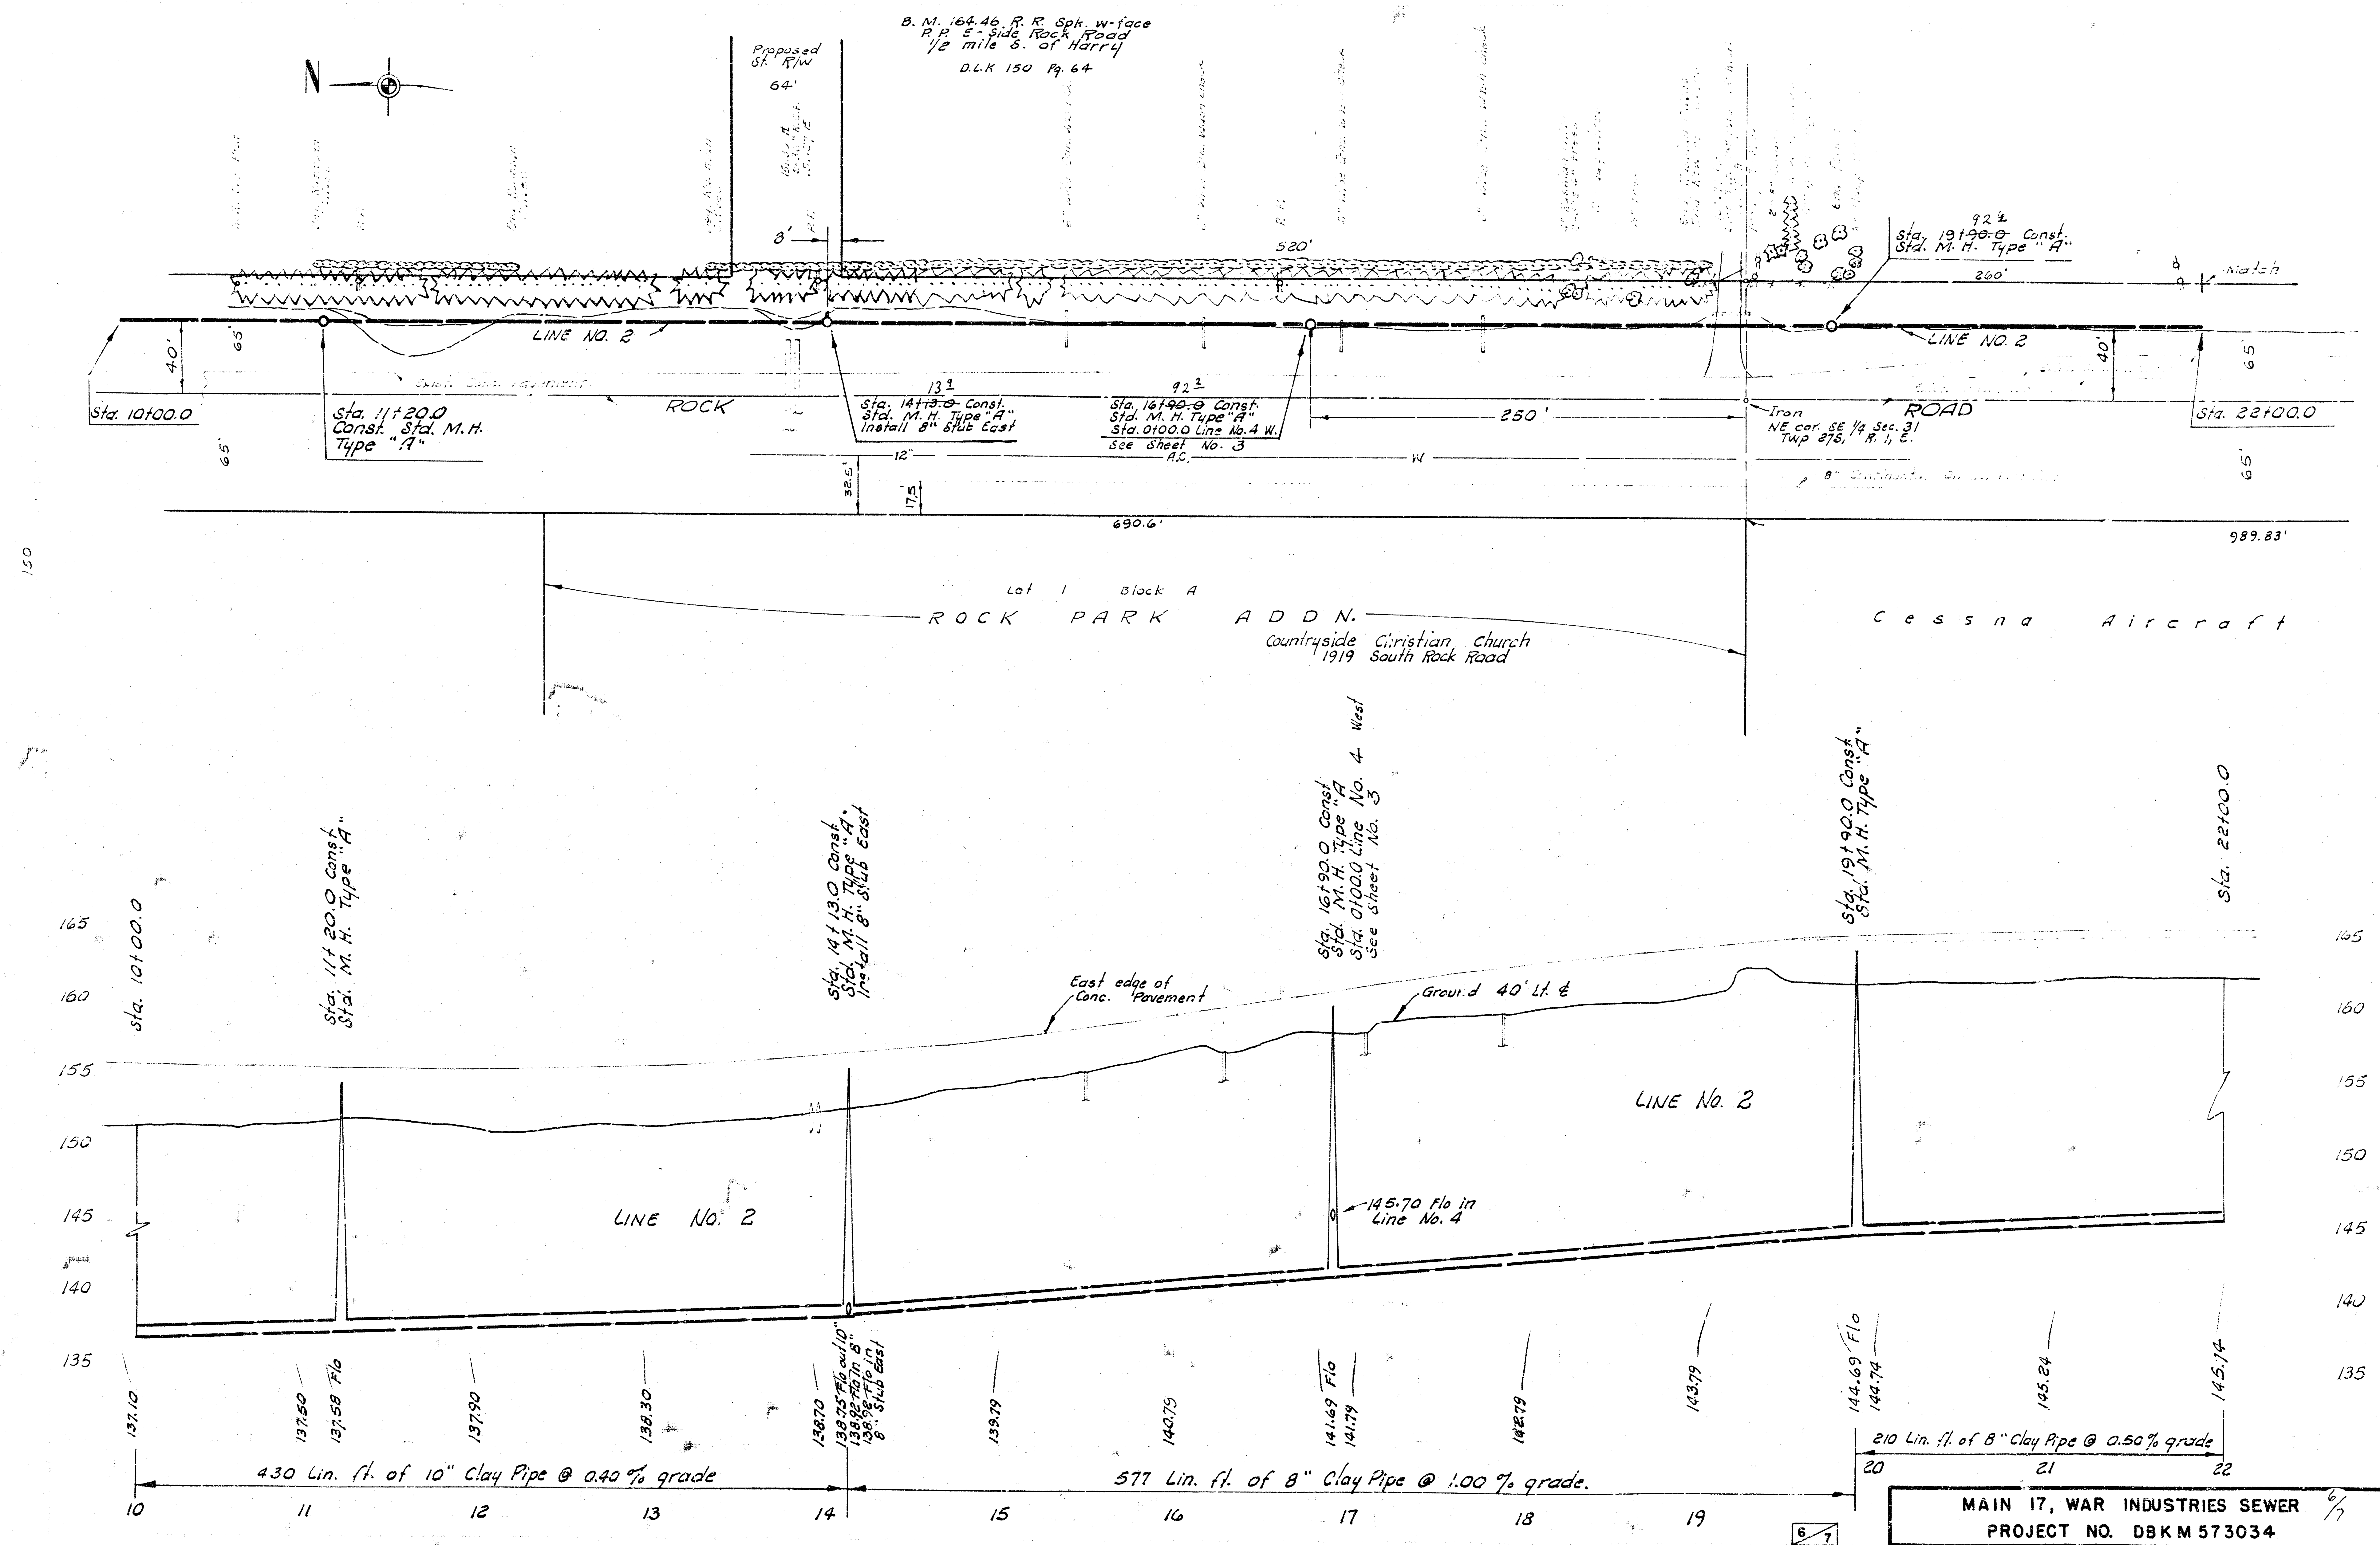

B. M. 165.71 "±" on cfr. Pawnee West
on cfr. Rock Road N-S

