

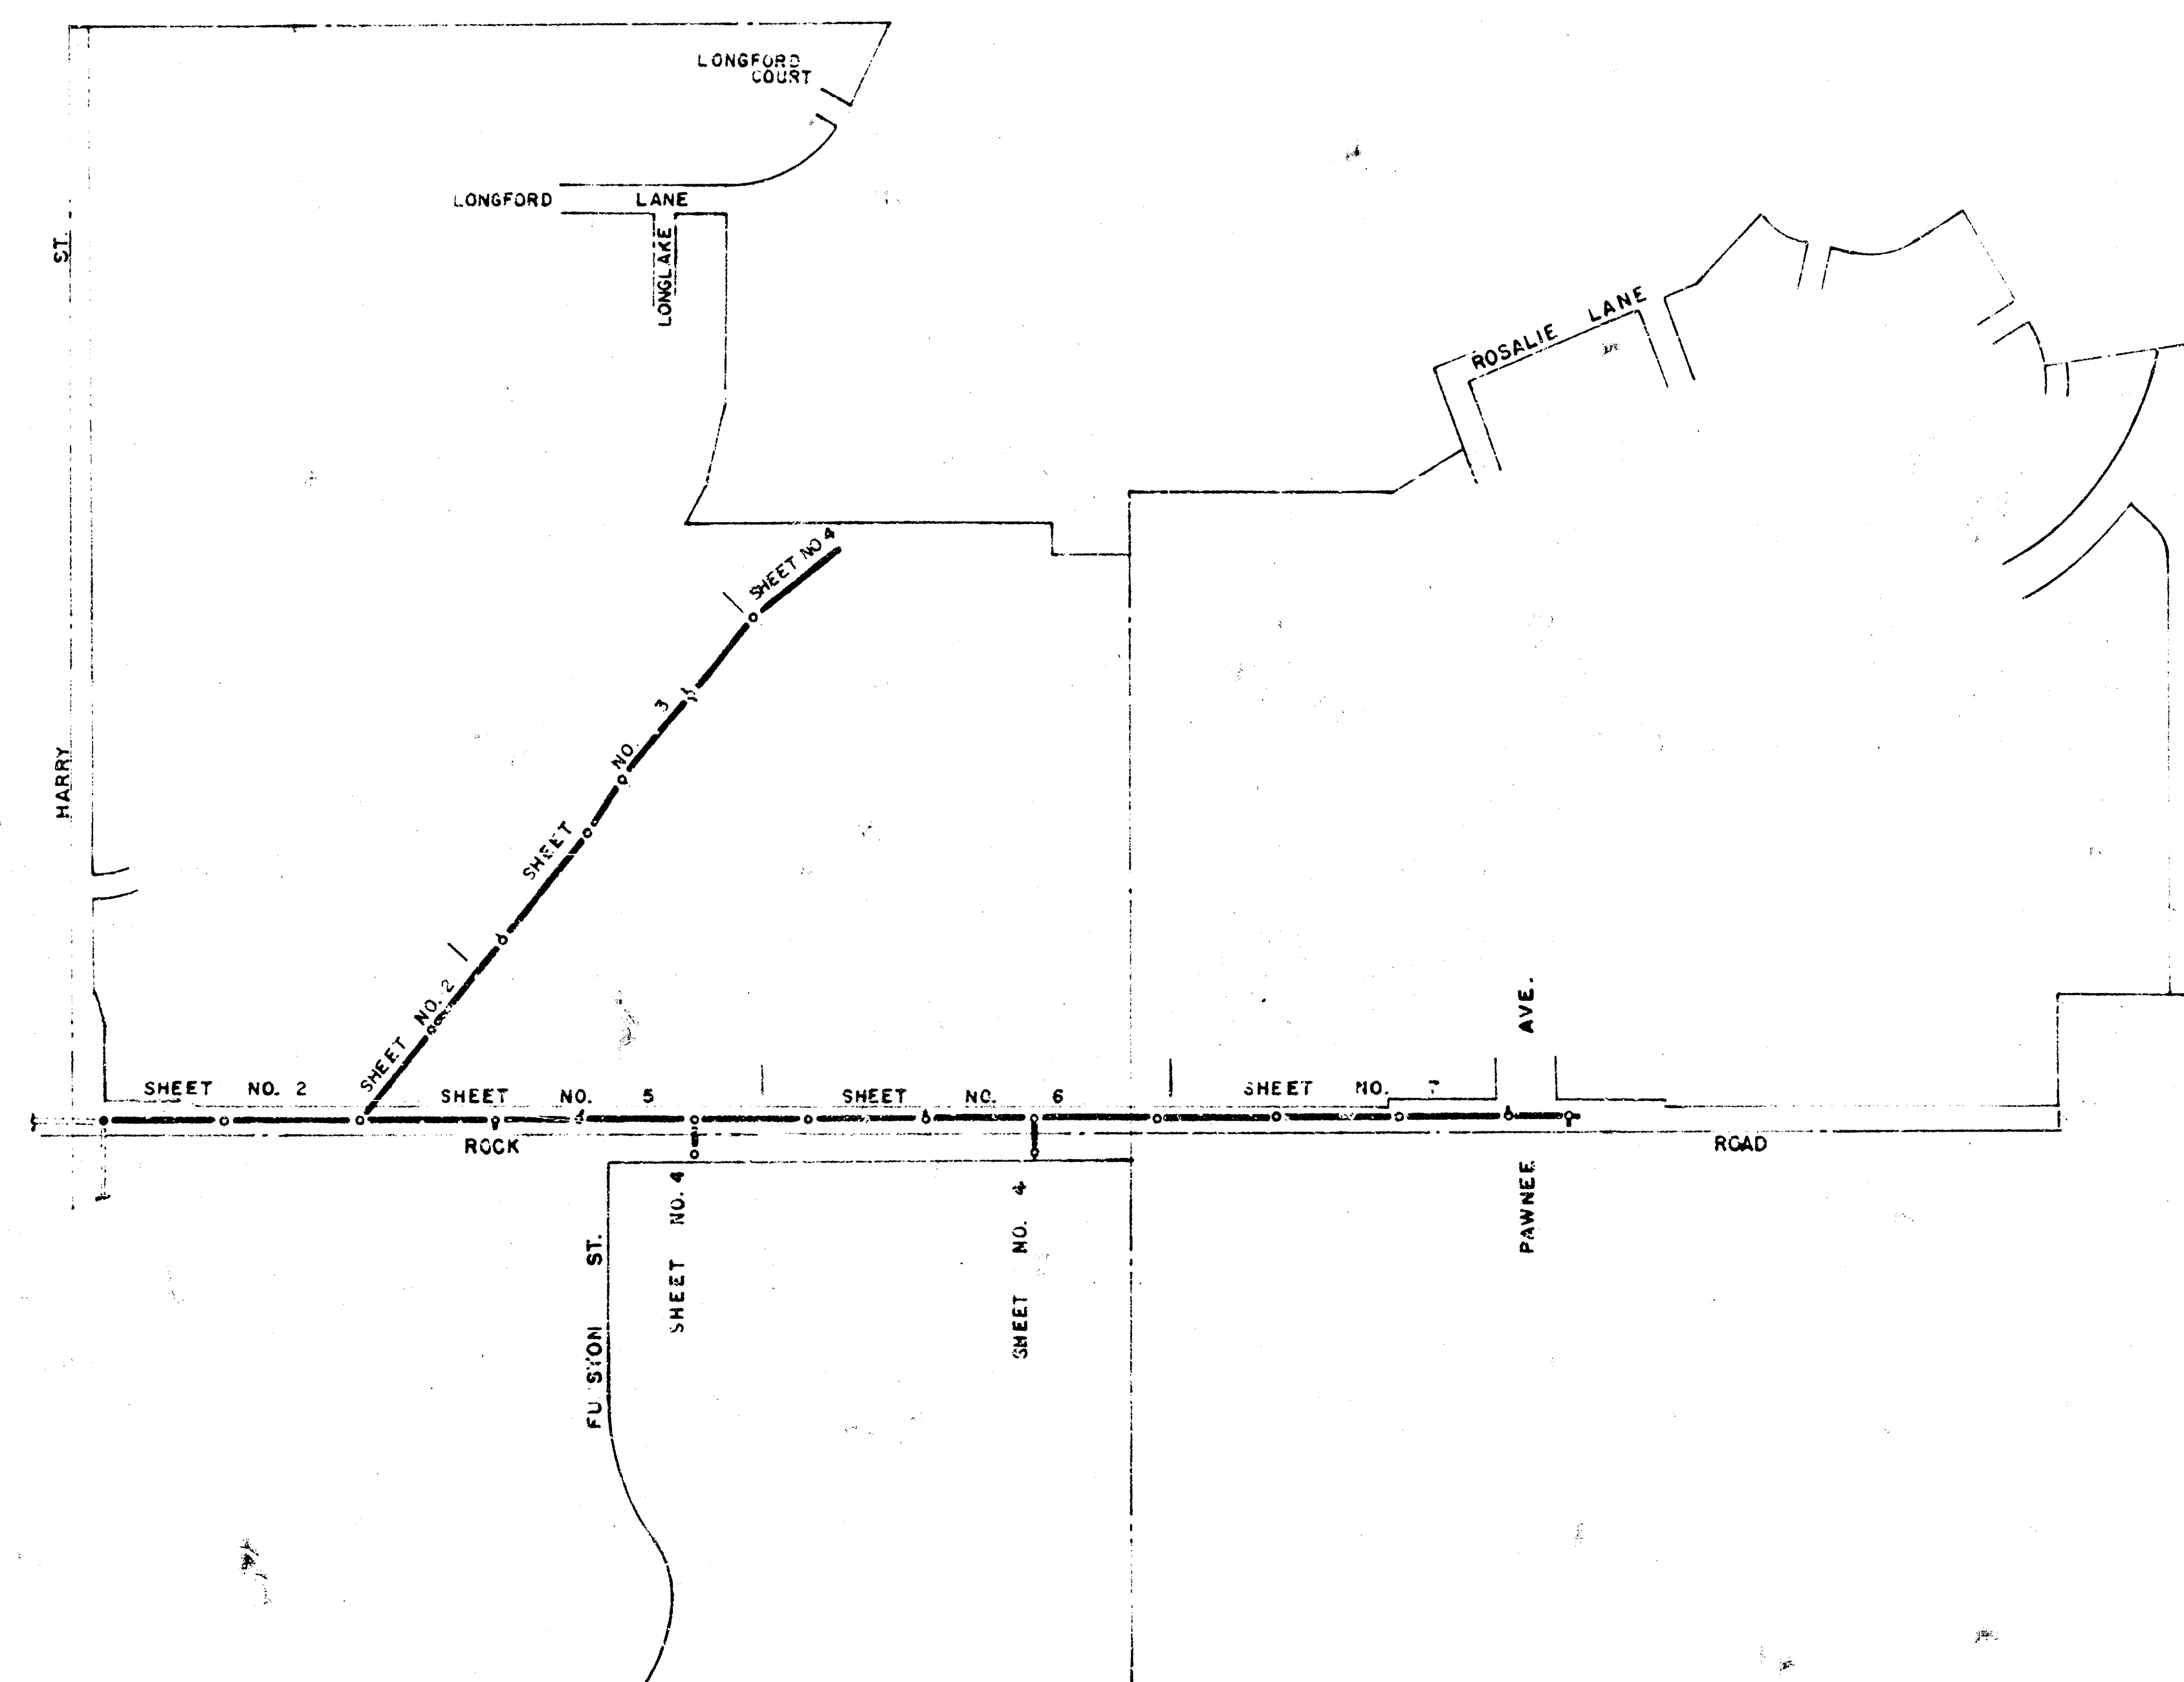



MAIN 17, WAR INDUSTRIES SEWER
CITY OF WICHITA, KANSAS
R. W. LINN - CITY ENGINEER
JULY 1973, PROJECT NO. DBKM 573034


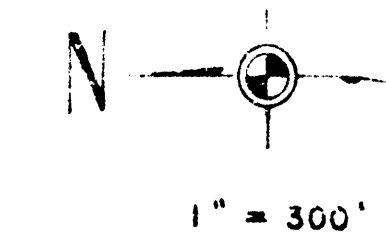


As Built Final Meas. 280-8
MAIN 17, WAR INDUSTRIES SEWER
PROJECT NO. DBKM 573034

3. M. 145.38 "+" on NW cor. N-headwall
R.C.B.C. on Harry 238' W. of Rock Rd.


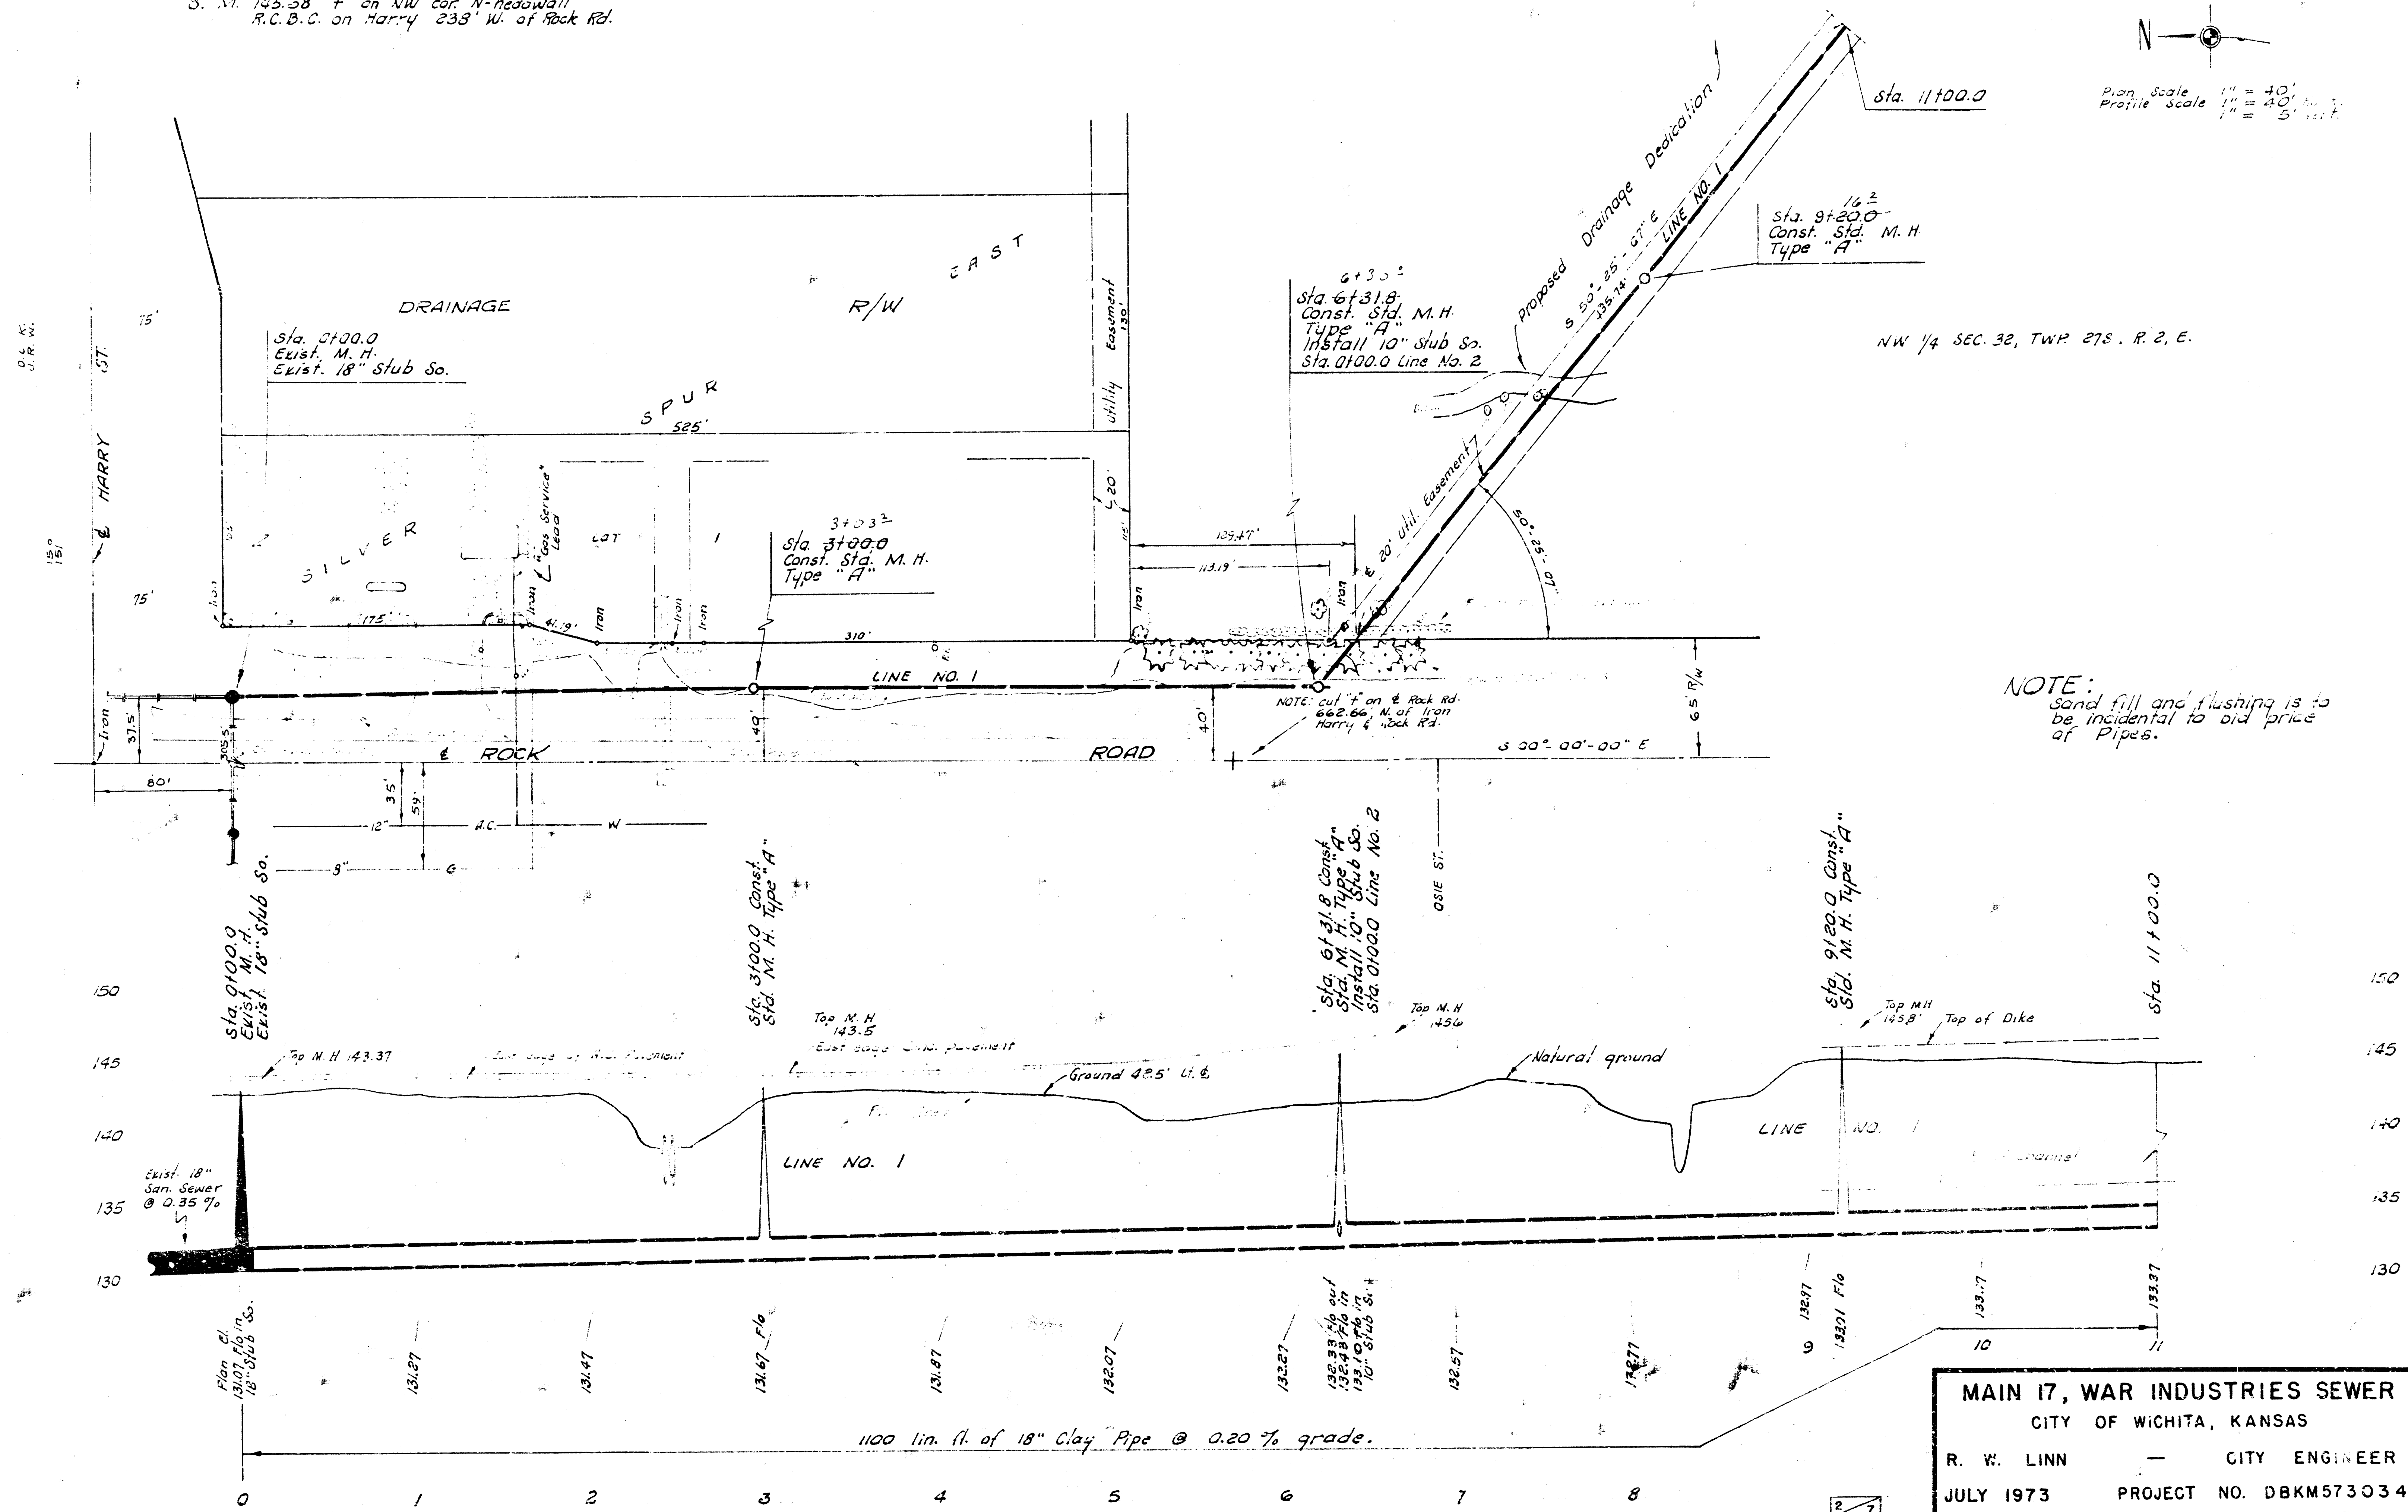


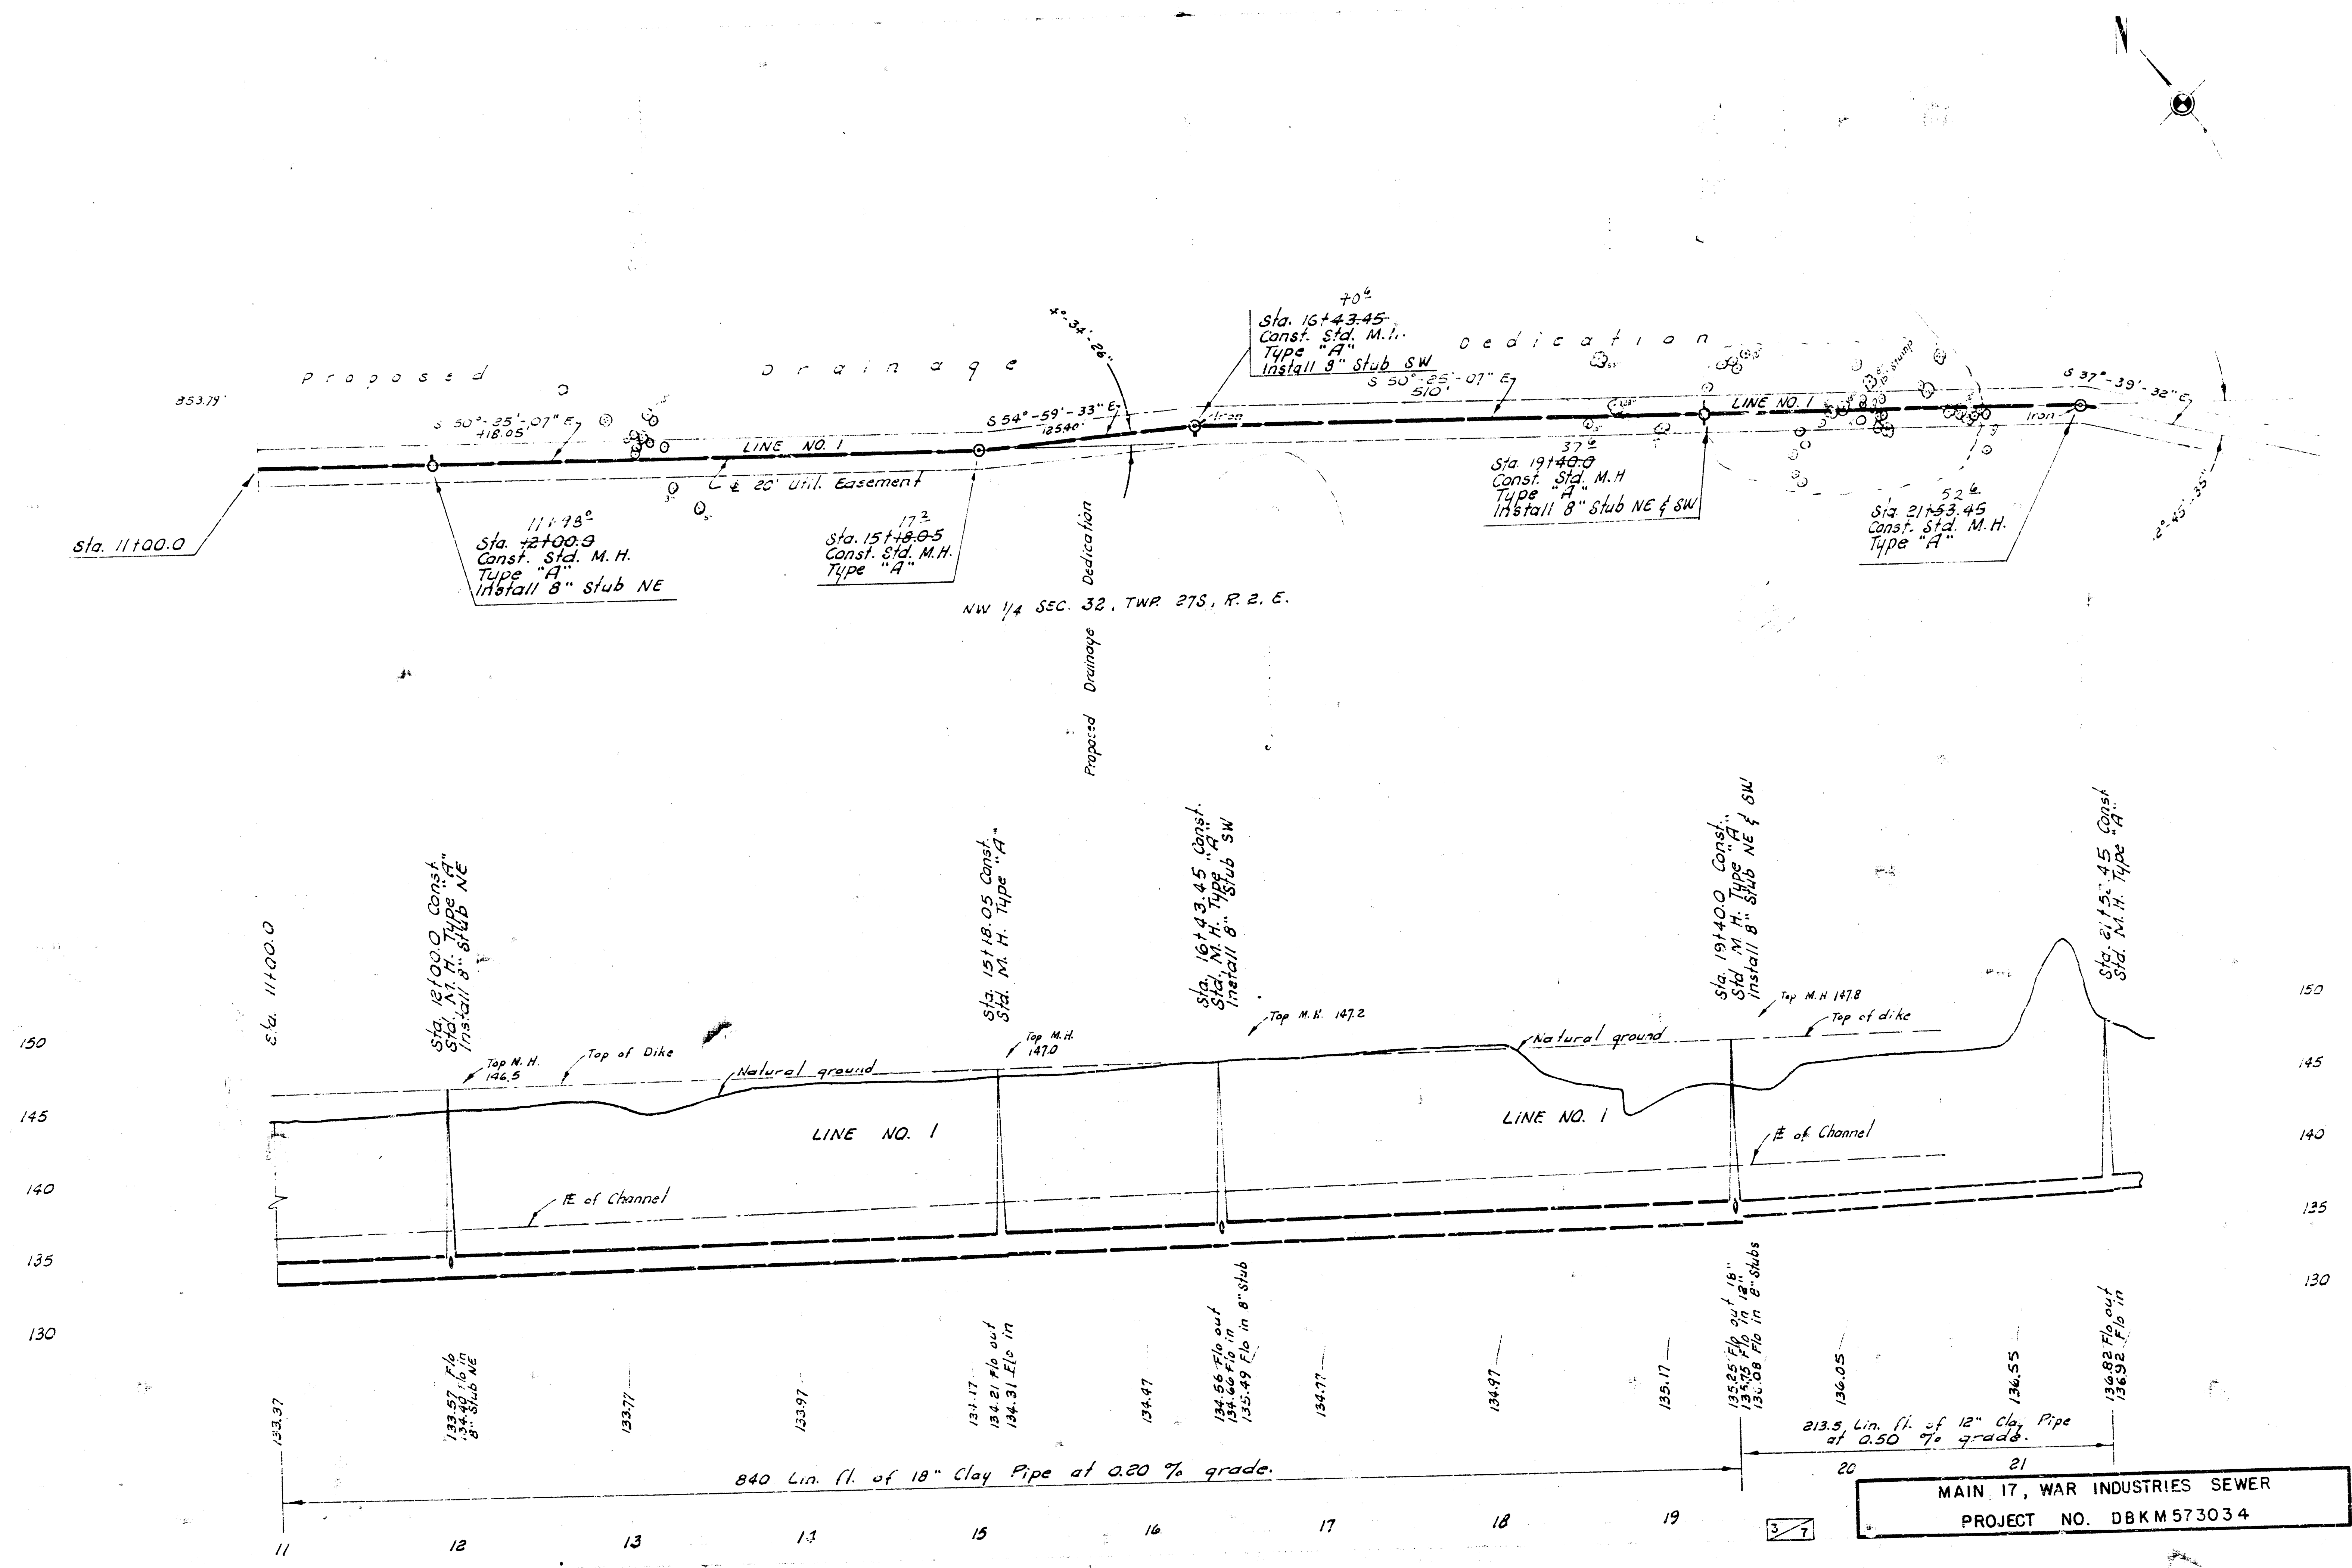

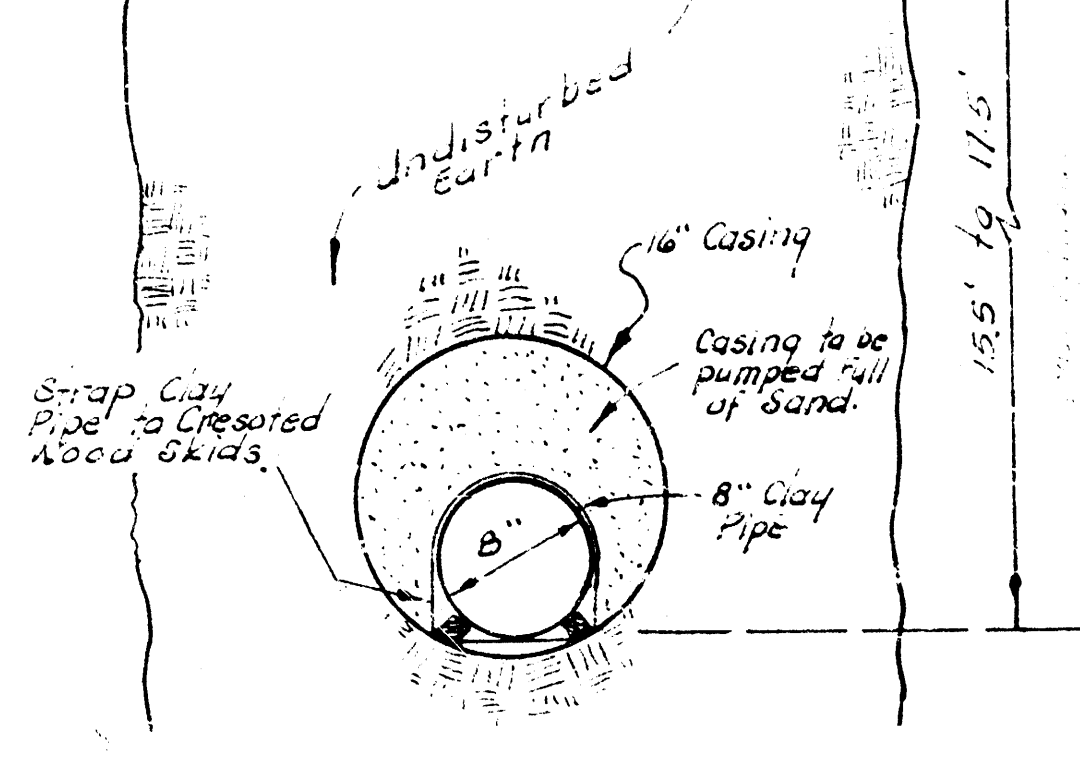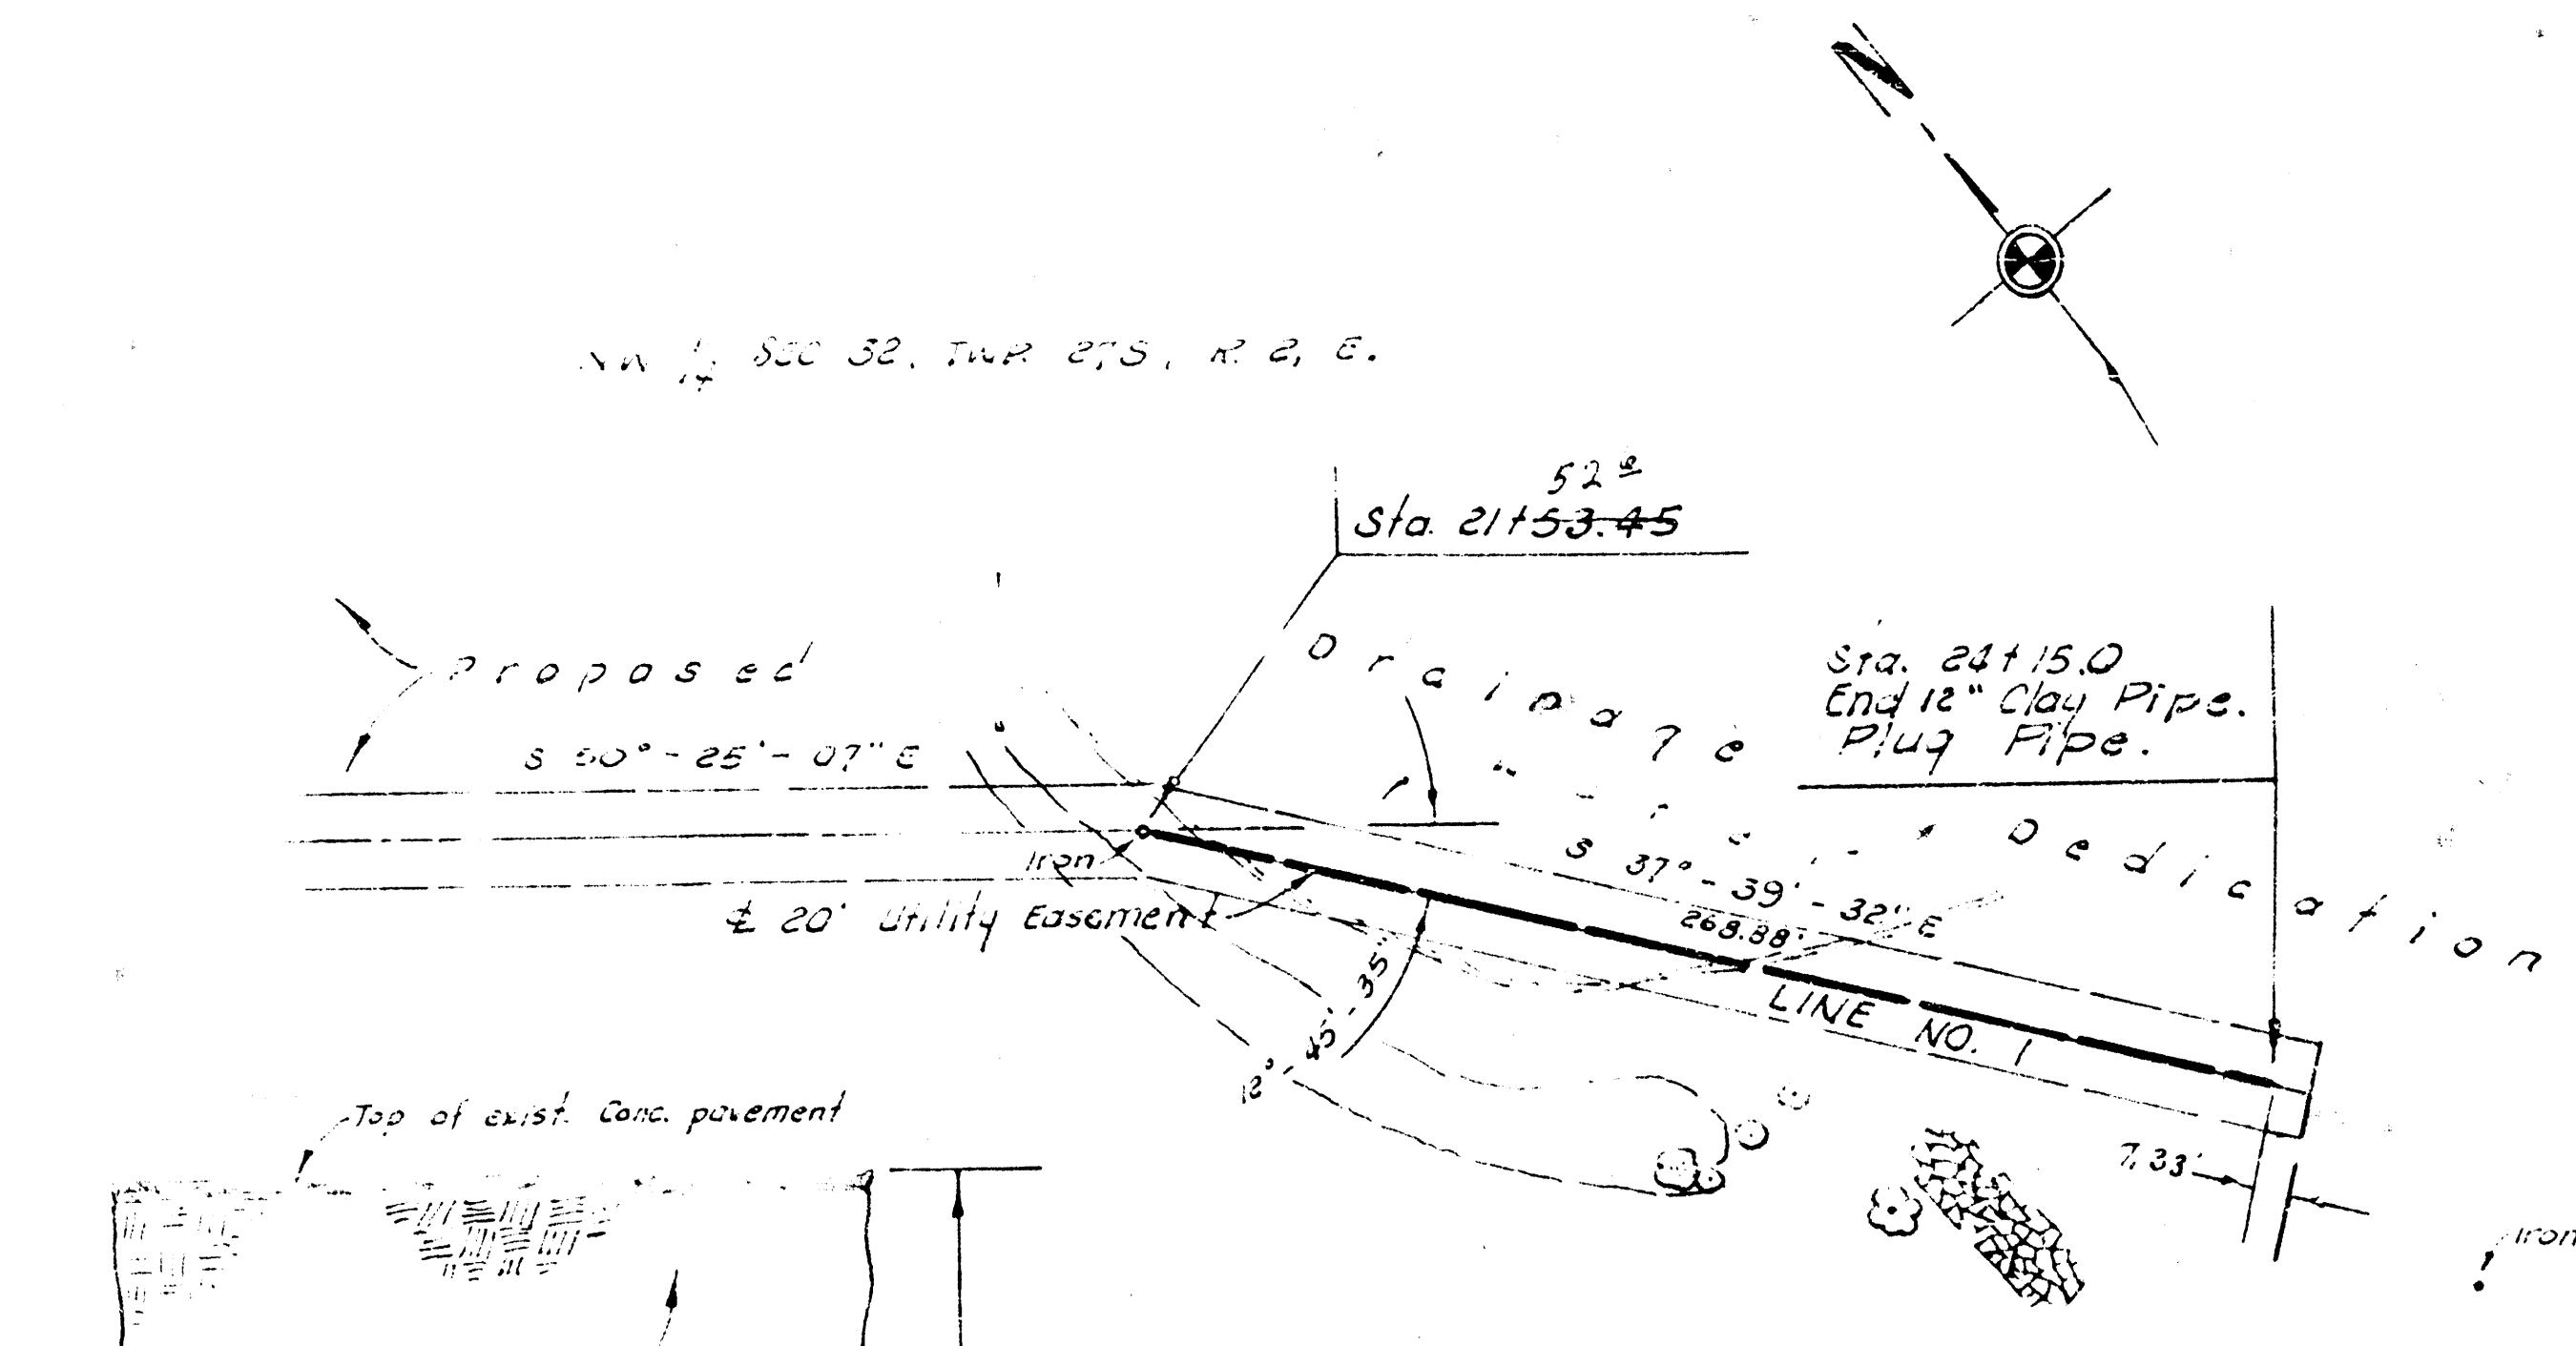



TYPICAL SECTION
Tunnel for
LINES NO. 3 and 4
No Scale



NOTE:
The bid price of Lin. ft.
of casing shall include
the dewatering, wood skids,
strips and the pumping
of sand.

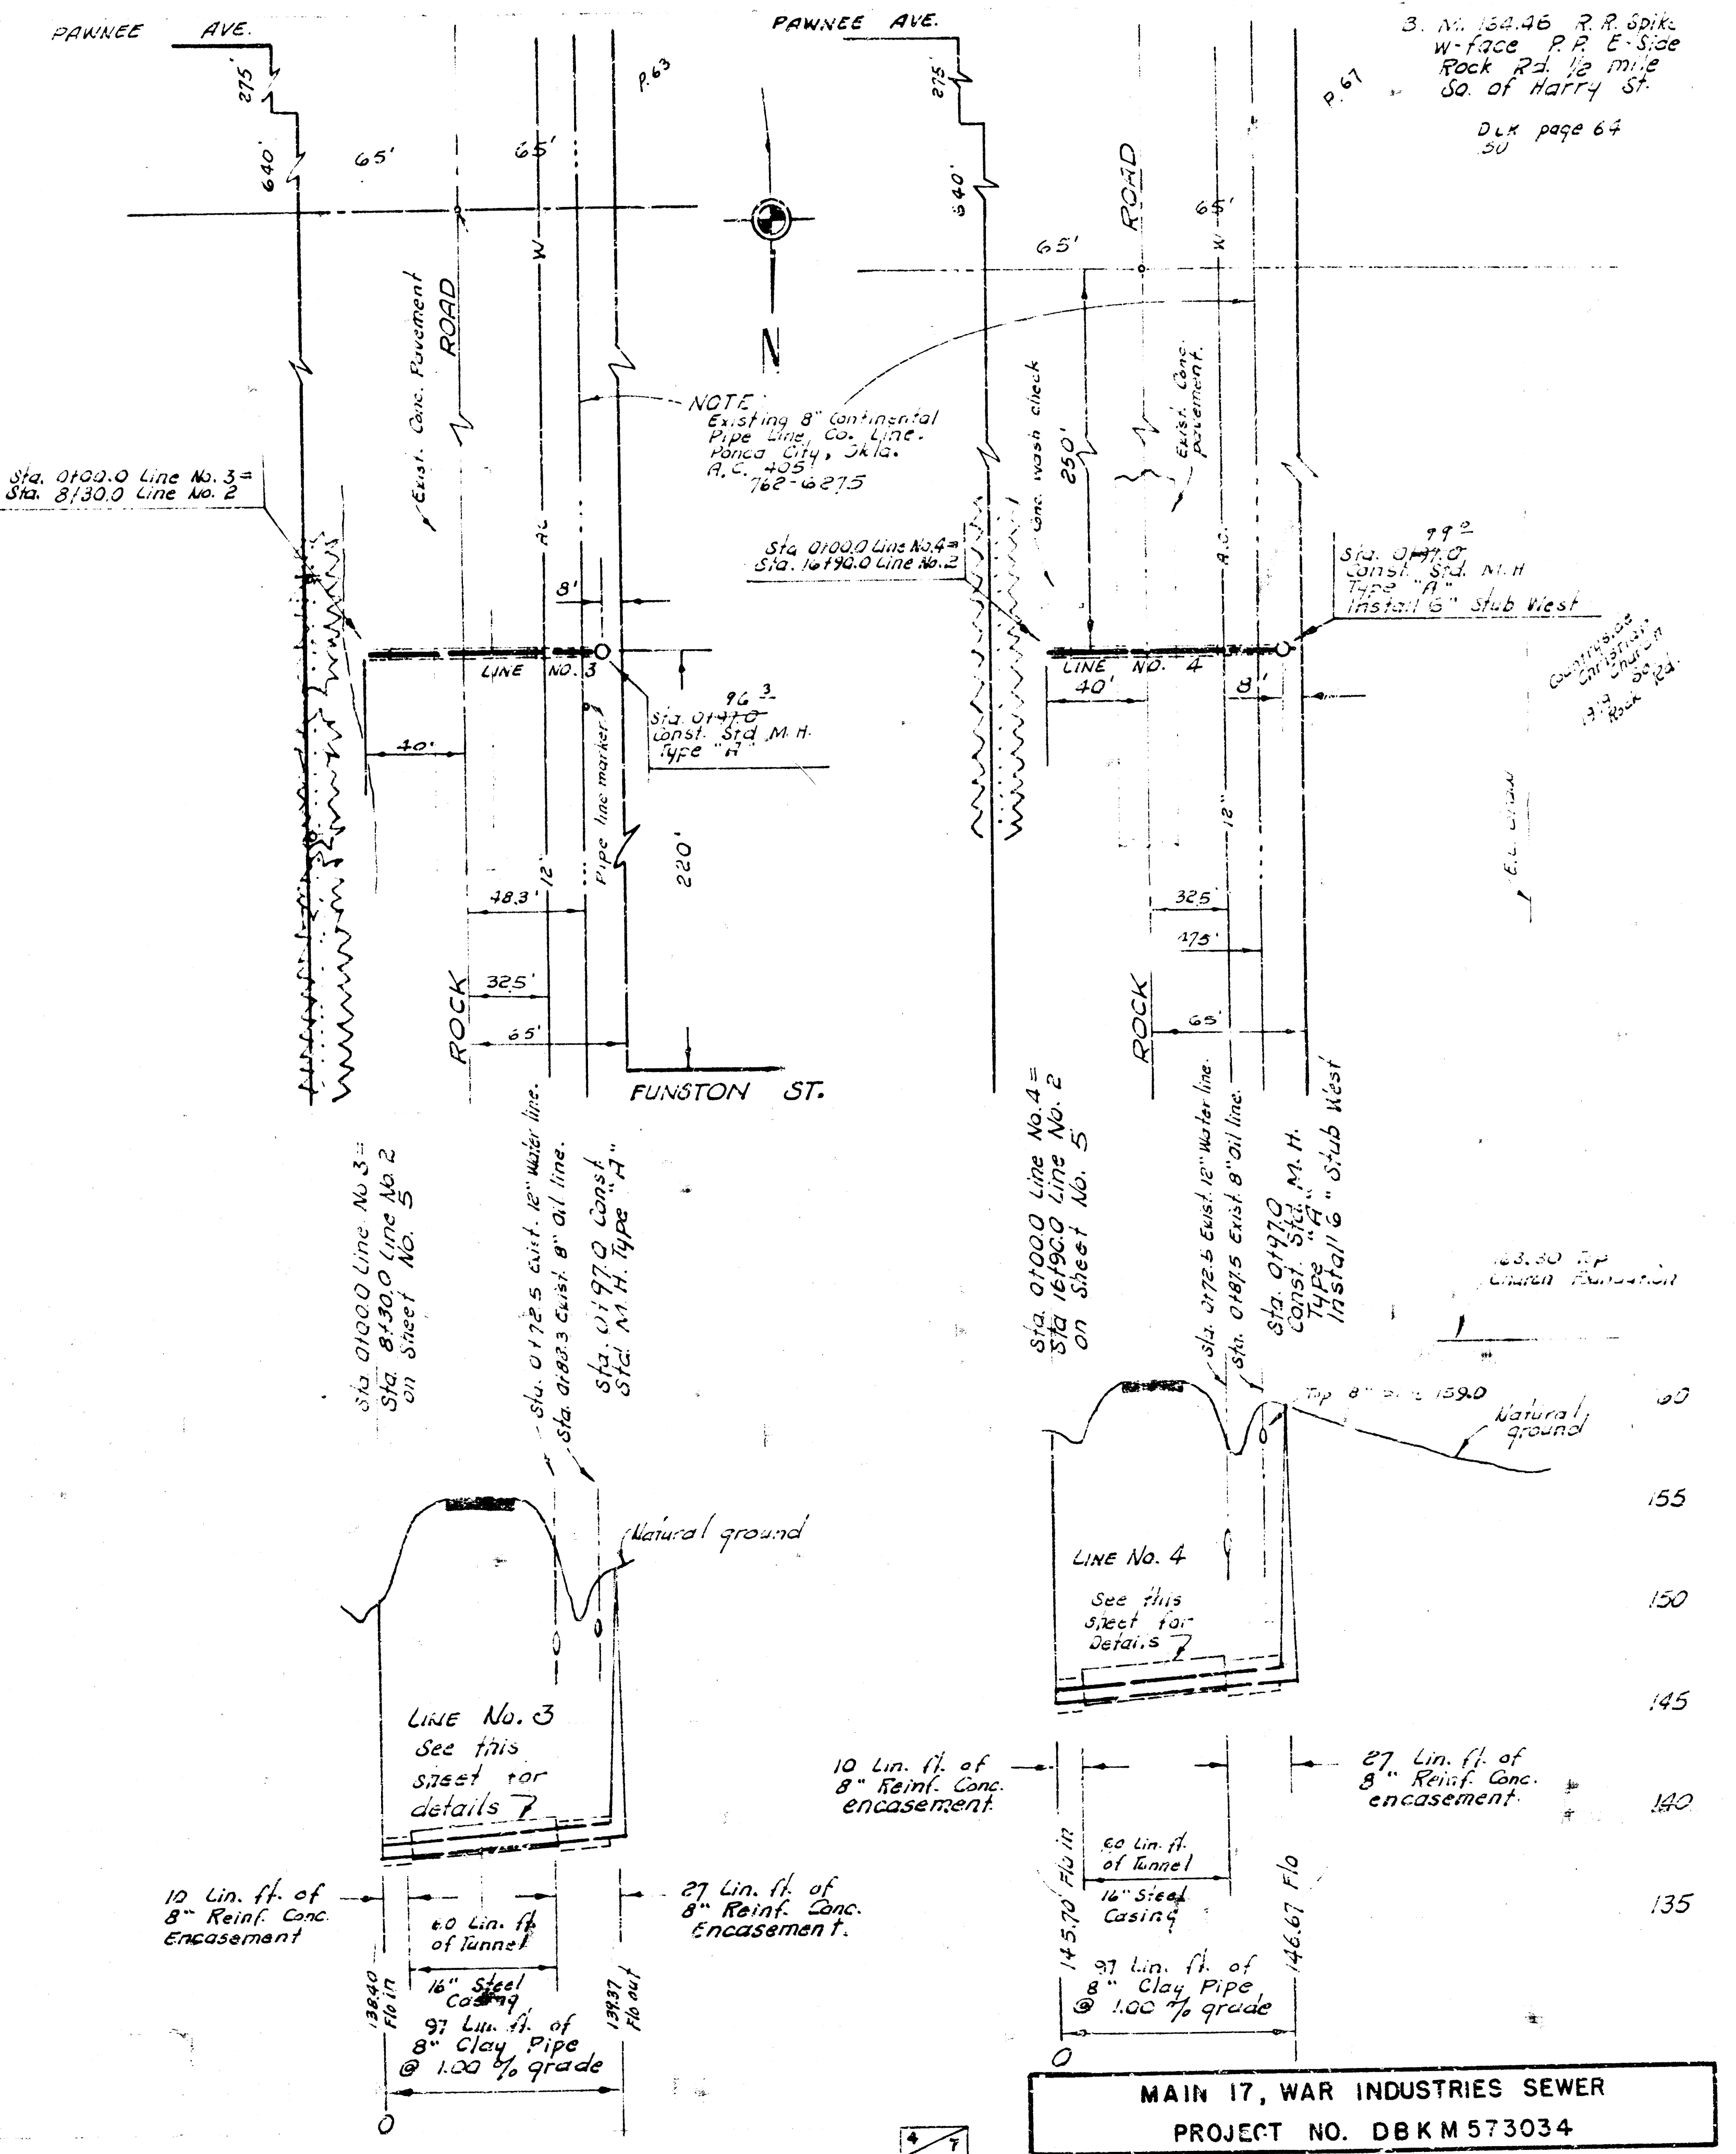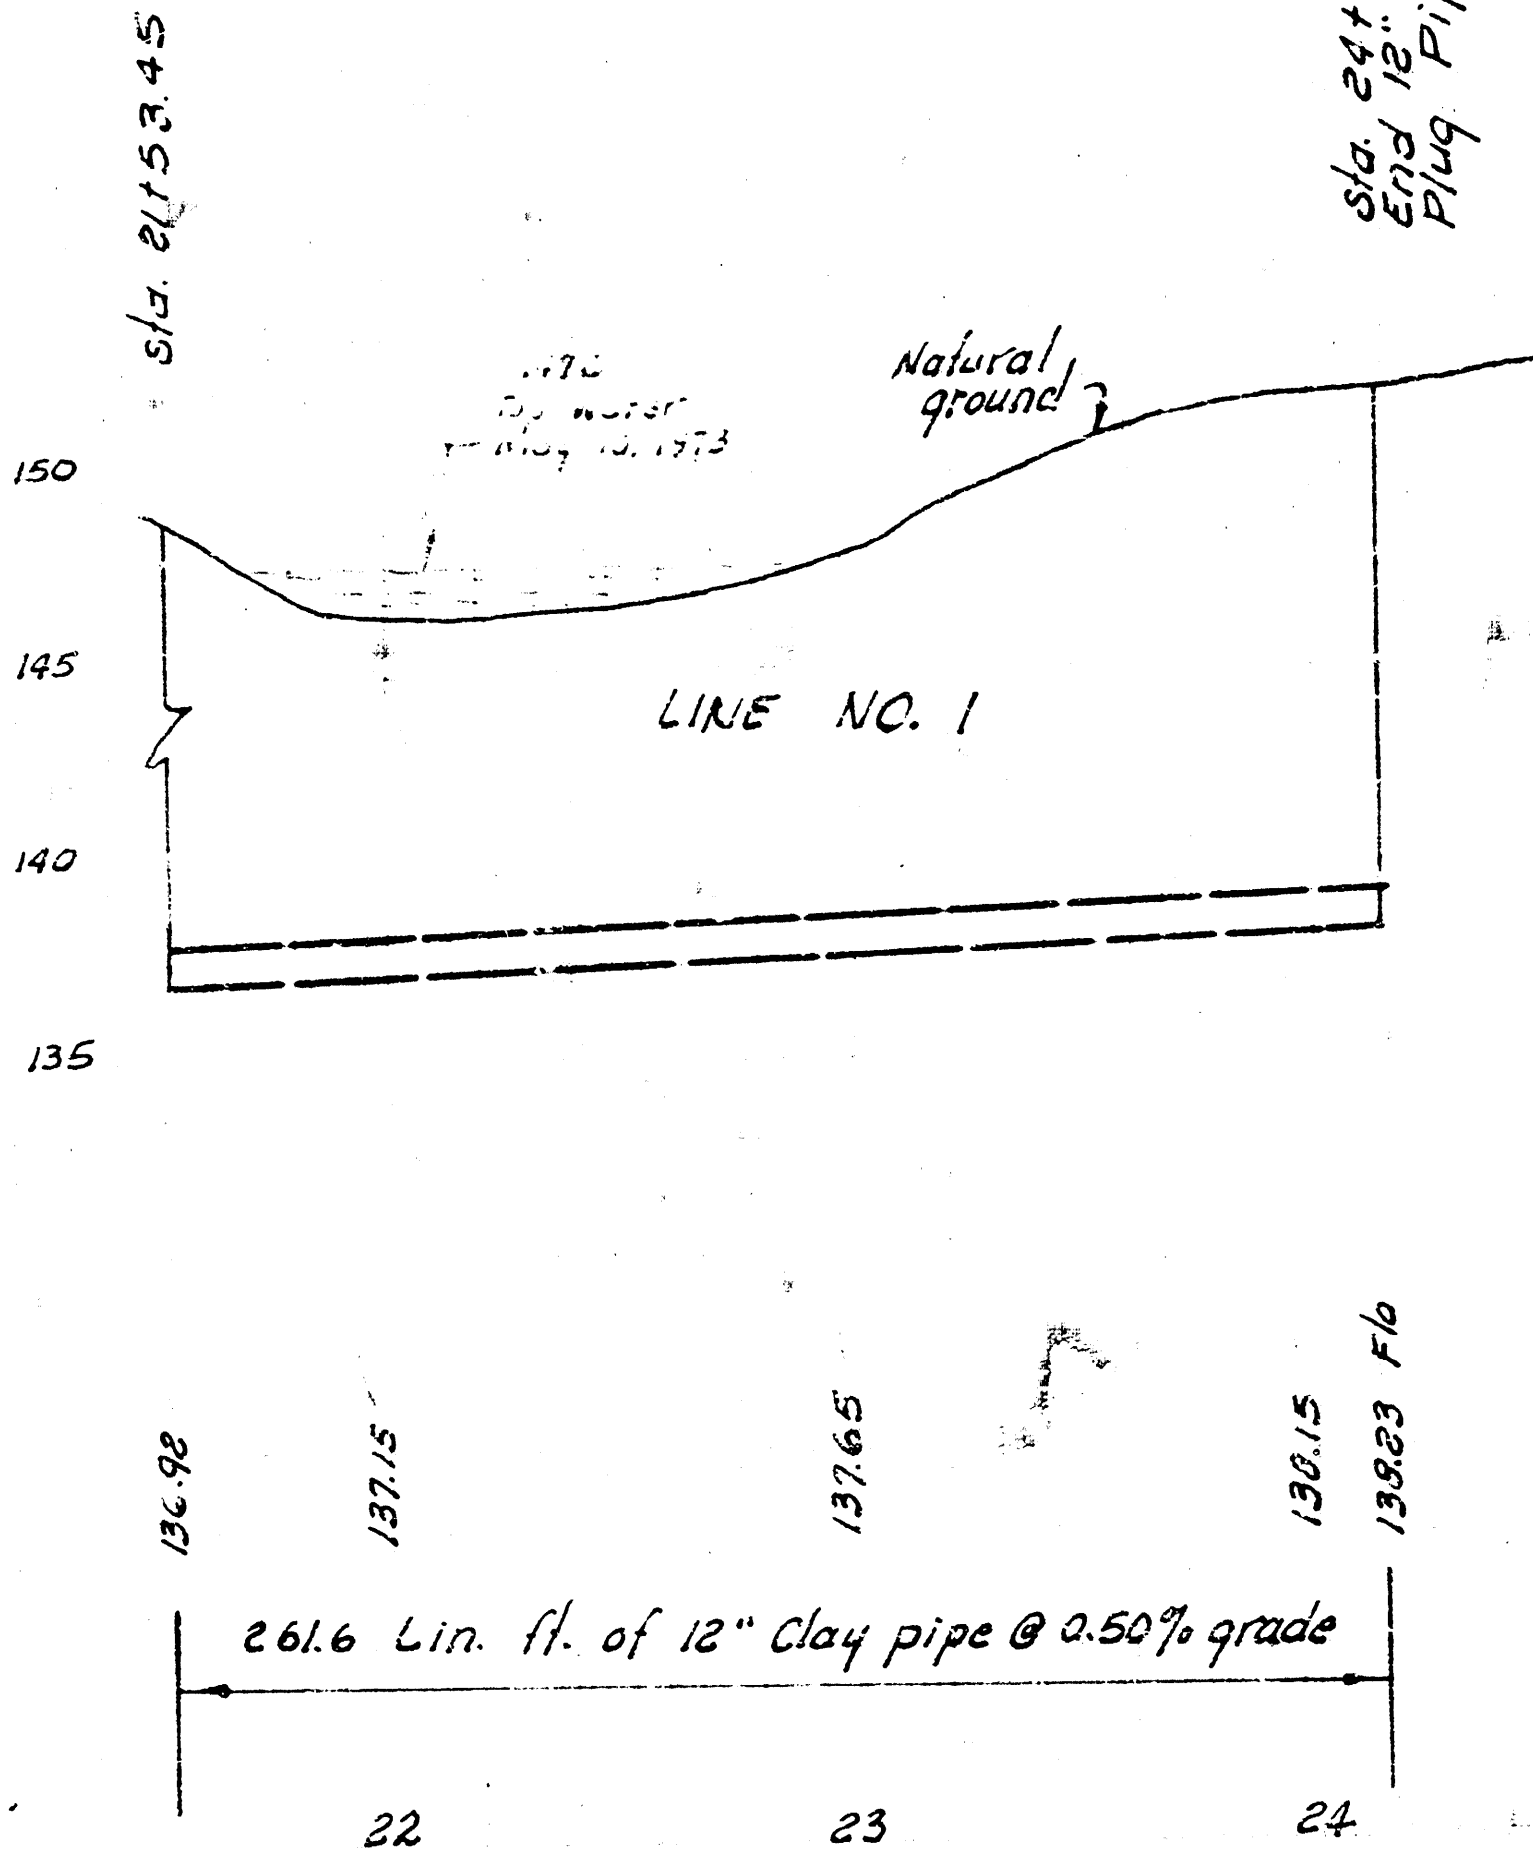



MAIN 17, WAR INDUSTRIES SEWER
PROJECT NO. DBKM 573034

B. M. 154.49 R.R. Spk. W-face P.P. E.L. Rock Rd.
S.L. Funston extended.

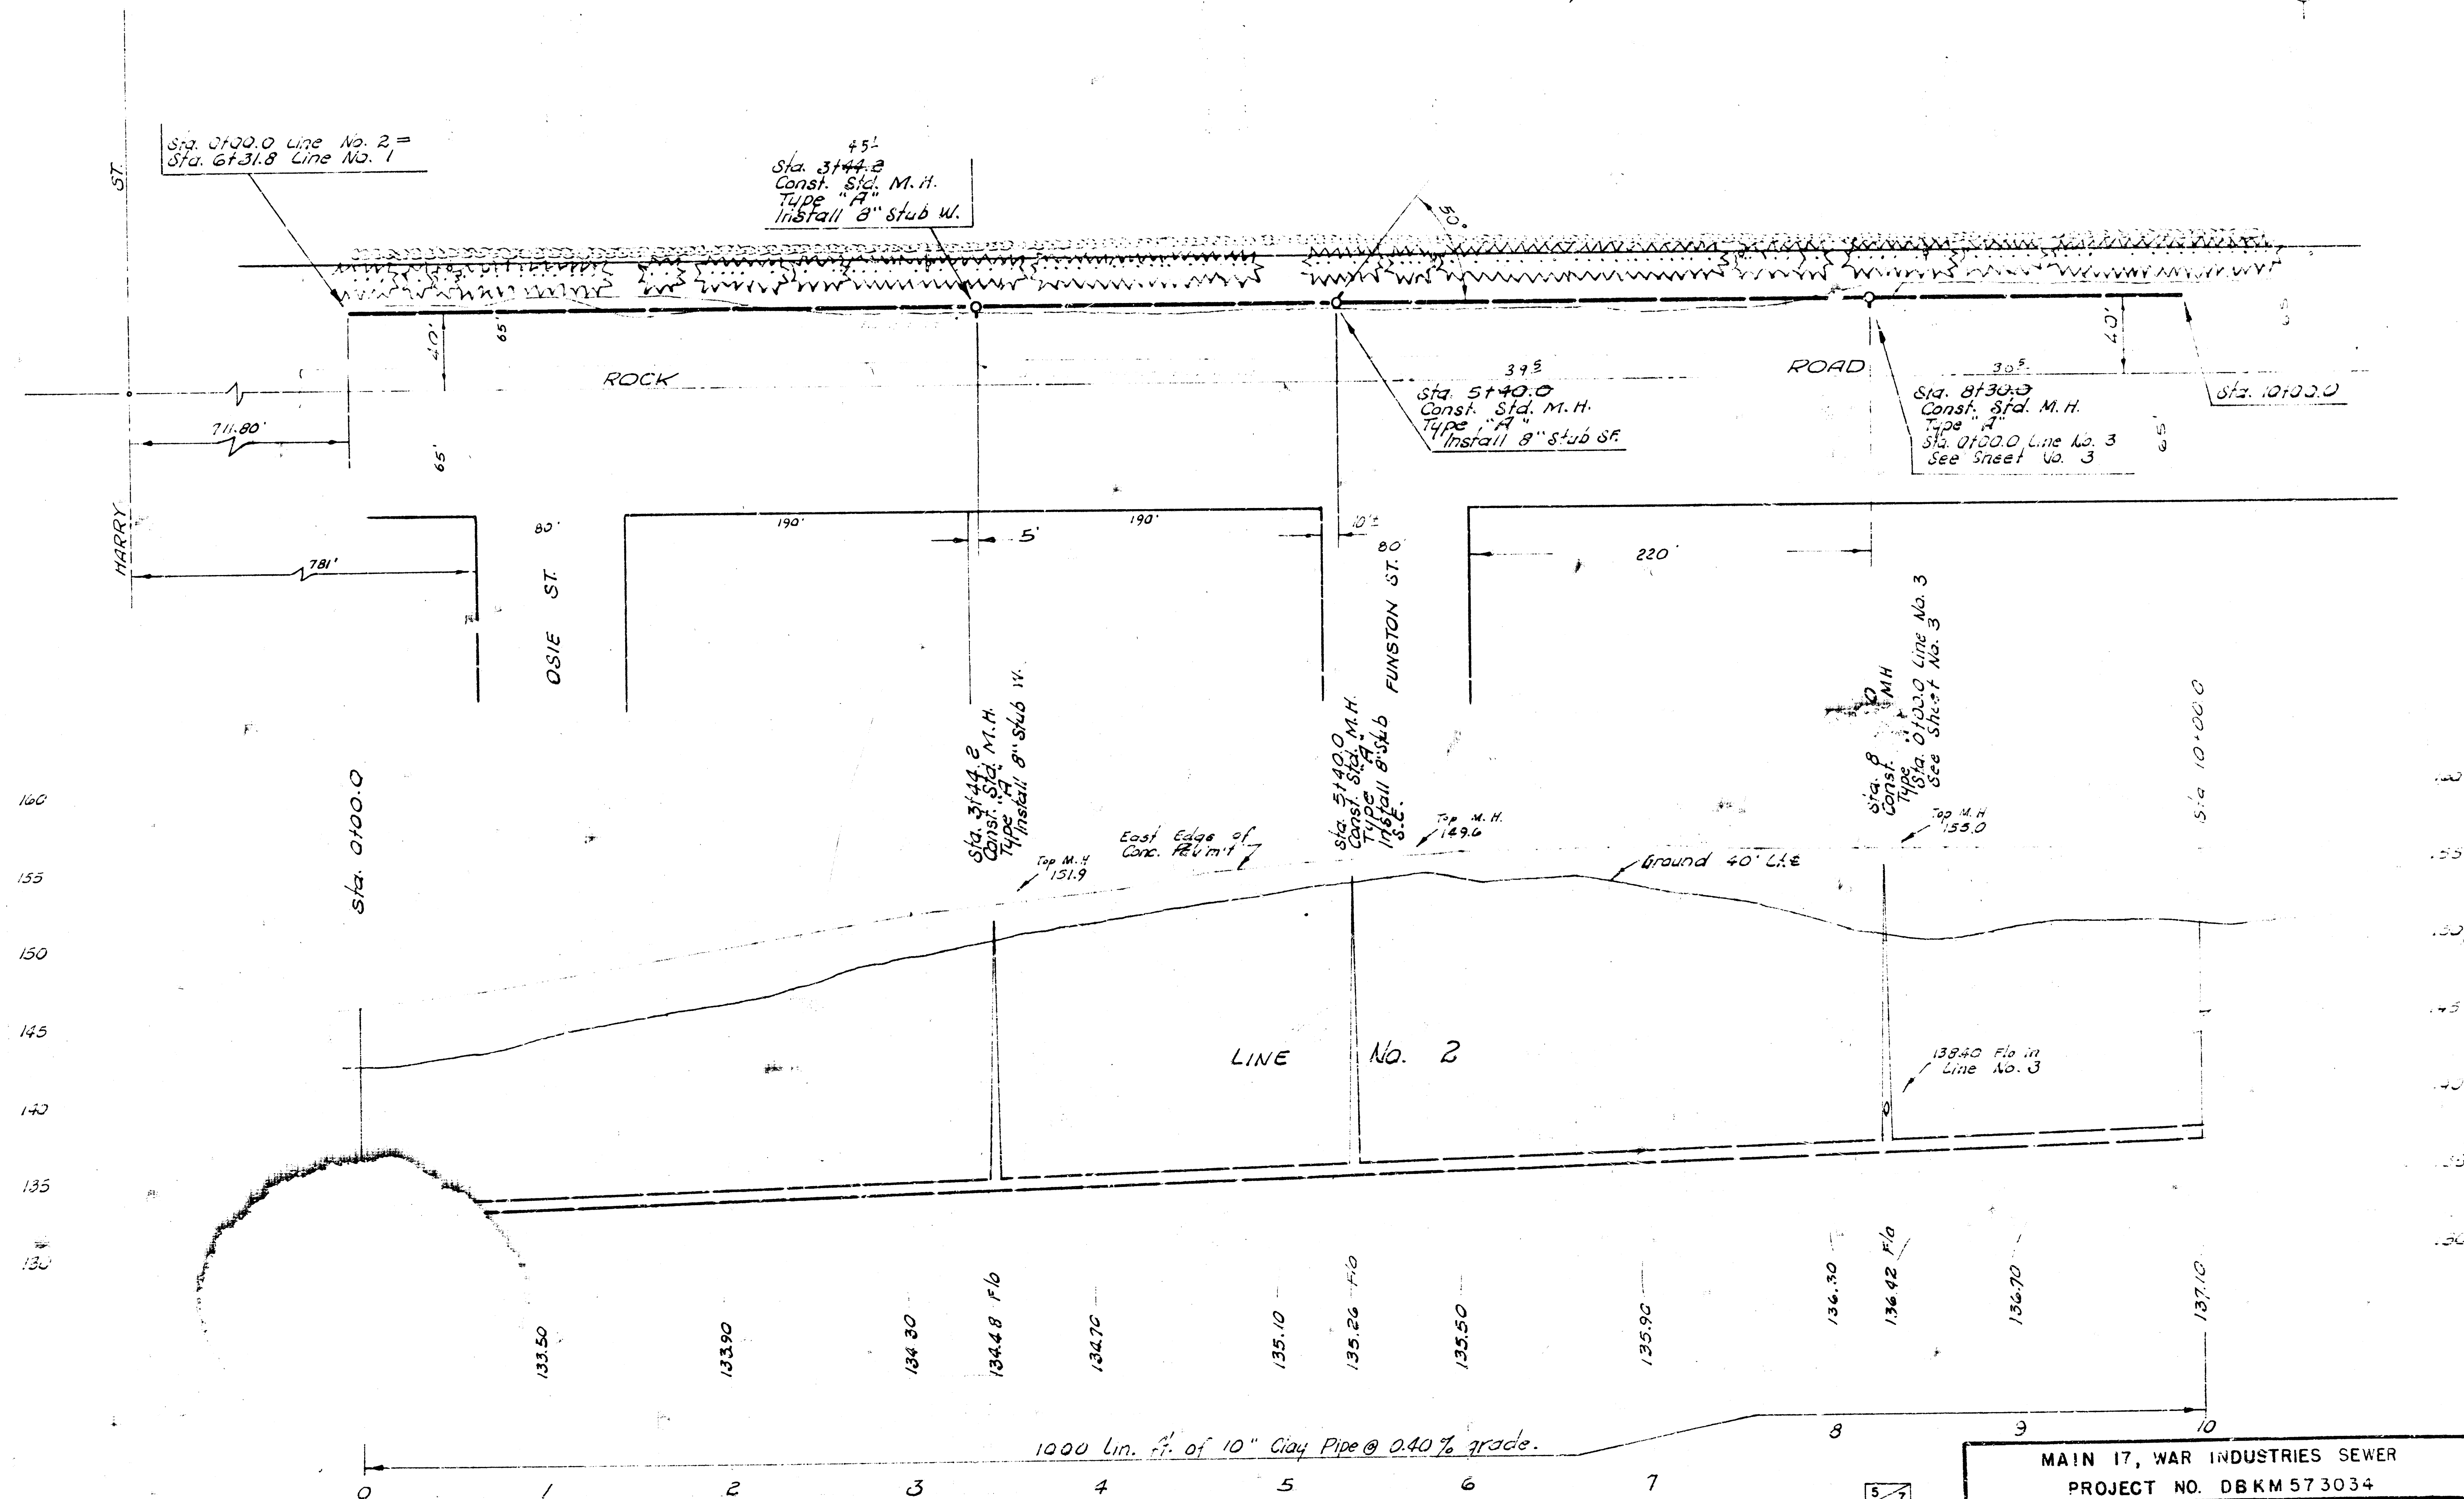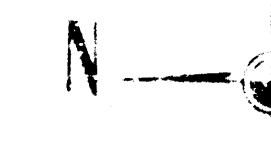


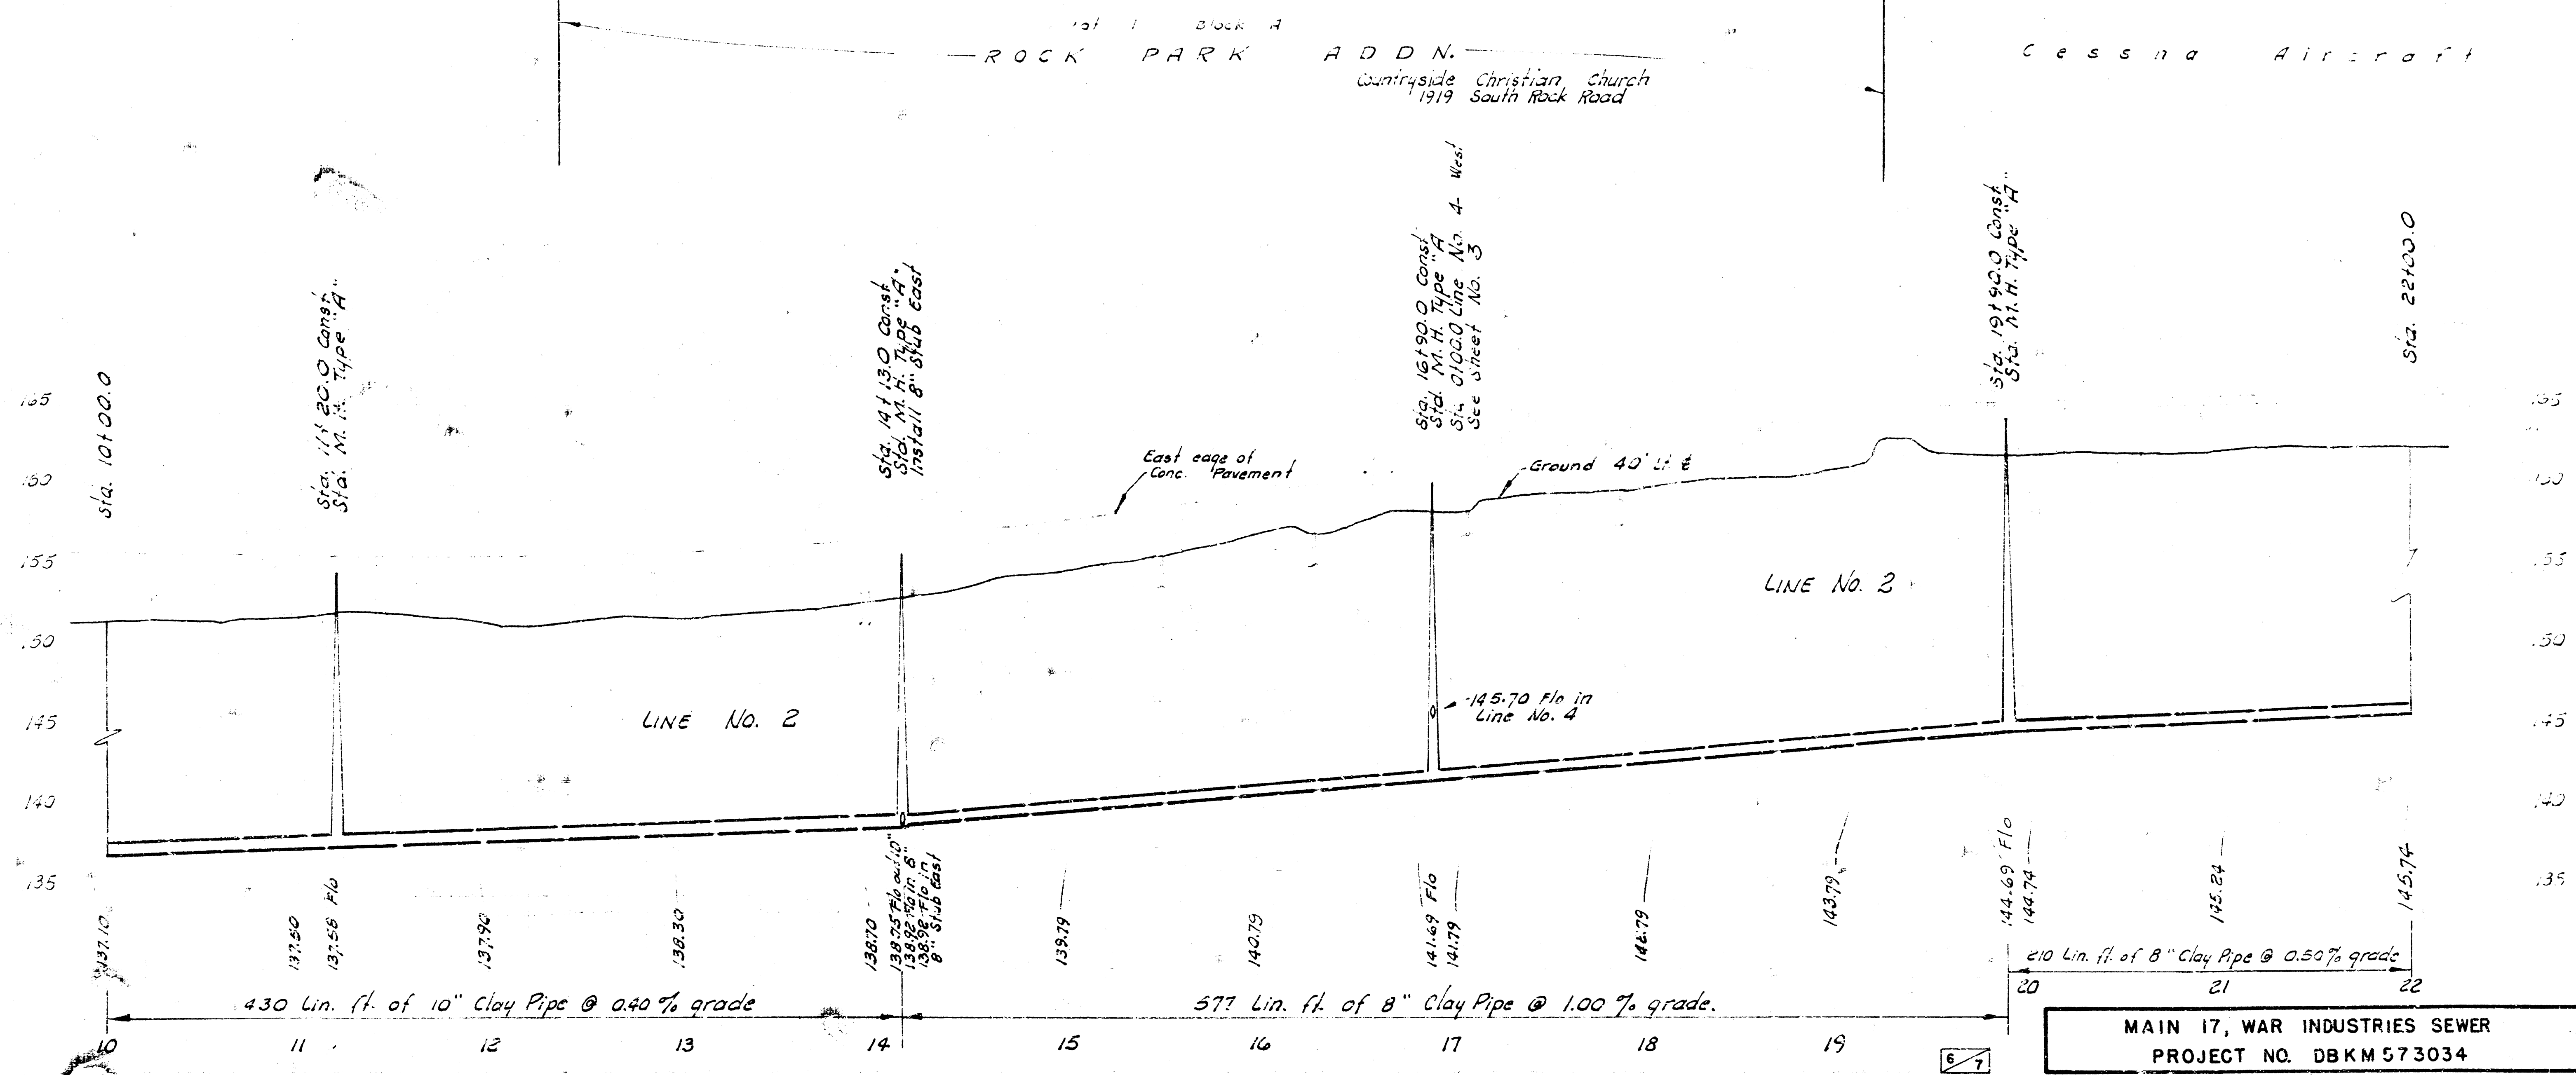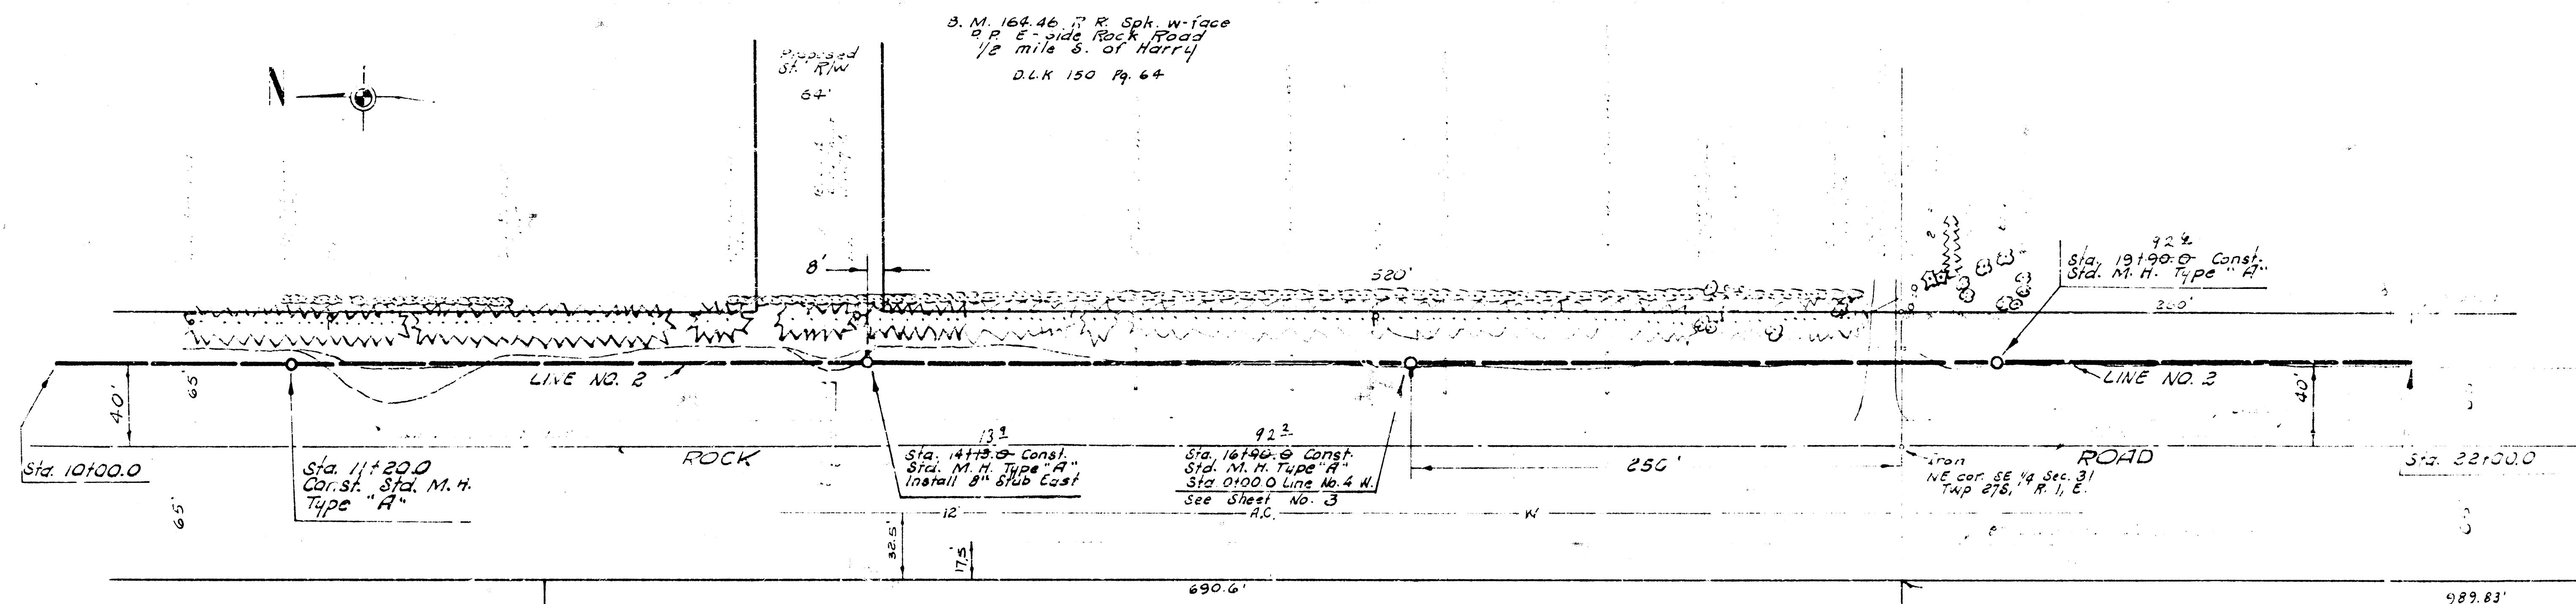

MAIN 17, WAR INDUSTRIES SEWER
PROJECT NO. DBKM 573034

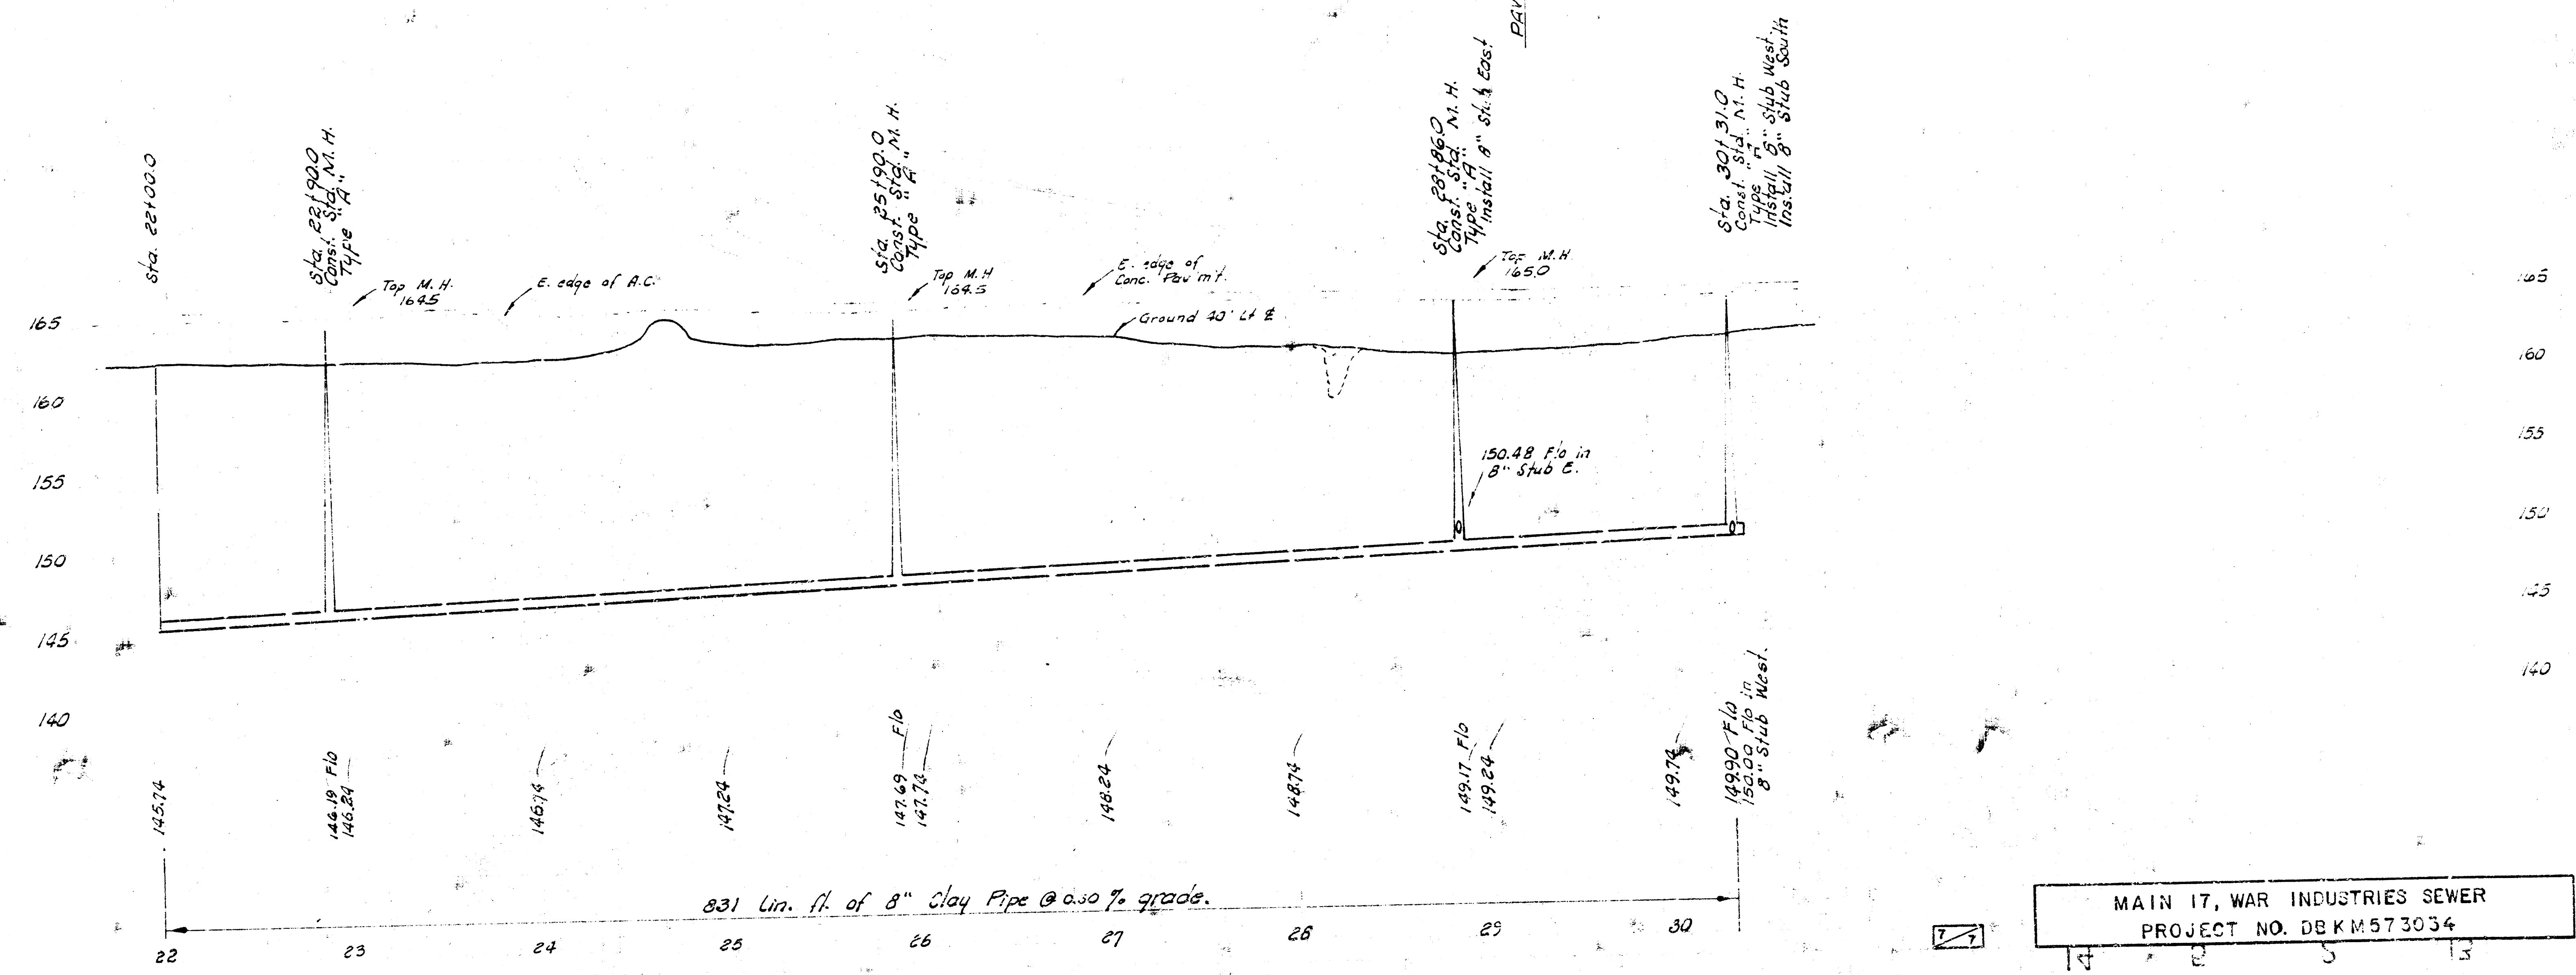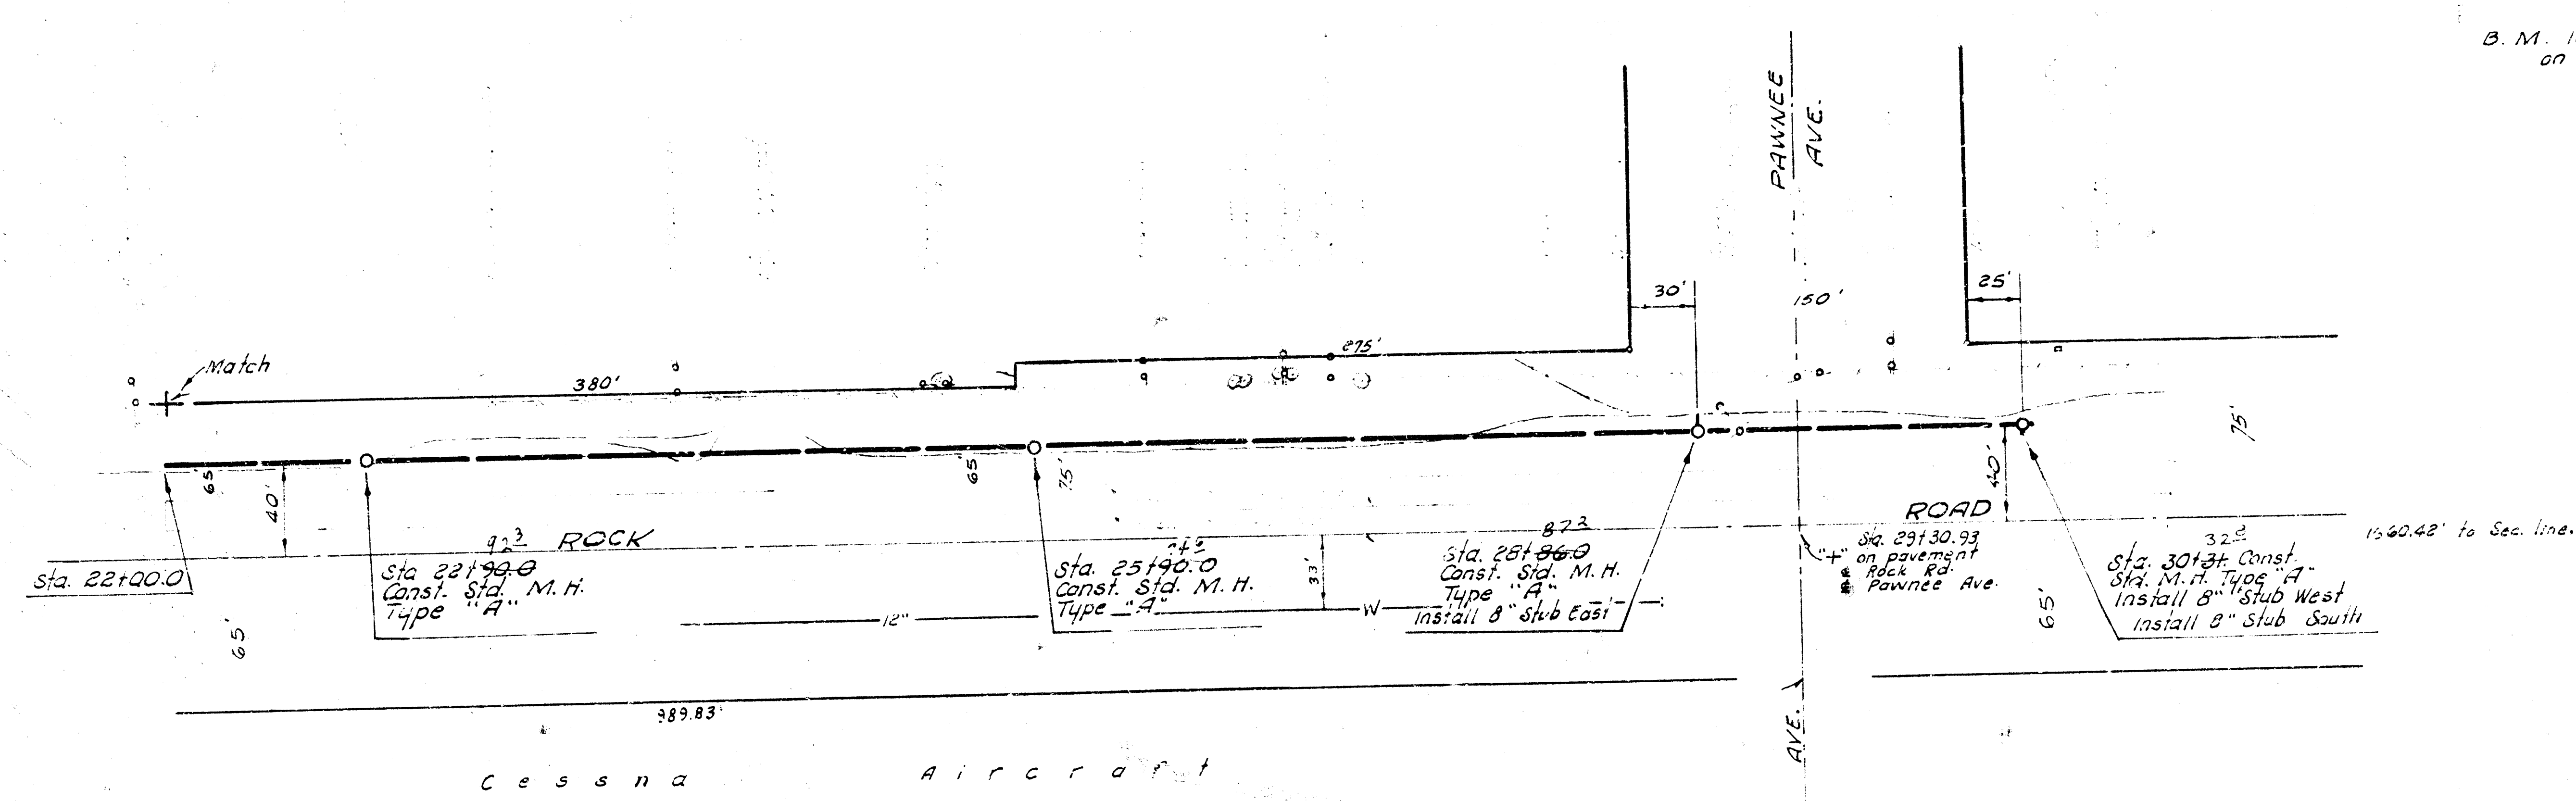

B. M. 165.71 "x" on ctr. Pawnee west on ctr. Rock Road N-S

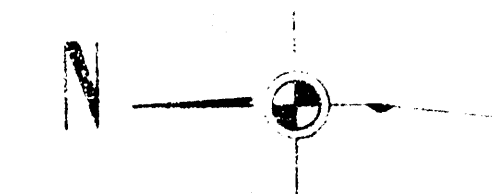

MAIN 17, WAR INDUSTRIES SEWER
PROJECT NO. DB KM 573034