
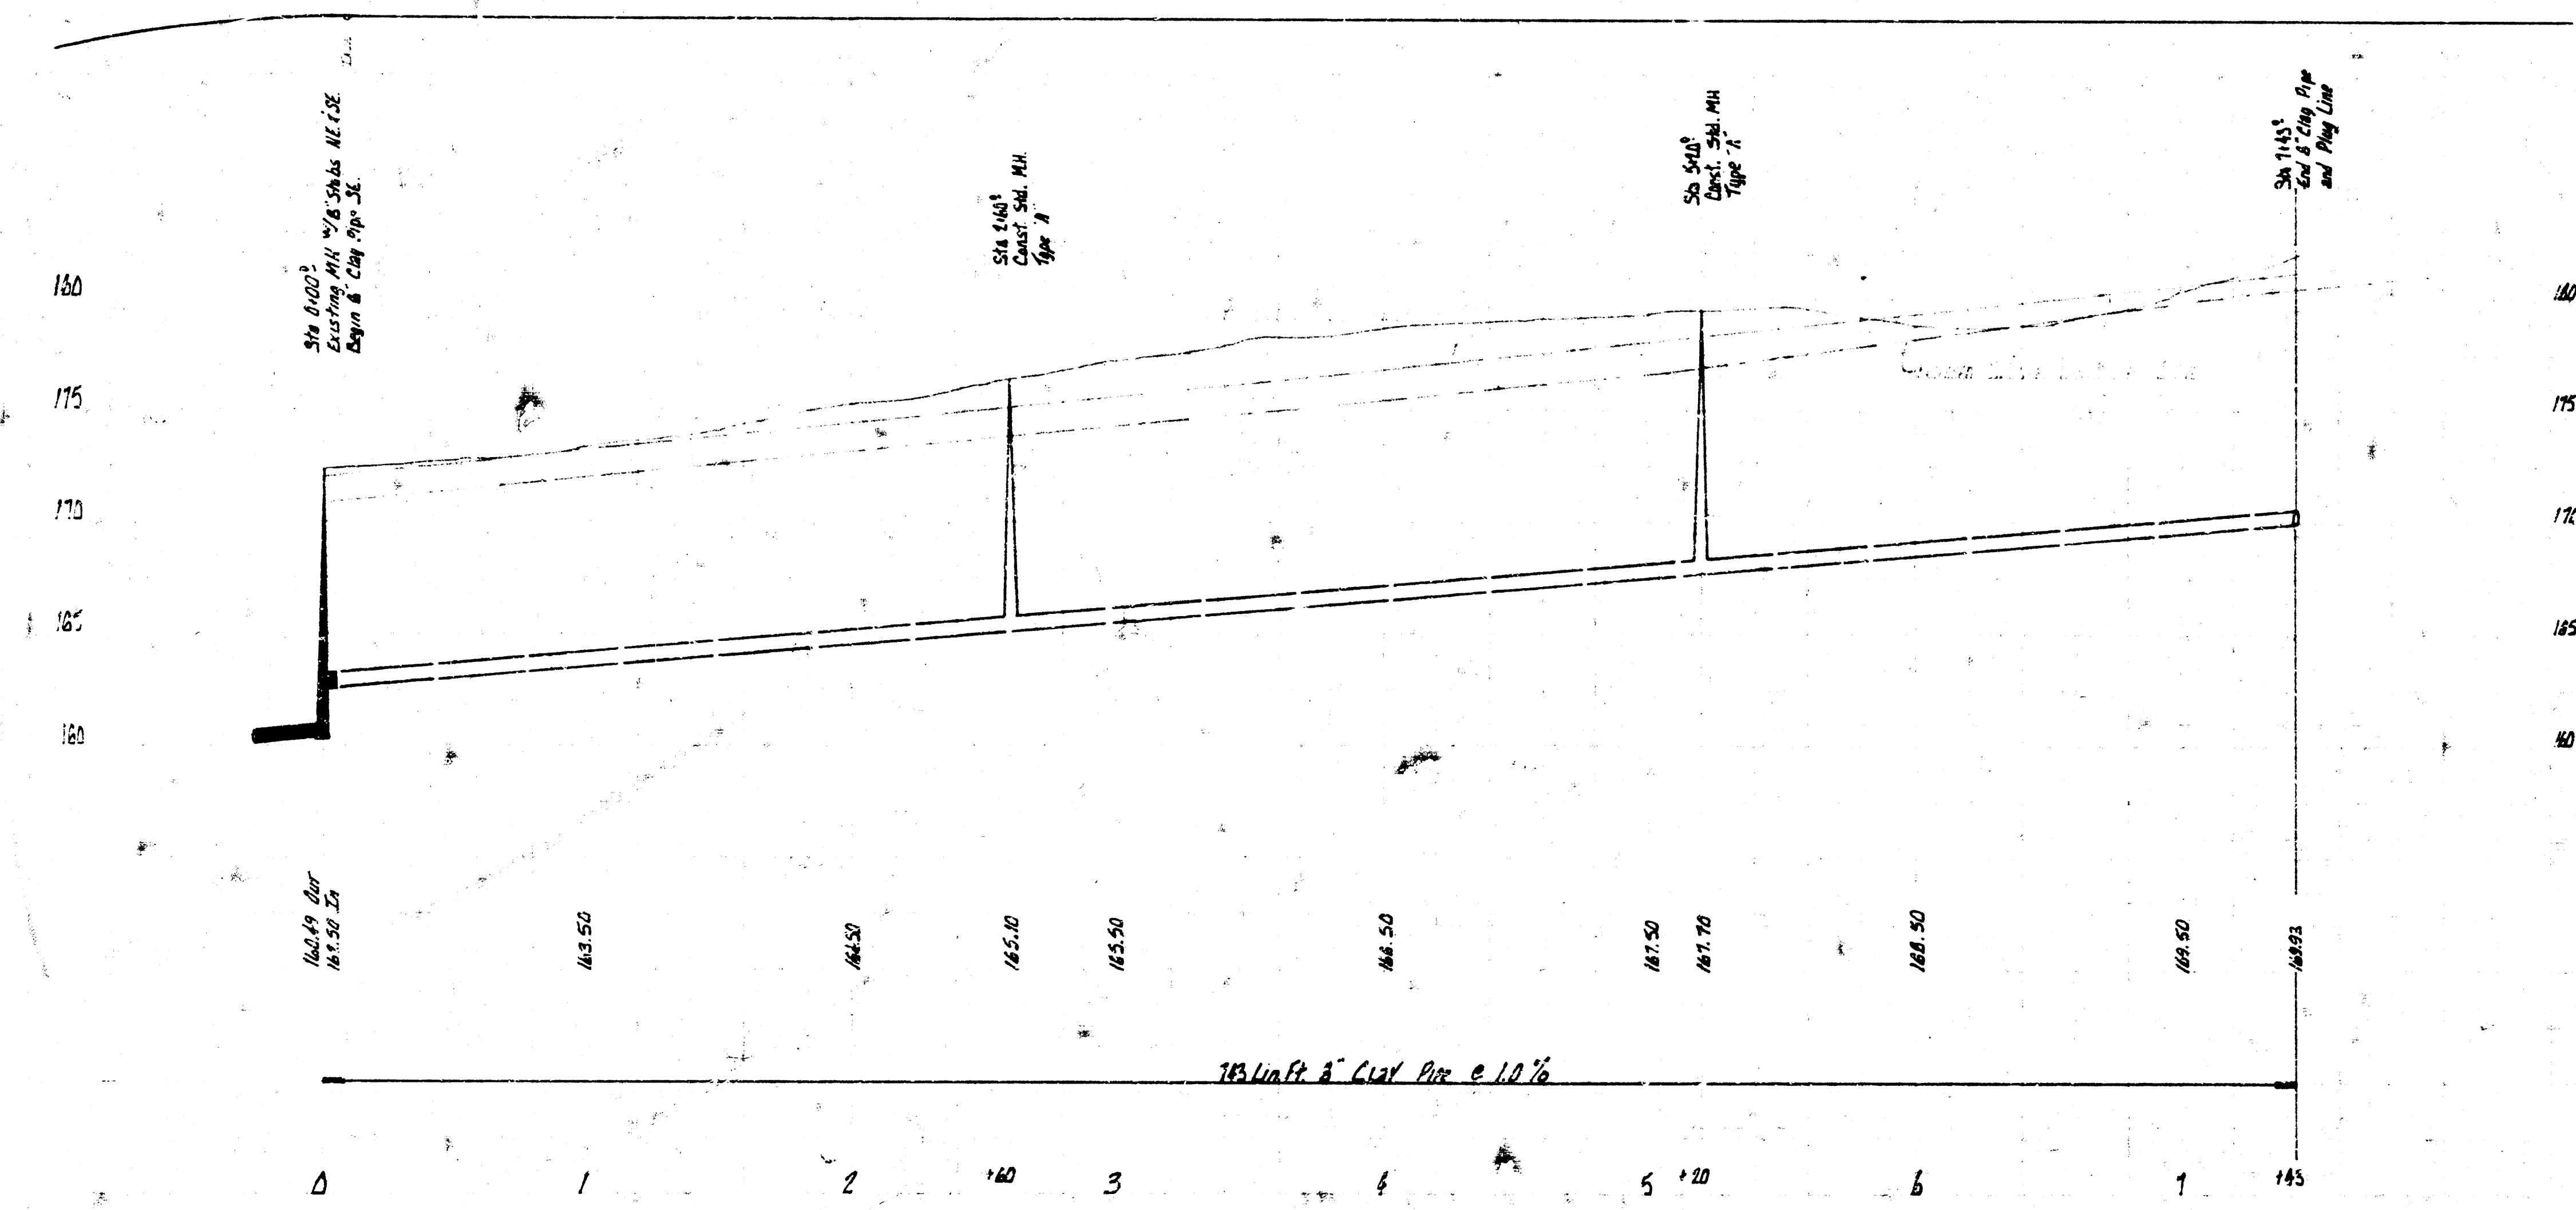


B.M. 165.71 on Center Line of Rock Rd. & Center of Pawnee West
 SCALE: PLAN 1"=40' PROFILE 1"=40' HORIZ. 1"=5' VERT.

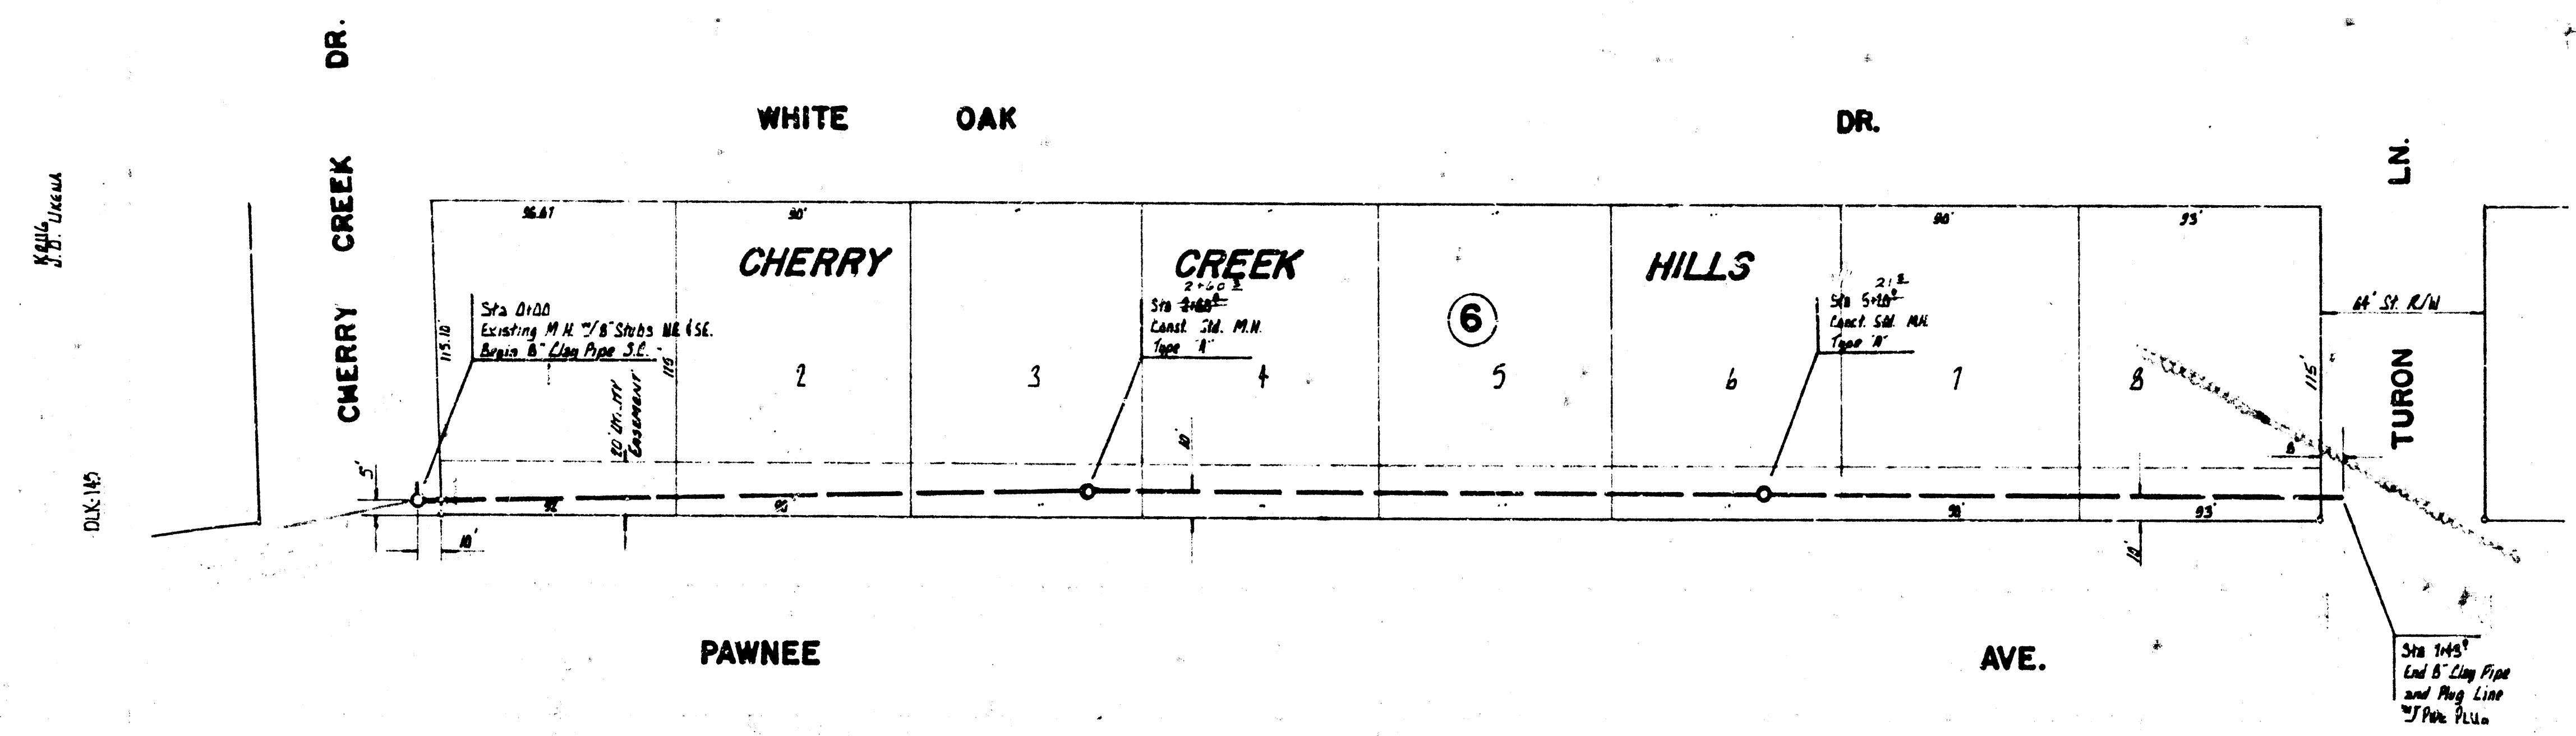

NOTE: CONSTRUCTION OF THIS PROJECT SHALL BE COORDINATED WITH MAIN SEWER CONSTRUCTION ALONG THE EAST SIDE OF ROCK ROAD.

As Built Final Plans 280 P
Lat. 2, Main 17, W.I.S.
 R.W. LINN City Engineer
 City of Wichita, Kansas
 Date: July 1973
 Project No. DBKL573013