




As Built Final Maps 280-Y

Lat 3, Main 17, W.I.S.
R.W. LINN CITY ENGINEER
CITY OF WICHITA, KANSAS
DATE: July 1973
PROJECT NO. DBKL573014

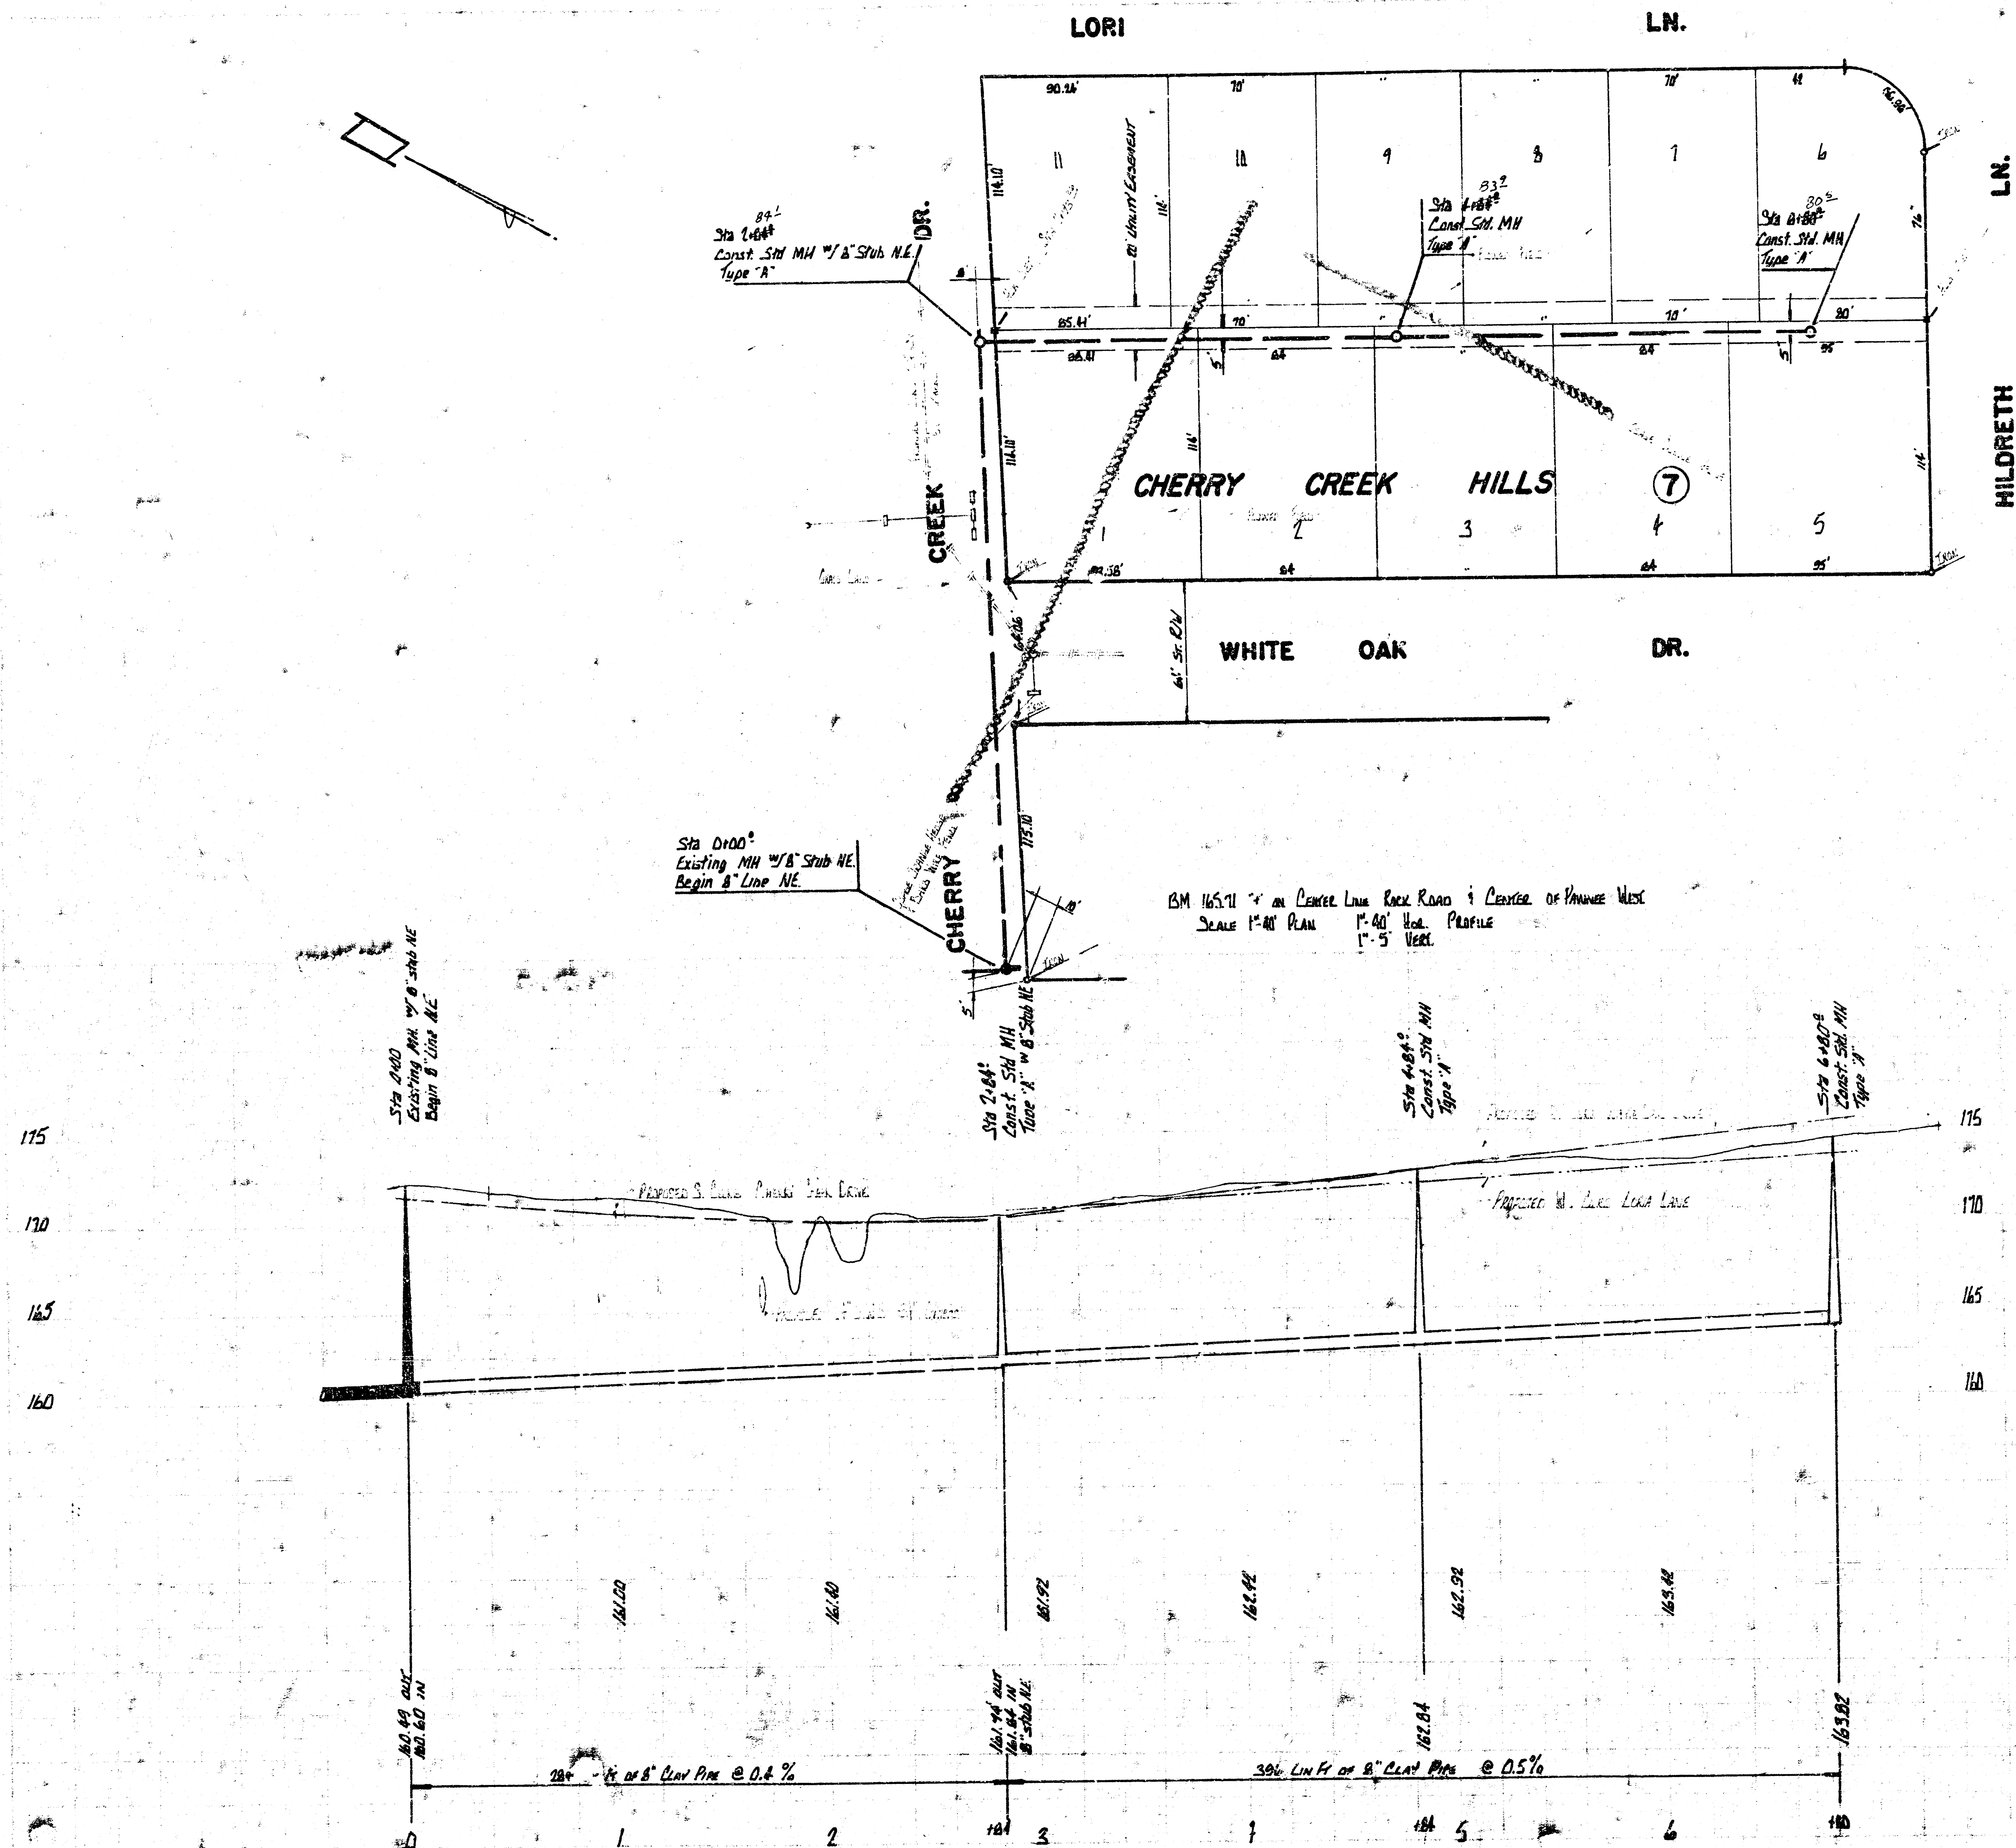